
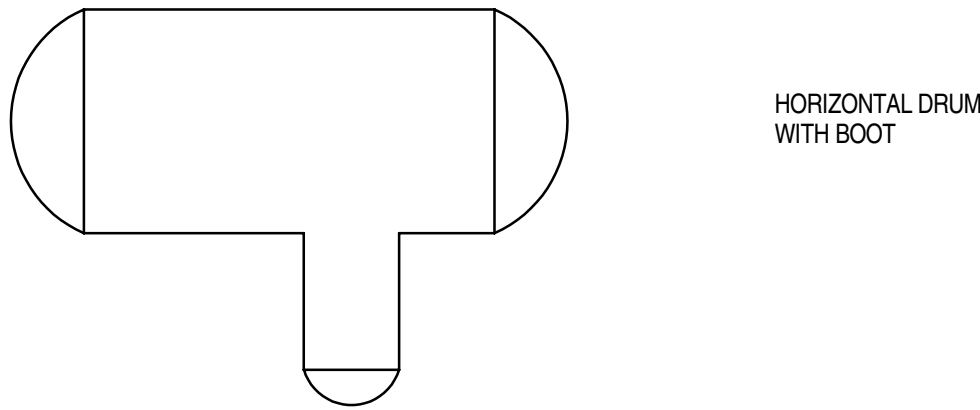


THIS DOCUMENT IS THE PROPERTY OF ABU DHABI GAS DEVELOPMENT COMPANY LIMITED AND CONTAINS INFORMATION WHICH IS PROPRIETARY. THIS INFORMATION IS TO BE HELD IN CONFIDENCE. NO DISCLOSURE OR OTHER USE OF THIS DOCUMENT IS TO BE MADE WITHOUT THE PRIOR WRITTEN CONSENT OF ABU DHABI GAS DEVELOPMENT COMPANY LIMITED.

EQUIPMENT SYMBOLS AND LEGEND

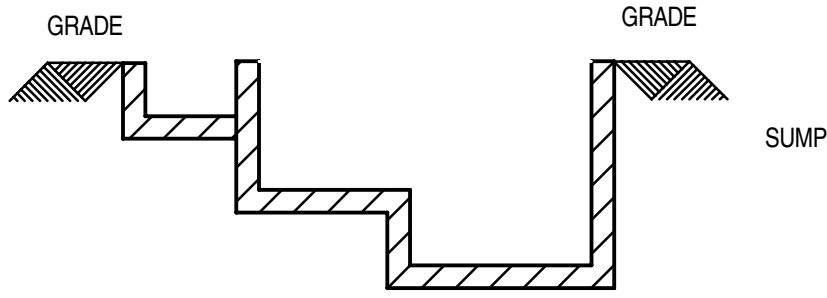

Z1	14/08/2014	IAB	ISSUE FOR AS BUILT	F.T.	N.F.	A.N.
02	30/06/2011	IFC	FINAL ISSUE FOR CONSTRUCTION	F.T.	D.L.	A.N.
01	02/03/2011	IFC	FIRST ISSUE FOR CONSTRUCTION	F.T.	D.L.	A.N.
00	29/11/2010	IFD	ISSUED FOR DESIGN	F.T.	N.F.	A.N.
B2	21/10/2010	IFH	ISSUE FOR HAZOP	F.T.	N.F.	A.N.
REV	DATE	STATUS	STATUS DESCRIPTION	BY	CKD	APP.

COMPANY:



Abu Dhabi Gas Development Co. Ltd.

CONTRACTOR:



JOB No. 032086

PROJECT:

SHAH GAS DEVELOPMENT (SGD) PROJECT

AGREEMENT No. 13525201

AS BUILT

DRAWING TITLE: PIPING & INSTRUMENT DIAGRAM UNIT 0500	
EQUIPMENT DESCRIPTION	EQUIPMENT SYMBOLS AND LEGEND
TAGITEM No.	

CONTRACTOR DRG.No.	500-GD-B-08034	REV. Z1
COMPANY DRG.No.	PP05-0500-00-PID-8034	
SCALE: NONE	SIZE: A1	
		DOC. CLASS: 1