


THIS DOCUMENT IS THE PROPERTY OF ABU DHABI GAS DEVELOPMENT COMPANY LIMITED. NO DISCLOSURE OR OTHER USE OF THIS DOCUMENT IS TO BE MADE WITHOUT THE PRIOR WRITTEN CONSENT OF ABU DHABI GAS DEVELOPMENT COMPANY LIMITED.

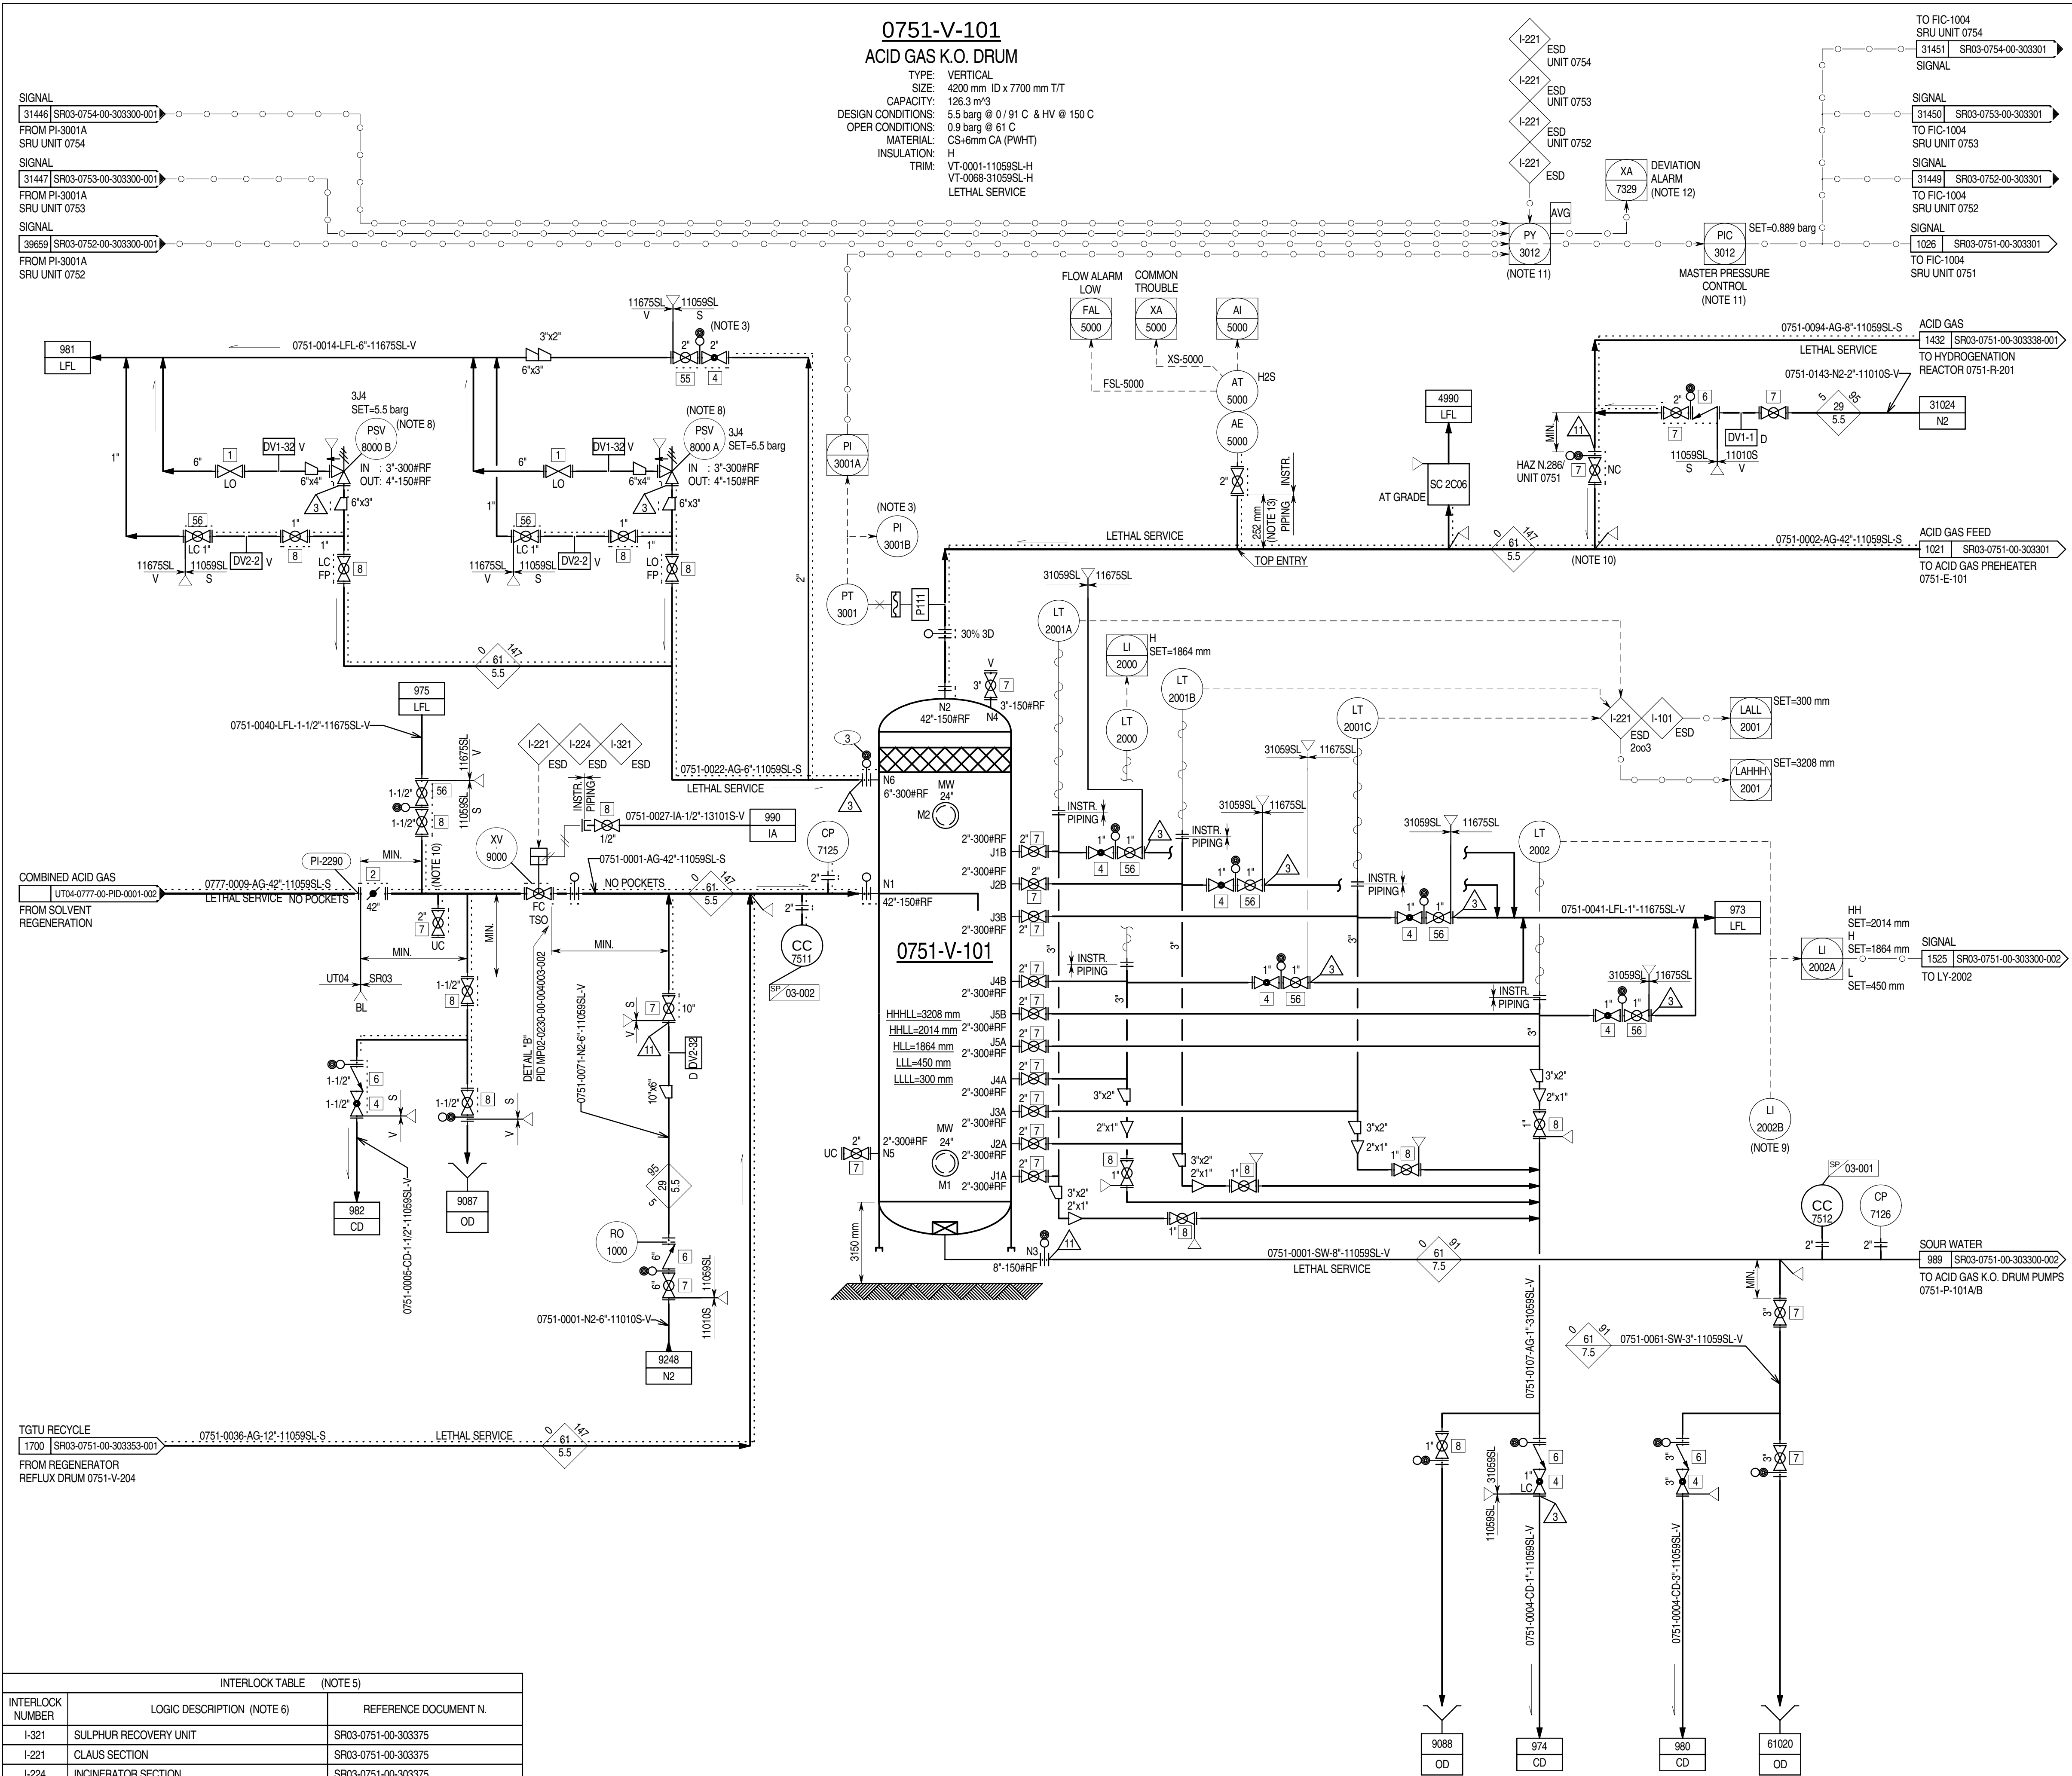

Z1	04-11-14	IAB	ISSUED FOR AS BUILT	PCA	MAR	ASP
2.1D	18-04-14	IFC	ISSUED FOR CONSTRUCTION	PCA	MAR	ASP
2.1C	01-05-13	IFC	ISSUED FOR CONSTRUCTION	RL	CN	MZ
2.1B	06-08-12	IFC	ISSUED FOR CONSTRUCTION	DSC	CBR	SIN
2	02-12-11	IFC	ISSUED FOR CONSTRUCTION	DSC	CBR	SIN
1	28-07-11	IFCH	ISSUED FOR CONSTRUCTION WITH HOLDS	DSC	CBR	SIN
0	15-02-11	IFD	ISSUED CLIENT COMMENTS INCORPORATED	BSC	LMA	SIN
B1	30-09-10	ICR	ISSUED FOR CLIENT REVIEW	BSC	LMA	SIN
REV	DATE	STATUS	STATUS DESCRIPTION	BY	CKD	APP.

COMPANY:

Abu Dhabi Gas Development Co. Ltd.



CONTRACTOR:





JOB No. 032090

PROJECT:

SHAH GAS DEVELOPMENT (SGD) PROJECT

AGREEMENT No. 13525001


DRAWING TITLE:

PIPING & INSTRUMENT DIAGRAM UNIT 0751
SULPHUR RECOVERY AND TAIL GAS TREATING UNIT

EQUIPMENT DESCRIPTION	ACID GAS KO DRUM
TAGITEM No.	0751-V-101

CONTRACTOR DRG. No.	751-GD-B-303300	REV. Z1
COMPANY DRG. No.	SR03-0751-00-303300-001	
SCALE:	SIZE: A1	
DOC. CLASS: 1		

RATED FLOW:	75.0 m3/hr
DIFFERENTIAL HEAD:	37.5 m
SG @ OP TEMP:	0.982 @ 61.0 C
SUCTION PRESSURE:	1.2 barg
DISCHARGE PRESSURE:	4.8 barg
DESIGN TEMPERATURE:	0/191 C & HV @ 150 C
MATERIAL:	DUPLEX 2205
DRIVER:	15.0 kW
SPEED:	2930 rpm
TRIM:	---

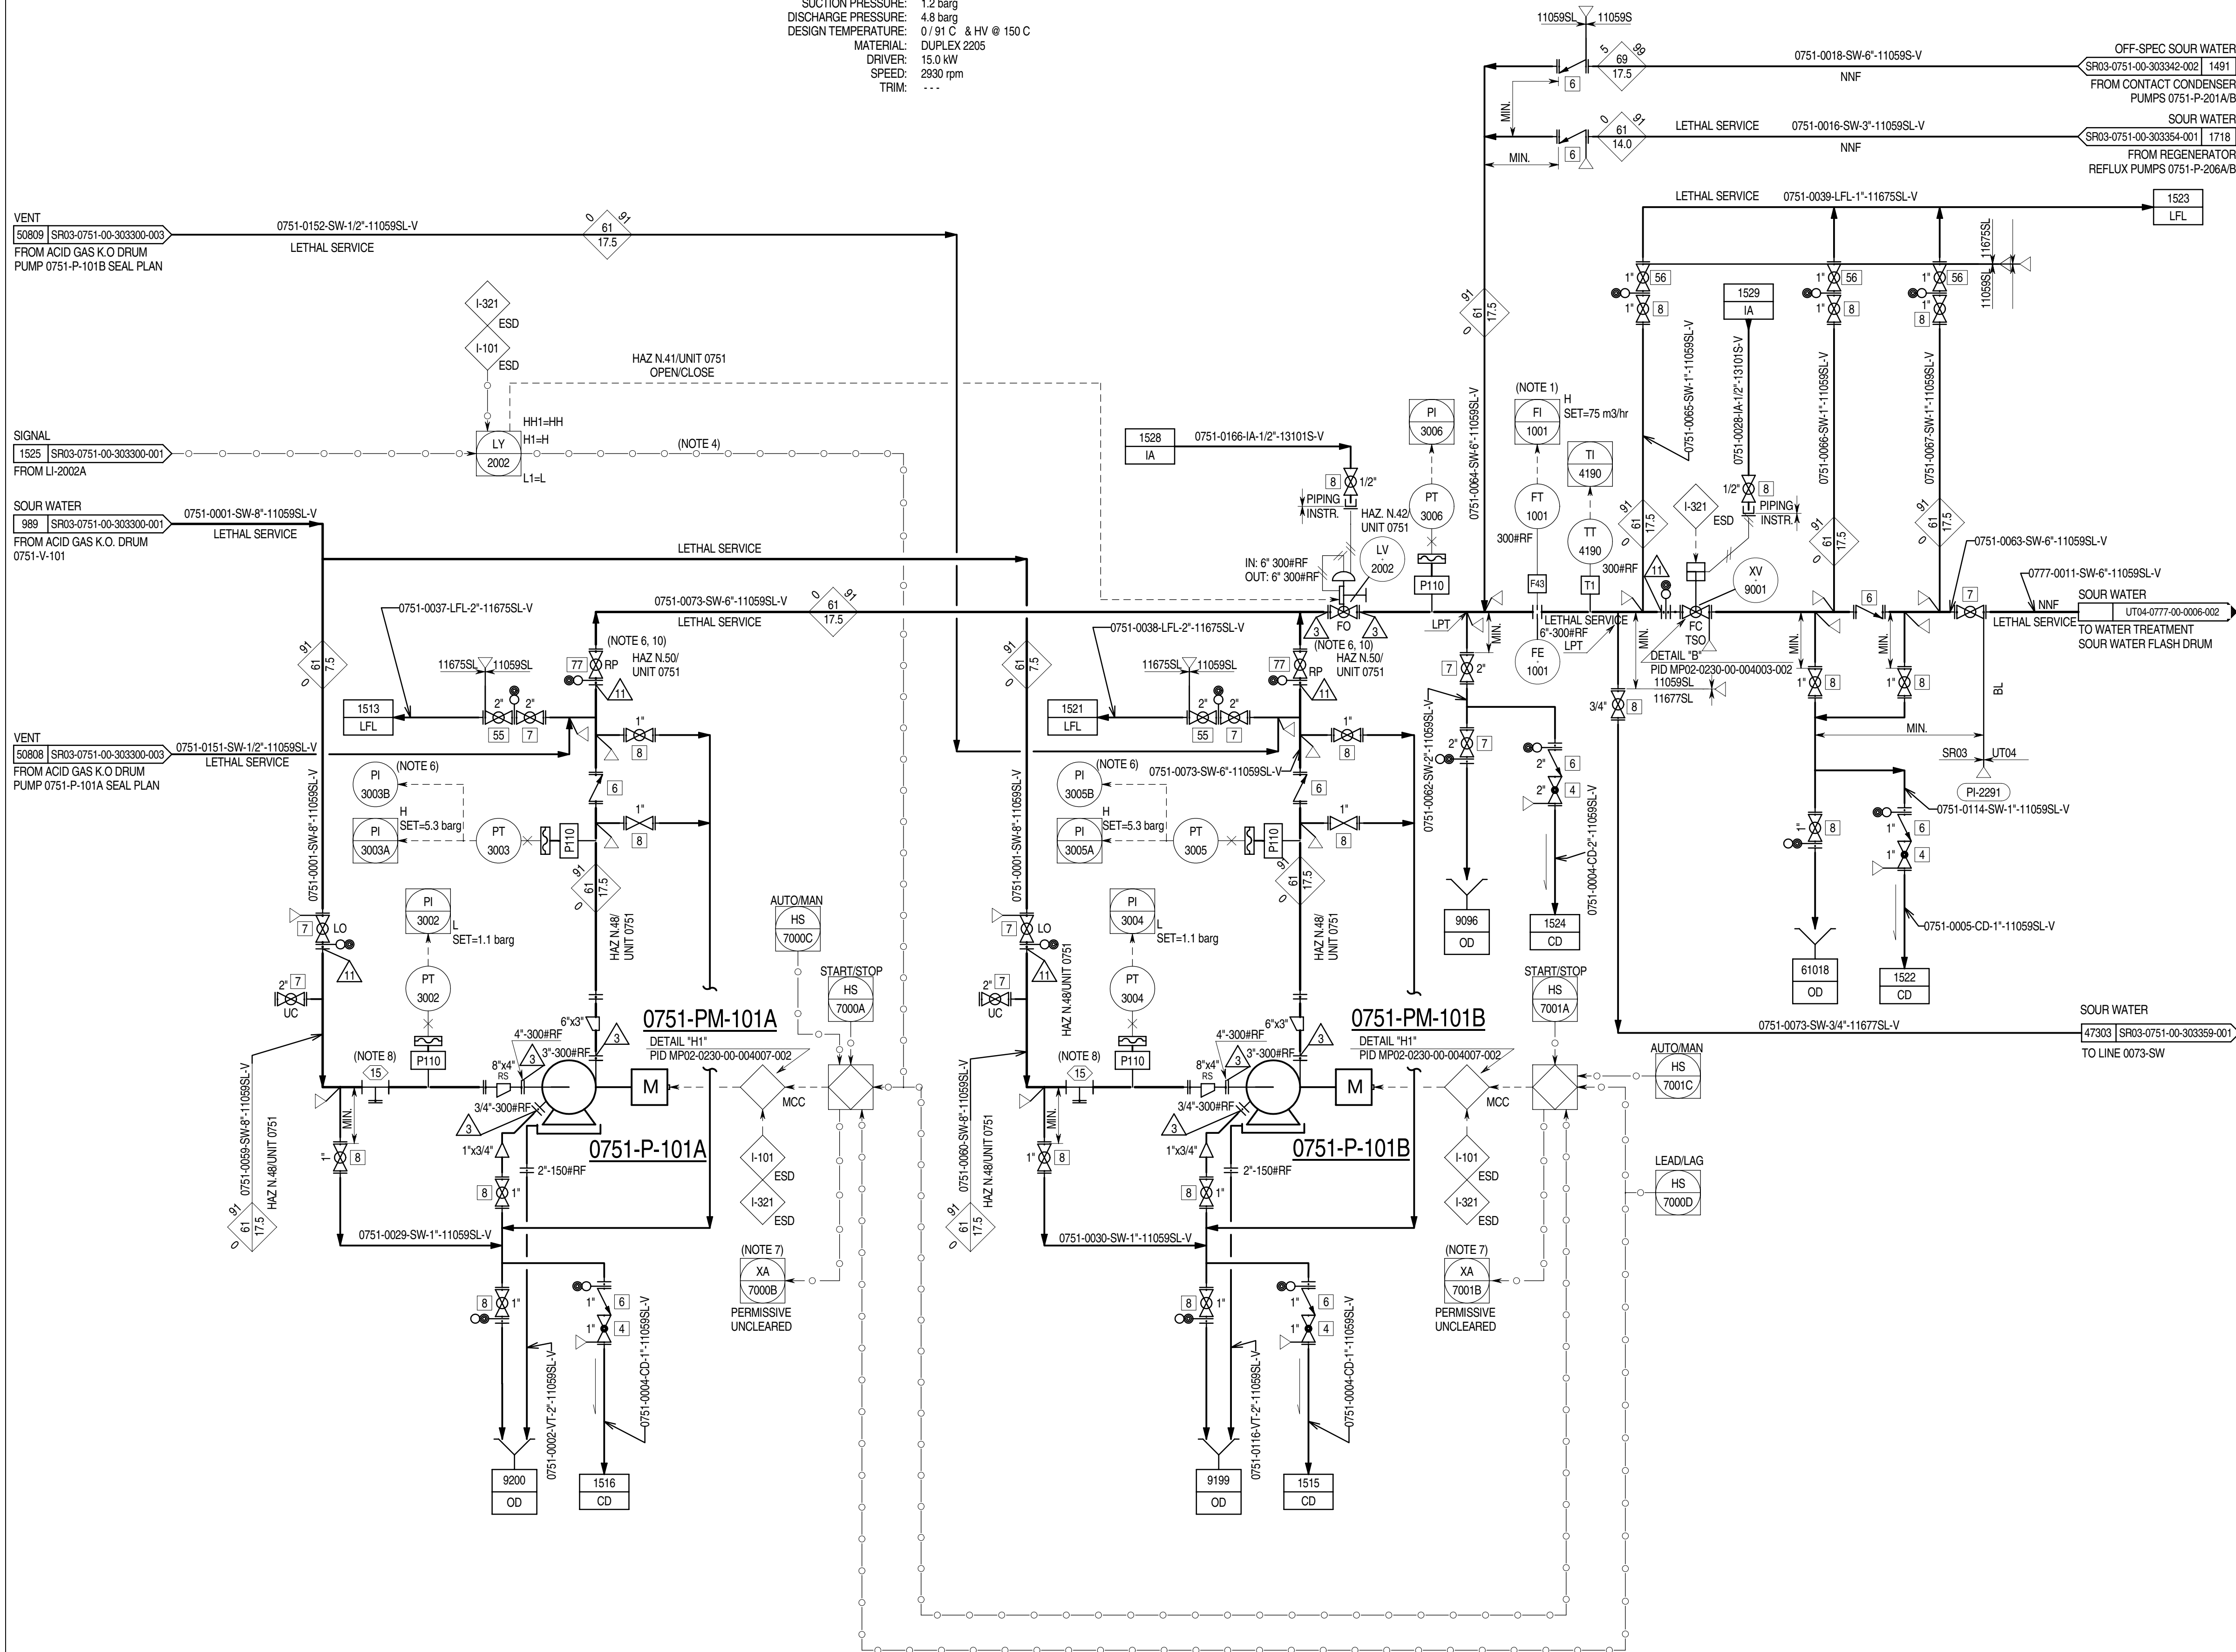

INTERLOCK TABLE (NOTE 2)		
INTERLOCK NUMBER	LOGIC DESCRIPTION (NOTE 3)	REFERENCE DOCUMENT N.
I-321	SULPHUR RECOVERY UNIT	SR03-0751-00-303375
I-101	ACID GAS KO DRUM	SR03-0751-00-303375

GENERAL NOTES:

1. FOR STANDARD SYMBOLS, DETAILS, ABBREVIATIONS, SAMPLE CONNECTION TYPE, GENERAL NOTES & LEGEND SHEETS REFER TO DRAWING NO. MPO2-0230-00-004000 TO 004015.
2. ALL INSTRUMENT TAG NUMBERS ON THIS P&ID INCLUDING PACKAGE UNITS ARE PREFIXED WITH UNIT NUMBER 0751 UNLESS OTHERWISE NOTED.
3. DELETED.

NOTES:

1. HIGH FLOW ALARM TO BE DUPLICATED AT WASTE WATER TREATMENT UNIT 0775.
2. INTERLOCK TABLE IS FOR REFERENCE ONLY. CAUSE AND EFFECT MATRIX SR03-0751-00-CCC-303155 SHALL COVER.
3. REFER TO CAUSE AND EFFECT CHART FOR FULL REPRESENTATION OF INTERLOCK INITIATORS AND ACTIONS.
4. LAH-2002 STARTS LEAD PUMP. LAHH-2002 STARTS LAG PUMP SO THAT BOTH RUN SIMULTANEOUSLY PRIOR TO TRIP AT LAHHH-2001. LAL-2002 STOP OPERATING PUMP(S).
5. DELETED.
6. LOCAL PI TO BE READABLE FROM CORRESPONDING PUMP DISCHARGE ISOLATION VALVE.
7. REFER TO PROCESS CONTROL NARRATIVE DOC. N. SR03-0751-00-SPE-303163 FOR PERMISSIVE TO START CONDITIONS.
8. STRAINER WITH SCREEN 48 MESH (TEMPORARY) 48 MESH (PERMANENT).
9. PUMPS ARE 2x100% L1 LEAD AND L1 LAG.
10. 0751-P-101A/B DISCHARGE RP MINIMUM BORE ONE SIZE BELOW STAND A/R B BLOCK VALVES WILL BE CATCHED IN INTERMEDIATE POSITION AFTER TO HAVE ADJUSTED THE VALVE'S OPENING PERCENTAGE IN ORDER TO OBTAIN THE RIGHT BACK PRESSURE.

HAZ N 50/101 0751

UTILITY REFERENCE TABLE		
IA	DRW. N°.	SR03-0751-00-PID-362305
CD	DRW. N°.	SR03-0751-00-PID-362306
OD	DRW. N°.	SR03-0751-00-PID-362307
LFL	DRW. N°.	SR03-0751-00-PID-362313

Z1	04-11-14	IAB	ISSUED FOR AS BUILT	PCA	MAR	ASP
2.1D	18-04-14	IFC	ISSUED FOR CONSTRUCTION	PCA	MAR	ASP
2.1C	01-05-13	IFC	ISSUED FOR CONSTRUCTION	RL	CN	MZ
2.1B	06-08-12	IFC	ISSUED FOR CONSTRUCTION	DSC	CBR	SIN
2	02-12-11	IFC	ISSUED FOR CONSTRUCTION	DSC	CBR	SIN
1	28-07-11	IFCH	ISSUED FOR CONSTRUCTION WITH HOLDS	DSC	CBR	SIN
0	15-02-11	IFD	ISSUED CLIENT COMMENTS INCORPORATED	BSC	LMA	SIN
B1	30-09-10	ICR	ISSUED FOR CLIENT REVIEW	BSC	LMA	SIN
REV	DATE	STATUS	STATUS DESCRIPTION	BY	CKD	APP.

COMPANY:

Abu Dhabi Gas Development Co. Ltd.



CONTRACTOR:

 **saipem**

JOB No. 032090

PROJECT: SHAH GAS DEVELOPMENT (SGD) PROJECT


AGREEMENT No. 13525001

<u>DRAWING TITLE:</u> PIPING & INSTRUMENT DIAGRAM UNIT 0751 SULPHUR RECOVERY AND TAIL GAS TREATING UNIT	
EQUIPMENT DESCRIPTION	ACID GAS KO DRUM PUMPS
TAGITEM No.	0751-P-101A / B

CONTRACTOR DRG. No.		751-GD-B-303300		REV. Z1
COMPANY DRG. No.		SR03-0751-00-303300-002		
SCALE:	SIZE:	A1	DOC. CLASS: 1	


THIS DOCUMENT IS THE PROPERTY OF ABU DHABI GAS DEVELOPMENT COMPANY LIMITED AND CONTAINS INFORMATION WHICH IS PROPRIETARY. THIS INFORMATION IS TO BE HELD IN CONFIDENCE. NO DISCLOSURE OR OTHER USE OF THIS DOCUMENT IS TO BE MADE WITHOUT THE PRIOR WRITTEN CONSENT OF ABU DHABI GAS DEVELOPMENT COMPANY LIMITED.

PLAN 11/53B FOR OH PUMPS

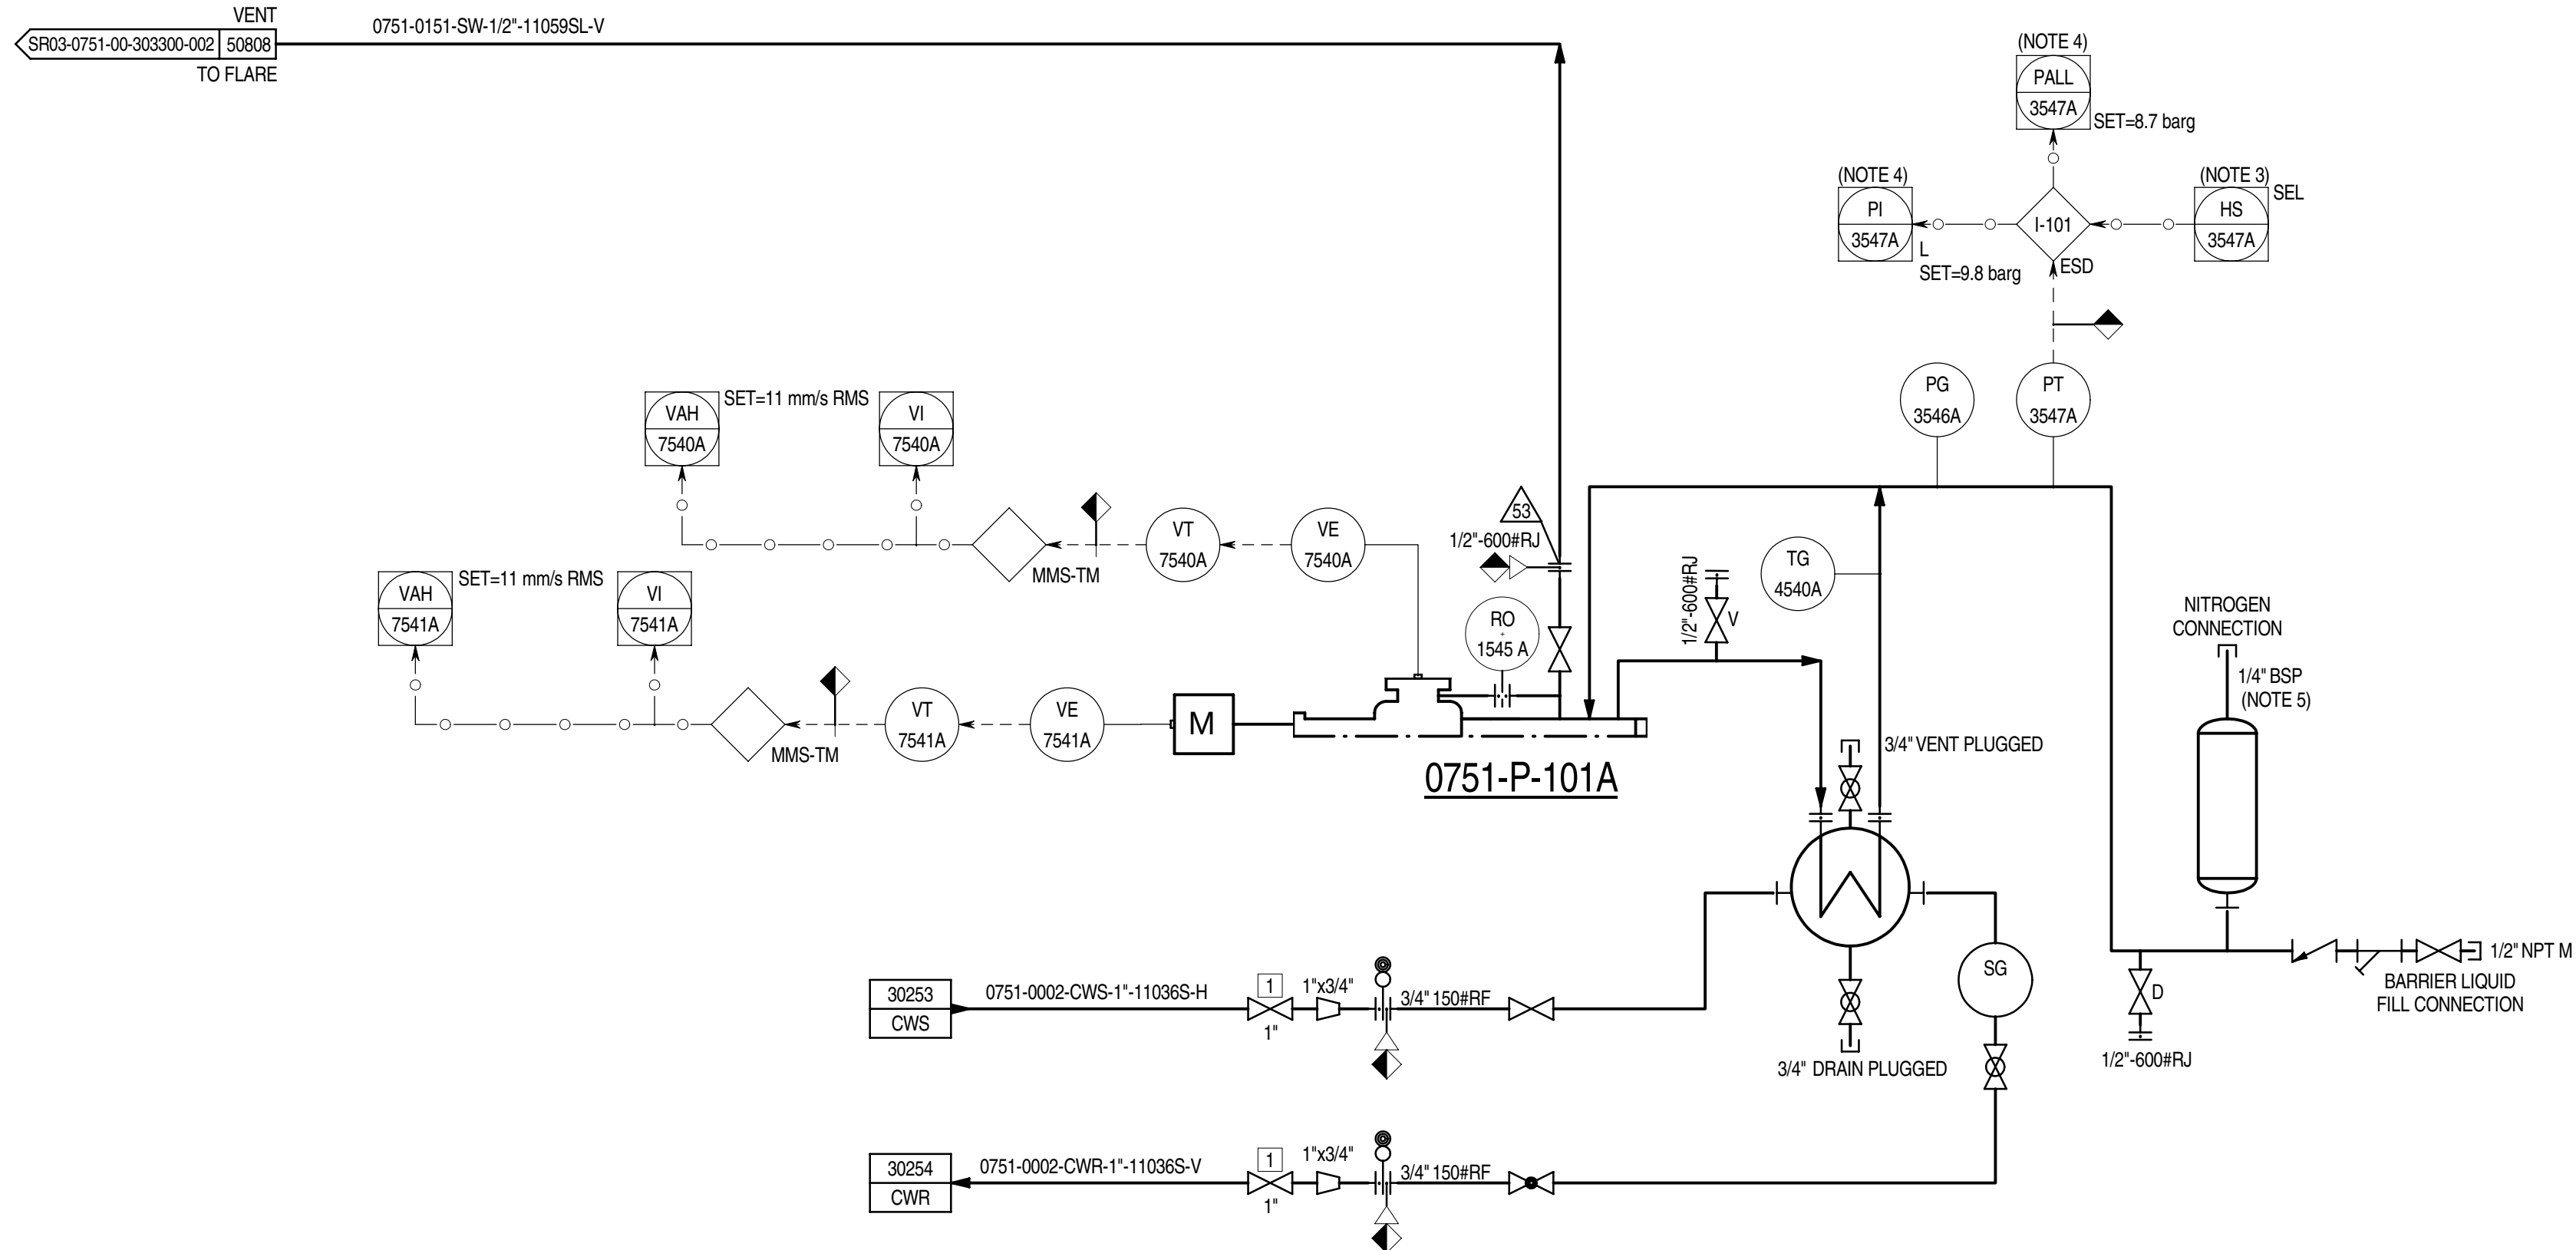

UTILITY REFERENCE TABLE	
CWS/CWR	DRW. N°. SR03-0751-00-PID-362308

PLAN 11/53B FOR OH PUMPS

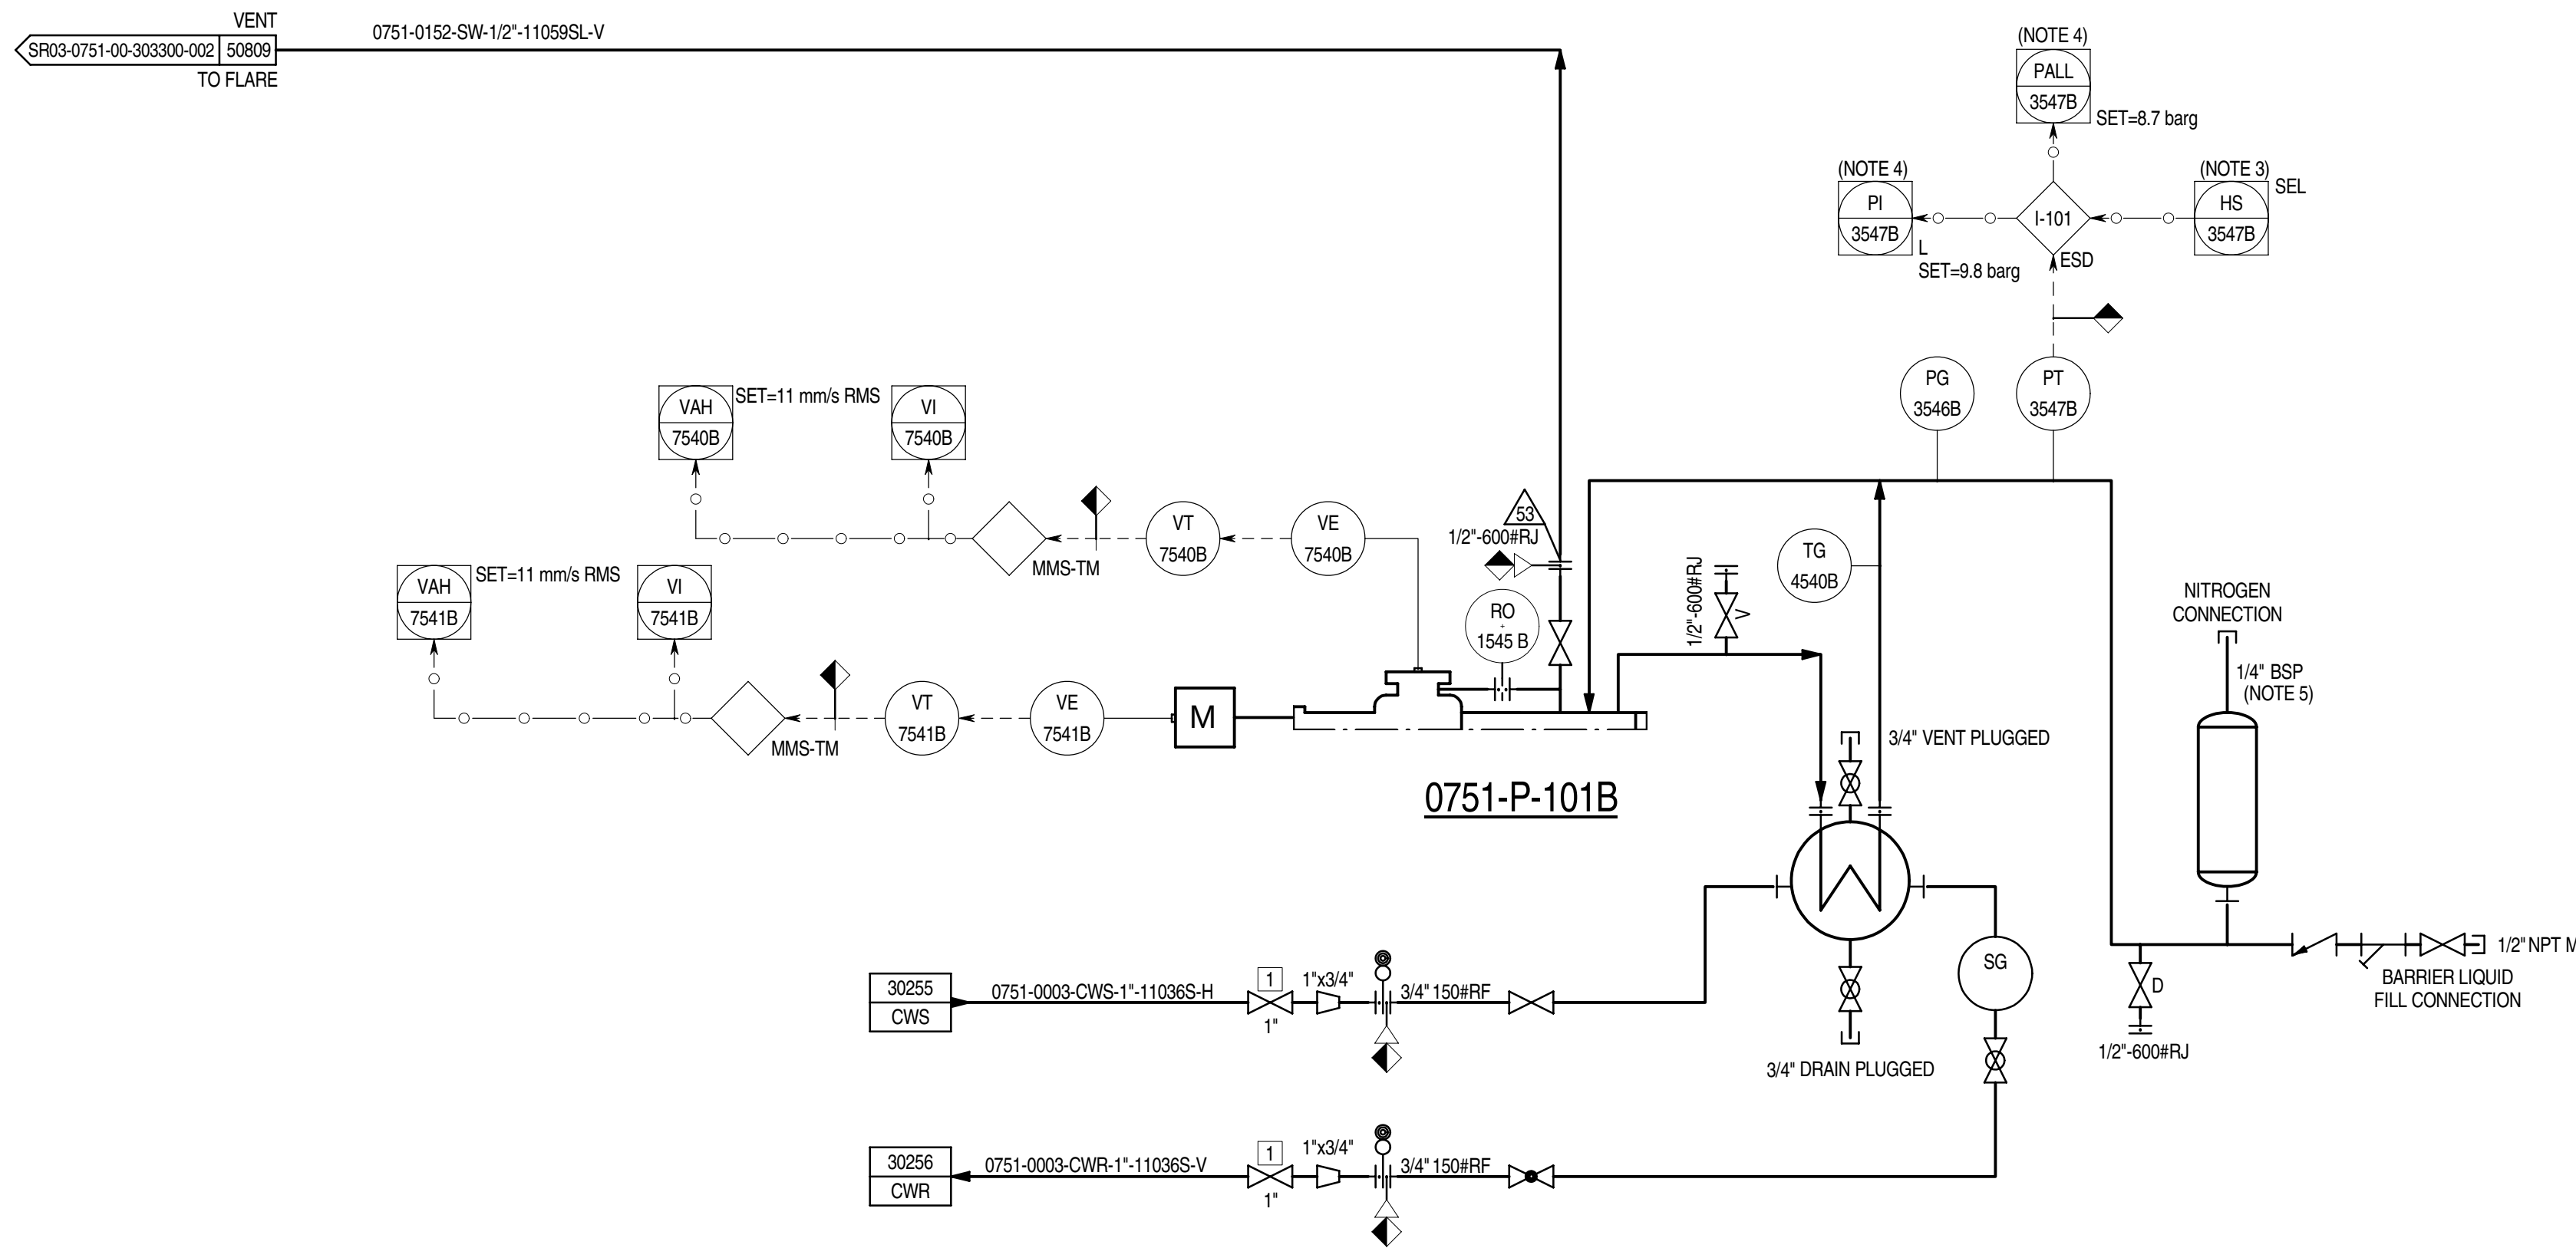

INTERLOCK TABLE (NOTE 1)		
INTERLOCK NUMBER	LOGIC DESCRIPTION (NOTE 2)	REFERENCE DOCUMENT N. (TDR)
I-101	ACID GAS KO DRUM	SR03-0751-00-303375

- GENERAL NOTES:**
- FOR STANDARD SYMBOLS, DETAILS, ABBREVIATIONS, SAMPLE CONNECTION TYPE, GENERAL NOTES & LEGEND SHEETS REFER TO DRAWING NO. MP02-0230-00-004000 TO 004015.
 - ALL INSTRUMENT TAG NUMBERS ON THIS P&ID INCLUDING PACKAGE UNITS ARE PREFIXED WITH UNIT NUMBER 0751 UNLESS OTHERWISE NOTED.
 - DELETED.
- NOTES:**
- INTERLOCK TABLE IS FOR REFERENCE ONLY. CAUSE AND EFFECT MATRIX SR03-0751-00-CC-30155 SHALL GOVERN.
 - REFER TO CAUSE AND EFFECT CHART FOR FULLY REPRESENTATION OF INTERLOCK INITIATORS AND ACTIONS.
 - SELECTOR TO ACTIVATE EITHER ALARM ONLY OR ALARM AND TRIP.
 - ALARM AND TRIP VALUES BY PUMP VENDOR.
 - BSP = BRITISH STANDARD PIPE.

Z1	04-11-14	IAB	ISSUED FOR AS BUILT	PCA	MAR	ASP
2.1D	18-04-14	IFC	ISSUED FOR CONSTRUCTION	PCA	MAR	ASP
2.1C	10-03-13	IFC	ISSUED FOR CONSTRUCTION	RL	CN	MZ
2.1B	06-08-12	IFC	ISSUED FOR CONSTRUCTION	DSC	CBR	SIN
2	02-12-11	IFC	ISSUED FOR CONSTRUCTION	DSC	CBR	SIN
1	28-07-11	IFCH	ISSUED FOR CONSTRUCTION WITH HOLDS	DSC	CBR	SIN
REV	DATE	STATUS	STATUS DESCRIPTION	BY	CKD	APP.

COMPANY:

Abu Dhabi Gas Development Co. Ltd.

CONTRACTOR:

JOB No. 032090

PROJECT:

SHAH GAS DEVELOPMENT (SGD) PROJECT
SHAH PROCESS PLANT

AGREEMENT No. 13525001


DRAWING TITLE: PIPING & INSTRUMENT DIAGRAM UNIT 0751 SULPHUR RECOVERY AND TAIL GAS TREATING UNIT	
EQUIPMENT DESCRIPTION	API PLAN 0751-P-101A/B AND VIBRATION MONITORING
TAGITEM No.	

CONTRACTOR DRG.No.	751-GD-B-303300	REV. Z1
COMPANY DRG.No.	SR03-0751-00-303300-003	
SCALE:	SIZE: A1 DOC. CLASS: 1	

THIS DOCUMENT IS THE PROPERTY OF ABU DHABI GAS DEVELOPMENT COMPANY LIMITED AND CONTAINS INFORMATION WHICH IS PROPRIETARY. THIS INFORMATION IS TO BE HELD IN CONFIDENCE. NO DISCLOSURE OR OTHER USE OF THIS DOCUMENT IS TO BE MADE WITHOUT THE PRIOR WRITTEN CONSENT OF ABU DHABI GAS DEVELOPMENT COMPANY LIMITED.

0751-B-101A/B COMBUSTION AIR BLOWER

RATED FLOW: 147259 m³/h
SUCTION PRESSURE: 1.0 bara
DISCHARGE PRESSURE: 1.994 bara
DESIGN TEMPERATURE: 170 C
MATERIAL: CS
DRIVER: 4.2 MW
SPEED: 7759.0 rpm

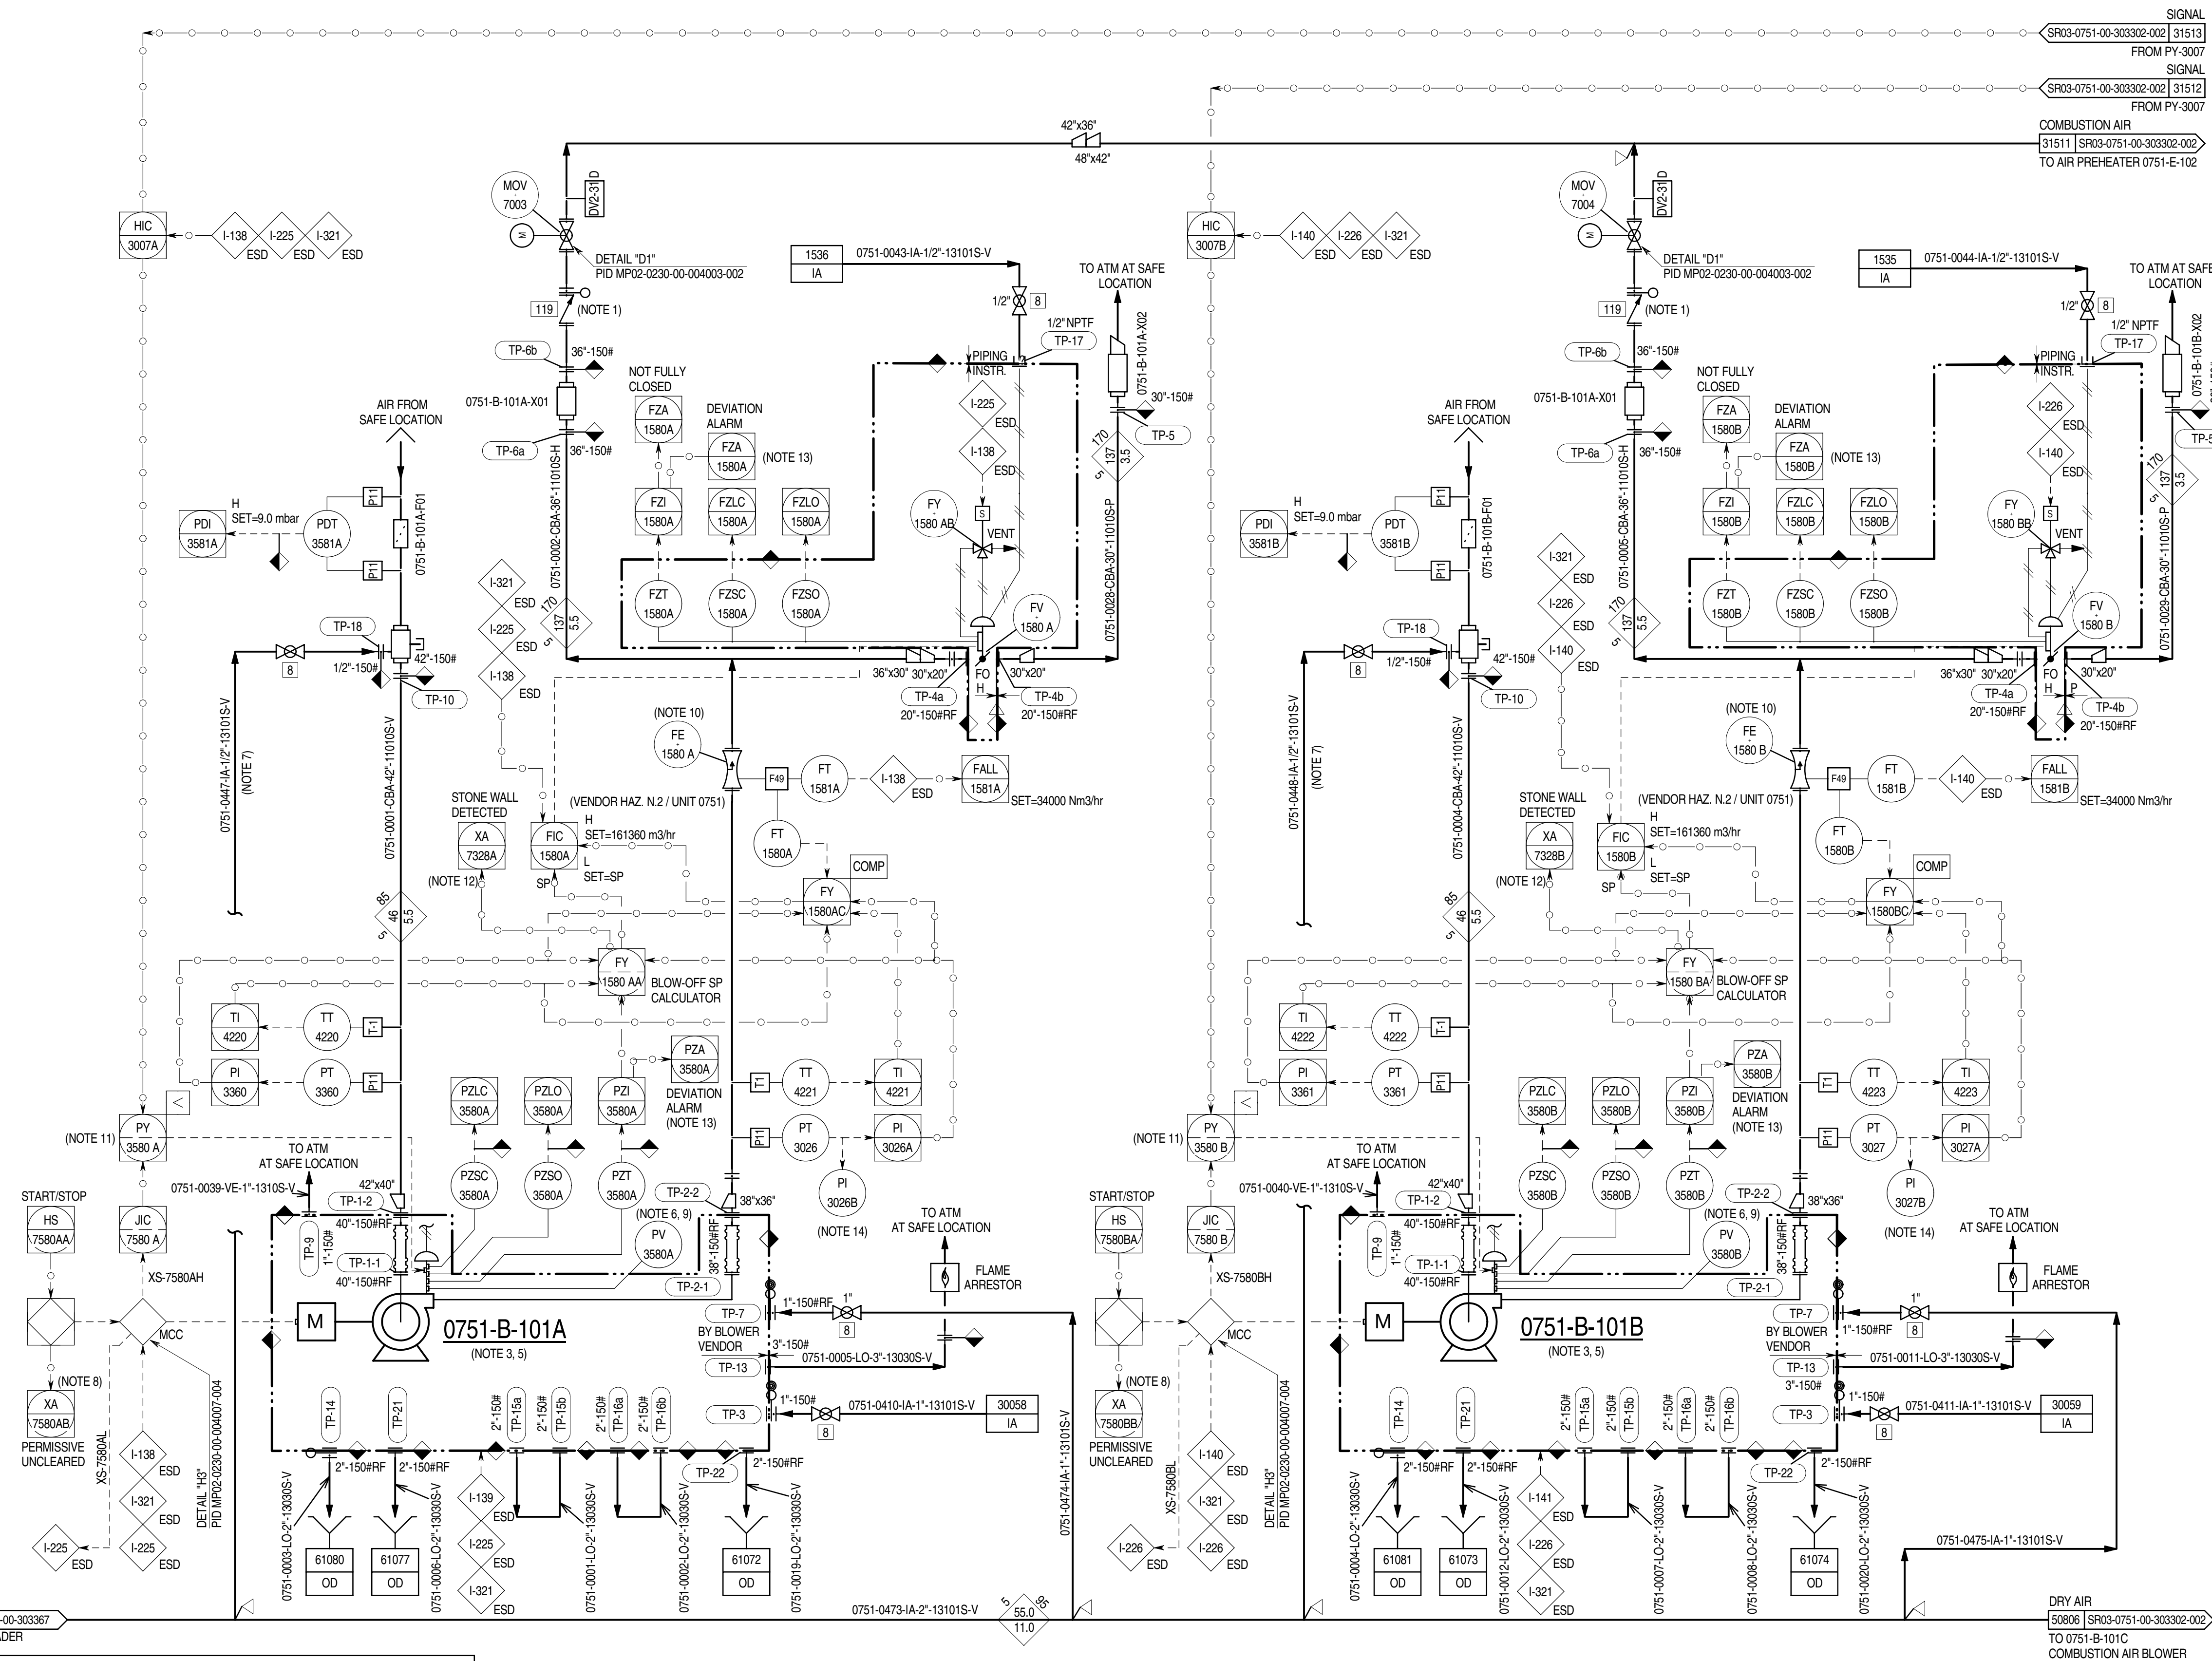

GENERAL NOTES:

- FOR STANDARD SYMBOLS, DETAILS, ABBREVIATIONS, SAMPLE CONNECTION TYPE, GENERAL NOTES & LEGEND SHEETS REFER TO DRAWING NO. MP02-0230-00-004000 TO 004015.
- ALL INSTRUMENT TAG NUMBERS ON THIS P&ID INCLUDING PACKAGE UNITS ARE PREFIXED WITH UNIT NUMBER 0751 UNLESS OTHERWISE NOTED.
- DELETED.
- DELETED.
- BLOWERS TO BE LOCATED OUTSIDE OF STRUCTURE AND INTAKE FILTERS TO BE IN OPEN AREA (DMS PI-002).
- INLET GUIDE VANES (IGV) SUPPLIED WITH BLOWER.
- DRY AIR SUPPLY TO CLEAN BLOWERS' FILTERS.
- REFER TO PROCESS CONTROL NARRATIVE DOC. N° SR03-0751-00-SPE-303163 FOR PERMISSIVE TO START CONDITIONS.
- INLET GUIDE VANES TO BE PROVIDED WITH POSITION TRANSMITTER. POSITION TRANSMITTER IS IN VENDOR SCOPE OF SUPPLY.
- V-CONE TYPE FLOWMETER.
- EACH JIC-7580A/B/C OVERRIDES ITS RELEVANT DISCHARGE PRESSURE CONTROLLER IN CASE OF HIGH ABSORBED POWER. (VENDOR HAZ. N°1/UNIT 0751).
- FOR MORE INFORMATION ABOUT STONE WALL DETECTION REFER TO PROCESS CONTROL NARRATIVE DOC. NO. SR03-0751-00-SPE-303163.
- ALARM WILL BE ACTIVATED WHEN THE DEVIATION BETWEEN THE OUTPUT TO THE POSITION CONTROLLER AND ITS FEEDBACK SIGNAL IS MORE THAN 10% OF RANGE (ADJUSTABLE) FOR MORE THAN 10 SECONDS (ADJUSTABLE).
- PI-3026B AND PI-3027B TO BE READABLE FROM GRADE OR PLATFORM.

UTILITY REFERENCE TABLE		
IA	DRW. N°	SR03-0751-00-PID-362305
OD	DRW. N°	SR03-0751-00-PID-362307

Z1	04-11-14	IAB	ISSUED FOR AS BUILT	PCA	MAR	ASP
2.1E	18-04-14	IFC	ISSUED FOR CONSTRUCTION	PCA	MAR	ASP
2.1D	28-02-14	IFC	ISSUED FOR CONSTRUCTION	PCA	MAR	ASP
2.1C	01-05-13	IFC	ISSUED FOR CONSTRUCTION	RL	CN	MZ
2.1B	06-08-12	IFC	ISSUED FOR CONSTRUCTION	DSC	CBR	SIN
2	02-12-11	IFC	ISSUED FOR CONSTRUCTION	DSC	CBR	SIN
1	28-07-11	IFCH	ISSUED FOR CONSTRUCTION WITH HOLDS	DSC	CBR	SIN
0	15-02-11	IFD	ISSUED CLIENT COMMENTS INCORPORATED	BSC	LMA	SIN
B1	30-09-10	ICR	ISSUED FOR CLIENT REVIEW	BSC	LMA	SIN
REV	DATE	STATUS	STATUS DESCRIPTION	BY	CKD	APP.

COMPANY:

Abu Dhabi Gas Development Co. Ltd.

الحصن للغاز
Al Hosn Gas

CONTRACTOR:

eni saipem

JOB No. 032090

PROJECT:

SHAH GAS DEVELOPMENT (SGD) PROJECT

AGREEMENT No. 13525001

DRAWING TITLE: PIPING & INSTRUMENT DIAGRAM UNIT 0751
SULPHUR RECOVERY AND TAIL GAS TREATING UNIT

EQUIPMENT DESCRIPTION	COMBUSTION AIR BLOWERS
TAGITEM No.	0751-B-101A/B

CONTRACTOR DRG. No.	751-GD-B-303302	REV. Z1
COMPANY DRG. No.	SR03-0751-00-303302-001	
SCALE:	SIZE: A1	DOC. CLASS: 1

UTILITY REFERENCE TABLE		
IA	DRW. N°.	SR03-0751-00-PID-362305
OD	DRW. N°.	SR03-0751-00-PID-362307

Z1	04-11-14	IAB	ISSUED FOR AS BUILT	PCA	MAR	AS
2.1E	18-04-14	IFC	ISSUED FOR CONSTRUCTION	PCA	MAR	AS
2.1D	28-02-14	IFC	ISSUED FOR CONSTRUCTION	PCA	MAR	AS
2.1C	10-03-13	IFC	ISSUED FOR CONSTRUCTION	RL	CN	M
2.1B	06-08-12	IFC	ISSUED FOR CONSTRUCTION	DCS	CBR	SI
2	02-12-11	IFC	ISSUED FOR CONSTRUCTION	DCS	CBR	SI
REV	DATE	STATUS	STATUS DESCRIPTION	BY	CKD	AP

الحصن للغاز
Al Hosn Gas




SHAH GAS DEVELOPMENT (SGD) PROJECT

DRAWING TITLE: PIPING & INSTRUMENT DIAGRAM UNIT 0751
SULPHUR RECOVERY AND TAIL GAS TREATING UNIT

EQUIPMENT DESCRIPTION	COMBUSTION AIR BLOWER
TAG/ITEM No.	0751-B-101C

CONTRACTOR DRG NO.	751-GD-B-303302		REV. Z1
COMPANY DRG. NO.	SR03-0751-00-303302-002		
SCALE:	SIZE: A1	DOC. CLASS: 1	

THIS DOCUMENT IS THE PROPERTY OF ABU DHABI GAS DEVELOPMENT COMPANY LIMITED AND CONTAINS INFORMATION WHICH IS PROPRIETARY. THIS INFORMATION IS TO BE HELD IN CONFIDENCE. NO DISCLOSURE OR OTHER USE OF THIS DOCUMENT IS TO BE MADE WITHOUT THE PRIOR WRITTEN CONSENT OF ABU DHABI GAS DEVELOPMENT COMPANY LIMITED.

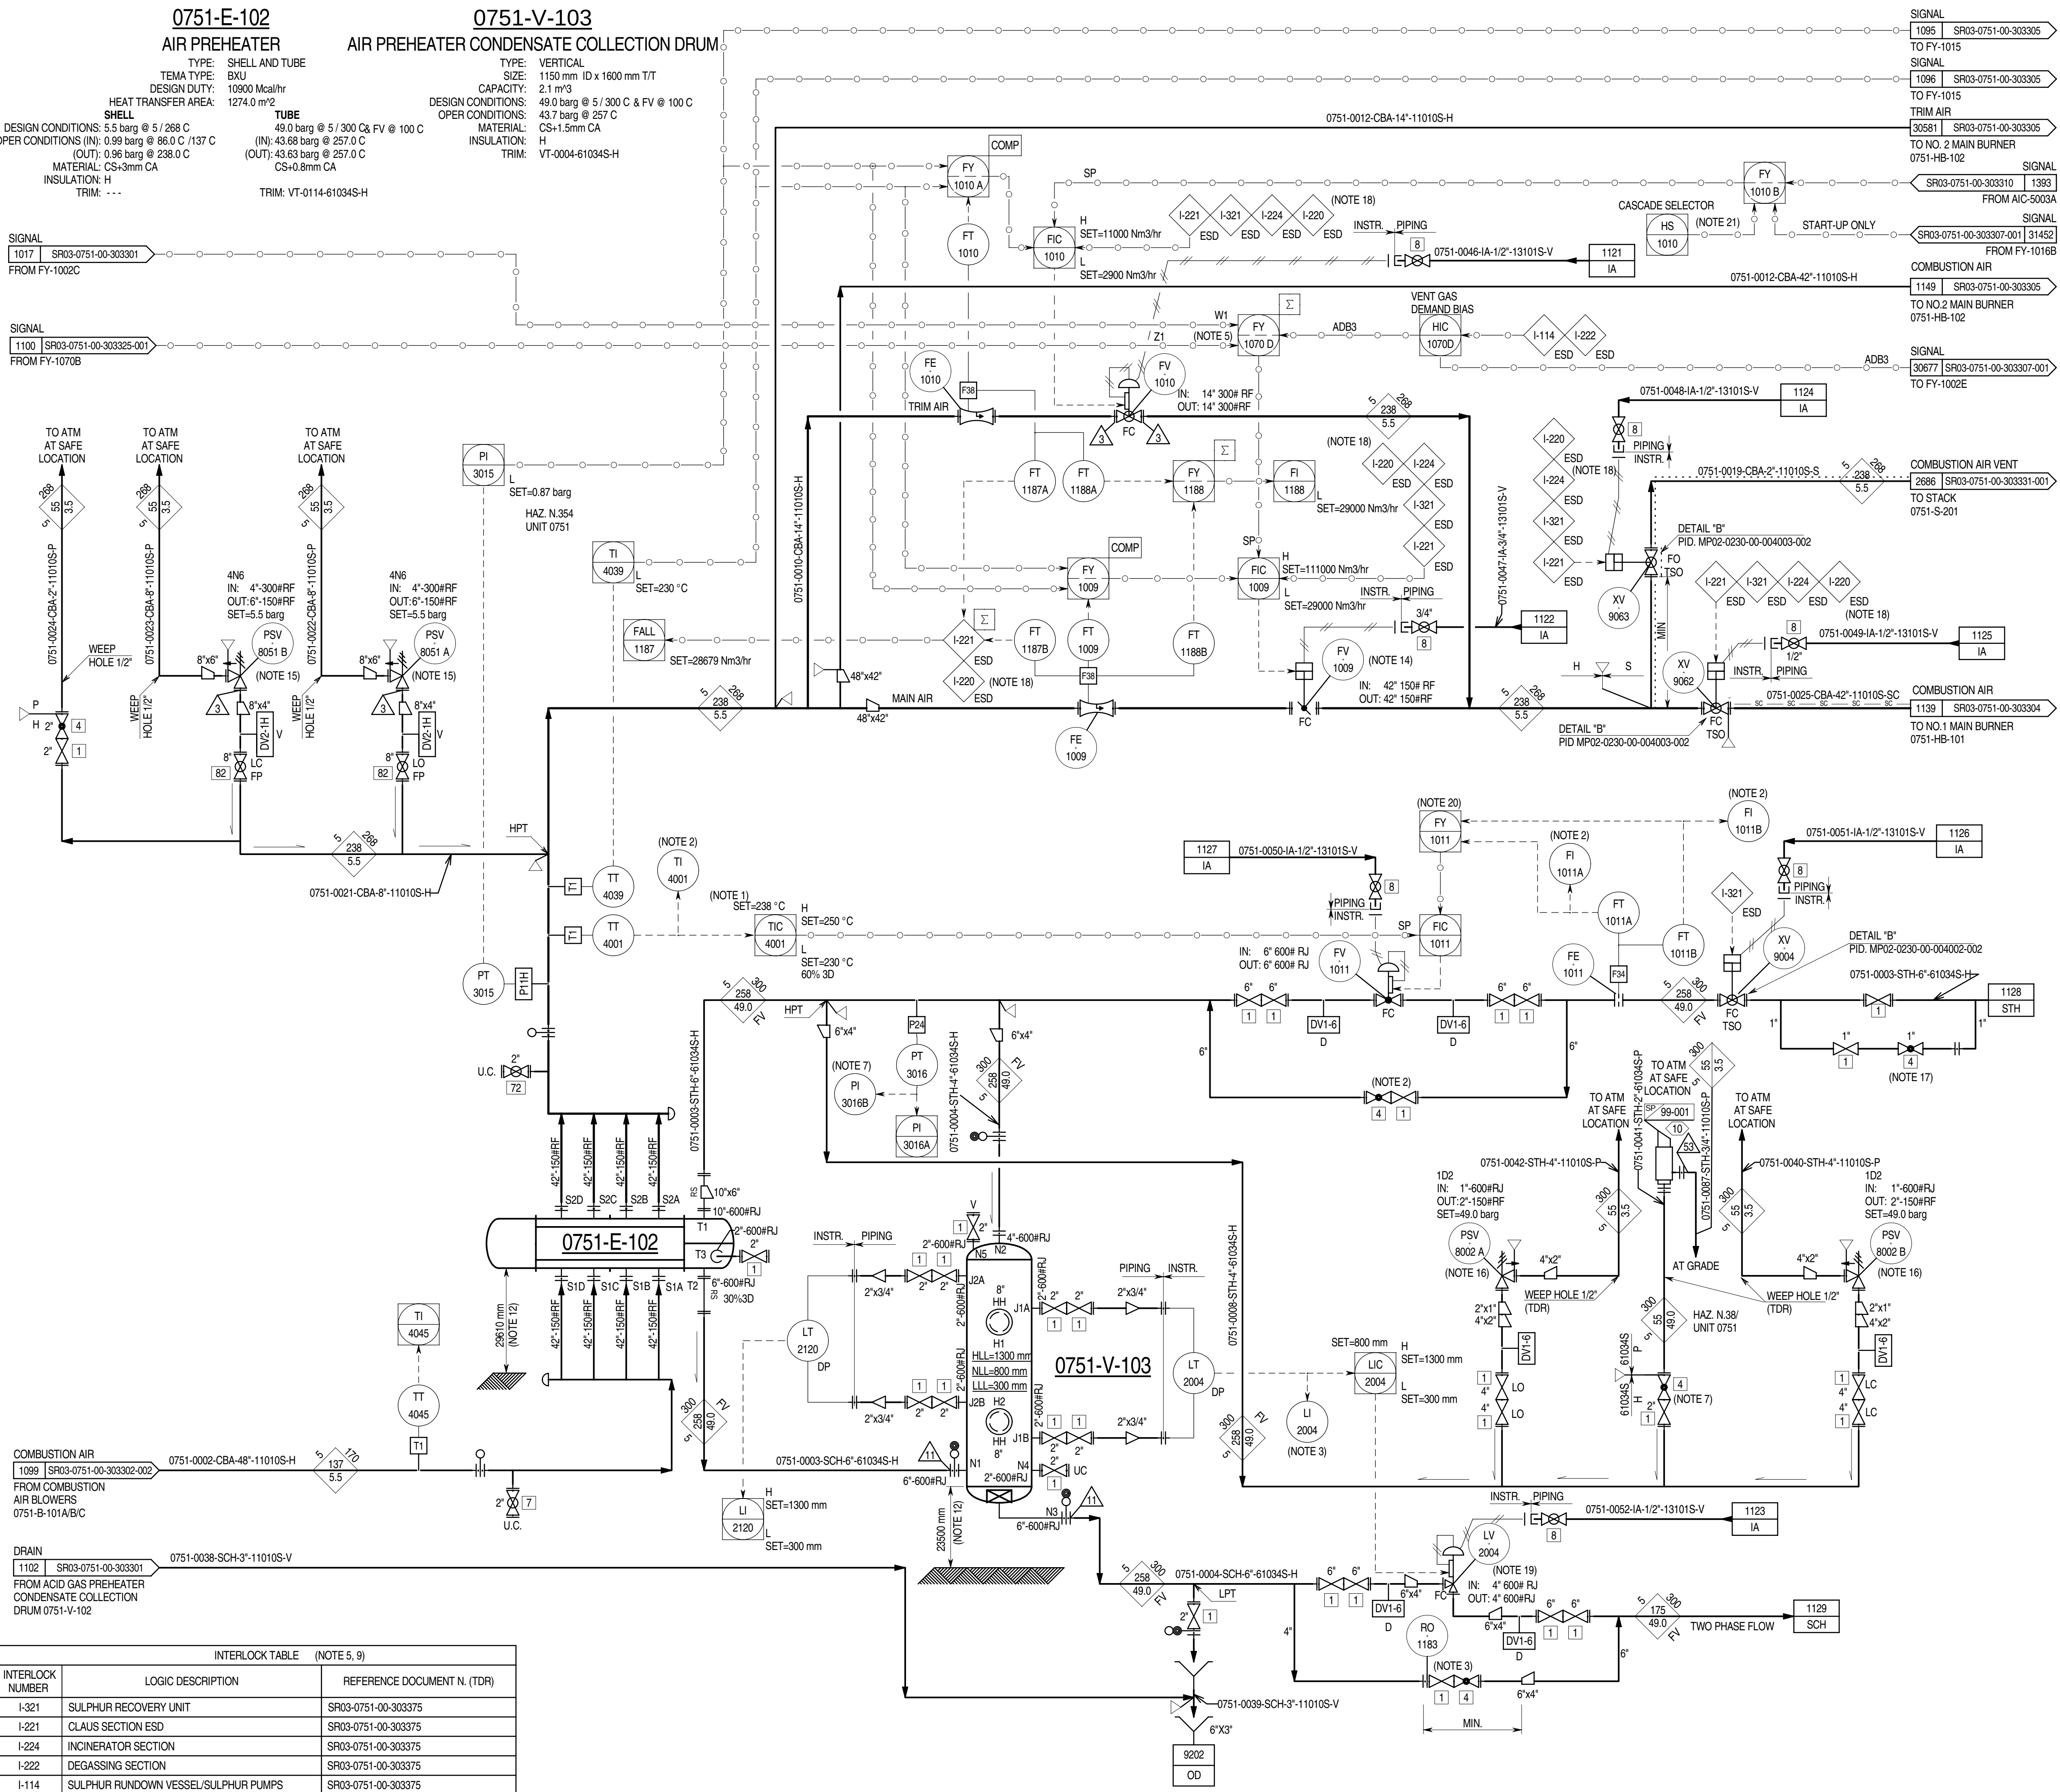

INTERLOCK TABLE (NOTE 5, 9)		
INTERLOCK NUMBER	LOGIC DESCRIPTION	REFERENCE DOCUMENT N. (TDR)
I-321	SULPHUR RECOVERY UNIT	SR03-0751-00-303375
I-221	CLAUS SECTION ESD	SR03-0751-00-303375
I-224	INCINERATOR SECTION	SR03-0751-00-303375
I-222	DEGASSING SECTION	SR03-0751-00-303375
I-114	SULPHUR RUNDOWN VESSEL/SULPHUR PUMPS	SR03-0751-00-303375

- GENERAL NOTES:**
- FOR STANDARD SYMBOLS, DETAILS, ABBREVIATIONS, SAMPLE CONNECTION TYPE. GENERAL NOTES & LEGEND SHEETS REFER TO DRAWING NO. MP02-0230-00-004000 TO 004015.
 - ALL INSTRUMENT TAG NUMBERS ON THIS P&ID INCLUDING PACKAGE UNITS ARE PREFIXED WITH UNIT NUMBER 0751 UNLESS OTHERWISE NOTED.
 - DELETED.
- NOTES:**
- LOCATE PSV/VENT CONNECTION AT HIGH POINT OF STEAM LINE FROM TOP OF PIPE.
 - FI-1011A, FI-1011B AND TI-4001 TO BE READABLE FROM FV-1011 BY-PASS VALVE.
 - LI-2004 TO BE READABLE FROM LV-2004 BY-PASS VALVE.
 - DELETED.
 - SUBTRACT VENT AIR FLOW FROM TOTAL AIR DEMAND.
 - DELETED.
 - PI-3016B TO BE READABLE FROM PSV-8002A/B MANUAL VENT VALVE.
 - INTERLOCK TABLE IS FOR REFERENCE ONLY CAUSE AND EFFECT MATRIX SR03-0751-00-CCC-303155 SHALL GOVERN.
 - REFER TO CAUSE AND EFFECT CHART FOR FULL REPRESENTATION OF INTERLOCK INITIATORS AND ACTIONS.
 - DELETED.
 - DELETED.
 - 0751-E-102 BOTTOM TANGENT LINE TO BE LOCATED 1300mm MIN ABOVE 0751-V-103 HIGH LIQUID LEVEL.
 - DELETED.
 - FV-1009 PROVIDED WITH AIR VOLUME TANK ONLY FOR STROKE FAIL POSITION.
 - PSV SIZING CASE: TUBE RUPTURE.
 - PSV SIZING CASE: FIRE.
 - GLOBE VALVE USED FOR WARM UP.
 - SIGNAL TO BE SEGREGATED. REFERENCE TO BE MADE TO MAIN BURNER AND CLAUS SECTION ESD.
 - 0751-1-220/0751-1-222 LOGIC SYSTEM DESCRIPTION, DOCUMENT N. SR03-0751-00-SPE-303161.
 - VALVE LV-2004 TO BE PROVIDED WITH LOCAL SIGN: "WARNING: TRIM SIZE AFFECTS RELIEF VALVE CAPACITY".
 - NO. 2 TRANSMITTERS SHALL BE PROVIDED TO COVER THE COMPLETE REQUEST INSTRUMENT RANGEABILITY: TRANSMITTER "A" -> LOW RANGE, TRANSMITTER "B" -> HIGH RANGE.
 - CASCADE SELECTOR SHALL BE USED ONLY IF CONTROLLER FIC-1010 IS IN MANUAL MODE AT 0% OUTPUT. DURING START-UP, SET POINT TO FIC-1010 IS PROVIDED BY FY-1016B. DURING NORMAL OPERATION, SET POINT TO FIC-1010 IS PROVIDED BY AIC-5003A.

UTILITY REFERENCE TABLE		
IA	DRW. N°.	SR03-0751-00-PID-362305
OD	DRW. N°.	SR03-0751-00-PID-362307
STH/SCH	DRW. N°.	SR03-0751-00-PID-362312

Z1	20-10-14	IAB	ISSUED FOR AS BUILT	PCA	MAR	ASP
2.1E	18-04-14	IFC	ISSUED FOR CONSTRUCTION	PCA	MAR	ASP
2.1D	28-02-14	IFC	ISSUED FOR CONSTRUCTION	PCA	MAR	ASP
2.1C	10-03-13	IFC	ISSUED FOR CONSTRUCTION	RL	CN	MZ
2.1B	06-08-12	IFC	ISSUED FOR CONSTRUCTION	DSC	CBR	SIN
2	02-12-11	IFC	ISSUED FOR CONSTRUCTION	DSC	CBR	SIN
1	28-07-11	IFCH	ISSUED FOR CONSTRUCTION WITH HOLDS	DSC	CBR	SIN
0	15-02-11	IFD	ISSUED CLIENT COMMENTS INCORPORATED	BSC	LMA	SIN
B1	30-09-10	ICR	ISSUED FOR CLIENT REVIEW	BSC	LMA	SIN
REV	DATE	STATUS	STATUS DESCRIPTION	BY	CKD	APP.

COMPANY:

Abu Dhabi Gas Development Co. Ltd.

CONTRACTOR:

JOB No. 032090

PROJECT:

SHAH GAS DEVELOPMENT (SGD) PROJECT


AGREEMENT No. 13525001

DRAWING TITLE: PIPING & INSTRUMENT DIAGRAM UNIT 0751 SULPHUR RECOVERY AND TAIL GAS TREATING UNIT

EQUIPMENT DESCRIPTION	COMBUSTION AIR CONTROL NO. 1 BURNER
TAGITEM No.	0751-E-102 0751-V-103

CONTRACTOR DRG. No.	751-GD-B-303303	REV.
COMPANY DRG. No.	SR03-0751-00-303303	
SCALE:	SIZE: A1	DOC. CLASS: 1

THIS DOCUMENT IS THE PROPERTY OF ABU DHABI GAS DEVELOPMENT COMPANY LIMITED AND CONTAINS INFORMATION WHICH IS PROPRIETARY. THIS INFORMATION IS TO BE HELD IN CONFIDENCE. NO DISCLOSURE OR OTHER USE OF THIS DOCUMENT IS TO BE MADE WITHOUT THE PRIOR WRITTEN CONSENT OF ABU DHABI GAS DEVELOPMENT COMPANY LIMITED.

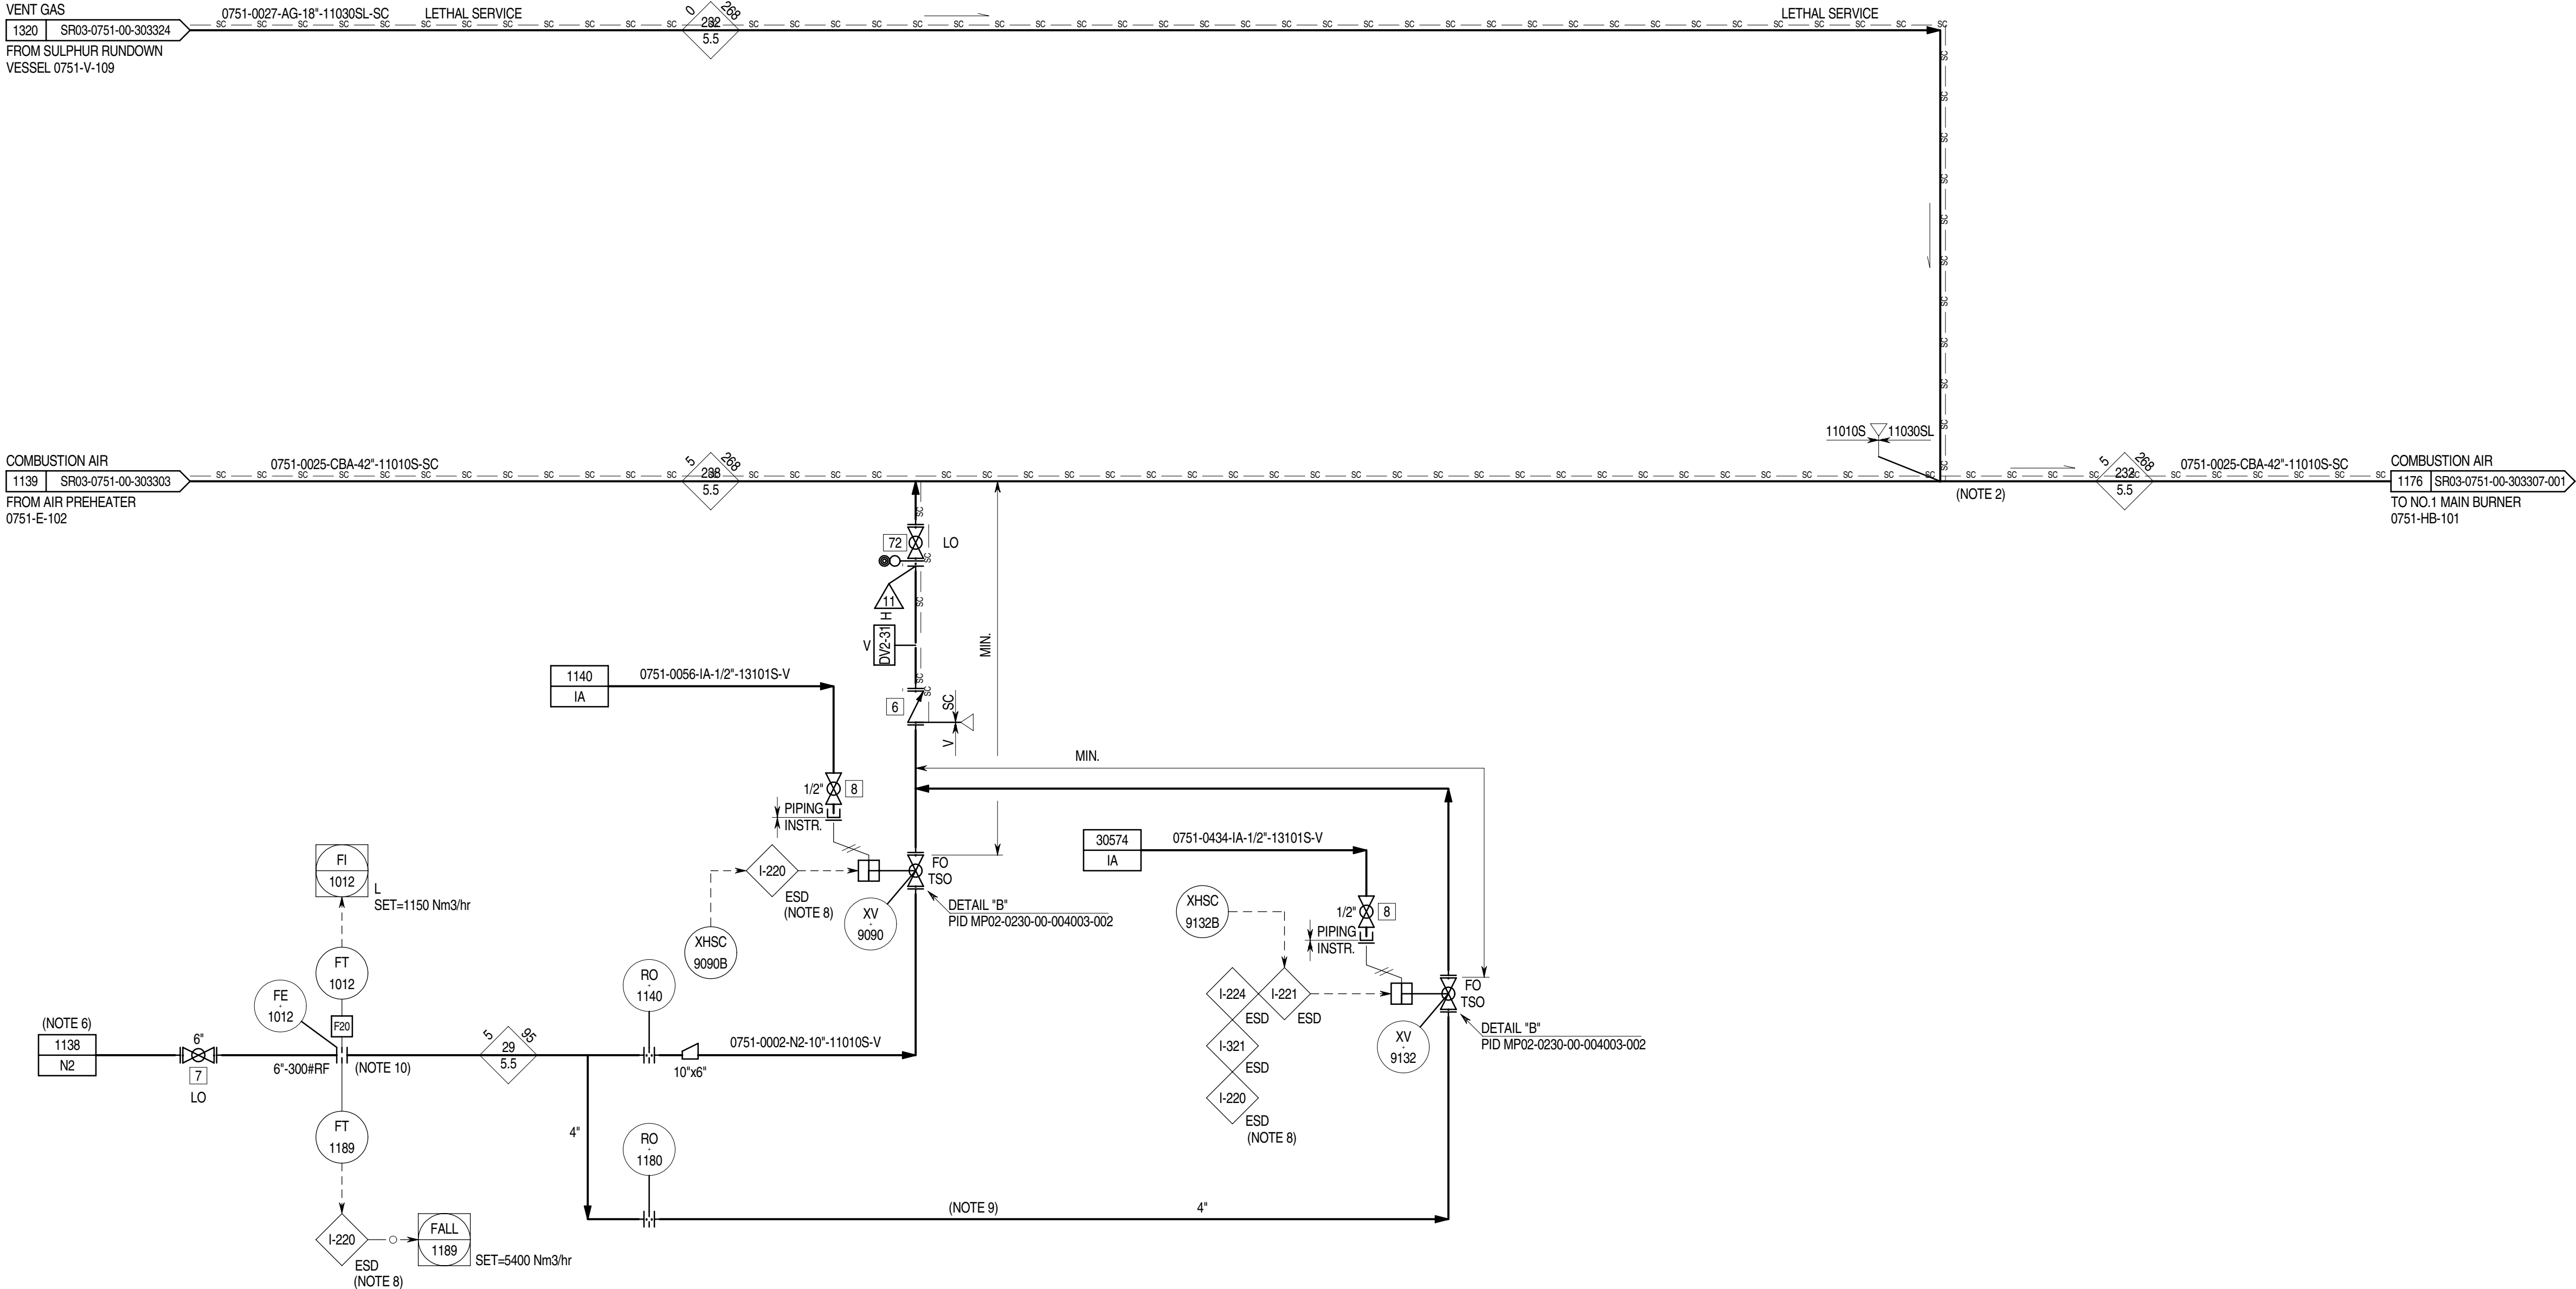

INTERLOCK TABLE (NOTE 4, 5)		
INTERLOCK NUMBER	LOGIC DESCRIPTION	REFERENCE DOCUMENT N.
I-321	SULPHUR RECOVERY UNIT	SR03-0751-00-303375
I-221	CLAUS SECTION	SR03-0751-00-303375
I-224	INCINERATOR SECTION	SR03-0751-00-303375

- GENERAL NOTES:**
- FOR STANDARD SYMBOLS, DETAILS, ABBREVIATIONS, SAMPLE CONNECTION TYPE, GENERAL NOTES & LEGEND SHEETS REFER TO DRAWING NO. MP02-0230-00-004000 TO 004015.
 - ALL INSTRUMENT TAG NUMBERS ON THIS P&ID INCLUDING PACKAGE UNITS ARE PREFIXED WITH UNIT NUMBER 0751 UNLESS OTHERWISE NOTED.
 - DELETED.
- NOTES:**
- DELETED.
 - THE VENT GAS LINE INTO AIR LINE AS CLOSE TO MAIN BURNER AS PRACTICAL. COMBINED LINE TO FREE DRAIN FROM TIE-IN POINT TO BURNER.
 - DELETED.
 - INTERLOCK TABLE IS FOR REFERENCE ONLY. CAUSE AND EFFECT MATRIX SR03-0751-CCC-303155 SHALL GOVERN.
 - REFER TO CAUSE AND EFFECT CHART FOR FULL REPRESENTATION OF INTERLOCK INITIATORS AND ACTIONS.
 - MAIN BURNER PURGE.
 - DELETED.
 - SIGNAL TO BE SEGREGATED. REFERENCE TO BE MADE TO MAIN BURNERS AND CLAUS SECTION ESD 0751-I-220/0751-I-221 LOGIC SYSTEM DESCRIPTION, DOCUMENT NO. SR03-0751-00-SPE-303161.
 - NITROGEN FOR MAIN BURNER POST SHUT-DOWN PURGE.
 - FAL-1012 IS REFERRED TO MAIN BURNER POST SHUT-DOWN PURGE.
 - FALL-1189 IS ACTIVE ONLY DURING MAIN BURNER START-UP PURGE.

UTILITY REFERENCE TABLE		
N2	DRW. N°.	SR03-0751-00-PID-362310
IA	DRW. N°.	SR03-0751-00-PID-362305

Z1	04-11-14	IAB	ISSUED FOR AS BUILT	PCA	MAR	ASP
2.1D	18-04-14	IFC	ISSUED FOR CONSTRUCTION	PCA	MAR	ASP
2.1C	28-02-14	IFC	ISSUED FOR CONSTRUCTION	PCA	MAR	ASP
2.1B	06-08-12	IFC	ISSUED FOR CONSTRUCTION	DSC	CBR	SIN
2	02-12-11	IFC	ISSUED FOR CONSTRUCTION	DSC	CBR	SIN
1	28-07-11	IFCH	ISSUED FOR CONSTRUCTION WITH HOLDS	DSC	CBR	SIN
0	15-02-11	IFD	ISSUED CLIENT COMMENTS INCORPORATED	BSC	LMA	SIN
B1	30-09-10	ICR	ISSUED FOR CLIENT REVIEW	BSC	LMA	SIN
REV	DATE	STATUS	STATUS DESCRIPTION	BY	CKD	APP.

COMPANY:

Abu Dhabi Gas Development Co. Ltd.

CONTRACTOR:

PROJECT: SHAH GAS DEVELOPMENT (SGD) PROJECT


AGREEMENT No. 13525001

DRAWING TITLE: PIPING & INSTRUMENT DIAGRAM UNIT 0751 SULPHUR RECOVERY AND TAIL GAS TREATING UNIT

EQUIPMENT DESCRIPTION	COMBUSTION AIR NO. 1 BURNER	
TAGITEM No.		

CONTRACTOR DRG. No.		751-GD-B-303304		REV. Z1
COMPANY DRG. No.		SR03-0751-00-303304		
SCALE:	SIZE:	A1	DOC. CLASS: 1	

THIS DOCUMENT IS THE PROPERTY OF ABU DHABI GAS DEVELOPMENT COMPANY LIMITED AND CONTAINS INFORMATION WHICH IS PROPRIETARY. THIS INFORMATION IS TO BE HELD IN CONFIDENCE. NO DISCLOSURE OR OTHER USE OF THIS DOCUMENT IS TO BE MADE WITHOUT THE PRIOR WRITTEN CONSENT OF ABU DHABI GAS DEVELOPMENT COMPANY LIMITED.

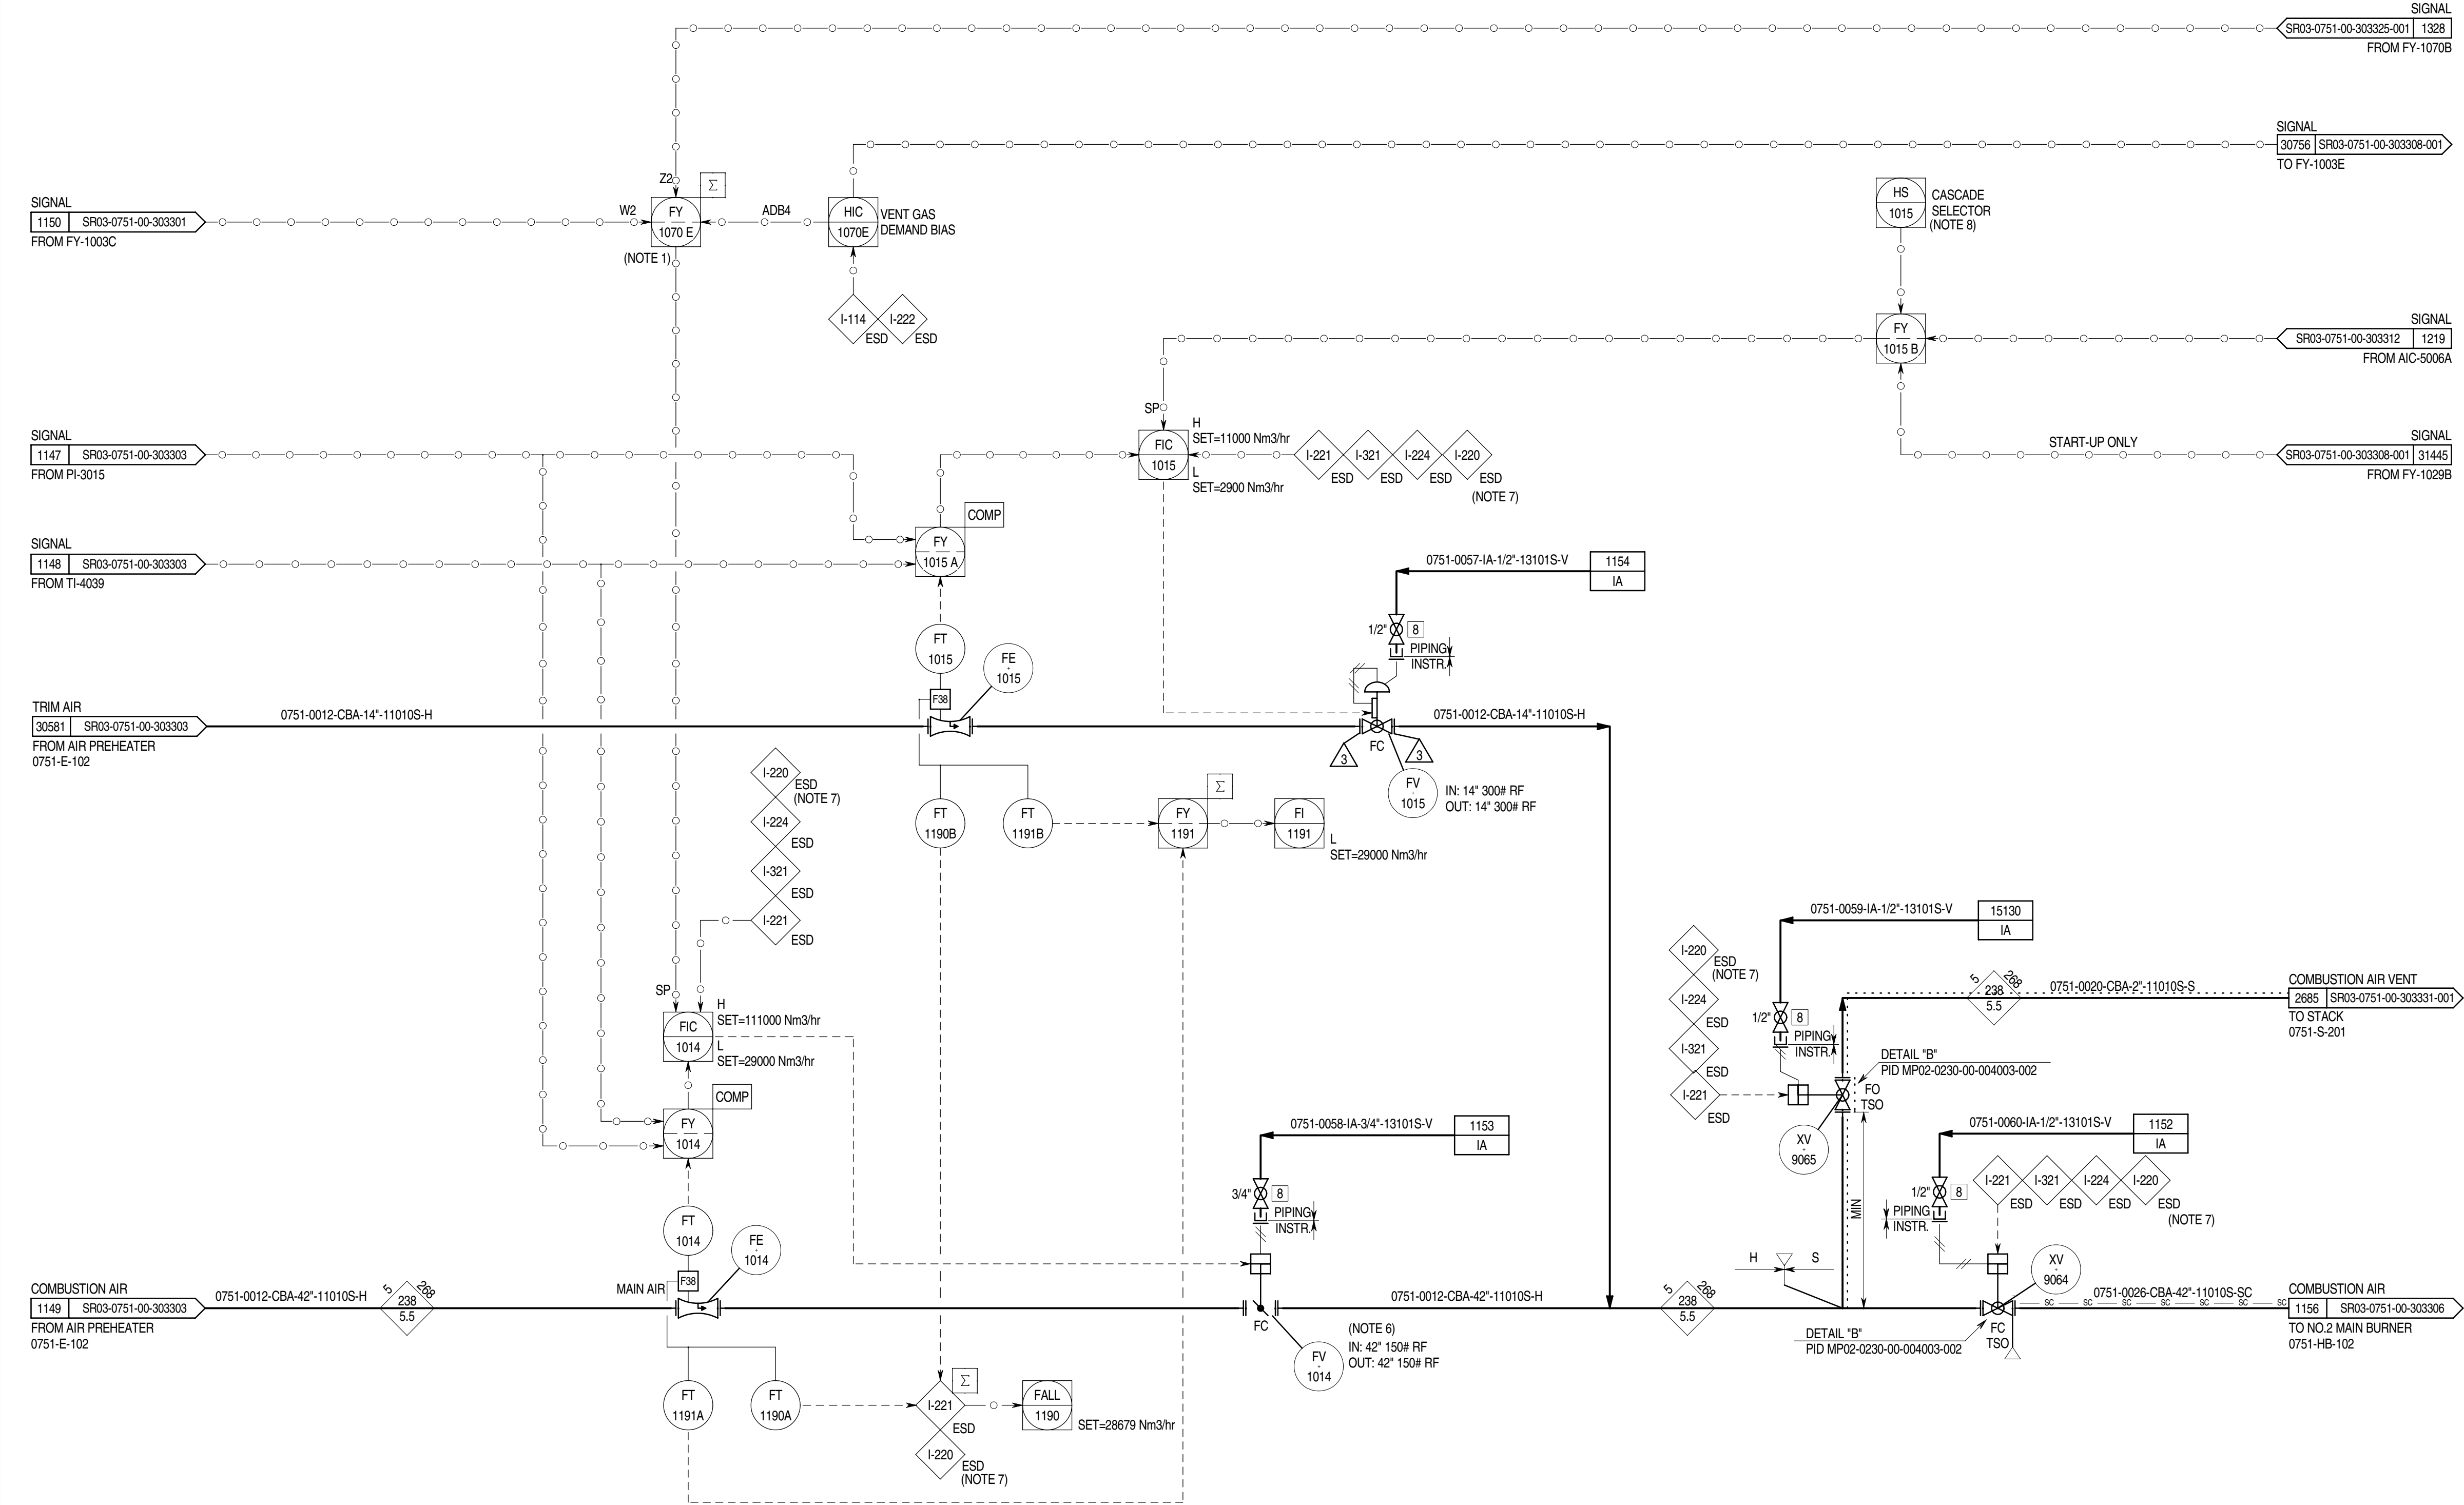

INTERLOCK TABLE (NOTE 3,4)		
INTERLOCK NUMBER	LOGIC DESCRIPTION	REFERENCE DOCUMENT N.
I-321	SULPHUR RECOVERY UNIT	SR03-0751-00-303375
I-221	CLAUS SECTION	SR03-0751-00-303375
I-224	INCINERATOR SECTION	SR03-0751-00-303375
I-222	DEGASSING SECTION	SR03-0751-00-303375
I-114	SULPHUR RUNDOWN VESSEL/SULPHUR PUMPS	SR03-0751-00-303375

- GENERAL NOTES:**
- FOR STANDARD SYMBOLS, DETAILS, ABBREVIATIONS, SAMPLE CONNECTION TYPE, GENERAL NOTES & LEGEND SHEETS REFER TO DRAWING NO. MP02-0230-00-004000 TO 004015.
 - ALL INSTRUMENT TAG NUMBERS ON THIS P&ID INCLUDING PACKAGE UNITS ARE PREFIXED WITH UNIT NUMBER 0751 UNLESS OTHERWISE NOTED.
 - DELETED.
- NOTES:**
- SUBTRACT VENT AIR FROM TOTAL AIR DEMAND.
 - DELETED.
 - INTERLOCK TABLE IS FOR REFERENCE ONLY. CAUSE AND EFFECT MATRIX SR03-0751-00-CCC-303155 SHALL GOVERN.
 - REFER TO CAUSE AND EFFECT CHART FOR FULL REPRESENTATION OF INTERLOCK INITIATORS AND ACTIONS.
 - DELETED.
 - FV-1014 PROVIDED WITH AIR VOLUME TANK ONLY FOR STROKE FAIL POSITION.
 - SIGNAL TO BE SEGREGATED. REFERENCE TO BE MADE TO MAIN BURNERS AND CLAUS SECTION ESD 0751-I-220/0751-I-221 LOGIC SYSTEM DESCRIPTION, DOCUMENT NO. SR03-0751-00-SPE-303161.
 - CASCADE SELECTOR SHALL BE USED ONLY IF CONTROLLER FIC-1015 IS IN MANUAL MODE AT 0% OUTPUT DURING START-UP. SET POINT TO FIC-1015 IS PROVIDED BY FY-1029B. DURING NORMAL OPERATION, SET POINT TO FIC-1015 IS PROVIDED BY AIC-5006A

UTILITY REFERENCE TABLE	
IA	DRW. N°. SR03-0751-00-PID-362305

Z1	04-11-14	IAB	ISSUED FOR AS BUILT	PCA	MAR	ASP
2.1B	06-08-12	IFC	ISSUED FOR CONSTRUCTION	DSC	CBR	SIN
2	02-12-11	IFC	ISSUED FOR CONSTRUCTION	DSC	CBR	SIN
1	28-07-11	IFCH	ISSUED FOR CONSTRUCTION WITH HOLDS	DSC	CBR	SIN
0	15-02-11	IFD	ISSUED CLIENT COMMENTS INCORPORATED	BSC	LMA	SIN
B1	30-09-10	ICR	ISSUED FOR CLIENT REVIEW	BSC	LMA	SIN
REV	DATE	STATUS	STATUS DESCRIPTION	BY	CKD	APP.

COMPANY:

Abu Dhabi Gas Development Co. Ltd.



CONTRACTOR:



JOB No. 032090

PROJECT:

SHAH GAS DEVELOPMENT (SGD) PROJECT


AGREEMENT No. 13525001

DRAWING TITLE:

PIPING & INSTRUMENT DIAGRAM UNIT 0751
SULPHUR RECOVERY AND TAIL GAS TREATING UNIT

EQUIPMENT DESCRIPTION	COMBUSTION AIR CONTROL NO. 2 BURNER
TAGITEM No.	

CONTRACTOR DRG. No.	751-GD-B-303305	REV. Z1
COMPANY DRG. No.	SR03-0751-00-303305	
SCALE:	SIZE: A1 DOC. CLASS: 1	

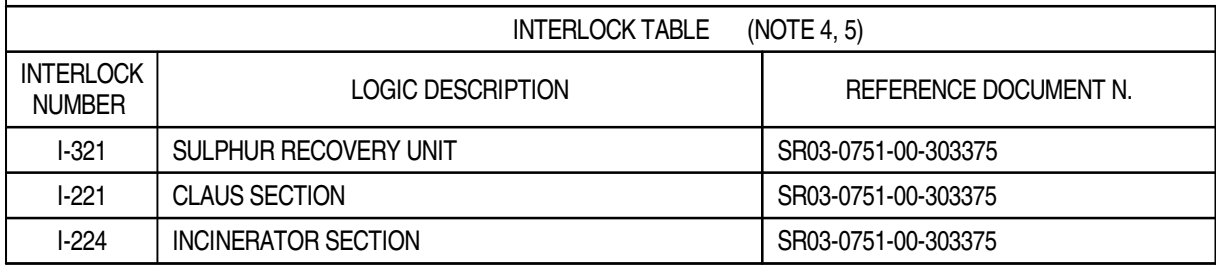

UTILITY REFERENCE TABLE		
N2	DRW. N°.	SR03-0751-00-PID-362310
IA	DRW. N°.	SR03-0751-00-PID-362305

COMPANY:

Abu Dhabi Gas Development Co. Ltd.




PROJECT: SHAH GAS DEVELOPMENT (SGD) PROJECT

AGREEMENT No. **13525001**

EQUIPMENT DESCRIPTION	COMBUSTION AIR NO. 2 BURNER
TAG/ITEM No.	

CONTRACTOR DRG. No.		751-GD-B-303306		REV. Z1
COMPANY DRG. No.		SR03-0751-00-303306		
SCALE:	SIZE: A1	DOC. CLASS: 1		

THIS DOCUMENT IS THE PROPERTY OF ABU DHABI GAS DEVELOPMENT COMPANY LIMITED AND CONTAINS INFORMATION WHICH IS PROPRIETARY. THIS INFORMATION IS TO BE HELD IN CONFIDENCE. NO DISCLOSURE OR OTHER USE OF THIS DOCUMENT IS TO BE MADE WITHOUT THE PRIOR WRITTEN CONSENT OF ABU DHABI GAS DEVELOPMENT COMPANY LIMITED.

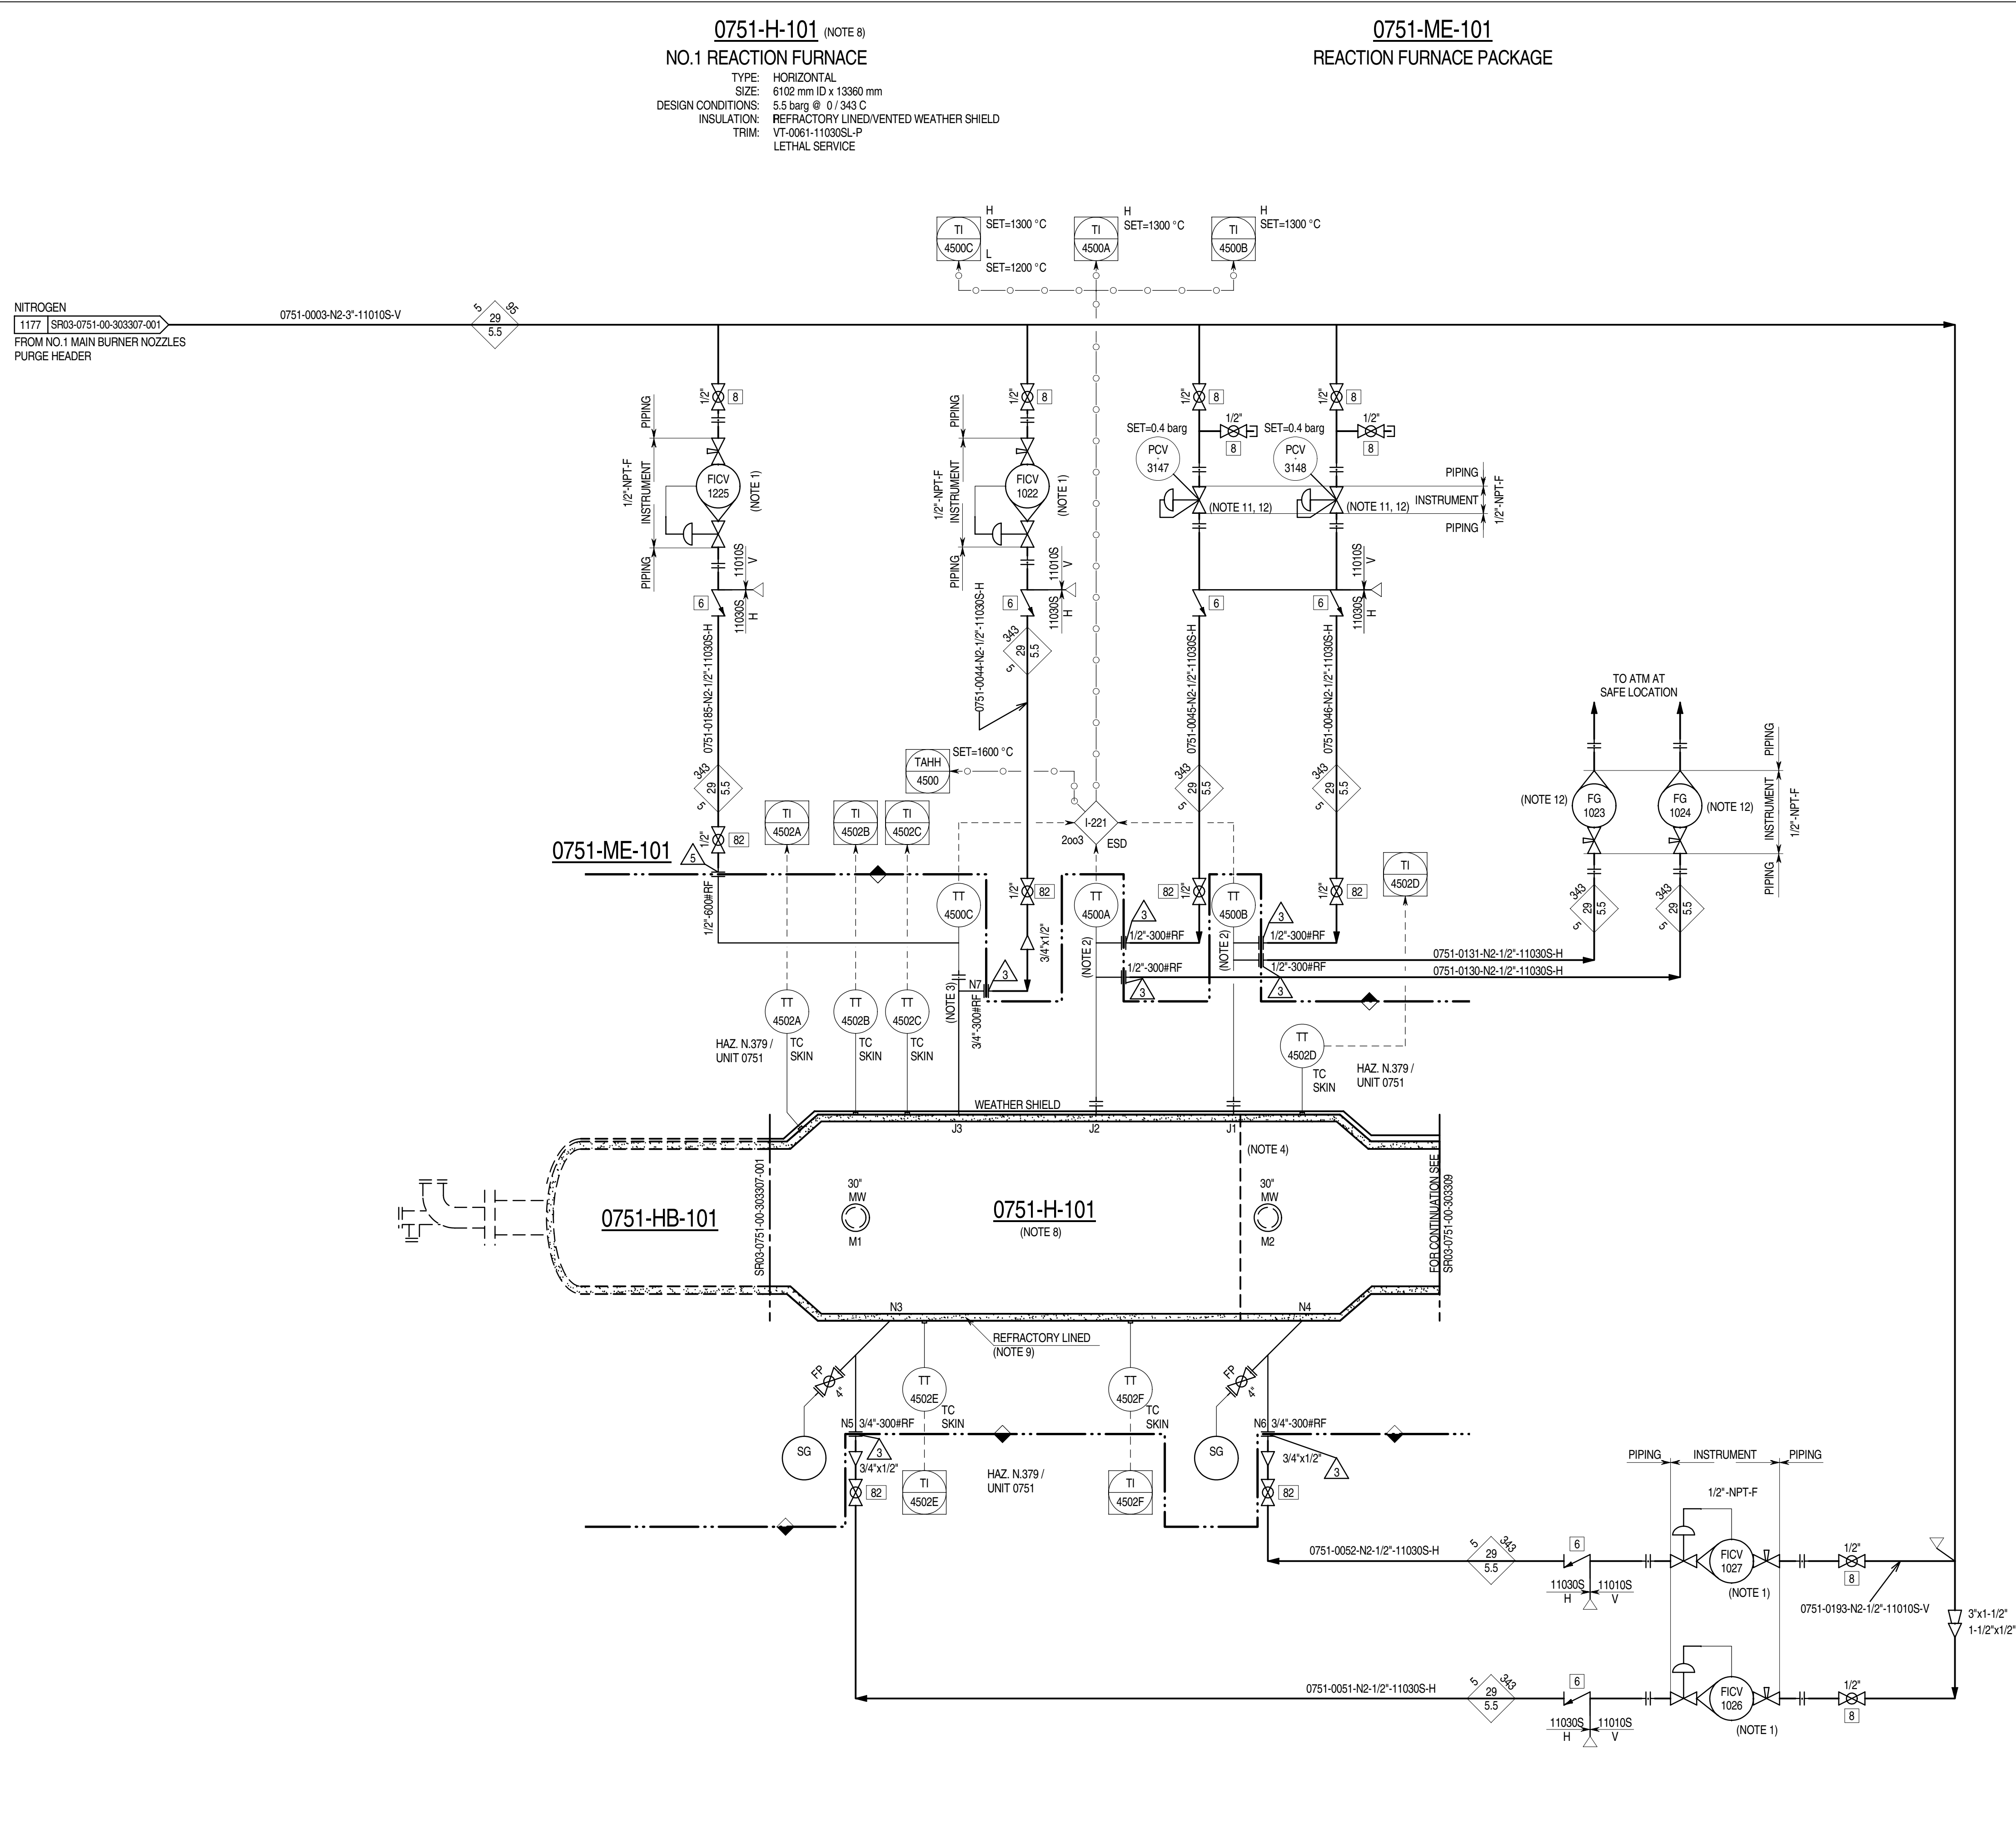

INTERLOCK TABLE (NOTE 5)		
INTERLOCK NUMBER	LOGIC DESCRIPTION (NOTE 6)	REFERENCE DOCUMENT N.
I-221	CLAUS SECTION	SR03-0751-00-303375

- GENERAL NOTES:**
- FOR STANDARD SYMBOLS, DETAILS, ABBREVIATIONS, SAMPLE CONNECTION TYPE, GENERAL NOTES & LEGEND SHEETS REFER TO DRAWING NO. MP02-0230-00-004000 TO 004015.
 - ALL INSTRUMENT TAG NUMBERS ON THIS P&ID INCLUDING PACKAGE UNITS ARE PREFIXED WITH UNIT NUMBER 0751 UNLESS OTHERWISE NOTED.
 - DELETED.
- NOTES:**
- GROUP BURNER PURGES TOGETHER ON OR NEAR BURNER PLATFORM.
 - THERMOWELL TO BE CERAMIC TYPE, PRESSURIZED TYPE.
 - PYROMETER FOR FLAME TEMPERATURE MEASUREMENT (E2T TYPE OR EQUIVALENT).
 - CHECKER WALL.
 - INTERLOCK TABLE IS FOR REFERENCE ONLY. CAUSE AND EFFECT MATRIX SR03-0751-CCC-303155 SHALL GOVERN.
 - REFER TO CAUSE AND EFFECT CHART FOR FULL REPRESENTATION OF INTERLOCK INITIATORS AND ACTIONS.
 - DELETED.
 - REACTION FURNACE PACKAGE 0751-ME-101 INCLUDES: 0751-HB-101, 0751-H-101, 0751-E-103, 0751-V-104.
 - SEE DATA SHEET FOR REFRACTORY LINING DETAILS.
 - FOR SKIN THERMOCOUPLES DISTRIBUTION AND POSITION SEE DOC. NO. SR0301003-0300-B01399091.
 - REGULATOR PROVIDED WITH PRESSURE GAUGE.
 - GROUP EACH PCV WITH RELEVANT FG ON THE SAME PANEL, ON OR NEAR BURNER PLATFORM.

Z1	04-11-14	IAB	ISSUED FOR AS BUILT	PCA	MAR	ASP
2.1G	18-04-14	IFC	ISSUED FOR CONSTRUCTION	PCA	MAR	ASP
2.1F	28-02-14	IFC	ISSUED FOR CONSTRUCTION	PCA	MAR	ASP
2.1E	27-12-12	IFC	ISSUED FOR CONSTRUCTION	RL	MF	MZ
2.1D	18-12-12	IFC	ISSUED FOR CONSTRUCTION	RL	MF	MZ
2.1C	31-10-12	IFC	ISSUED FOR CONSTRUCTION	RL	MF	MZ
2.1B	06-08-12	IFC	ISSUED FOR CONSTRUCTION	DSC	CBR	SIN
2	02-12-11	IFC	ISSUED FOR CONSTRUCTION	DSC	CBR	SIN
1	28-07-11	IFCH	ISSUED FOR CONSTRUCTION WITH HOLDS	DSC	CBR	SIN
0	15-02-11	IFD	ISSUED CLIENT COMMENTS INCORPORATED	BSC	LMA	SIN
B1	30-09-10	ICR	ISSUED FOR CLIENT REVIEW	BSC	LMA	SIN
REV	DATE	STATUS	STATUS DESCRIPTION	BY	CKD	APP.

COMPANY:

Abu Dhabi Gas Development Co. Ltd.

CONTRACTOR:

JOB No. 032090

PROJECT: **SHAH GAS DEVELOPMENT (SGD) PROJECT**

AGREEMENT No. **13525001**


DRAWING TITLE: **PIPING & INSTRUMENT DIAGRAM UNIT 0751 SULPHUR RECOVERY AND TAIL GAS TREATING UNIT**

EQUIPMENT DESCRIPTION	NO.1 REACTION FURNACE	
TAGITEM No.	0751-H-101	

CONTRACTOR DRG. No.		751-GD-B-303307		REV. Z1
COMPANY DRG. No.		SR03-0751-00-303307-002		
SCALE:	SIZE: A1	DOC. CLASS: 1		

THIS DOCUMENT IS THE PROPERTY OF ABU DHABI GAS DEVELOPMENT COMPANY LIMITED AND CONTAINS INFORMATION WHICH IS PROPRIETARY. THIS INFORMATION IS TO BE HELD IN CONFIDENCE. NO DISCLOSURE OR OTHER USE OF THIS DOCUMENT IS TO BE MADE WITHOUT THE PRIOR WRITTEN CONSENT OF ABU DHABI GAS DEVELOPMENT COMPANY LIMITED.

INTERLOCK TABLE (NOTE 4)		
INTERLOCK NUMBER	LOGIC DESCRIPTION (NOTE 3)	REFERENCE DOCUMENT N.
I-221	CLAUS SECTION	SR03-0751-00-303375
I-114	SULPHUR RUNDOWN VESSEL/SULPHUR PUMPS	SR03-0751-00-303375
I-222	DEGASSING SECTION	SR03-0751-00-303375

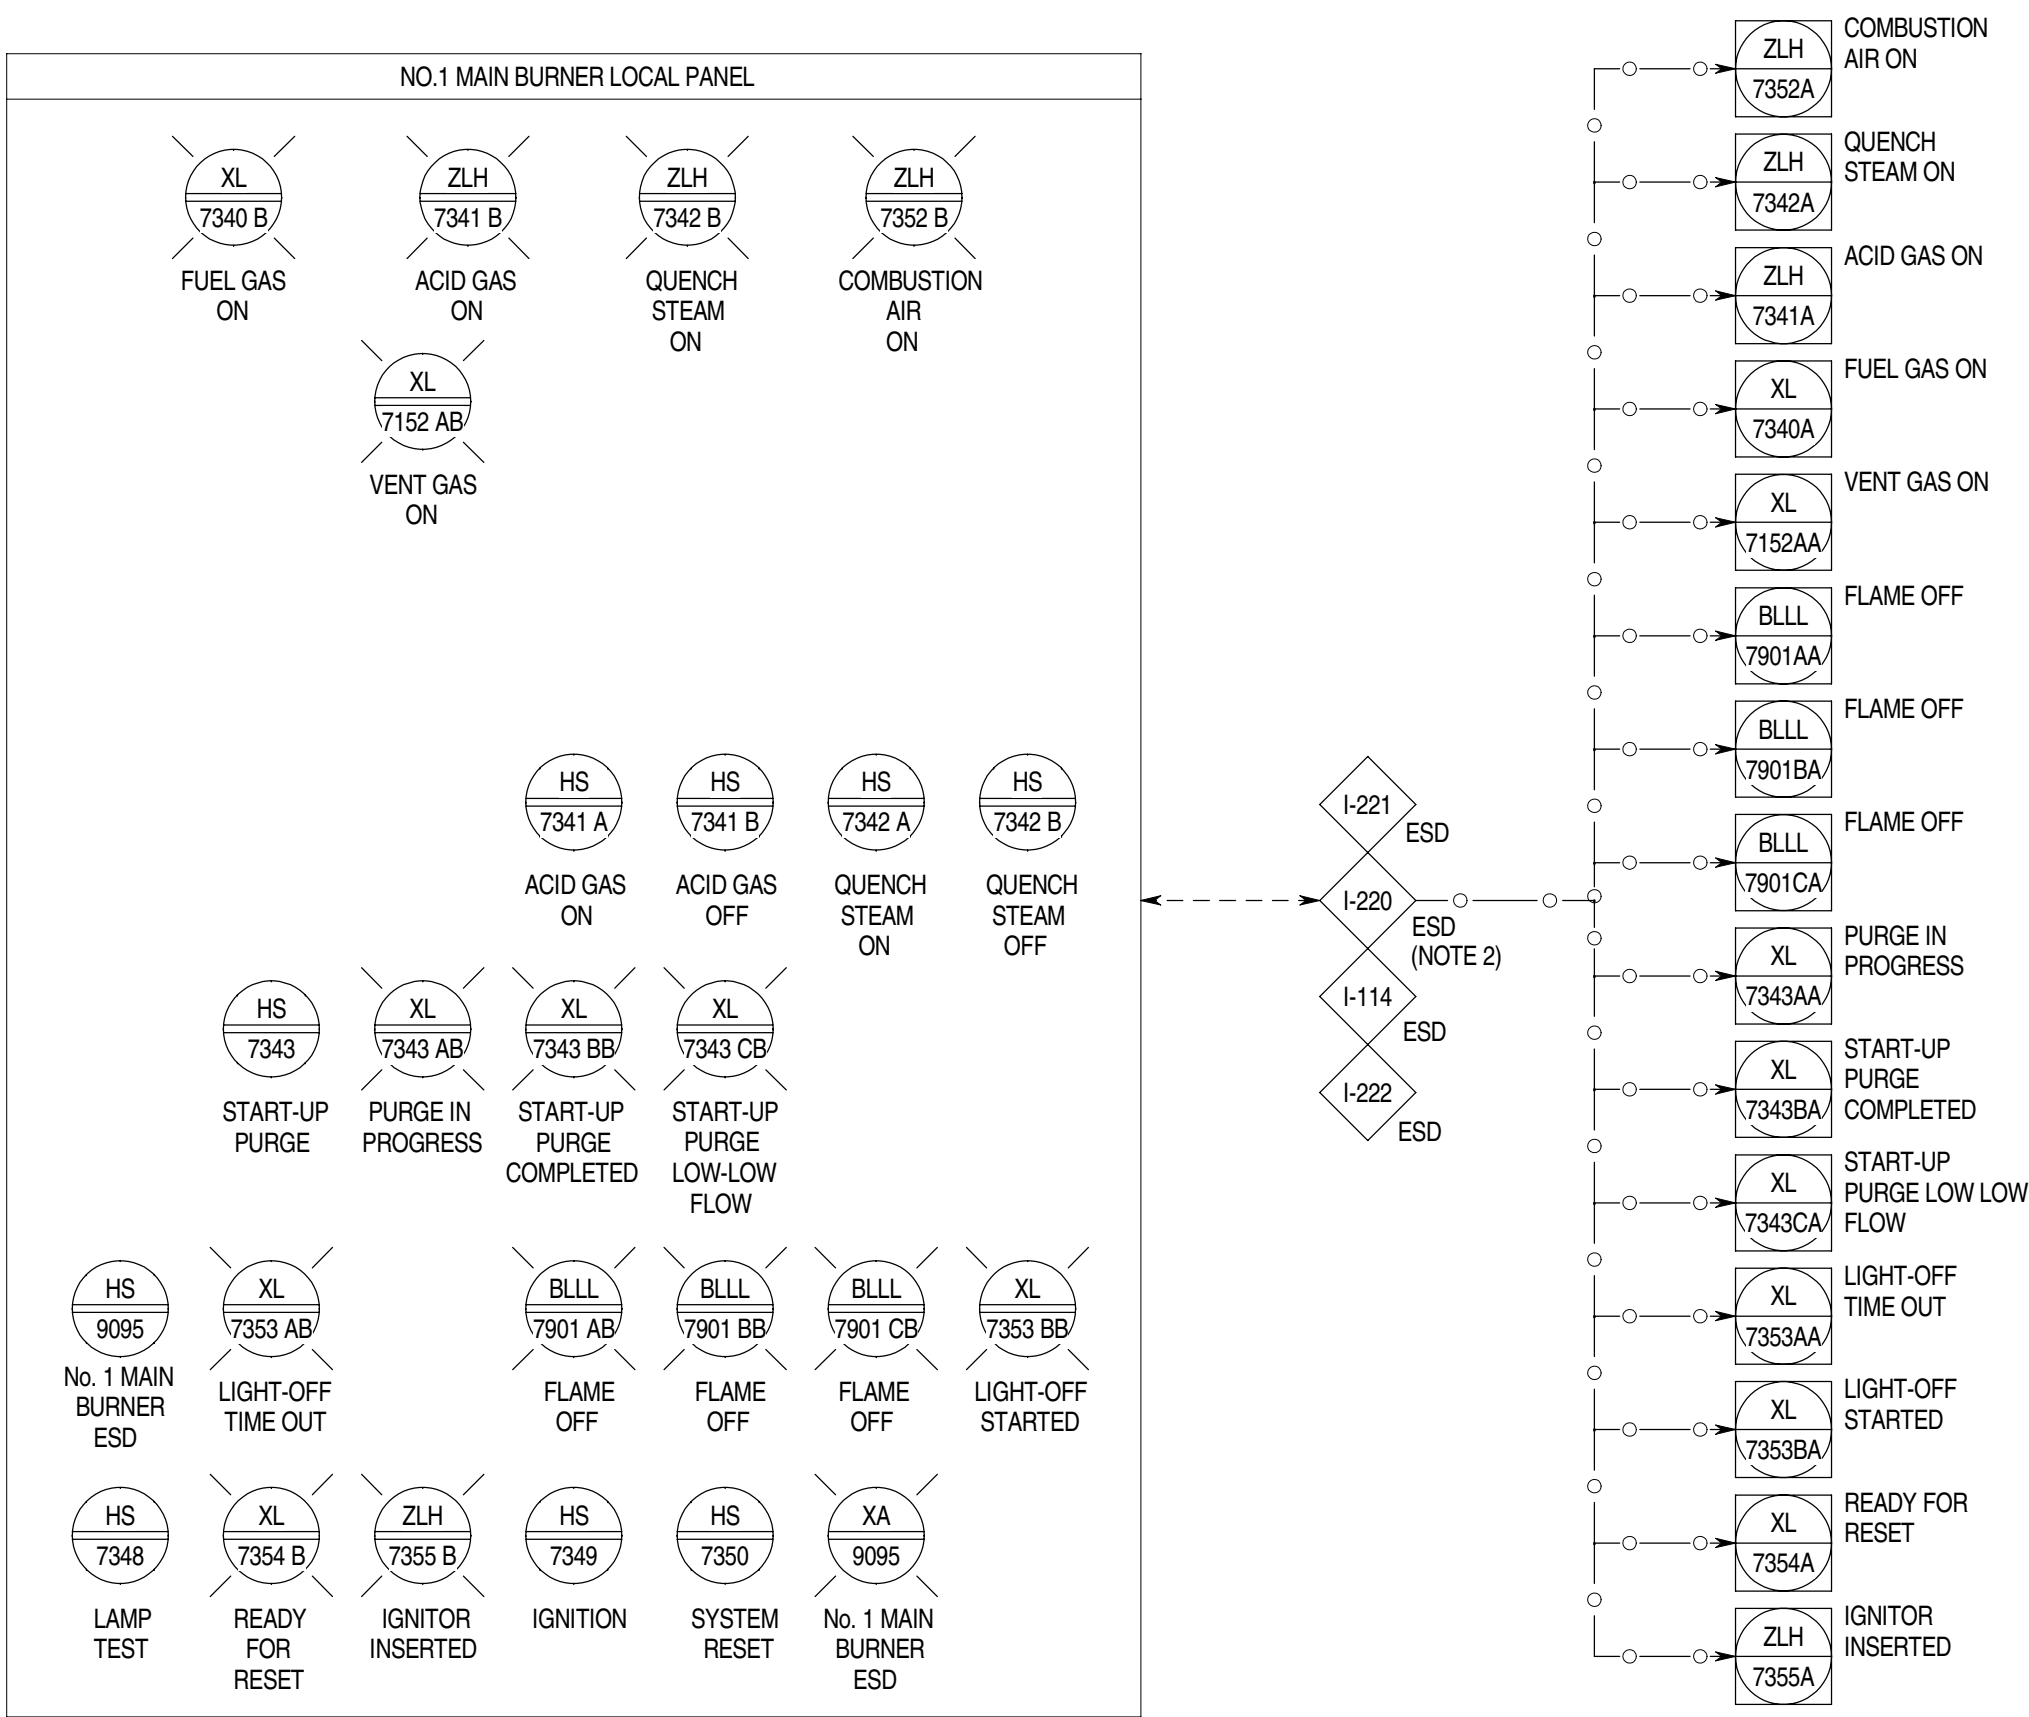

- GENERAL NOTES:**
- FOR STANDARD SYMBOLS, DETAILS, ABBREVIATIONS, SAMPLE CONNECTION TYPE, GENERAL NOTES & LEGEND SHEETS REFER TO DRAWING NO. MP02-0230-00-004000 TO 004015.
 - ALL INSTRUMENT TAG NUMBERS ON THIS P&ID INCLUDING PACKAGE UNITS ARE PREFIXED WITH UNIT NUMBER 0751 UNLESS OTHERWISE NOTED.
 - DELETED.
- NOTES:**
- DELETED.
 - SIGNAL TO BE SEGREGATED. REFERENCE TO BE MADE TO MAIN BURNERS AND CLAUS SECTION ESD 0751-I-220/0751-I-221 LOGIC SYSTEM DESCRIPTION, DOCUMENT NO. SR03-0751-00-SPE-303161.
 - REFER TO CAUSE AND EFFECT CHART FOR FULL REPRESENTATION OF INTERLOCK INITIATORS AND ACTIONS.
 - INTERLOCK TABLE IS FOR REFERENCE ONLY.
CAUSE AND EFFECT MATRIX SR03-0751-CCC-303155 SHALL GOVERN.

Z1	04-11-14	IAB	ISSUED FOR AS BUILT	PCA	MAR	ASP
2.1G	18-04-14	IFC	ISSUED FOR CONSTRUCTION	PCA	MAR	ASP
2.1F	28-02-14	IFC	ISSUED FOR CONSTRUCTION	PCA	MAR	ASP
2.1E	27-12-12	IFC	ISSUED FOR CONSTRUCTION	RL	MF	MZ
2.1D	18-12-12	IFC	ISSUED FOR CONSTRUCTION	RL	MF	MZ
2.1C	31-10-12	IFC	ISSUED FOR CONSTRUCTION	RL	MF	MZ
2.1B	06-08-12	IFC	ISSUED FOR CONSTRUCTION	DSC	CBR	SIN
2	02-12-11	IFC	ISSUED FOR CONSTRUCTION	DSC	CBR	SIN
1	28-07-11	IFCH	ISSUED FOR CONSTRUCTION WITH HOLDS	DSC	CBR	SIN
0	15-02-11	IFD	ISSUED CLIENT COMMENTS INCORPORATED	BSC	LMA	SIN
B1	30-09-10	ICR	ISSUED FOR CLIENT REVIEW	BSC	LMA	SIN
REV	DATE	STATUS	STATUS DESCRIPTION	BY	CKD	APP.

COMPANY:

Abu Dhabi Gas Development Co. Ltd.



CONTRACTOR:



JOB No. 032090


PROJECT: SHAH GAS DEVELOPMENT (SGD) PROJECT

AGREEMENT No. 13525001


DRAWING TITLE: PIPING & INSTRUMENT DIAGRAM UNIT 0751
SULPHUR RECOVERY AND TAIL GAS TREATING UNIT

EQUIPMENT DESCRIPTION	NO.1 REACTION FURNACE LOCAL PANEL
TAGITEM No.	

CONTRACTOR DRG.No.	751-GD-B-303307	REV. Z1
COMPANY DRG.No.	SR03-0751-00-303307-003	
SCALE:	SIZE: A1	DOC. CLASS: 1

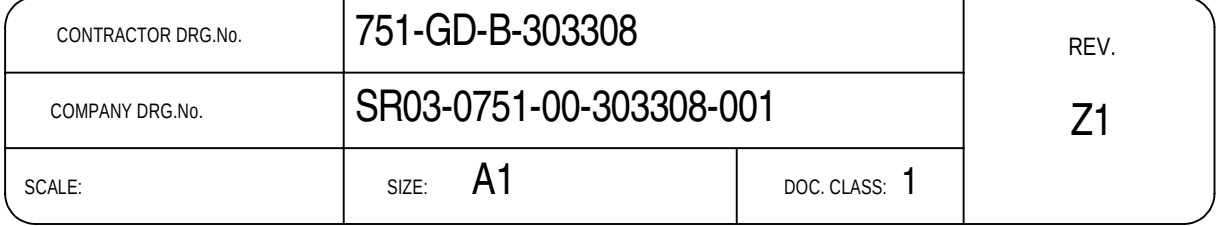


THIS DOCUMENT IS THE PROPERTY OF ABU DHABI GAS DEVELOPMENT COMPANY LIMITED AND CONTAINS INFORMATION WHICH IS PROPRIETARY. THIS INFORMATION IS TO BE HELD IN CONFIDENCE. NO DISCLOSURE OR OTHER USE OF THIS DOCUMENT IS TO BE MADE WITHOUT THE PRIOR WRITTEN CONSENT OF ABU DHABI GAS DEVELOPMENT COMPANY LIMITED.

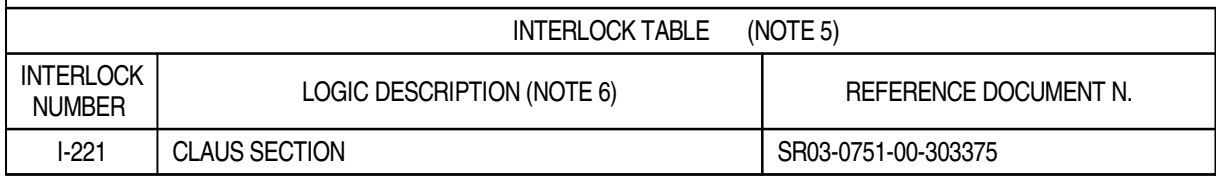

CONTRACTOR DRG.No.		751-GD-B-303308	REV. Z1
COMPANY DRG.No.		SR03-0751-00-303308-002	
SCALE:	SIZE: A1	DOC. CLASS: 1	

THIS DOCUMENT IS THE PROPERTY OF ABU DHABI GAS DEVELOPMENT COMPANY LIMITED AND CONTAINS INFORMATION WHICH IS PROPRIETARY. THIS INFORMATION IS TO BE HELD IN CONFIDENCE. NO DISCLOSURE OR OTHER USE OF THIS DOCUMENT IS TO BE MADE WITHOUT THE PRIOR WRITTEN CONSENT OF ABU DHABI GAS DEVELOPMENT COMPANY LIMITED.

INTERLOCK TABLE (NOTE 4)		
INTERLOCK NUMBER	LOGIC DESCRIPTION (NOTE 3)	REFERENCE DOCUMENT N.
I-221	CLAUS SECTION	SR03-0751-00-303375
I-114	SULPHUR RUNDOWN VESSEL/SULPHUR PUMPS	SR03-0751-00-303375
I-222	DEGASSING SECTION	SR03-0751-00-303375

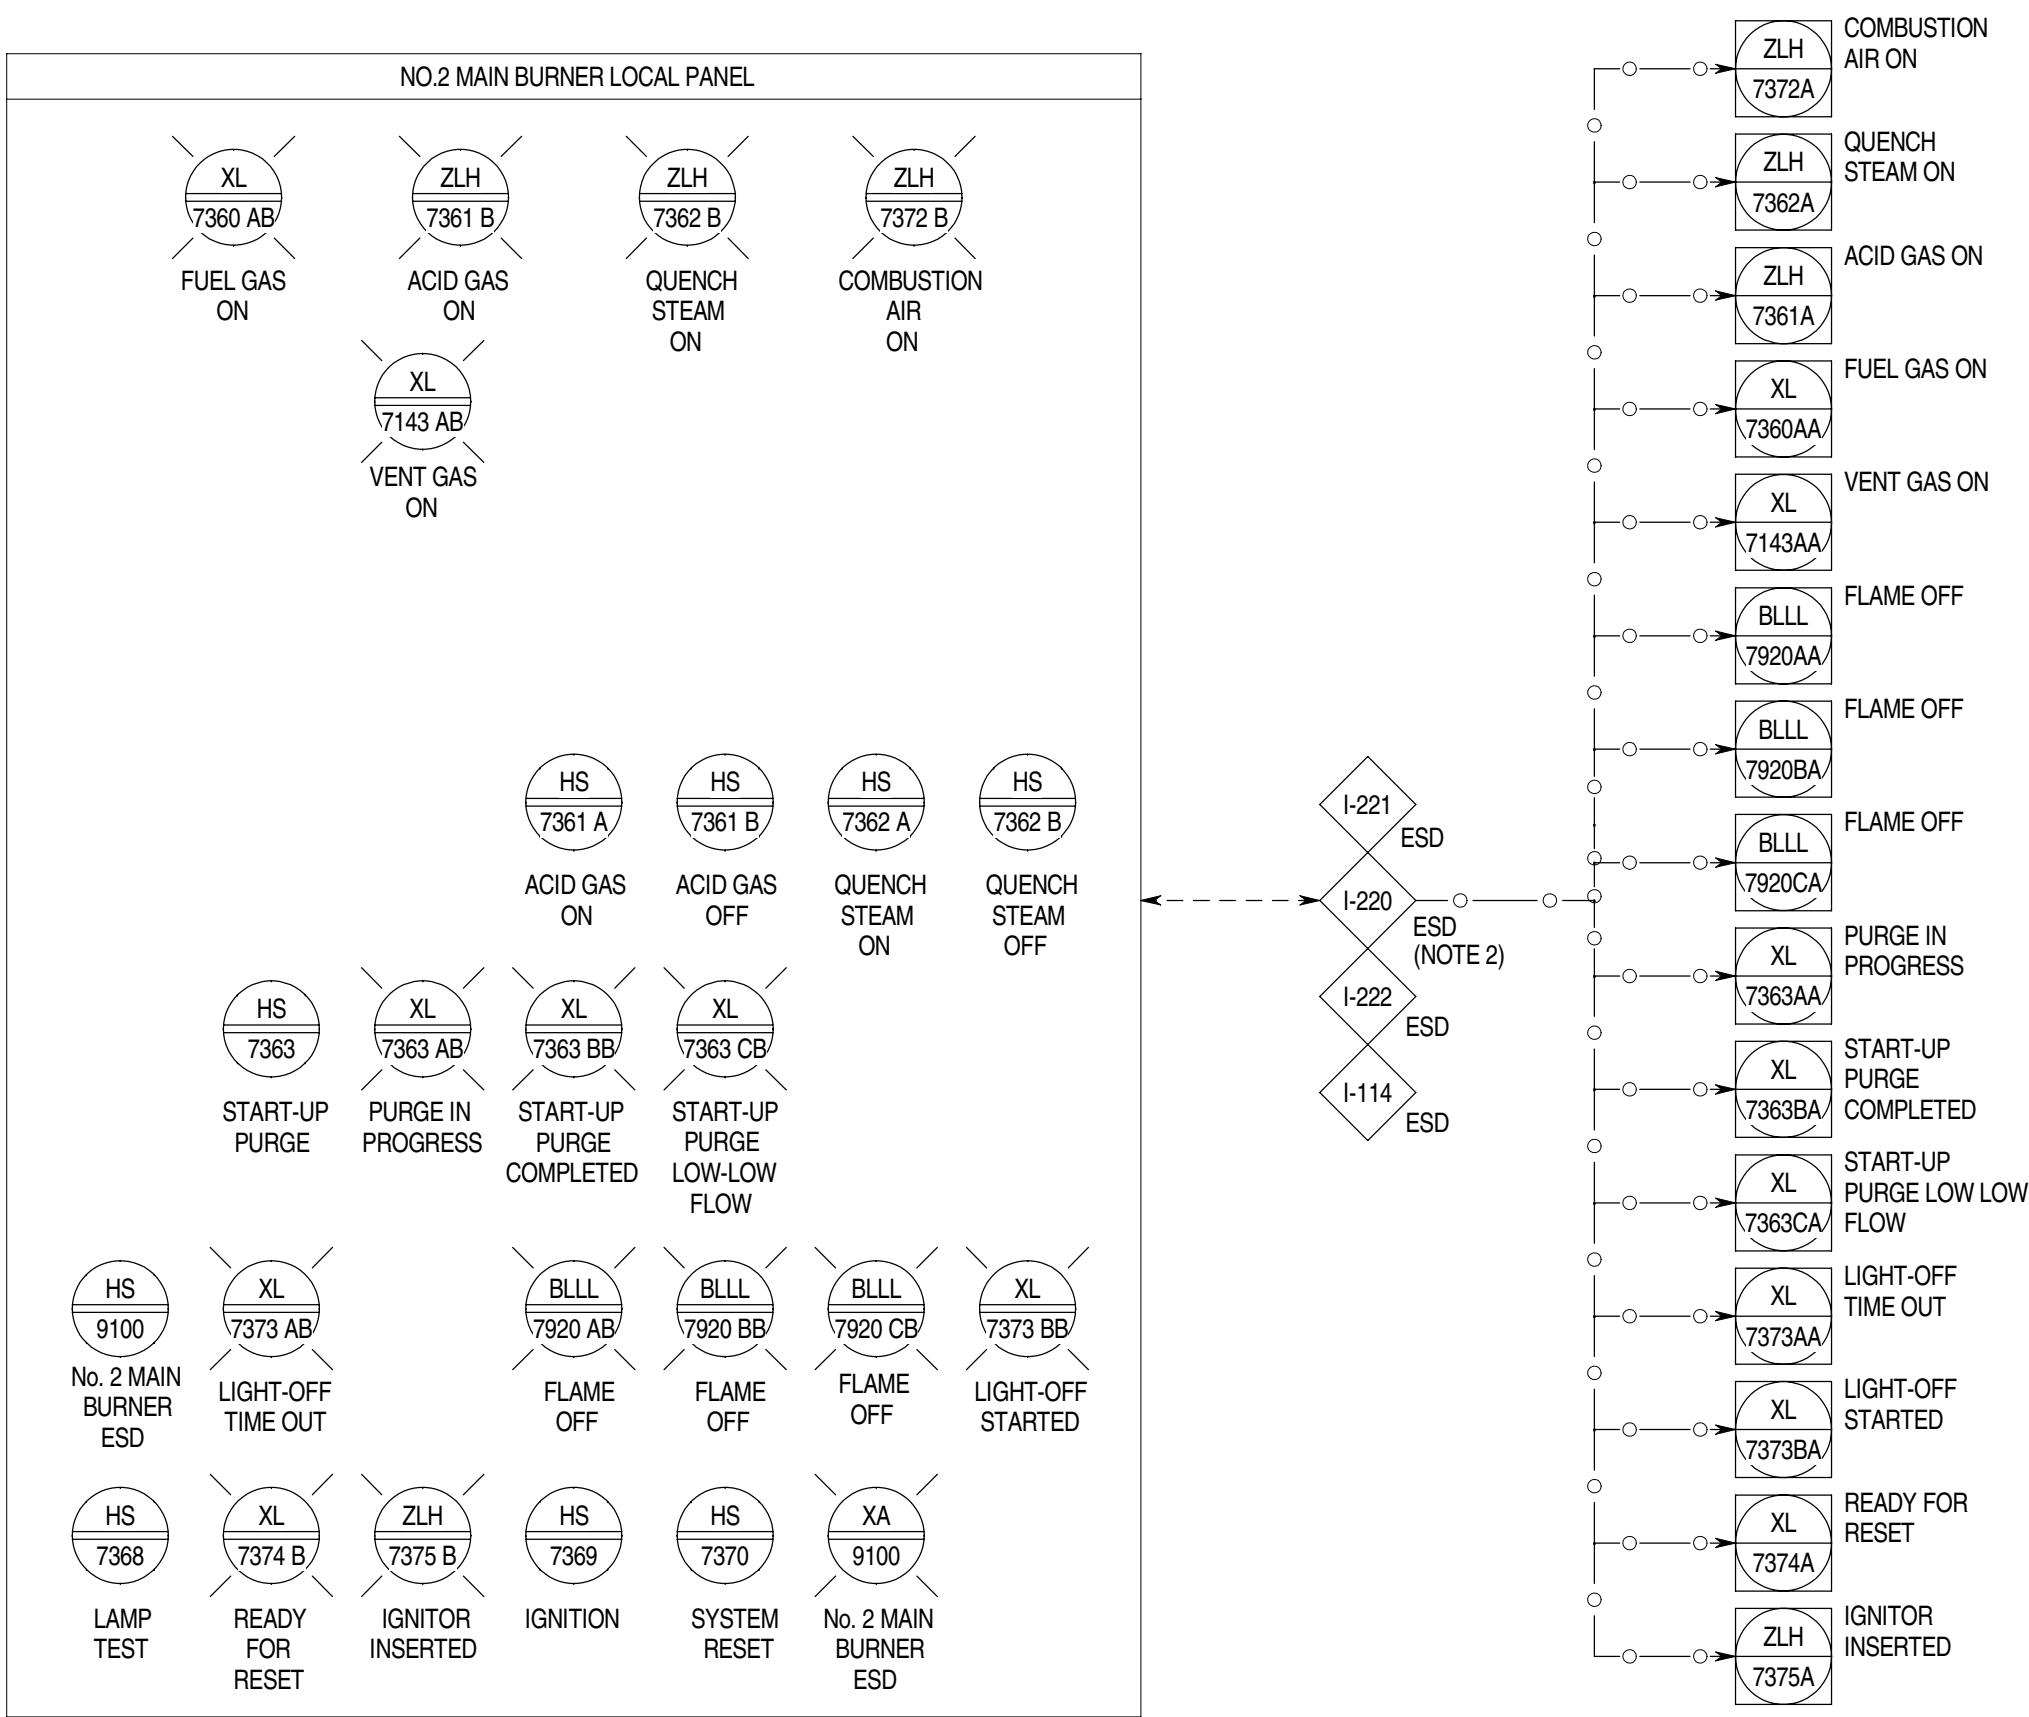

- GENERAL NOTES:**
- FOR STANDARD SYMBOLS, DETAILS, ABBREVIATIONS, SAMPLE CONNECTION TYPE, GENERAL NOTES & LEGEND SHEETS REFER TO DRAWING NO. MP02-0230-00-004000 TO 004015.
 - ALL INSTRUMENT TAG NUMBERS ON THIS P&ID INCLUDING PACKAGE UNITS ARE PREFIXED WITH UNIT NUMBER 0751 UNLESS OTHERWISE NOTED.
 - DELETED.
- NOTES:**
- DELETED.
 - SIGNAL TO BE SEGREGATED. REFERENCE TO BE MADE TO MAIN BURNERS AND CLAUS SECTION ESD 0751-I-220/0751-I-221 LOGIC SYSTEM DESCRIPTION, DOCUMENT NO. SR03-0751-00-SPE-303161.
 - REFER TO CAUSE AND EFFECT CHART FOR FULL REPRESENTATION OF INTERLOCK INITIATORS AND ACTIONS.
 - INTERLOCK TABLE IS FOR REFERENCE ONLY.
CAUSE AND EFFECT MATRIX SR03-0751-CCC-303155 SHALL GOVERN.

Z1	04-11-14	IAB	ISSUED FOR AS BUILT	PCA	MAR	ASP
2.1G	18-04-14	IFC	ISSUED FOR CONSTRUCTION	PCA	MAR	ASP
2.1F	28-02-14	IFC	ISSUED FOR CONSTRUCTION	PCA	MAR	ASP
2.1E	27-12-12	IFC	ISSUED FOR CONSTRUCTION	RL	MF	MZ
2.1D	18-12-12	IFC	ISSUED FOR CONSTRUCTION	RL	MF	MZ
2.1C	31-10-12	IFC	ISSUED FOR CONSTRUCTION	RL	MF	MZ
2.1B	06-08-12	IFC	ISSUED FOR CONSTRUCTION	DSC	CBR	SIN
2	02-12-11	IFC	ISSUED FOR CONSTRUCTION	DSC	CBR	SIN
1	28-07-11	IFCH	ISSUED FOR CONSTRUCTION WITH HOLDS	DSC	CBR	SIN
0	15-02-11	IFD	ISSUED CLIENT COMMENTS INCORPORATED	BSC	LMA	SIN
B1	30-09-10	ICR	ISSUED FOR CLIENT REVIEW	BSC	LMA	SIN
REV	DATE	STATUS	STATUS DESCRIPTION	BY	CKD	APP.

COMPANY:

Abu Dhabi Gas Development Co. Ltd.

CONTRACTOR:

PROJECT: SHAH GAS DEVELOPMENT (SGD) PROJECT

AGREEMENT No. 13525001

DRAWING TITLE: PIPING & INSTRUMENT DIAGRAM UNIT 0751
SULPHUR RECOVERY AND TAIL GAS TREATING UNIT

EQUIPMENT DESCRIPTION	NO.2 REACTION FURNACE LOCAL PANEL				
TAG/ITEM No.					

CONTRACTOR DRG.No.		751-GD-B-303308		REV. Z1
COMPANY DRG.No.		SR03-0751-00-303308-003		
SCALE:	SIZE: A1	DOC. CLASS: 1		

UTILITY REFERENCE TABLE		
BBD	DRW. N°.	SR03-0751-00-PID-362303
BWF	DRW. N°.	SR03-0751-00-PID-362304
IA	DRW. N°.	SR03-0751-00-PID-362305
OD	DRW. N°.	SR03-0751-00-PID-362307
STH	DRW. N°.	SR03-0751-00-PID-362312

Z1	04-11-14	IAB	ISSUED FOR AS BUILT	PCA	MAR	ASP
2.1D	18-04-14	IFC	ISSUED FOR CONSTRUCTION	PCA	MAR	ASP
2.1C	28-02-14	IFC	ISSUED FOR CONSTRUCTION	PCA	MAR	ASP
2.1B	06-08-12	IFC	ISSUED FOR CONSTRUCTION	DSC	CBR	SIN
2	02-12-11	IFC	ISSUED FOR CONSTRUCTION	DSC	CBR	SIN
1	28-07-11	IFCH	ISSUED FOR CONSTRUCTION WITH HOLDS	DSC	CBR	SIN
0	15-02-11	IFD	ISSUED CLIENT COMMENTS INCORPORATED	BSC	LMA	SIN
B1	30-09-10	ICR	ISSUED FOR CLIENT REVIEW	BSC	LMA	SIN
REV	DATE	STATUS	STATUS DESCRIPTION	BY	CKD	APP.

الحصن للغاز
Al Hosn Gas




saipem

JOB No. 032090

SHAH GAS DEVELOPMENT (SGD) PROJECT

DRAWING TITLE: PIPING & INSTRUMENT DIAGRAM UNIT 0751
SULPHUR RECOVERY AND TAIL GAS TREATING UNIT

EQUIPMENT DESCRIPTION		NO.1 WASTE HEAT BOILER / STEAM DRUM	
TAG/ITEM No.		0751-E-103 0751-V-104	
CONTRACTOR DRG.No.		751-GD-B-303309	
COMPANY DRG.No.		SR03-0751-00-303309	
SCALE:	SIZE: A1	DOC. CLASS: 1	
		REV. Z1	

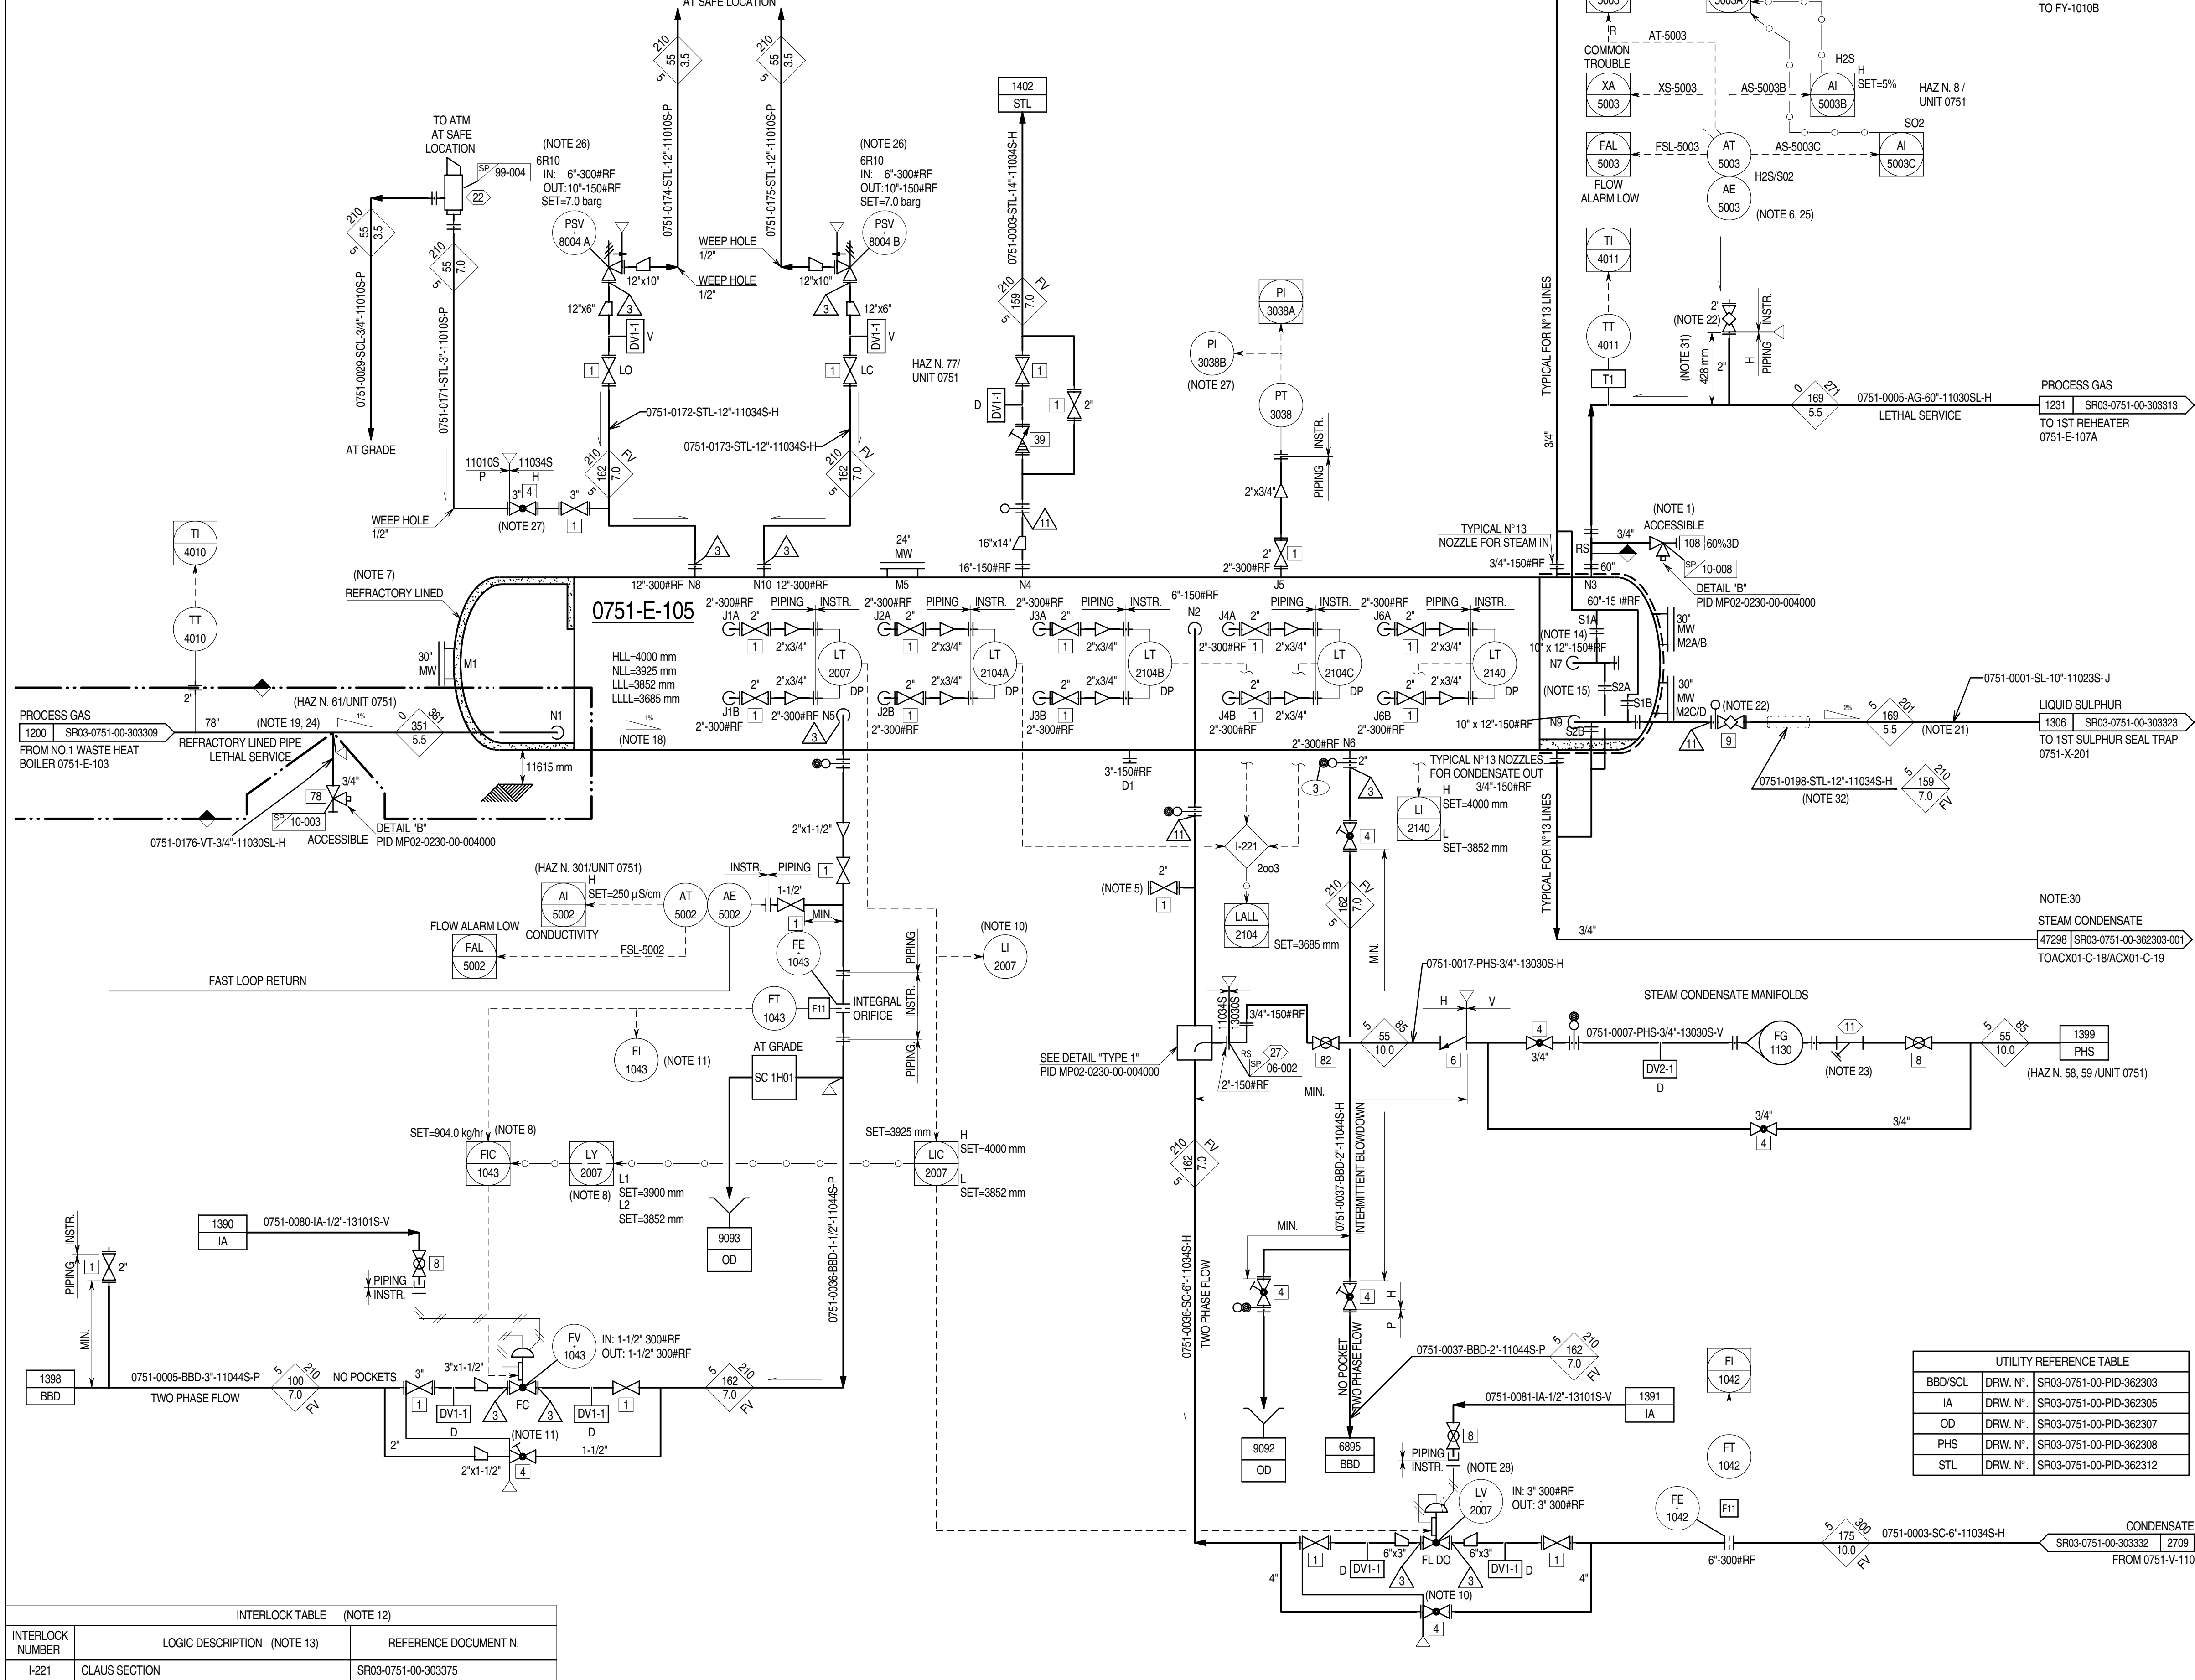

GENERAL NOTES:

1. FOR STANDARD SYMBOLS, DETAILS, ABBREVIATIONS, SAMPLE CONNECTION TYPE, GENERAL NOTES & LEGEND SHEETS REFER TO DRAWING NO. MP02-0230-00-004000 TO 004015.
2. ALL INSTRUMENT TAG NUMBERS ON THIS P&ID INCLUDING PACKAGE UNITS ARE PREFIXED WITH UNIT NUMBER 0751 UNLESS OTHERWISE NOTED.
3. DELETED.

NOTES:

1. THE SAMPLE POINT (STRAHMAN VALVE) IS USED FOR DETERMINING THE STOICHIOMETRIC COMBUSTION RATIO OF FUEL GAS AND AIR DURING START-UP OPERATION WITH A PORTABLE O₂/CO ANALYSER. AT THE SAMPLE POINT 3/4" NPT-F WILL BE CONNECTED AN ANALYZER WITH A PORTABLE SAMPLE CONNECTION SYSTEM.
2. DELETED.
3. DELETED.
4. DELETED.
5. ACID WASH CONNECTION.
6. TAIL GAS ANALYSER MOUNTING DETAILS WILL BE SPECIFIED BY VENDOR. THAT SHOWN IS FOR ILLUSTRATION ONLY.
7. SEE DATA SHEET FOR REFRACTORY LINING DETAILS.
8. AT LOW LEVEL L2 (LV-2) THE DCS LOGIC WILL PUT THE FLOW CONTROL OF CONTINUOUS BLOWDOWN ON MANUAL MODE AND WILL FORCE ITS OUTPUT TO 0% CLOSING FV-1043. AS THE LEVEL RAISES TO L1 (LV-2007), AN ALARM WILL SOUND AND AN OPERATOR WILL PLACE THE BLOWDOWN CONTROL BACK IN AUTO.
9. DELETED.
10. LI-2007 TO BE READABLE FROM LV-2007 BYPASS VALVE.
11. FI-1043 TO BE READABLE FROM FV-1043 BYPASS VALVE.
12. INTERLOCK TABLE IS FOR REFERENCE ONLY. CAUSE AND EFFECT MATRIX SR03-0751-00-CCC-303155 SHALL GOVERN.
13. REFER TO CAUSE AND EFFECT CHART FOR FULL REPRESENTATION OF INTERLOCK INITIATORS AND ACTIONS.
14. THE I/N789 NOZZLES ARE HORIZONTAL AND ARE LOCATED TANGENTIAL TO THE BOTTOM OF THE OUT CHANNEL. NOZZLES CENTER LINES ARE CO-LINEAR. THE N7-N9 NOZZLES ARE STEAM JACKETED.
16. DELETED. (HAZ N. 77/JUNIT 0751)
17. DELETED. (HAZ N. 77/JUNIT 0751)
18. NO.1 FIRST CONDENSER TO HAVE 1% SLOPE TOWARDS SULPHUR OULET END.
19. PROVIDE EXPANDED METAL SHIELD AROUND PIPE BETWEEN 751-E-103 & 751-E-105 FOR PERSONAL PROTECTION.
20. DELETED.
21. FOR SULPHUR JACKETED LINES PROVIDE FLANGED BREAKS AT STANDARD PIPE LENGTHS. FOR CHANGE IN DIRECTION PROVIDE FLANGED CROSSES.
22. STEAM JACKETED PLUG VALVE.
23. STRAINER WITH SCREEN 20 MESH.
24. CONNECTING PIPE BETWEEN 0751-E-103 & 0751-E-105; TO BE DESIGNED AND SUPPLIED BY 0751-E-105 VENDOR.
25. SAMPLE ANALYSER CONNECTION TO BE SHORT AS POSSIBLE WITH POKETS AND TO BE KEPT HOT. (HAZ N. 73/JUNIT 0751)
26. PSV-4004R SIZING CASE: BLOCKED DISCHARGE.
27. PI-3038B TO BE READABLE FROM PSV-8004AB MANUAL VENT VALVE.
28. LOCATE LV-2007 AT GRADE AT MINIMUM DISTANCE FROM 0751-E-105.
29. THERE ARE TWO STEAM SUPPLY MANIFOLDS (PVX). FOR DETAILS REFER TO DRAWING NO. SR03-0751-00-362312-001 AND TO STEAM TRACING LAYOUT DOC NO 0751-13-GAS-362333.
30. THERE ARE TWO STEAM CONDENSATE MANIFOLDS (ACX). FOR DETAILS REFER TO DRAWING NO. SR03-0751-00-362303-001 AND TO STEAM TRACING LAYOUT DOC NO 0751-13-GAS-362333.
31. FROM PIPE OD.
32. FOR STEAM SUPPLY AND CONDENSATE SAFE RETURN REFERS TO TABLE 'A' AND 'B' ON P&ID SR03-0751-00-362312-005.

Z1	04-11-14	IAB	ISSUED FOR AS BUILT	PCA	MAR	AS
2.1E	18-04-14	IFC	ISSUED FOR CONSTRUCTION	PCA	MAR	AS
2.1D	28-02-14	IFC	ISSUED FOR CONSTRUCTION	PCA	MAR	AS
2.1C	05-05-13	IFC	ISSUED FOR CONSTRUCTION	RL	MS	A
2.1B	06-08-12	IFC	ISSUED FOR CONSTRUCTION	DSC	CBR	SIN
2	02-12-11	IFC	ISSUED FOR CONSTRUCTION	DSC	CBR	SIN
1	28-07-11	IFCH	ISSUED FOR CONSTRUCTION WITH HOLDS	DSC	CBR	SIN
0	15-02-11	IFD	ISSUED CLIENT COMMENTS INCORPORATED	BSC	LMA	SIN
B1	30-09-10	ICR	ISSUED FOR CLIENT REVIEW	BSC	LMA	SIN
REV	DATE	STATUS	STATUS DESCRIPTION	BY	CKD	AP

COMPANY:

Abu Dhabi Gas Development Co. Ltd.



CONTRACTOR:

 **saipem**

JOB No. 032090

PROJECT: SHAH GAS DEVELOPMENT (SGD) PROJECT

AGREEMENT No. 13525001


DRAWING TITLE: PIPING & INSTRUMENT DIAGRAM UNIT 0751
SULPHUR RECOVERY AND TAIL GAS TREATING UNIT

EQUIPMENT DESCRIPTION	NO.1 FIRST CONDENSER
TAG/ITEM No.	0751-E-105

CONTRACTOR DRG.No.	751-GD-B-303310		REV. Z1
COMPANY DRG.No.	SR03-0751-00-303310		
SCALE:	SIZE: A1	DOC. CLASS: 1	

Z1	04-11-14	IAB	ISSUED FOR AS BUILT	PCA	MAR	ASP
2.1D	18-04-14	IFC	ISSUED FOR CONSTRUCTION	PCA	MAR	ASP
2.1C	28-02-14	IFC	ISSUED FOR CONSTRUCTION	PCA	MAR	ASP
2.1B	06-08-12	IFC	ISSUED FOR CONSTRUCTION	DSC	CBR	SIN
2	02-12-11	IFC	ISSUED FOR CONSTRUCTION	DSC	CBR	SIN
1	28-07-11	IFCH	ISSUED FOR CONSTRUCTION WITH HOLDS	DSC	CBR	SIN
0	15-02-11	IFD	ISSUED CLIENT COMMENTS INCORPORATED	BSC	LMA	SIN
B1	30-09-10	ICR	ISSUED FOR CLIENT REVIEW	BSC	LMA	SIN
REV	DATE	STATUS	STATUS DESCRIPTION	BY	CKD	APP.

CONTRACTOR DRG.No.		751-GD-B-303311		REV.
COMPANY DRG.No.		SR03-0751-00-303311		
SCALE:	SIZE: A1	DOC. CLASS: 1		

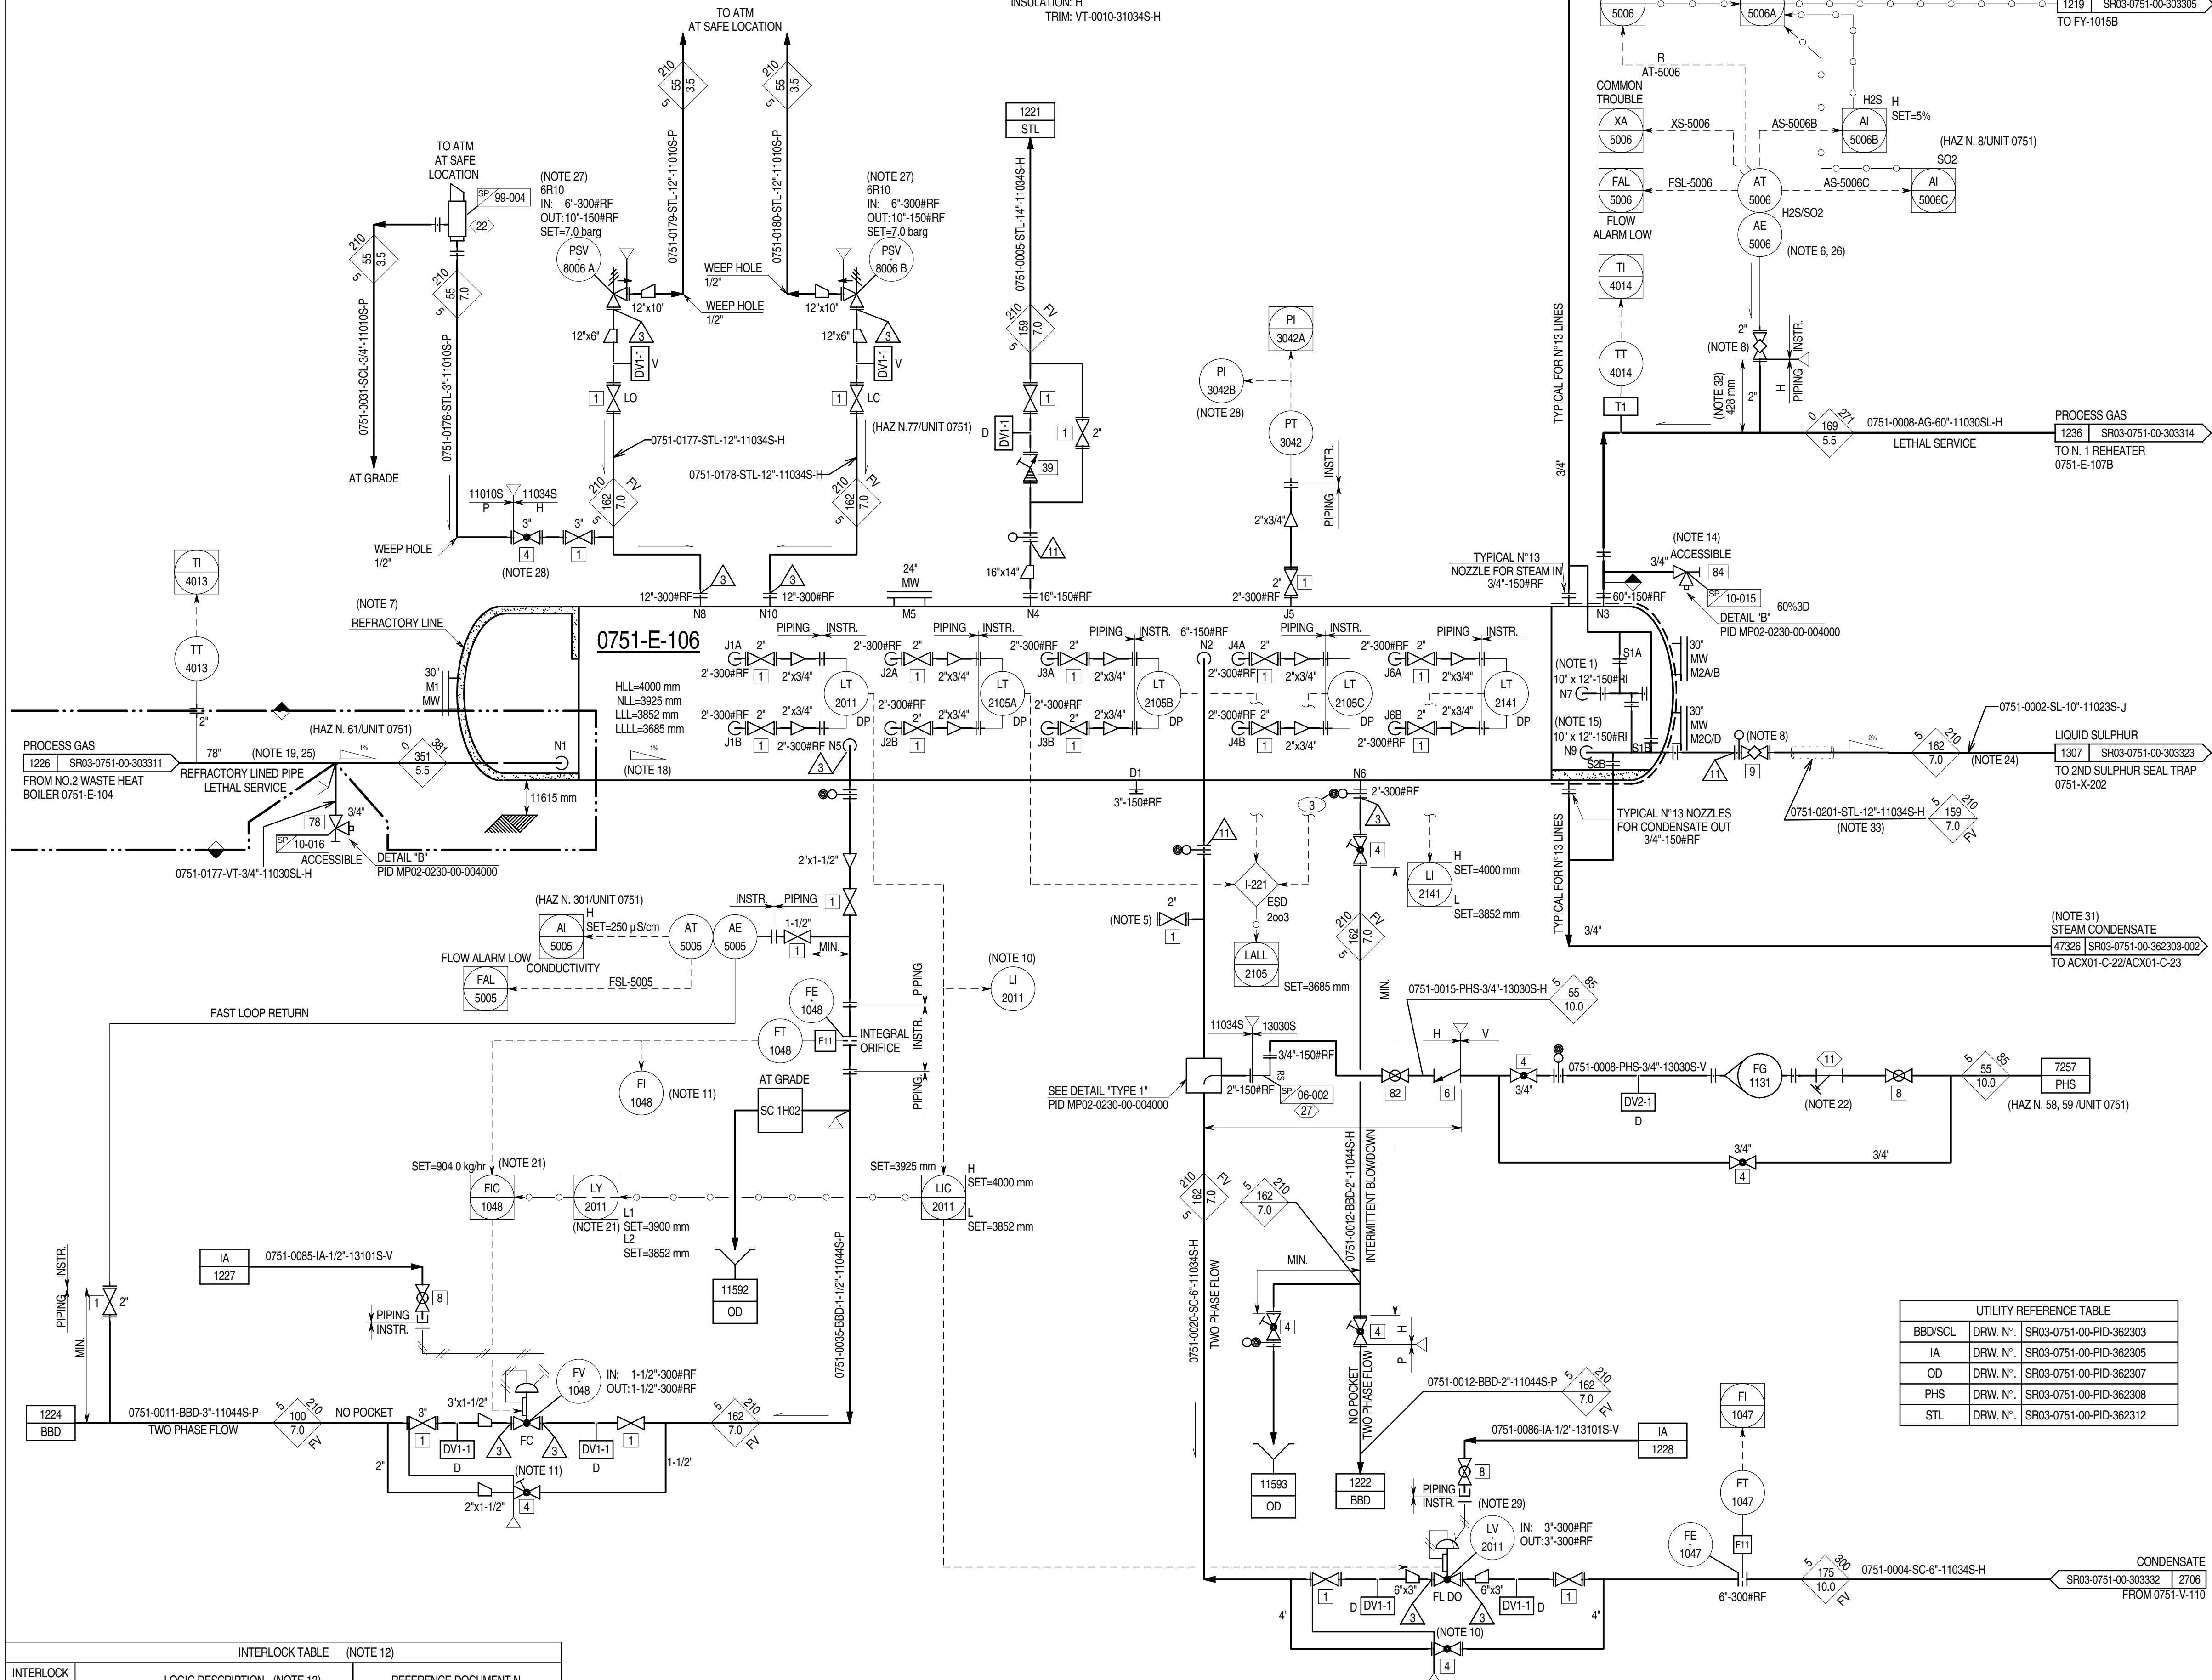

INTERLOCK TABLE (NOTE 12)		
INTERLOCK NUMBER	LOGIC DESCRIPTION (NOTE 13)	REFERENCE DOCUMENT N.
I-221	CLAUS SECTION	SR03-0751-00-303375

GENERAL NOTES:

1. FOR STANDARD SYMBOLS, DETAILS, ABBREVIATIONS, SAMPLE CONNECTION TYPE, GENERAL NOTES & LEGEND SHEETS REFER TO DRAWING NO. MP02-0230-00-004000 TO 004015.
2. ALL INSTRUMENT TAG NUMBERS ON THIS P&ID INCLUDING PACKAGE UNITS ARE PREFIXED WITH UNIT NUMBER 0751 UNLESS OTHERWISE NOTED.
3. DELETED.

NOTES:

1. OUTLET CHANNEL IS STEAM TRACED.
2. DELETED.
3. DELETED.
4. DELETED.
5. ACID WASH CONNECTION.
6. TAIL GAS ANALYSER MOUNTING DETAILS WILL BE SPECIFIED BY VENDOR THAT SHOWN IS FOR ILLUSTRATION ONLY.
7. SEE DATA SHEET FOR REFRACTORY LINING DETAILS.
8. STEAM JACKETED PLUG VALVE.
9. DELETED.
10. LI-2011 TO BE READABLE FROM LV-2011 BYPASS VALVE.
11. FI-1048 TO BE READABLE FROM FV-1048 BYPASS VALVE.
12. INTERLOCK TABLE IS FOR REFERENCE ONLY. CAUSE AND EFFECT MATRIX SR03-0751-00-CCC-303155 SHALL GOVERN.
13. REFER TO CAUSE AND EFFECT CHART FOR FULL REPRESENTATION OF INTERLOCK INITIATORS AND ACTIONS.
14. THE SAMPLE POINT (STRAHMANN VALVE) IS USED FOR DETERMINING THE STOICHIOMETRIC COMBUSTION RATIO OF FUEL GAS AND AIR DURING START-UP OPERATION WITH A PORTABLE O2/CO ANALYSER. AT THE SAMPLE POINT (3/4" NPT-F) WILL BE CONNECTED AN ANALYZER WITH A PORTABLE SAMPLE CONNECTION SYSTEM.
15. THE N7/N9 NOZZLES ARE HORIZONTAL AND ARE LOCATED TANGENTIAL TO THE BOTTOM OF THE OUTLET CHANNEL. NOZZLES CENTER LINES ARE CO-LINEAR. THE N7/N9 NOZZLE ARE STEAM JACKETED.
16. DELETED. HAZ N.77/UNIT 0751
17. DELETED. HAZ N.77/UNIT 0751
18. NO.2 FIRST CONDENSER TO HAVE 1% SLOPE TOWARDS SULPHUR OUTLET END.
19. PROVIDE EXPANDED METAL SHIELD AROUND CONNECTING PIPE BETWEEN 751-E-104 & 751-E-106 FOR PERSONAL PROTECTION.
20. DELETED.
21. AT LOW LEVEL L2 (LV-2011) THE DCS LOGIC WILL PUT THE FLOW CONTROL OF CONTINUOUS BLOWDOWN ON MANUAL AND WILL FORCE ITS OUTPUT TO 0% CLOSING FV-1048. AS THE LEVEL RAISES TO L1 (LV-2011), AN ALARM WILL SOUND AND AN OPERATOR WILL PLACE THE BLOWDOWN CONTROL BACK IN AUTO.
22. STRAINER WITH SCREEN 20 MESH.
23. DELETED.
24. FOR SULPHUR JACKETED LINES PROVIDE FLANGED BREAKS AT STANDARD PIPE LENGTHS. FOR CHANGE IN DIRECTION PROVIDE FLANGED CROSSERS.
25. CONNECTING PIPE BETWEEN 0751-E-104 & 0751-E-106 TO BE DESIGNED AND SUPPLIED BY 0751-E-106 VENDOR.
26. SAMPLE ANALYSER CONNECTION TO BE SHORT AS POSSIBLE WITHOUT POCKETS AND
TO BE KEPT HOT. (HAZ N. 45/UNIT 0751)
27. PSV-8006 SIZING CASE. BLOCKED DISCHARGE.
28. PI-3042B TO BE READABLE FROM PSV-8006A/B MANUAL VENT VALVE.
29. LOCATE LV-2011 AT GRADE AT MINIMUM DISTANCE FROM 0751-E-106.
30. THERE ARE TWO STEAM SUPPLY MANIFOLDS (PVX). FOR DETAILS REFER TO DRAWING NO. SR03-0751-00-362312-001/003 AND TO STEAM TRACING LAYOUT DOC. NO 0751-13-GAS-362333.
31. THERE ARE TWO STEAM CONDENSATE MANIFOLDS (ACX). FOR DETAILS REFER TO DRAWING NO. SR03-0751-00-362303-002 AND TO STEAM TRACING LAYOUT DOC. NO 0751-13-GAS-362333.
32. FROM PIPE OD.
33. FOR STEAM SUPPLY AND CONDENSATE RETURN REFER TO TABLE 'A' AND 'B' ON P&ID SR03-0751-00-362312-005.

Z1	04-11-14	IAB	ISSUED FOR AS BUILT	PCA	MAR	ASB
2.1E	18-04-14	IFC	ISSUED FOR CONSTRUCTION	PCA	MAR	ASB
2.1D	28-02-14	IFC	ISSUED FOR CONSTRUCTION	PCA	MAR	ASB
2.1C	05-05-13	IFC	ISSUED FOR CONSTRUCTION	RL	MS	AS
2.1B	06-08-12	IFC	ISSUED FOR CONSTRUCTION	DSC	CBR	SIN
2	02-12-11	IFC	ISSUED FOR CONSTRUCTION	DSC	CBR	SIN
1	28-07-11	IFCH	ISSUED FOR CONSTRUCTION WITH HOLDS	DSC	CBR	SIN
0	15-02-11	IFD	ISSUED CLIENT COMMENTS INCORPORATED	BSC	LMA	SIN
B1	30-09-10	ICR	ISSUED FOR CLIENT REVIEW	BSC	LMA	SIN
REV	DATE	STATUS	STATUS DESCRIPTION	BY	CKD	APP.

COMPANY: Abu Dhabi Gas Development Co. Ltd.



CONTRACTOR:

 **saipem**

JOB No. 032090


PROJECT: SHAH GAS DEVELOPMENT (SGD) PROJECT

AGREEMENT No. 13525001

DRAWING TITLE: PIPING & INSTRUMENT DIAGRAM UNIT 0751
SULPHUR RECOVERY AND TAIL GAS TREATING UNIT

EQUIPMENT DESCRIPTION	NO.2 FIRST CONDENSER
TAG/ITEM No.	0751-E-106

CONTRACTOR DRG No.		751-GD-B-303312		REV. Z1
COMPANY DRG No.		SR03-0751-00-303312		
SCALE:	SIZE: A1	DOC. CLASS: 1		

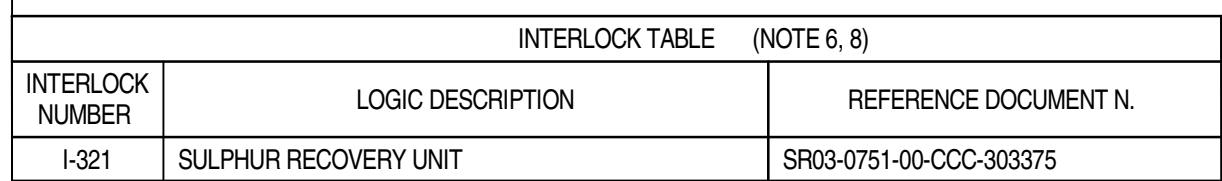

- | UTILITY REFERENCE TABLE | | |
|-------------------------|----------|-------------------------|
| IA | DRW. N°. | SR03-0751-00-PID-362305 |
| OD | DRW. N°. | SR03-0751-00-PID-362307 |
| STH/SCH | DRW. N°. | SR03-0751-00-PID-362312 |

Z1	04-11-14	IAB	ISSUED FOR AS BUILT	PCA	MAR	ASP
2.1D	18-04-14	IFC	ISSUED FOR CONSTRUCTION	PCA	MAR	ASP
2.1C	10-03-13	IFC	ISSUED FOR CONSTRUCTION	RL	CN	MZ
2.1B	06-08-12	IFC	ISSUED FOR CONSTRUCTION	DSC	CBR	SIN
2	02-12-11	IFC	ISSUED FOR CONSTRUCTION	DSC	CBR	SIN
1	28-07-11	IFCH	ISSUED FOR CONSTRUCTION WITH HOLDS	DSC	CBR	SIN
0	15-02-11	IFD	ISSUED CLIENT COMMENTS INCORPORATED	BSC	LMA	SIN
B1	30-09-10	ICR	ISSUED FOR CLIENT REVIEW	BSC	LMA	SIN
REV	DATE	STATUS	STATUS DESCRIPTION	BY	CKD	APP.

COMPANY:

Abu Dhabi Gas Development Co. Ltd.



CONTRACTOR:  **saipem**

JOB No. 032090


PROJECT: SHAH GAS DEVELOPMENT (SGD) PROJECT

AGREEMENT No. 13525001

DRAWING TITLE: PIPING & INSTRUMENT DIAGRAM UNIT 0751 SULPHUR RECOVERY AND TAIL GAS TREATING UNIT	
EQUIPMENT DESCRIPTION	NO.1 REHEATER A
TAGITEM No.	0751-E-107A 0751-V-107A

CONTRACTOR DRG. No.	751-GD-B-303313		REV. Z1
COMPANY DRG. No.	SR03-0751-00-303313		
SCALE:	SIZE: A1	DOC. CLASS: 1	

THIS DOCUMENT IS THE PROPERTY OF ABU DHABI GAS DEVELOPMENT COMPANY LIMITED AND CONTAINS INFORMATION WHICH IS PROPRIETARY. THIS INFORMATION IS TO BE HELD IN CONFIDENCE. NO DISCLOSURE OR OTHER USE OF THIS DOCUMENT IS TO BE MADE WITHOUT THE PRIOR WRITTEN CONSENT OF ABU DHABI GAS DEVELOPMENT COMPANY LIMITED.

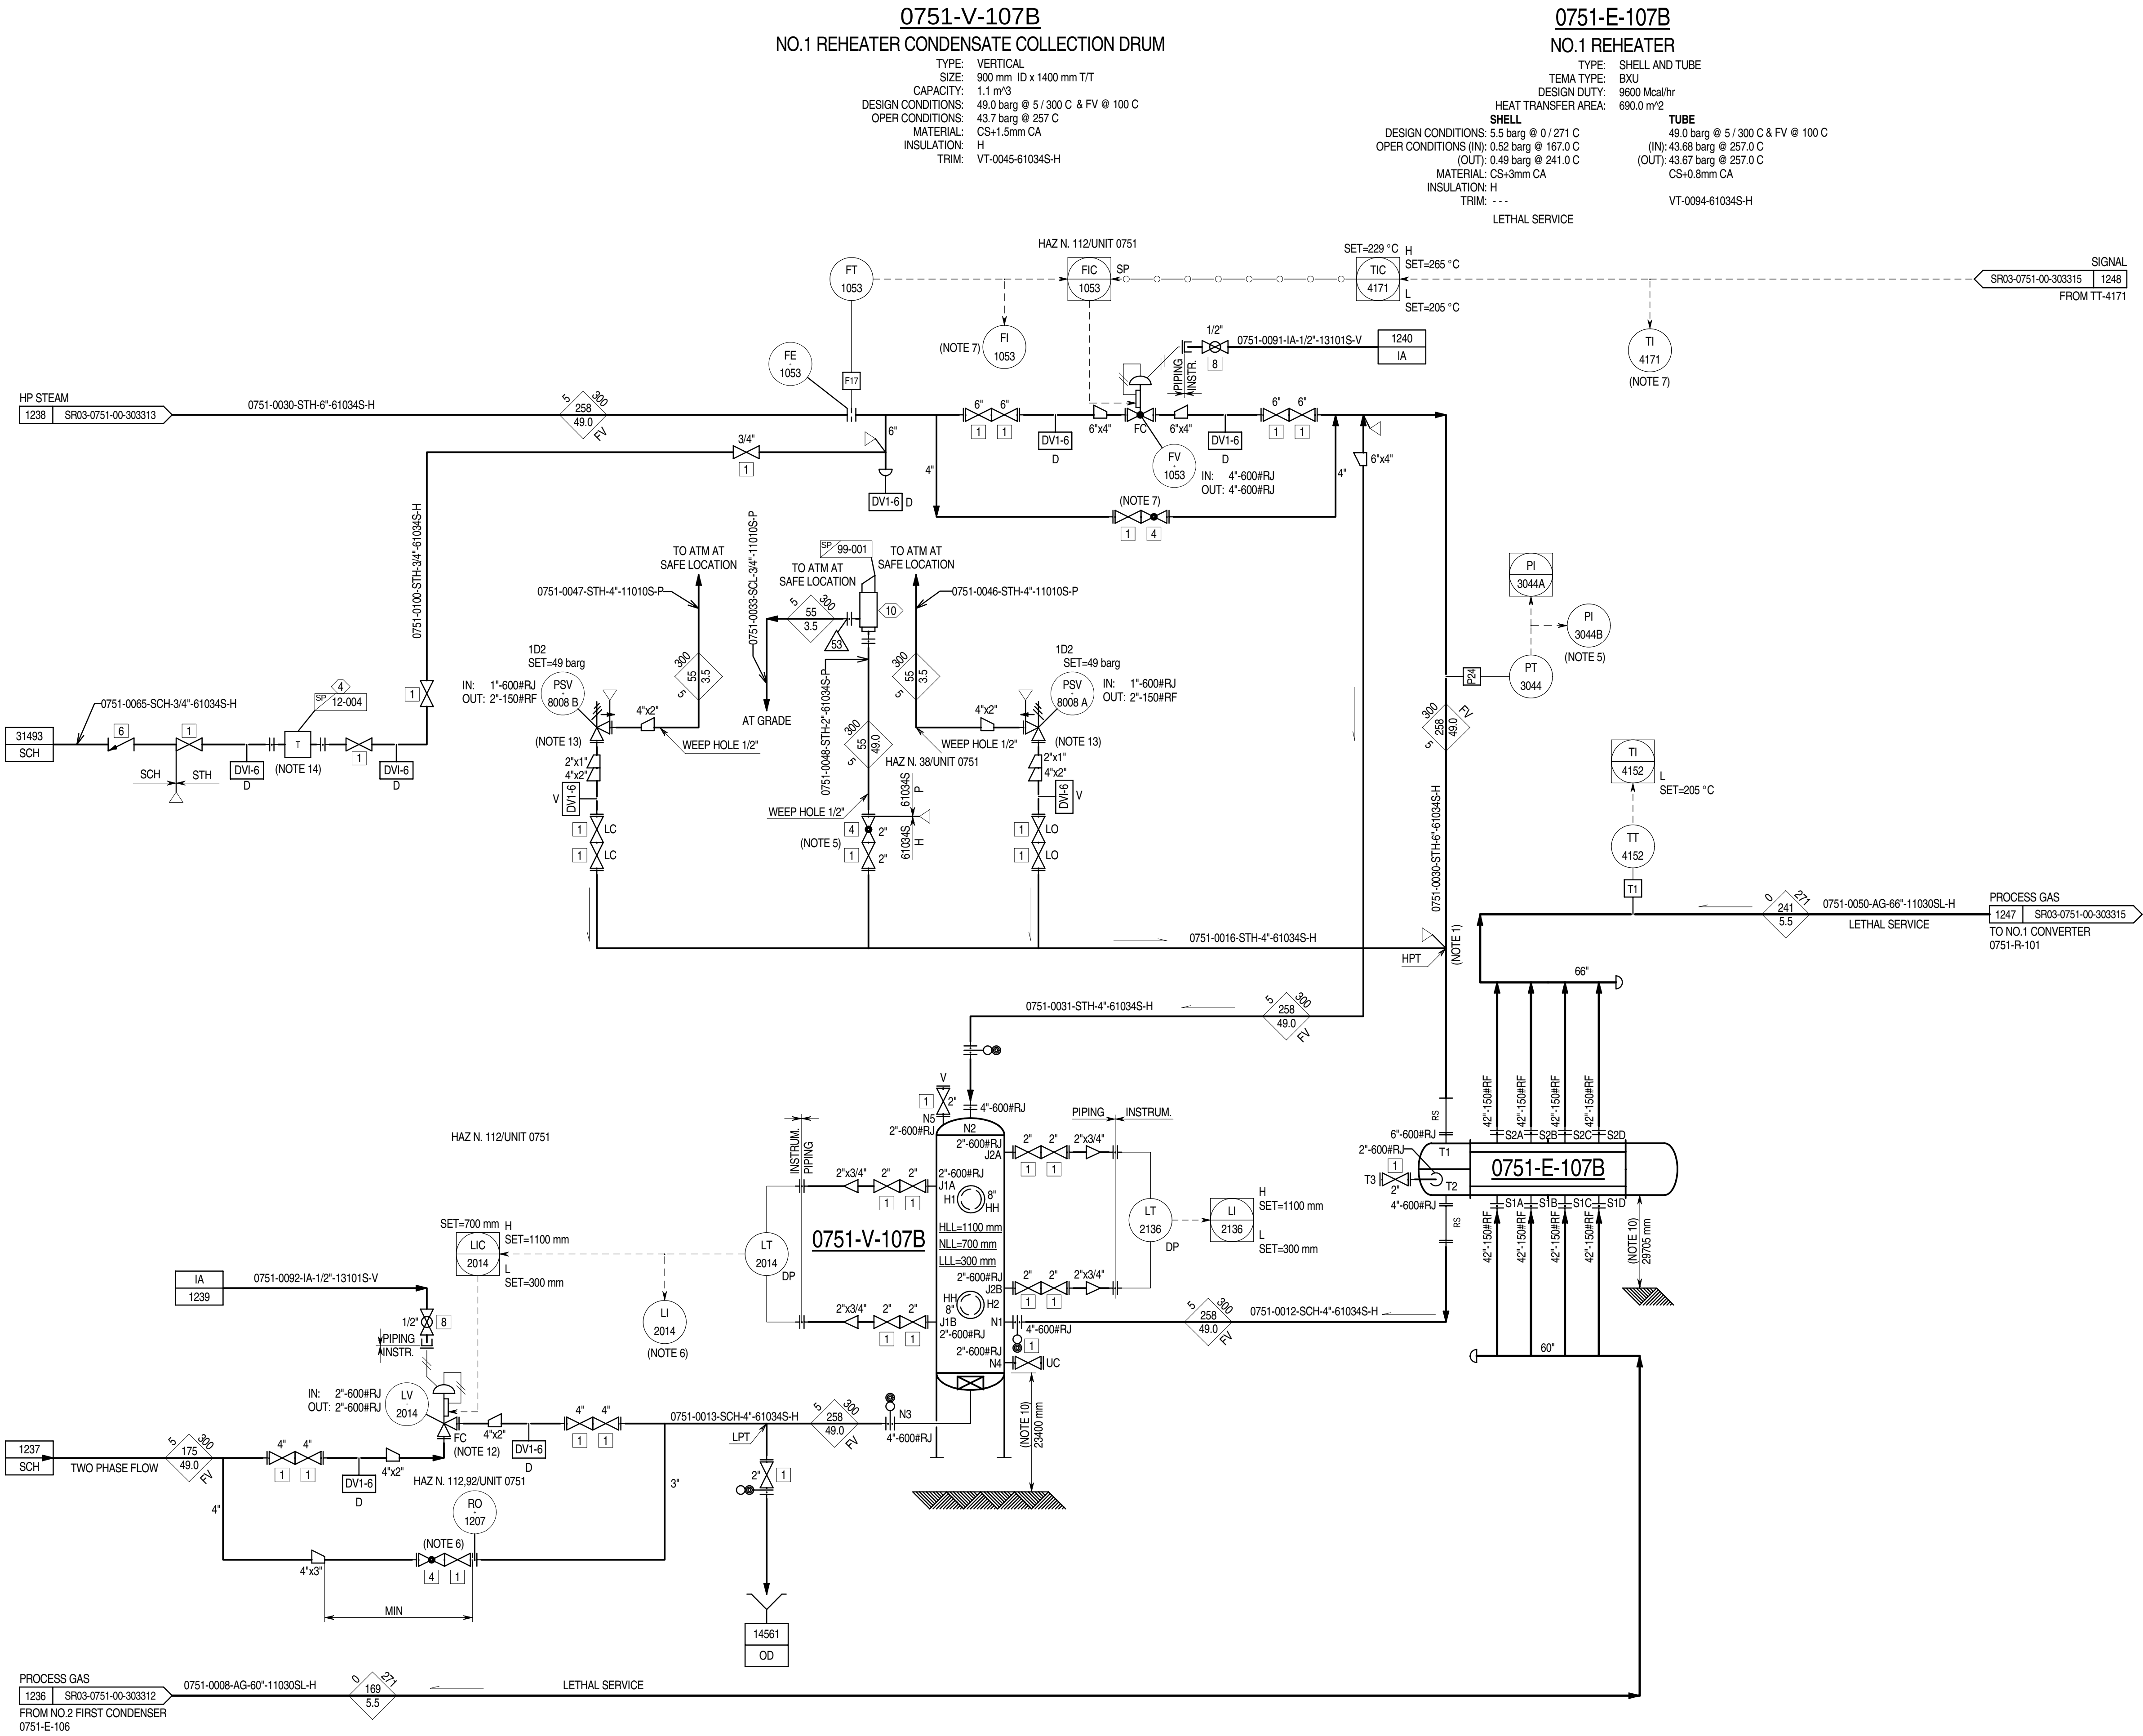

- GENERAL NOTES:**
- FOR STANDARD SYMBOLS, DETAILS, ABBREVIATIONS, SAMPLE CONNECTION TYPE. GENERAL NOTES & LEGEND SHEETS REFER TO DRAWING NO. MP02-0230-00-004000 TO 004015.
 - ALL INSTRUMENT TAG NUMBERS ON THIS P&ID INCLUDING PACKAGE UNITS ARE PREFIXED WITH UNIT NUMBER 0751 UNLESS OTHERWISE NOTED.
 - DELETED.
- NOTES:**
- LOCATE PSV/VENT CONNECTION AT HIGH POINT OF STEAM LINE FROM TOP OF PIPE.
 - DELETED.
 - DELETED.
 - DELETED.
 - PI-3044 TO BE READABLE FROM PSV-8008A/B MANUAL VENT VALVE.
 - LI-2014 TO BE READABLE FROM LV-2014 BYPASS VALVE.
 - FI-1053 AND TI-4171 TO BE READABLE FROM FV-1053 BYPASS VALVE.
 - DELETED.
 - DELETED.
 - 0751-E-107B BOTTOM TANGENT LINE TO BE LOCATED 900mm MIN ABOVE 0751-V-107B HIGH LIQUID LEVEL.
 - DELETED.
 - VALVE TO BE PROVIDED WITH LOCAL SIGN: "WARNING: TRIM SIZE AFFECTS RELIEF VALVE CAPACITY".
 - PSV SIZING CASE: FIRE.
 - STEAM TRAP TO BE PROVIDED WITH INTEGRAL INLET STRAINER OTHERWISE A DEDICATED PIPING STRAINER TO BE INSTALLER.

UTILITY REFERENCE TABLE		
IA	DRW. N°.	SR03-0751-00-PID-362305
OD	DRW. N°.	SR03-0751-00-PID-362307
SCH	DRW. N°.	SR03-0751-00-PID-362312

Z1	04-11-14	IAB	ISSUED FOR AS BUILT	PCA	MAR	ASP
2.1D	18-04-14	IFC	ISSUED FOR CONSTRUCTION	PCA	MAR	ASP
2.1C	10-03-13	IFC	ISSUED FOR CONSTRUCTION	RL	CN	MZ
2.1B	06-08-12	IFC	ISSUED FOR CONSTRUCTION	DSC	CBR	SIN
2	02-12-11	IFC	ISSUED FOR CONSTRUCTION	DSC	CBR	SIN
1	28-07-11	IFCH	ISSUED FOR CONSTRUCTION WITH HOLDS	DSC	CBR	SIN
0	15-02-11	IFD	ISSUED CLIENT COMMENTS INCORPORATED	BSC	LMA	SIN
B1	30-09-10	ICR	ISSUED FOR CLIENT REVIEW	BSC	LMA	SIN
REV	DATE	STATUS	STATUS DESCRIPTION	BY	CKD	APP.

COMPANY:

Abu Dhabi Gas Development Co. Ltd.

الحدس للغاز
Al Hosn Gas

CONTRACTOR:

eni saipem

JOB No. 032090

PROJECT: SHAH GAS DEVELOPMENT (SGD) PROJECT

AGREEMENT No. 13525001

DRAWING TITLE: PIPING & INSTRUMENT DIAGRAM UNIT 0751 SULPHUR RECOVERY AND TAIL GAS TREATING UNIT		
EQUIPMENT DESCRIPTION	NO.1 REHEATER B	
TAGITEM No.	0751-E-107B 0751-V-107B	
CONTRACTOR DRG.No.	751-GD-B-303314	
COMPANY DRG.No.	SR03-0751-00-303314	
SCALE:	SIZE: A1	DOC. CLASS: 1
		REV. Z1

THIS DOCUMENT IS THE PROPERTY OF ABU DHABI GAS DEVELOPMENT COMPANY LIMITED AND CONTAINS INFORMATION WHICH IS PROPRIETARY. THIS INFORMATION IS TO BE HELD IN CONFIDENCE. NO DISCLOSURE OR OTHER USE OF THIS DOCUMENT IS TO BE MADE WITHOUT THE PRIOR WRITTEN CONSENT OF ABU DHABI GAS DEVELOPMENT COMPANY LIMITED.

0751-R-101 NO.1 CONVERTER

TYPE: HORIZONTAL
SIZE: 6300 mm ID x 33000 mm T/T
CAPACITY: 451364 m³/h
DESIGN CONDITIONS: 5.5 barg @ 0.0 / 337.0 °C
OPER. CONDITIONS: 0.6 barg @ 229.0 °C
MATERIAL: CS+3mm CA (PWH-T)/ INTERNAL REFRACTORY LINED 50 mm
INSULATION: P
TRIM: VT-0066-31059SL-H
LETHAL SERVICE


PROCESS GAS
1250 SR03-0751-00-303313
FROM NO.1 REHEATER
0751-E-107A

PROCESS GAS
1247 SR03-0751-00-303314
FROM NO.1 REHEATER
0751-E-107B

SIGNAL
SR03-0751-00-303314 1248
TO TIC-4171

SIGNAL
SR03-0751-00-303313 1249
TO TIC-4015

INTERLOCK TABLE (NOTE 10)		
INTERLOCK NUMBER	LOGIC DESCRIPTION (NOTE 15)	REFERENCE DOCUMENT N.
I-109	NO. 1 & 2 CONVERTER PURGE	SR03-0751-00-303375

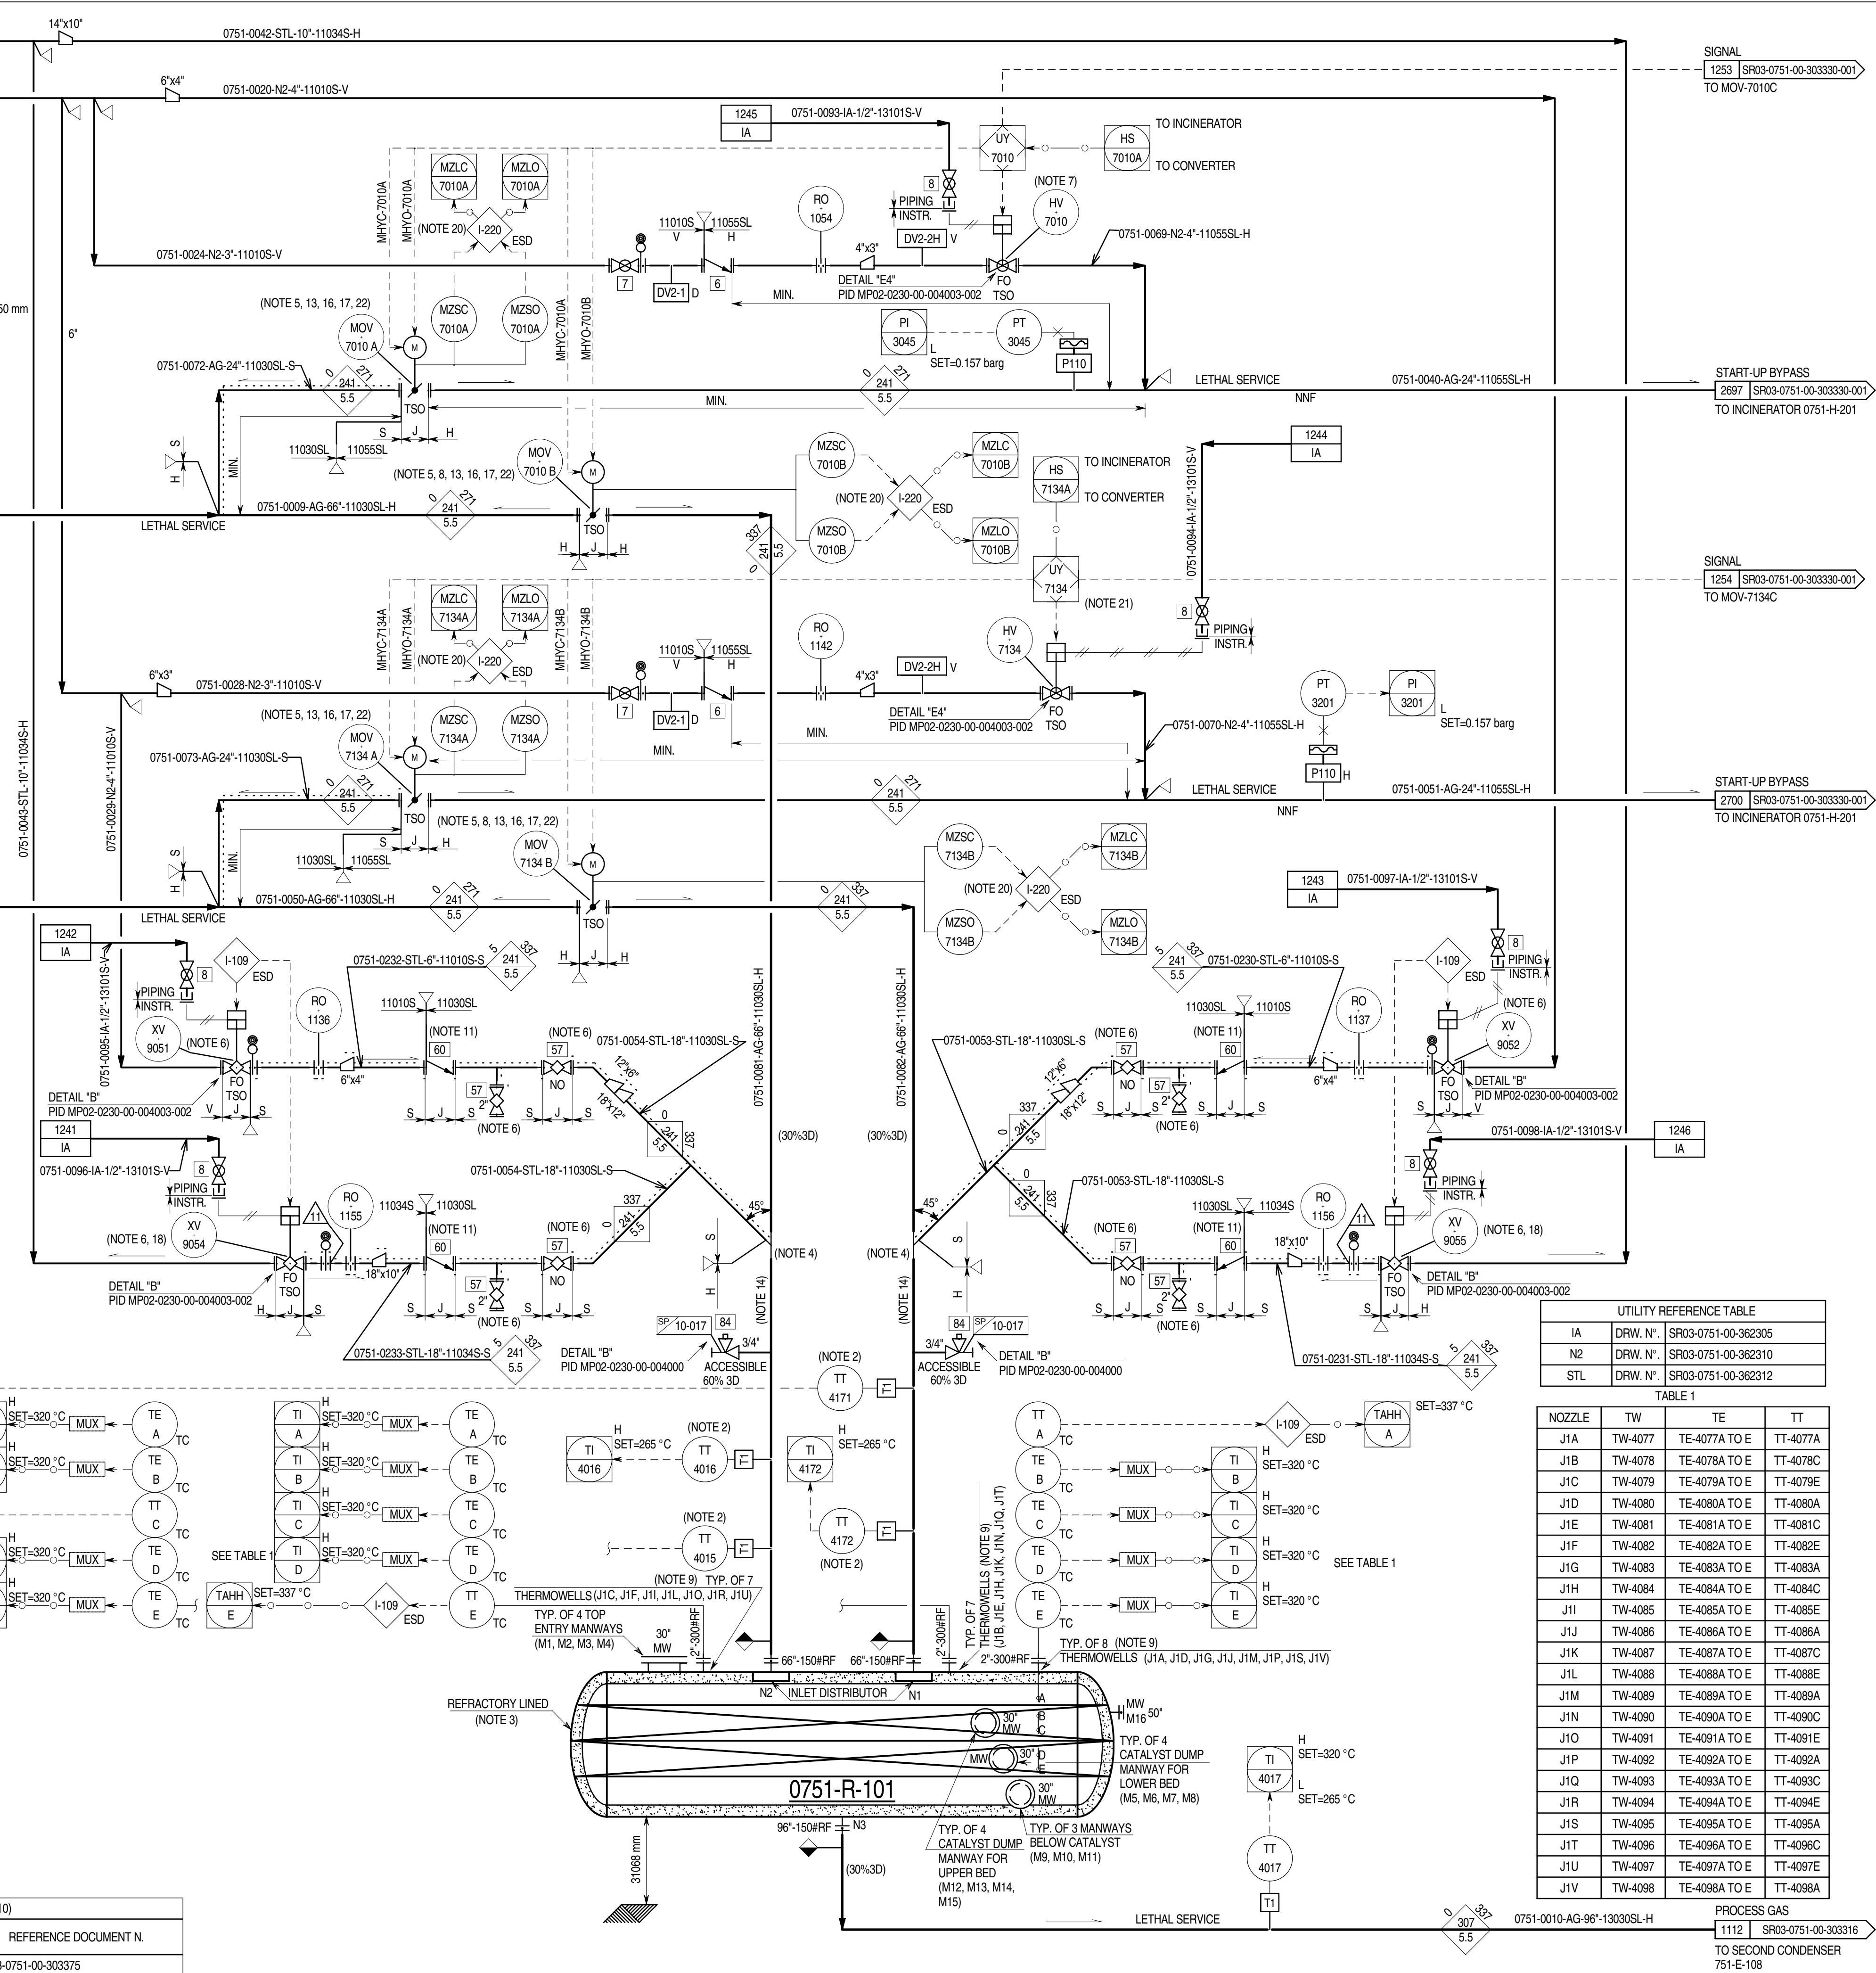

- GENERAL NOTES:**
- FOR STANDARD SYMBOLS, DETAILS, ABBREVIATIONS, SAMPLE CONNECTION TYPE, GENERAL NOTES & LEGEND SHEETS REFER TO DRAWING NO. MP02-0230-00-004000 TO 004015.
 - ALL INSTRUMENT TAG NUMBERS ON THIS PID INCLUDING PACKAGE UNITS ARE PREFIXED WITH UNIT NUMBER 0751 UNLESS OTHERWISE NOTED.
 - DELETED.
- NOTES:**
- DELETED.
 - LOCATE TT-4015/4016/4171/4172 AS CLOSE AS POSSIBLE TO NO. 1 CONVERTER.
 - SEE DATA SHEET FOR REFRACTORY LINING DETAIL.
 - NITROGEN/STEAM PURGE CONNECTION AT 45° TO VERTICAL.
 - STEAM JACKETED VALVE WITH HEATED SHAFT AND DISC.
 - STEAM JACKETED PLUG VALVE.
 - THE HAND SWITCH HS-7010A ALLOWS TO MANUALLY SELECT THE OPERATING MODE. THE CONTROL LOGIC UY-7010 WILL CLOSE THE MAIN VALVE (MOV-7010B) AND OPEN THE TWO START-UP BY-PASS VALVES (MOV-7010A/7010C). THE CONTROL LOGIC WILL NOT ALLOW THE MAIN PROCESS VALVE TO CLOSE UNTIL THE START-UP BY-PASS VALVES ARE COMPLETELY OPEN. IN ADDITION, CONTROL LOGIC WILL NOT ALLOW THE START-UP BY-PASS VALVES (MOV-7010A/7010C) TO CLOSE UNTIL THE MAIN PROCESS VALVE (MOV-7010B) IS COMPLETELY OPEN WHEN THE BY-PASS IS NO LONGER REQUIRED, THE MAIN VALVE (MOV-7010B) OPENS. THE FIRST BY-PASS VALVE (MOV-7010A) ONLY CLOSURES. PURGE N2 VALVE (HV-7010) OPENS FOR 15 MIN. THE SECOND BY-PASS VALVE (MOV-7010C) (ON DRAWING SR03-0751-00-303330-0001) CLOSURES, TRAPPING N2 BETWEEN THE TWO 24" MOVs. FOR MORE DETAIL REFER TO PROCESS CONTROL NARRATIVE (DOC. N. SR03-0751-00-SPE-303163).
 - THE VALVE SHALL BE LOCATED ON THE PLATFORM (DMS PI-003).
 - THE CONVERTER IS EQUIPPED WITH 22 VERTICAL THERMOWELLS AND 5 THERMOCOUPLES (A, B, C, D, E) PER THERMOWELL AT DIFFERENT BED HEIGHTS. A HIGH-HIGH TEMPERATURE TRIP IS PROVIDED ON ONE THERMOCOUPLE PER THERMOWELL WITH AN ALTERNATE CONFIGURATION (A, C, E). SO 22 TAAH ARE ARRANGED ON ALL LAYERS OF THE CONVERTER. A 50022 VOTING ESD LOGIC OPENS THE VALVES XV-9051/9052/9054/9055 ON NITROGEN AND STEAM LINES. ALL REMAINING THERMOCOUPLES ARE PROVIDED WITH DCS INDICATION AND HIGH TEMPERATURE ALARM.
 - INTERLOCK TABLE IS FOR REFERENCE ONLY. CAUSE AND EFFECT MATRIX SR03-0751-CCC-303155 SHALL GOVERN.
 - STEAM JACKETED CHECK VALVE TILTING DISK TYPE.
 - DELETED.
 - HAND JACK IS PROVIDED IN WAREHOUSE.
 - REMOVABLE SPOOL TO BE PROVIDED FROM MOV-7010B TO N2 NOZZLE ON 0751-R-101 AND MOV-7134B TO N1 NOZZLE ON 0751-R-101. (300/302)
 - REFER TO CAUSE AND EFFECT CHART FOR FULL REPRESENTATION OF INTERLOCK INITIATORS AND ACTIONS.
 - TRAVEL TIME TO BE NOT LESS THAN 120 SECONDS FOR MOV-7010A AND MOV-7134A; AND NOT LESS THAN 330 SECONDS FOR MOV-7010B AND MOV-7134B. (HAZ N. 88/UNIT 0751)
 - LOCAL OPEN/CLOSE/STOP CONTROL TO BE INHIBITED.
 - VALVE INSTALLED AT HIGH POINT (HAZ N. 84/UNIT 0751).
 - IN CASE ONE OF THE ACID GAS ON/OFF VALVE LIMIT SWITCHES (XZLC-9060 OR XZLC-9061 ON DRAWING SR03-0751-00-303301) DOES NOT CONFIRM THE CLOSED POSITION OF ITS VALVE, THE LOGIC I-220 FOR SWITCH OVER TO START-UP BY PASS WILL NOT BE STARTED. (HAZ N. 91/UNIT 0751)
 - SIGNAL TO BE SEGREGATED REFERENCE TO BE MADE TO MAIN BURNERS AND CLAUS SECTION ESD 0751-I-220/0751-I-221 LOGIC SYSTEM DESCRIPTION, DOCUMENT N. SR03-0751-00-SPE-303161.
 - THE HAND SWITCH HS-7134A ALLOWS TO MANUALLY SELECT THE OPERATING MODE. THE CONTROL LOGIC UY-7134 WILL CLOSE THE MAIN VALVE (MOV-7134B) AND OPEN THE TWO START-UP BY-PASS VALVES (MOV-7134A/7134C). THE CONTROL LOGIC WILL NOT ALLOW THE MAIN PROCESS VALVE TO CLOSE UNTIL THE START-UP BY-PASS VALVES ARE COMPLETELY OPEN. IN ADDITION, CONTROL LOGIC WILL NOT ALLOW THE START-UP BY-PASS VALVES (MOV-7134A/7134C) TO CLOSE UNTIL THE MAIN PROCESS VALVE (MOV-7134B) IS COMPLETELY OPEN. WHEN THE BY-PASS IS NO LONGER REQUIRED, THE MAIN VALVE (MOV-7134B) OPENS. THE FIRST BY-PASS VALVE (MOV-7134C) ONLY CLOSURES. PURGE N2 VALVE (HV-7134) OPENS FOR 15 MIN. THE SECOND BY-PASS VALVE (MOV-7134C) (ON DRAWING SR03-0751-00-303330-0001) CLOSURES, TRAPPING N2 BETWEEN THE TWO 24" MOVs FOR MORE DETAIL REFER TO PROCESS CONTROL NARRATIVE (DOC. N. SR03-0751-00-SPE-303163).
 - DISCREPANCY ALARM SHALL BE PROVIDED.

ZI	04-11-14	IAB	ISSUED FOR AS BUILT	PCA	MAR	ASP
2.1D	18-04-14	IFC	ISSUED FOR CONSTRUCTION	PCA	MAR	ASP
2.1C	28-02-14	IFC	ISSUED FOR CONSTRUCTION	PCA	MAR	ASP
2.1B	06-08-12	IFC	ISSUED FOR CONSTRUCTION	DSC	CBR	SIN
2	02-12-11	IFC	ISSUED FOR CONSTRUCTION	DSC	CBR	SIN
1	28-07-11	IFCH	ISSUED FOR CONSTRUCTION WITH HOLDS	DSC	CBR	SIN
0	15-02-11	IFD	ISSUED CLIENT COMMENTS INCORPORATED	BSC	LMA	SIN
B1	30-09-10	ICR	ISSUED FOR CLIENT REVIEW	BSC	LMA	SIN
REV	DATE	STATUS	STATUS DESCRIPTION	BY	CKD	APP.

COMPANY:

Abu Dhabi Gas Development Co. Ltd.

الحصن للغاز
Al Hosn Gas

CONTRACTOR:

eni saipem

JOB No. 032090

PROJECT:

SHAH GAS DEVELOPMENT (SGD) PROJECT

AGREEMENT No. 13525001

DRAWING TITLE: PIPING & INSTRUMENT DIAGRAM UNIT 0751
SULPHUR RECOVERY AND TAIL GAS TREATING UNIT

EQUIPMENT DESCRIPTION	NO.1 CONVERTER
TAGITEM No.	0751-R-101


CONTRACTOR DRG. No.	751-GD-B-303315	REV.	Z1
COMPANY DRG. No.	SR03-0751-00-303315		
SCALE:	SIZE: A1	DOC. CLASS: 1	

1. LOCATE PSV VENT CONNECTION AT HIGH POINT OF STEAM LINE FROM TOP OF PIPE.
2. DELETED.
3. FI-1057A, FI-1057B AND TI-4019 TO BE READABLE FROM FV-1057 BY-PASS VALVE.
4. LI-2017 READABLE TO BE FROM LV-2017 BY-PASS VALVE.
5. DELETED.
6. INTERLOCK TABLE IS FOR REFERENCE ONLY. CAUSE AND EFFECT CHART SR03-0751-CCC-303155 SHALL GOVERN.
7. PI-3047B TO BE READABLE FROM PSV-8010A/B MANUAL VENT VALVE.
8. REFER TO CAUSE AND EFFECT CHART FOR FULL REPRESENTATION OF INTERLOCK INITIATORS AND ACTIONS.
9. DELETED.
10. 0751-V-108A BOTTOM TANGENT LINE TO BE LOCATED 900 mm MIN ABOVE 0751-V-108A HIGH LIQUID LEVEL.
11. DELETED.
12. PSV SIZING CASE: FIRE.
13. VALVE TO BE PROVIDED WITH LOCAL BILINGUAL (ENGLISH/ARABIC) SIGN: "WARNING: TRIM SIZE AFFECTS RELIEF VALVE CAPACITY"
14. GLOBE VALVE USED FOR WARM UP.
15. STEAM TRAP TO BE PROVIDED WITH INTEGRAL INLET STRAINER OTHERWISE A DEDICATED PIPING STRAINER TO BE INSTALLED.
16. N. 2 TRANSMITTERS SHALL BE PROVIDED TO COVER THE COMPLETE REQUEST INSTRUMENT RANGEABILITY:
TRANSMITTER "A" -> LOW RANGE
TRANSMITTER "B" -> HIGH RANGE.

Z1	04-11-14	IAB	ISSUED FOR AS BUILT	PCA	MAR	ASS
2.1D	18-04-14	IFC	ISSUED FOR CONSTRUCTION	PCA	MAR	ASS
2.1C	10-03-13	IFC	ISSUED FOR CONSTRUCTION	RL	CN	MZ
2.1B	06-08-12	IFC	ISSUED FOR CONSTRUCTION	DSC	CBR	SIN
2	02-12-11	IFC	ISSUED FOR CONSTRUCTION	DSC	CBR	SIN
1	28-07-11	IFCH	ISSUED FOR CONSTRUCTION WITH HOLDS	DSC	CBR	SIN
0	15-02-11	IFD	ISSUED CLIENT COMMENTS INCORPORATED	BSC	LMA	SIN
B1	30-09-10	ICR	ISSUED FOR CLIENT REVIEW	BSC	LMA	SIN
REV	DATE	STATUS	STATUS DESCRIPTION	BY	CKD	APP

COMPANY:

Abu Dhabi Gas Development Co. Ltd.

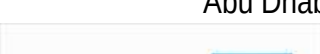

CONTRACTOR:

 **saipem**

JOB No. 032090

PROJECT: SHAH GAS DEVELOPMENT (SGD) PROJECT


AGREEMENT No. 13525001

DRAWING TITLE: PIPING & INSTRUMENT DIAGRAM UNIT 0751
SULPHUR RECOVERY AND TAIL GAS TREATING UNIT

EQUIPMENT DESCRIPTION	NO.2 REHEATER A	
TAG/ITEM No.	0751-E-109A	0751-V-108A

CONTRACTOR DRG.No.		751-GD-B-303317	REV. Z1
COMPANY DRG.No.		SR03-0751-00-303317	
SCALE:	SIZE: A1	DOC. CLASS: 1	

THIS DOCUMENT IS THE PROPERTY OF ABU DHABI GAS DEVELOPMENT COMPANY LIMITED AND CONTAINS INFORMATION WHICH IS PROPRIETARY. THIS INFORMATION IS TO BE HELD IN CONFIDENCE. NO DISCLOSURE OR OTHER USE OF THIS DOCUMENT IS TO BE MADE WITHOUT THE PRIOR WRITTEN CONSENT OF ABU DHABI GAS DEVELOPMENT COMPANY LIMITED.

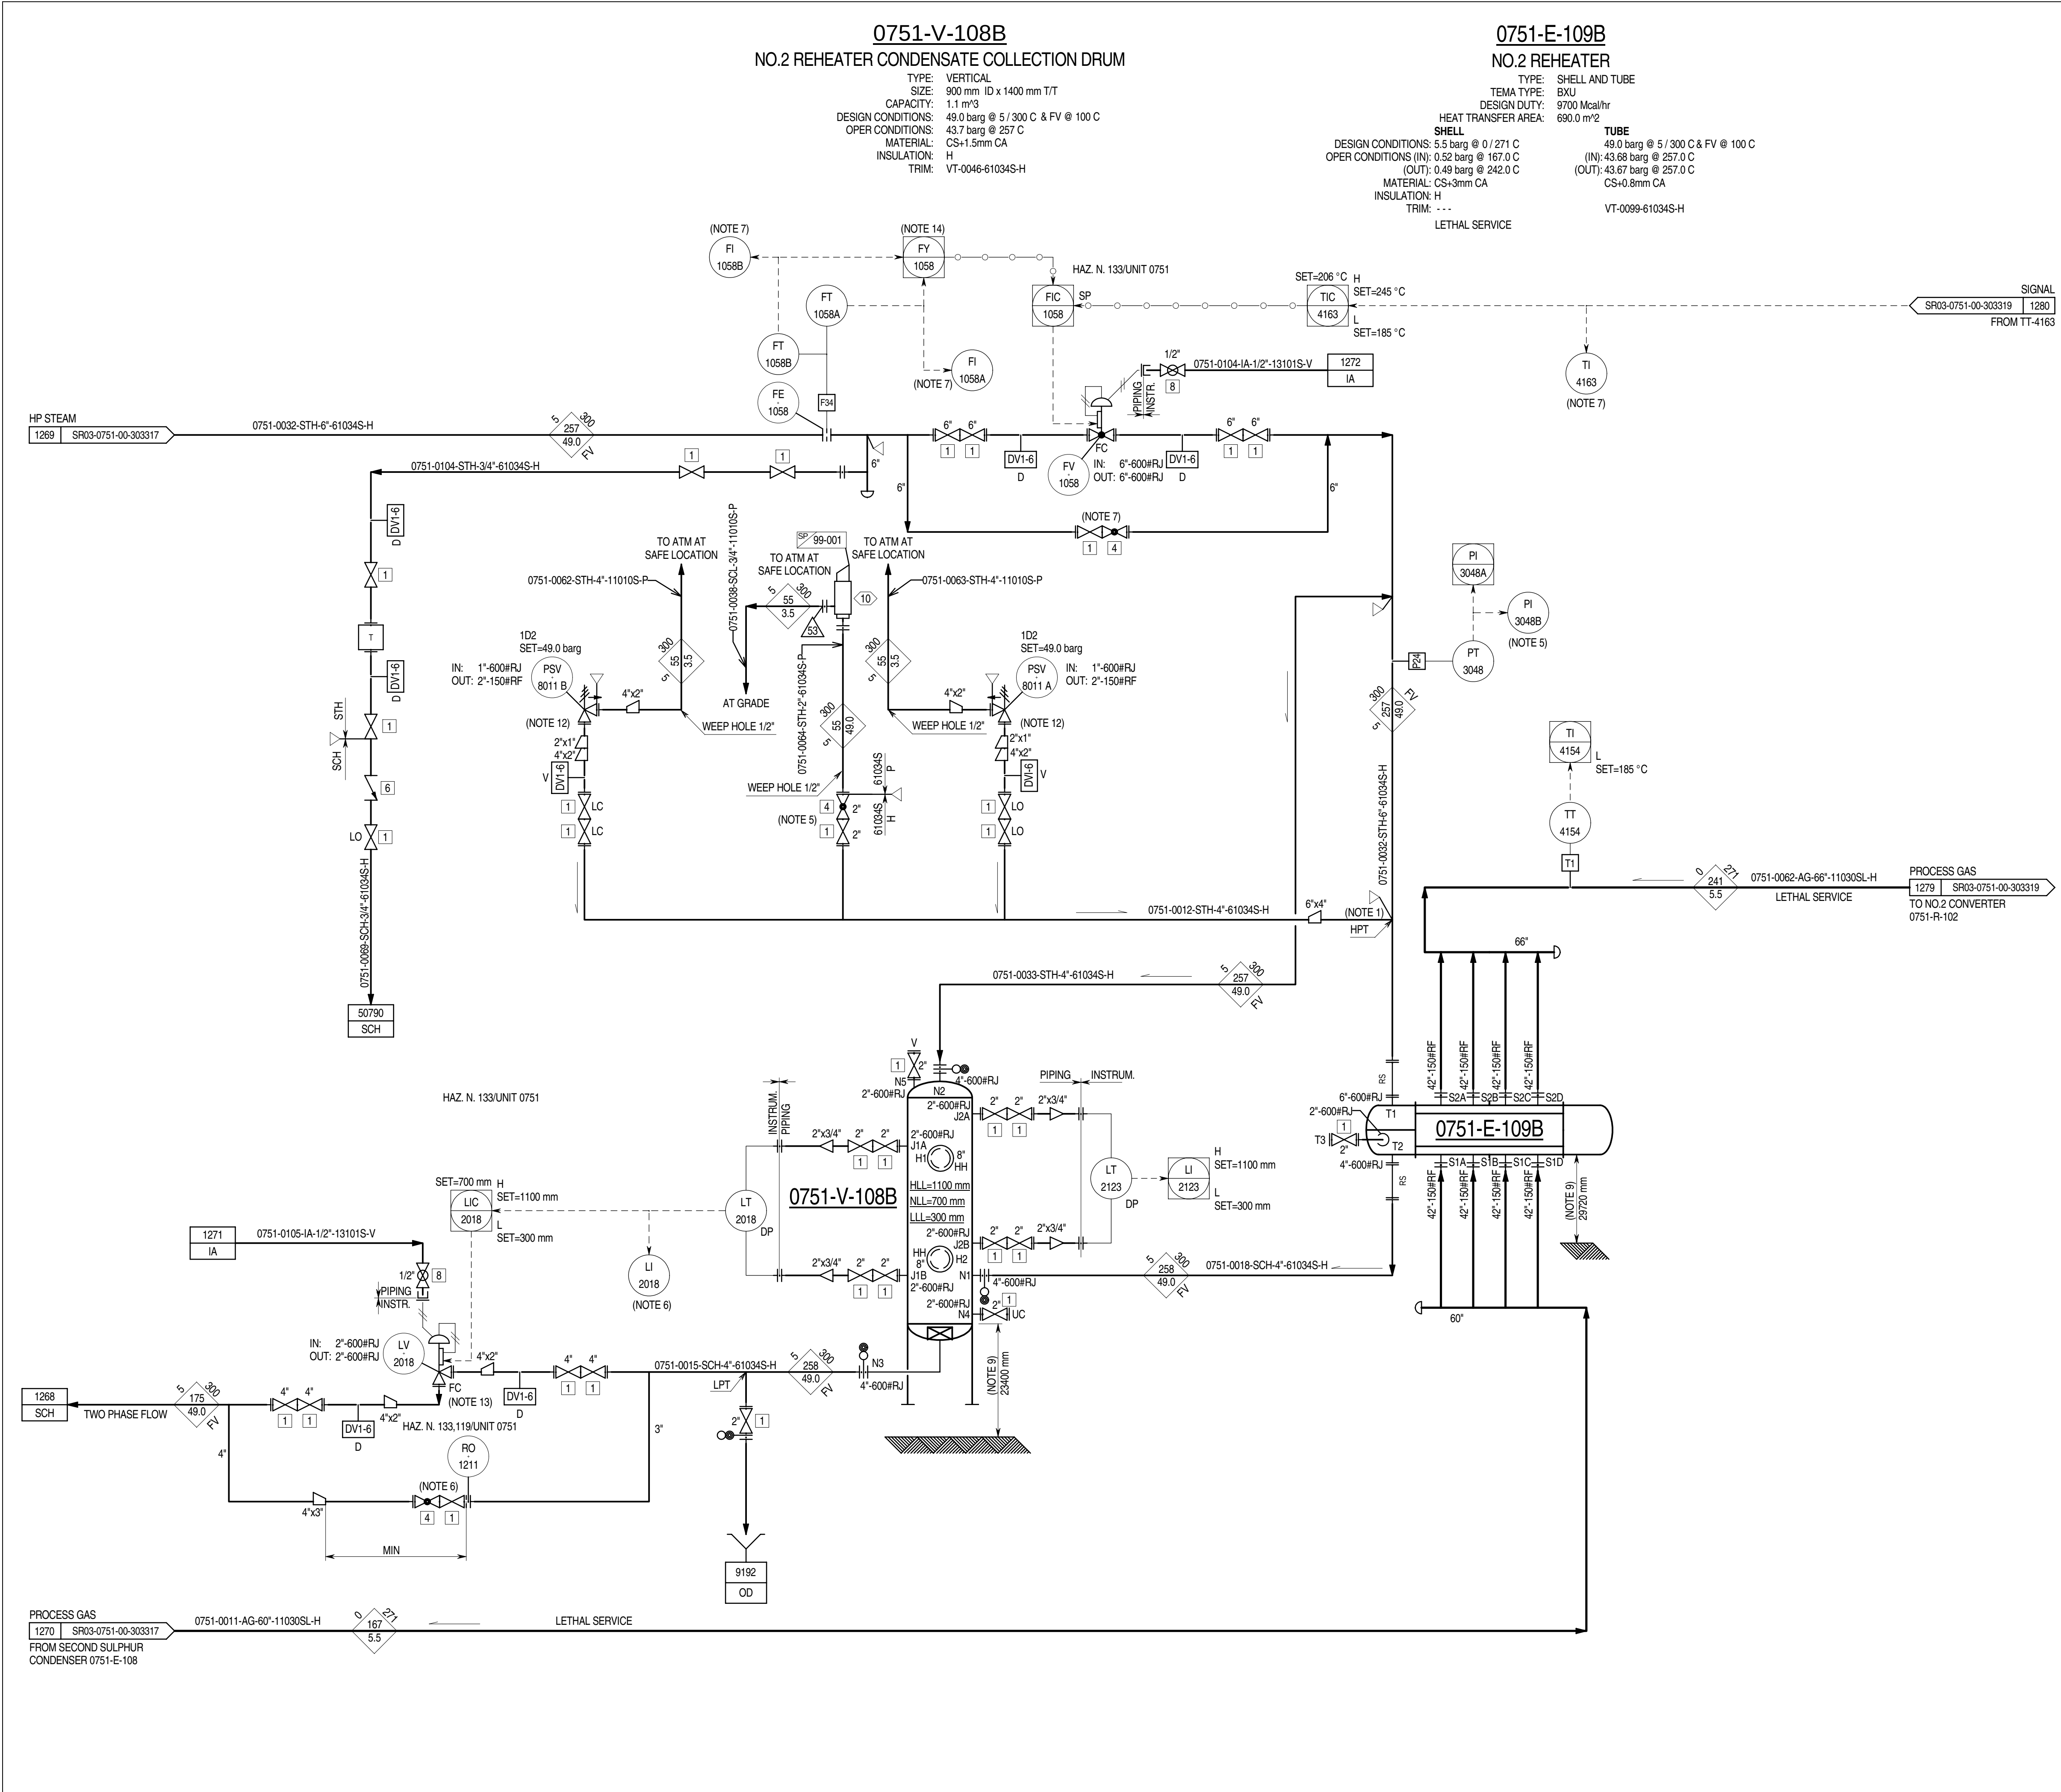

- GENERAL NOTES:**
- FOR STANDARD SYMBOLS, DETAILS, ABBREVIATIONS, SAMPLE CONNECTION TYPE, GENERAL NOTES & LEGEND SHEETS REFER TO DRAWING NO. MP02-0230-00-004000 TO 004015.
 - ALL INSTRUMENT TAG NUMBERS ON THIS P&ID INCLUDING PACKAGE UNITS ARE PREFIXED WITH UNIT NUMBER 0751 UNLESS OTHERWISE NOTED.
 - DELETED.
- NOTES:**
- LOCATE PSV VENT CONNECTION AT HIGH POINT OF STEAM LINE FROM TOP OF PIPE.
 - DELETED.
 - DELETED.
 - DELETED.
 - PI-3048B TO BE READABLE FROM PSV-8011A/B MANUAL VENT VALVE.
 - LI-2018 TO BE READABLE FROM LV-2018 BY-PASS VALVE.
 - FI-1058A, FI-1058B AND TI-4163 TO BE READABLE FROM FV-1058 BY-PASS VALVE.
 - DELETED.
 - 0751-E-109B BOTTOM TANGENT LINE TO BE LOCATED 900mm MIN ABOVE 0751-V-108B HIGH LIQUID LEVEL.
 - DELETED.
 - DELETED.
 - PVS SIZING CASE: FIRE
 - VALVE TO BE PROVIDED WITH LOCAL SIGN: "WARNING: TRIM AFFECTS RELIEF VALVE CAPACITY".
 - No. 2 TRANSMITTERS SHALL BE PROVIDED TO COVER THE COMPLETE REQUEST INSTRUMENT RANGEABILITY:
TRANSMITTER 'A' --> LOW RANGE
TRANSMITTER 'B' --> HIGH RANGE

UTILITY REFERENCE TABLE		
IA	DRW. N°.	SR03-0751-00-PID-362305
OD	DRW. N°.	SR03-0751-00-PID-362307
SCH	DRW. N°.	SR03-0751-00-PID-362312

Z1	04-11-14	IAB	ISSUED FOR AS BUILT	PCA	MAR	ASP
2.1D	18-04-14	IFC	ISSUED FOR CONSTRUCTION	PCA	MAR	ASP
2.1C	10-03-13	IFC	ISSUED FOR CONSTRUCTION	RL	CN	MZ
2.1B	06-08-12	IFC	ISSUED FOR CONSTRUCTION	DSC	CBR	SIN
2	02-12-11	IFC	ISSUED FOR CONSTRUCTION	DSC	CBR	SIN
1	28-07-11	IFCH	ISSUED FOR CONSTRUCTION WITH HOLDS	DSC	CBR	SIN
0	15-02-11	IFD	ISSUED CLIENT COMMENTS INCORPORATED	BSC	LMA	SIN
B1	30-09-10	ICR	ISSUED FOR CLIENT REVIEW	BSC	LMA	SIN
REV	DATE	STATUS	STATUS DESCRIPTION	BY	CKD	APP.

COMPANY:

Abu Dhabi Gas Development Co. Ltd.

CONTRACTOR:

JOB No. 032090

PROJECT: SHAH GAS DEVELOPMENT (SGD) PROJECT


AGREEMENT No. 13525001

DRAWING TITLE: PIPING & INSTRUMENT DIAGRAM UNIT 0751
SULPHUR RECOVERY AND TAIL GAS TREATING UNIT

EQUIPMENT DESCRIPTION	NO.2 REHEATER B
TAGITEM No.	0751-V-108B 0751-E-109B

CONTRACTOR DRG.No.	751-GD-B-303318	REV. Z1
COMPANY DRG.No.	SR03-0751-00-303318	
SCALE:	SIZE: A1 DOC. CLASS: 1	

THIS DOCUMENT IS THE PROPERTY OF ABU DHABI GAS DEVELOPMENT COMPANY LIMITED AND CONTAINS INFORMATION WHICH IS PROPRIETARY. THIS INFORMATION IS TO BE HELD IN CONFIDENCE. NO DISCLOSURE OR OTHER USE OF THIS DOCUMENT IS TO BE MADE WITHOUT THE PRIOR WRITTEN CONSENT OF ABU DHABI GAS DEVELOPMENT COMPANY LIMITED.

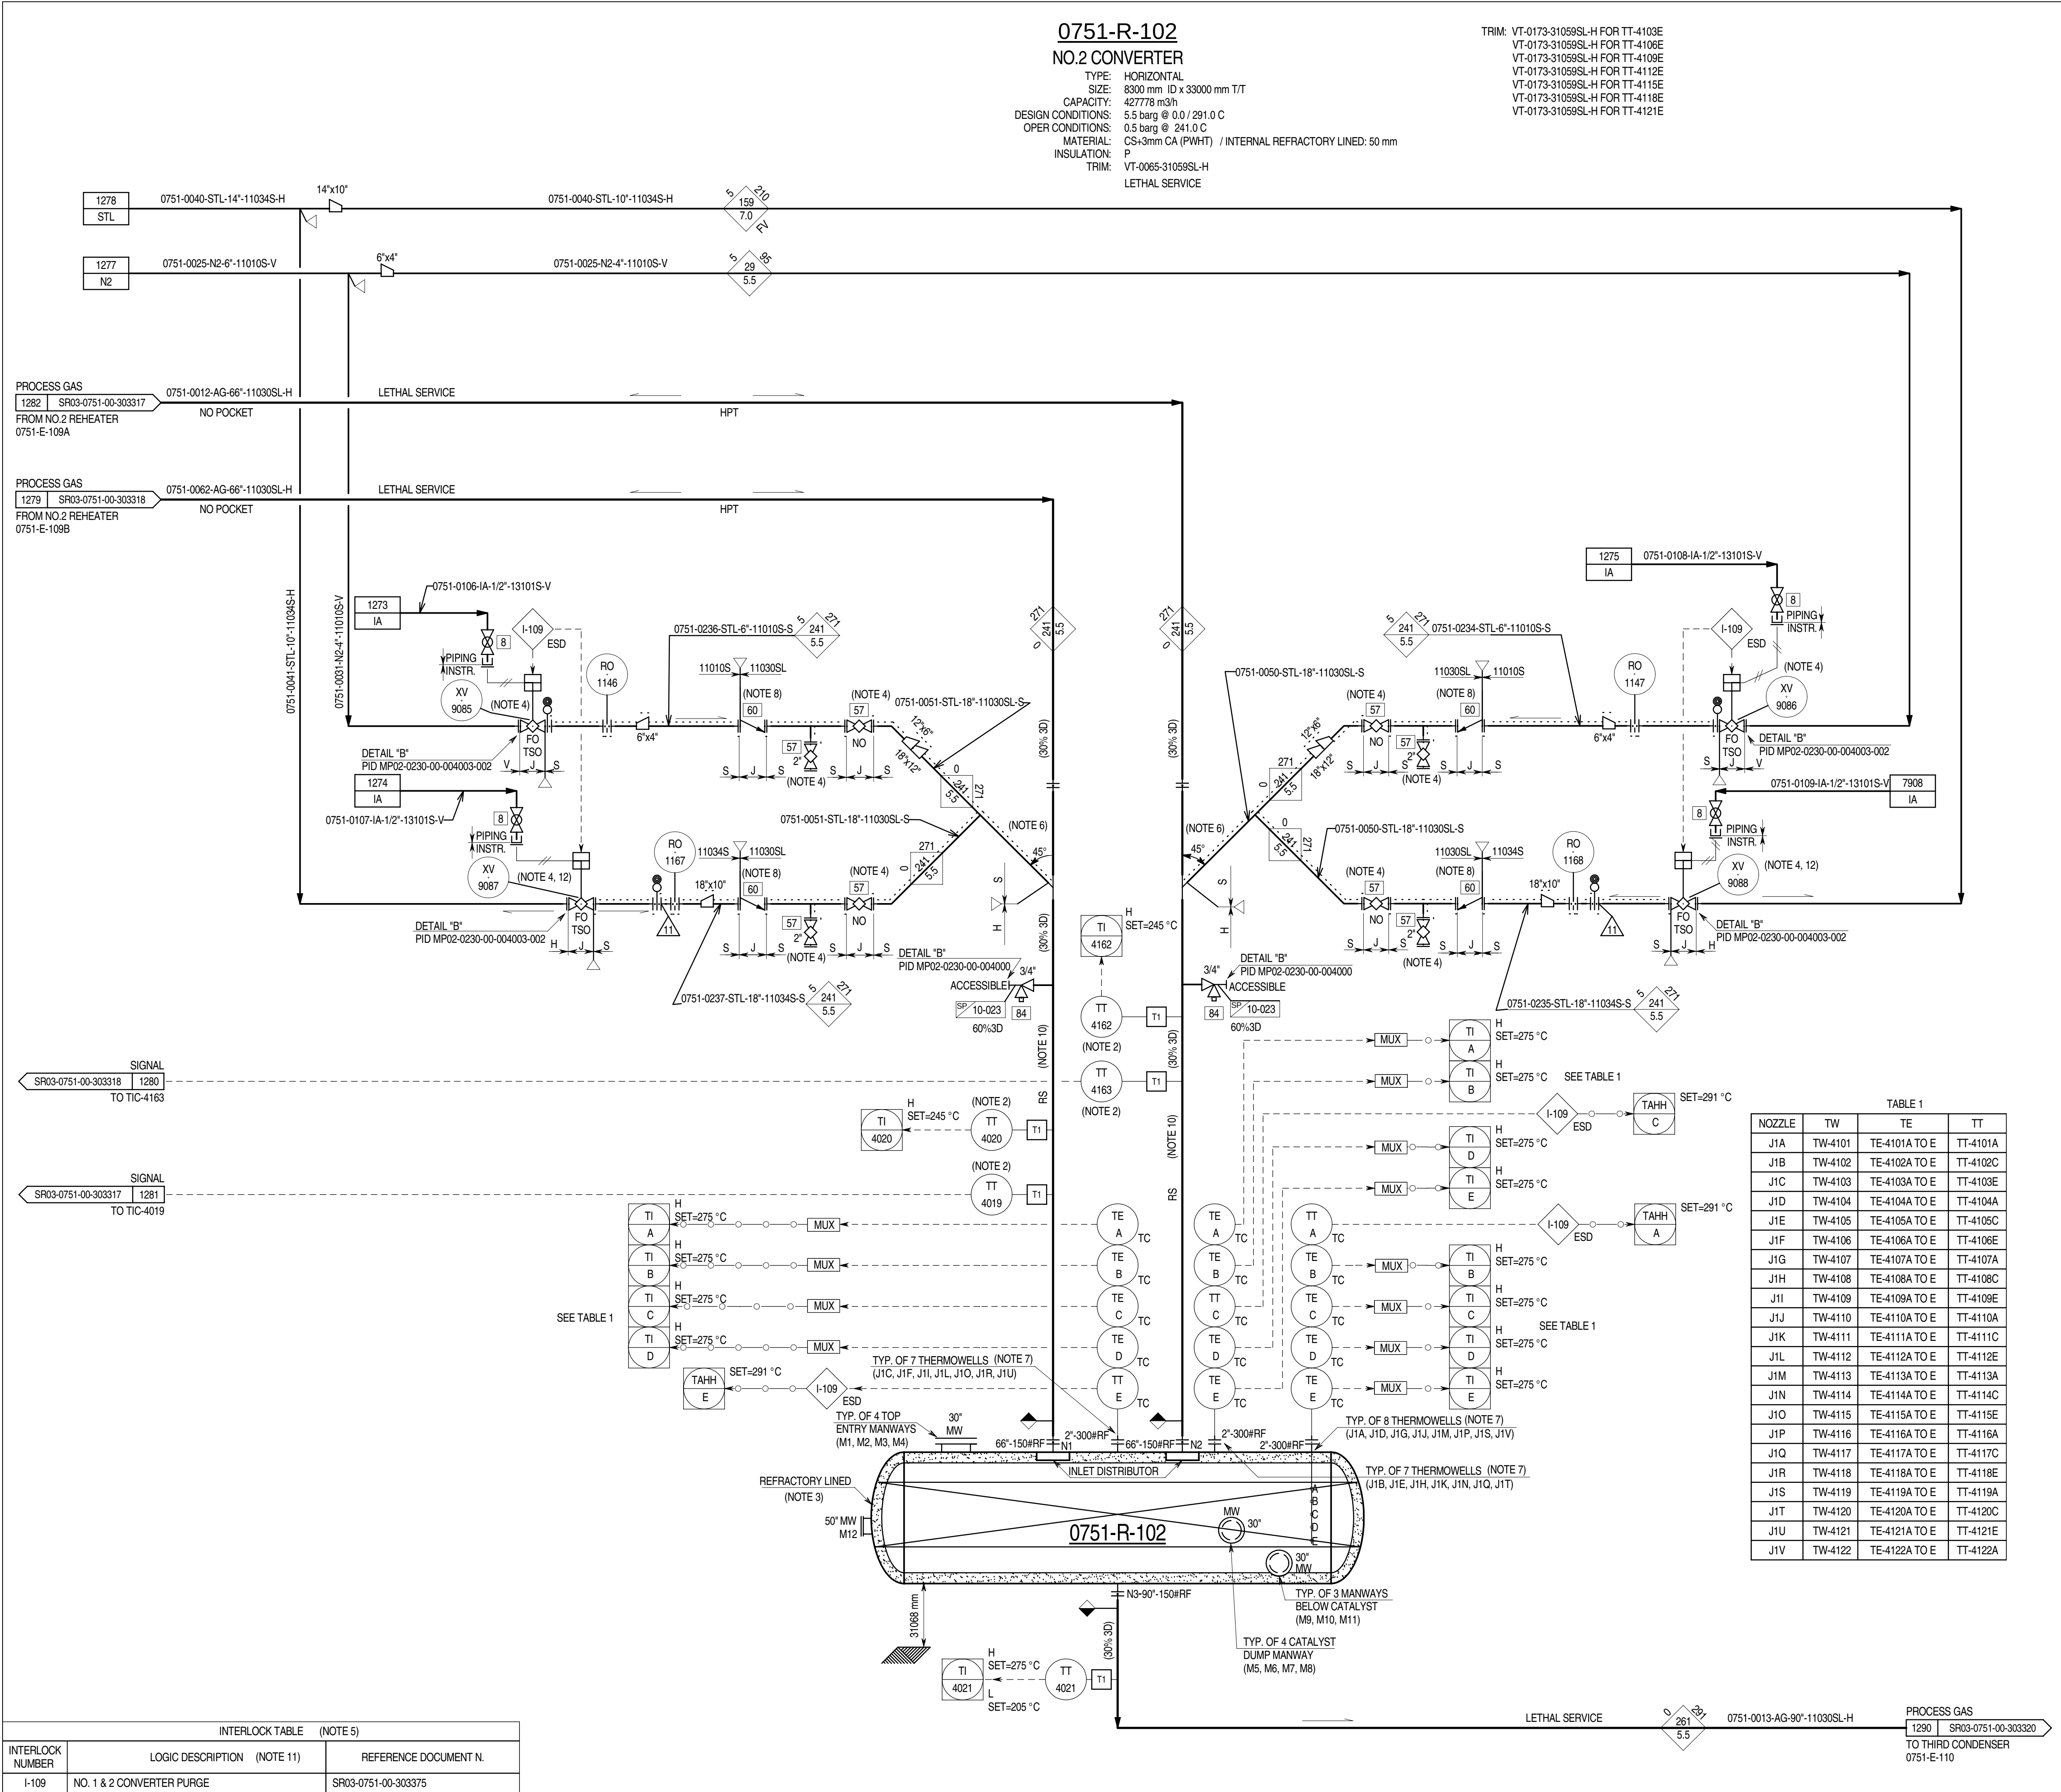

- GENERAL NOTES:**
- FOR STANDARD SYMBOLS, DETAILS, ABBREVIATIONS, SAMPLE CONNECTION TYPE, GENERAL NOTES & LEGEND SHEETS REFER TO DRAWING NO. MP02-0230-00-004000 TO 004015.
 - ALL INSTRUMENT TAG NUMBERS ON THIS P&ID INCLUDING PACKAGE UNITS ARE PREFIXED WITH UNIT NUMBER 0751 UNLESS OTHERWISE NOTED.
 - DELETED.
- DELETED.
 - LOCATE TT-4019/4020/4162/4163 AS CLOSE AS POSSIBLE TO No.2 CONVERTER.
 - SEE DATA SHEET FOR REFRACTORY LINING DETAIL.
 - STEAM JACKETED PLUG VALVE.
 - INTERLOCK TABLE IS FOR REFERENCE ONLY. CAUSE AND EFFECT MATRIX SR03-0751-00-CCC-303155 SHALL GOVERN.
 - NITROGEN STEAM PURGE CONNECTION AT 45° TO VERTICAL.
 - THE CONVERTER IS EQUIPPED WITH 22 VERTICAL THERMOWELLS AND 5 THERMOCOUPLES (A, B, C, D, E) PER THERMOWELL AT DIFFERENT BED HEIGHTS. A HIGH-HIGH TEMPERATURE TRIP IS PROVIDED ON ONE THERMOWELL PER THERMOWELL WITH AN ALTERNATE CONFIGURATION (A, C, E). SO 22 TAIH ARE ARRANGED ON ALL LAYERS OF THE CONVERTER. A 5oo22 VOTING ESD LOGIC OPENS THE VALVES XV-9085/9086/9087/9088 ON NITROGEN AND STEAM LINES. ALL REMAINING THERMOCOUPLES ARE PROVIDED WITH DCS INDICATION AND HIGH TEMPERATURE ALARM.
 - STEAM JACKETED CHECK VALVE TILTING DISK TYPE.
 - DELETED.
 - REMOVABLE SPOOL TO BE PROVIDED FROM FLANGE TO N1/N2 NOZZLES ON 0751-R-102.
 - REFER TO CAUSE AND EFFECT CHART FOR FULL REPRESENTATION OF INTERLOCK INITIATORS AND ACTIONS.
 - VALVE INSTALLED AT HIGH POINT.

Z1	04-11-14	IAB	ISSUED FOR AS BUILT	PCA	MAR	ASP
2.1D	18-04-14	IFC	ISSUED FOR CONSTRUCTION	PCA	MAR	ASP
2.1C	31-10-12	IFC	ISSUED FOR CONSTRUCTION	RL	MF	MZ
2.1B	06-08-12	IFC	ISSUED FOR CONSTRUCTION	DSC	CBR	SIN
2	02-12-11	IFC	ISSUED FOR CONSTRUCTION	DSC	CBR	SIN
1	28-07-11	IFCH	ISSUED FOR CONSTRUCTION WITH HOLDS	DSC	CBR	SIN
0	15-02-11	IFD	ISSUED CLIENT COMMENTS INCORPORATED	BSC	LMA	SIN
B1	30-09-10	ICR	ISSUED FOR CLIENT REVIEW	BSC	LMA	SIN
REV	DATE	STATUS	STATUS DESCRIPTION	BY	CKD	APP.

COMPANY:

Abu Dhabi Gas Development Co. Ltd.

CONTRACTOR:

PROJECT:

SHAH GAS DEVELOPMENT (SGD) PROJECT

AGREEMENT No. 13525001

DRAWING TITLE: PIPING & INSTRUMENT DIAGRAM UNIT 0751 SULPHUR RECOVERY AND TAIL GAS TREATING UNIT


EQUIPMENT DESCRIPTION	NO.2 CONVERTER
TAGITEM No.	0751-R-102

CONTRACTOR DRG. No.	751-GD-B-303319	REV. Z1
COMPANY DRG. No.	SR03-0751-00-303319	
SCALE:	SIZE: A1 DOC. CLASS: 1	

THIS DOCUMENT IS THE PROPERTY OF ABU DHABI GAS DEVELOPMENT COMPANY LIMITED AND CONTAINS INFORMATION WHICH IS PROPRIETARY. THIS INFORMATION IS TO BE HELD IN CONFIDENCE. NO DISCLOSURE OR OTHER USE OF THIS DOCUMENT IS TO BE MADE WITHOUT THE PRIOR WRITTEN CONSENT OF ABU DHABI GAS DEVELOPMENT COMPANY LIMITED.

0751-E-110 THIRD CONDENSER

TYPE: FIXED TUBESHEET SPECIAL
TEMA TYPE:
DESIGN DUTY: 13200 Mcal/hr
HEAT TRANSFER AREA: 6625.2 m²
SHELL
DESIGN CONDITIONS: 7.0 barg @ 5/210 C & FV @ 100 C
OPER CONDITIONS (IN): 1.00 barg @ 121.0 C
(OUT): 1.00 barg @ 121.0 C
MATERIAL: CS-3mm CA (PWHT)
INSULATION: H
TRIM: VT-0014-31034S-H
TUBE
5.5 barg @ 0/343 C (METAL)
(IN): 0.43 barg @ 226.0 C
(OUT): 0.40 barg @ 132.0 C
CS+0.8mm CA (PWHT)

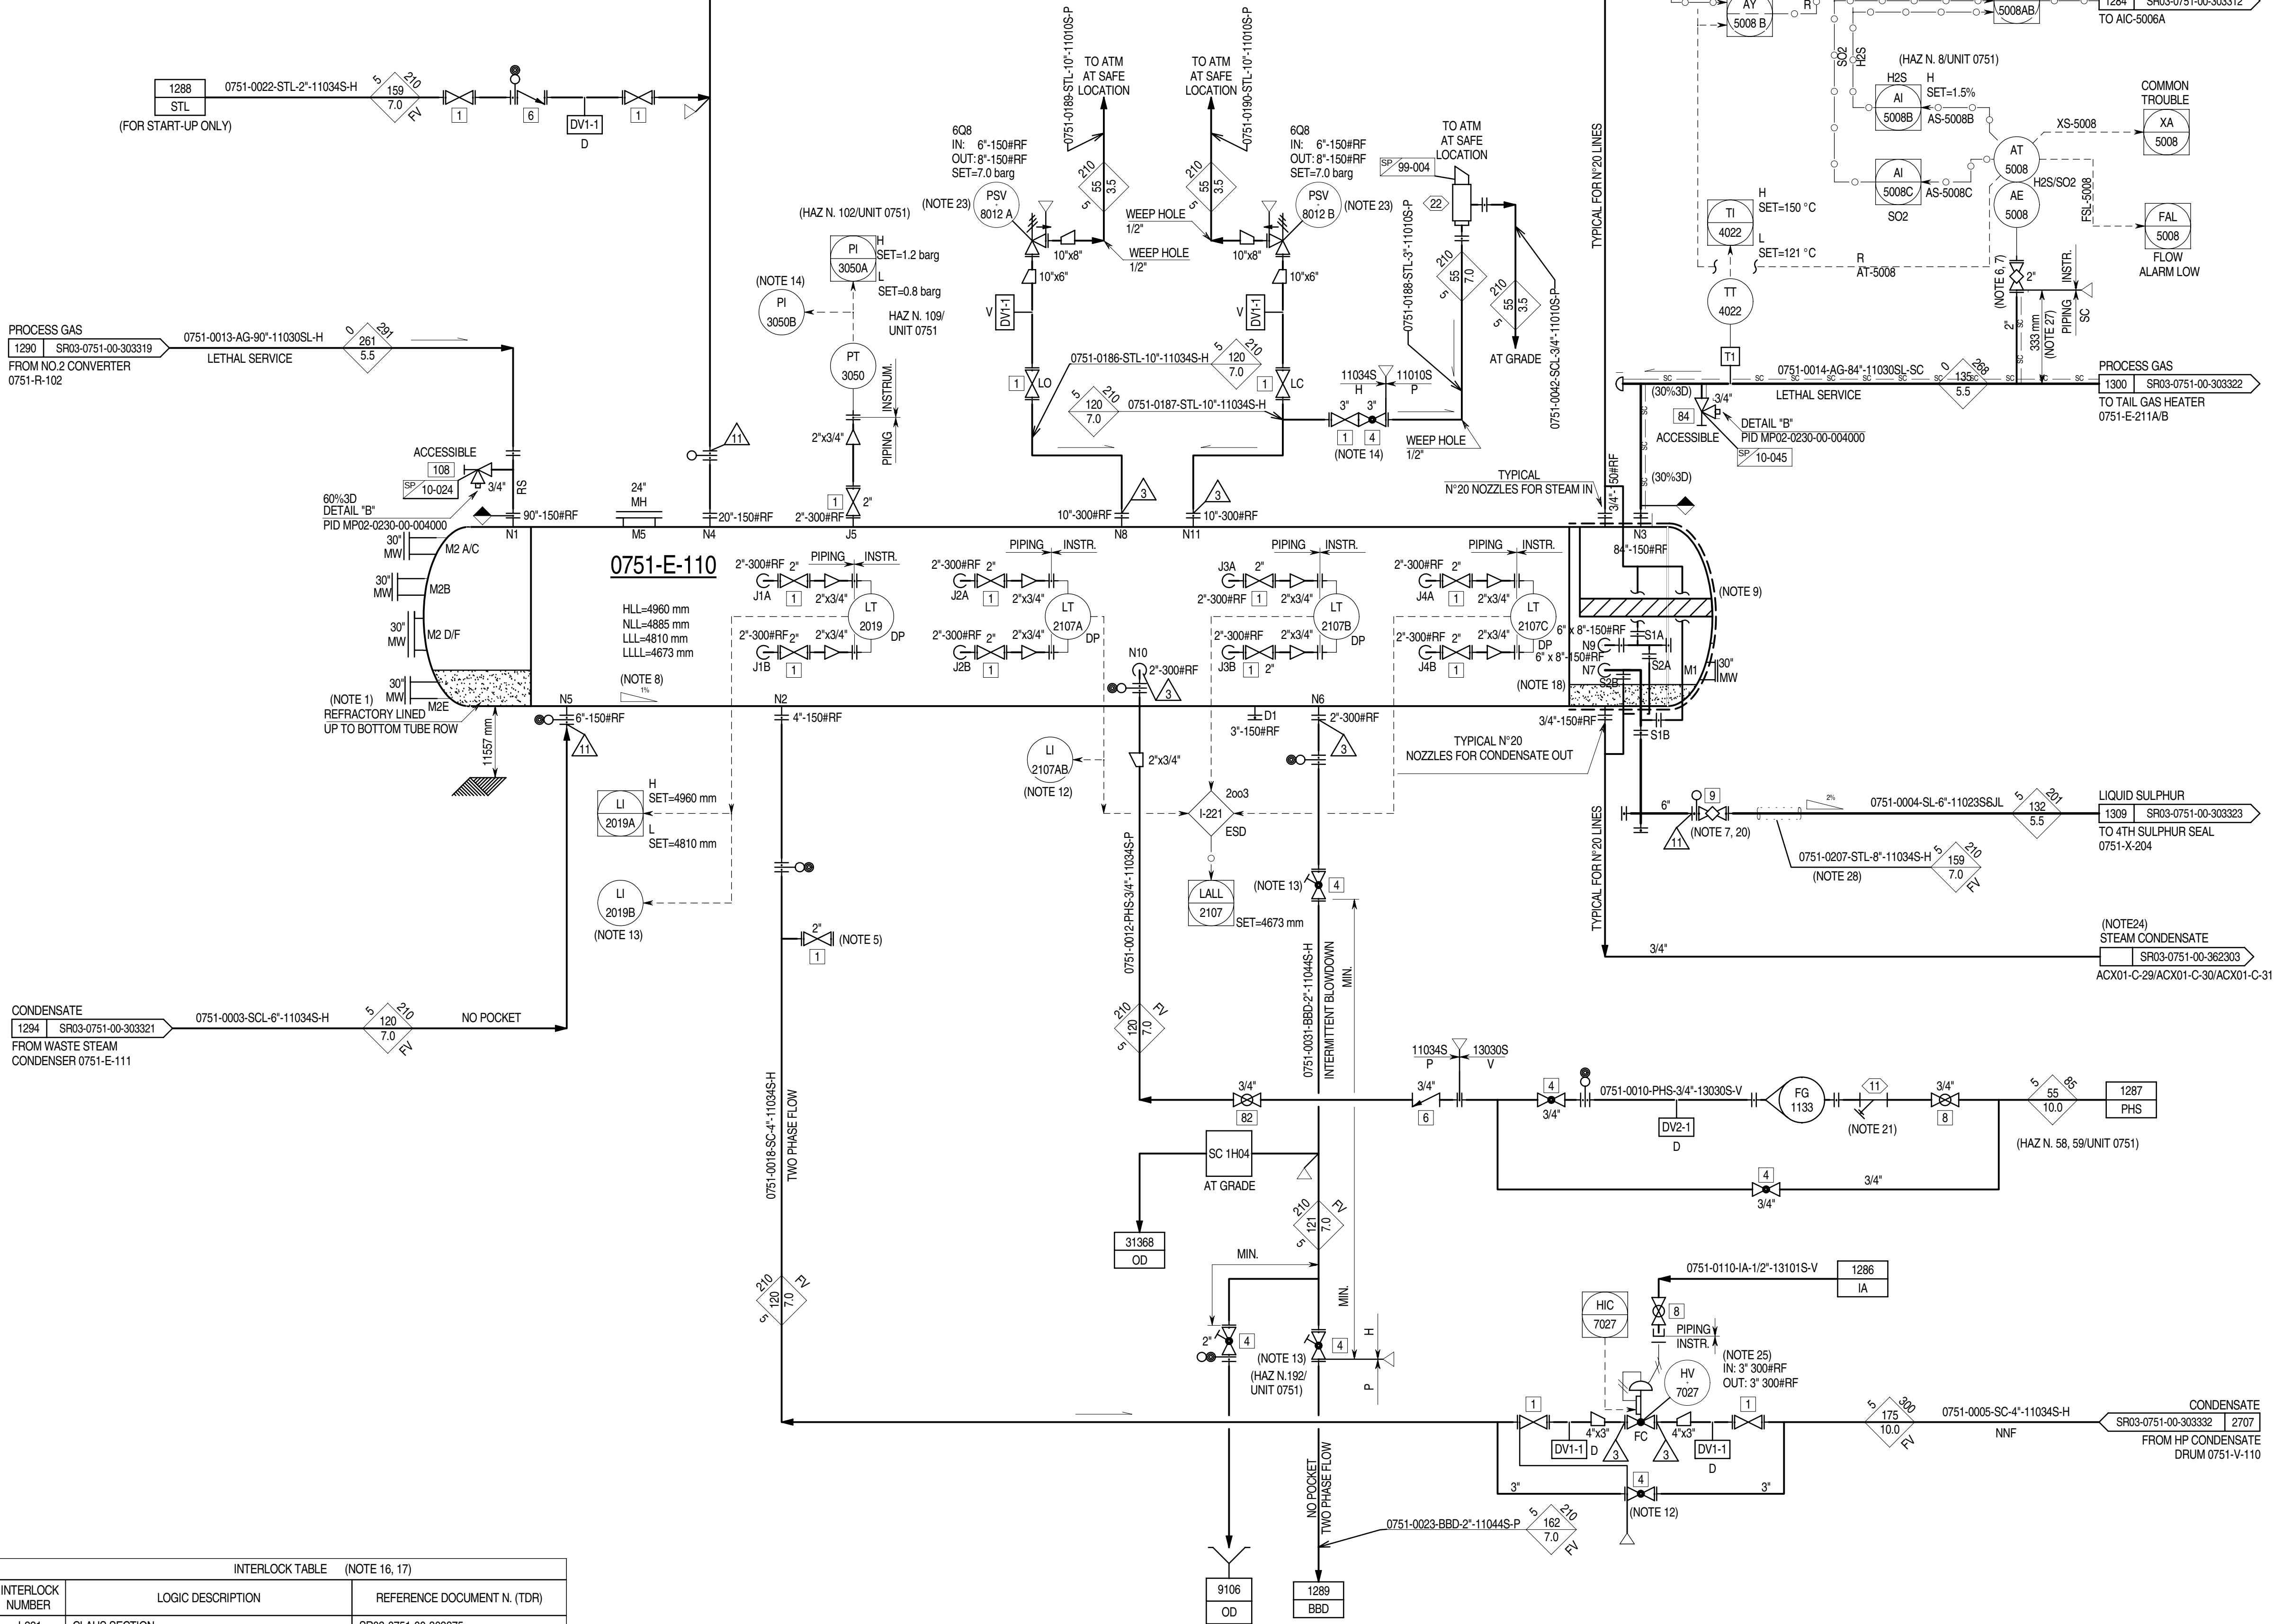

- GENERAL NOTES:**
- FOR STANDARD SYMBOLS, DETAILS, ABBREVIATIONS, SAMPLE CONNECTION TYPE, GENERAL NOTES & LEGEND SHEETS REFER TO DRAWING NO. MP02-0230-00-004000 TO 004015.
 - ALL INSTRUMENT TAG NUMBERS ON THIS P&ID INCLUDING PACKAGE UNITS ARE PREFIXED WITH UNIT NUMBER 0751 UNLESS OTHERWISE NOTED.
 - DELETED.
- NOTES:**
- SEE DATA SHEET FOR REFRACTORY LINING DETAILS.
 - DELETED.
 - DELETED.
 - DELETED.
 - ACID WASH CONNECTION.
 - TAIL GAS ANALYSER MOUNTING DETAILS WILL BE SPECIFIED BY VENDOR. THAT SHOWN IS FOR ILLUSTRATION ONLY.
 - STEAM JACKETED PLUG VALVE.
 - THIRD CONDENSER TO HAVE 1% SLOPE TOWARDS SULPHUR OUTLET END.
 - OUTLET CHANNEL IS STEAM-TRACED.
 - DELETED. (HAZ N. 77/UNIT 0751)
 - DELETED.
 - LI-2107AB TO BE READABLE FROM HV-7027 BYPASS VALVE.
 - LI-2019B TO BE READABLE FROM BLOW DOWN MANUAL VALVE.
 - PI-3050B TO BE READABLE FROM MANUAL VENT VALVE OF PSV-8012A/B.
 - DELETED.
 - INTERLOCK TABLE IS FOR REFERENCE ONLY. CAUSE AND EFFECT MATRIX SR03-0751-CCC-303155 SHALL GOVERN.
 - REFER TO CAUSE AND EFFECT CHART FOR FULL REPRESENTATION OF INTERLOCK INITIATOR AND ACTIONS.
 - THE N7/N8 NOZZLES ARE HORIZONTAL AND ARE LOCATED TANGENTIAL TO THE BOTTOM OF THE OUTLET CHANNEL. NOZZLES CENTER LINES ARE CO-LINEAR. THE N7/N8 NOZZLES ARE STEAM JACKETED.
 - DELETED.
 - FOR SULPHUR JACKETED LINES PROVIDE FLANGED BREAKS AT STANDARD PIPE LENGTHS. FOR CHANGE IN DIRECTION PROVIDE FLANGED CROSSES.
 - STRAINER WITH SCREEN 20 MESH.
 - SAMPLE ANALYSER CONNECTION TO BE SHORT AS POSSIBLE WITHOUT POCKETS AND TO BE KEPT HOT. (HAZ N. 73/UNIT 0751)
 - PSV-8012 SIZING CASE: BLOCKED DISCHARGE.
 - THERE ARE THREE STEAM CONDENSATE MANIFOLDS (ACX).
 - FOR DETAILS REFER TO DRAWING NO. SR03-0751-00-362303-002/003 AND TO STEAM TRACING LAYOUT DOC. N° 0751-13-GAS-362333.
 - LOCATE HV-7027 AT GRADE AT MINIMUM DISTANCE FROM 0751-E-110.
 - THERE ARE THREE STEAM SUPPLY MANIFOLDS (PVX).
 - FOR DETAILS REFER TO DRAWING NO. SR03-0751-00-362312-003 AND TO STEAM TRACING LAYOUT DOC. N° 0751-13-GAS-362333.
 - FROM PIPE OD.
 - FOR STEAM SUPPLY AND CONDENSATE RETURN REFER TO TABLE "A" AND "B" ON P&ID SR03-0751-00-362312-005.

UTILITY REFERENCE TABLE			
BBD/SCL	DRW. N°:	SR03-0751-00-PID-362303	
IA	DRW. N°:	SR03-0751-00-PID-362305	
OD	DRW. N°:	SR03-0751-00-PID-362307	
PHS	DRW. N°:	SR03-0751-00-PID-362308	
STL	DRW. N°:	SR03-0751-00-PID-362312	

Z1	04-11-14	IAB	ISSUED FOR AS BUILT	PCA	MAR	ASP
2.1D	18-04-14	IFC	ISSUED FOR CONSTRUCTION	PCA	MAR	ASP
2.1C	05-05-13	IFC	ISSUED FOR CONSTRUCTION	RL	MS	AS
2.1B	06-08-12	IFC	ISSUED FOR CONSTRUCTION	DSC	CBR	SIN
2	02-12-11	IFC	ISSUED FOR CONSTRUCTION	DSC	CBR	SIN
1	28-07-11	IFCH	ISSUED FOR CONSTRUCTION WITH HOLDS	DSC	CBR	SIN
0	15-02-11	IFD	ISSUED CLIENT COMMENTS INCORPORATED	BSC	LMA	SIN
B1	30-09-10	ICR	ISSUED FOR CLIENT REVIEW	BSC	LMA	SIN
REV	DATE	STATUS	STATUS DESCRIPTION	BY	CKD	APP.

COMPANY:

Abu Dhabi Gas Development Co. Ltd.

CONTRACTOR:

PROJECT: SHAH GAS DEVELOPMENT (SGD) PROJECT

AGREEMENT No. 13525001

DRAWING TITLE: PIPING & INSTRUMENT DIAGRAM UNIT 0751
SULPHUR RECOVERY AND TAIL GAS TREATING UNIT

EQUIPMENT DESCRIPTION	THIRD CONDENSER
TAGITEM No.	0751-E-110

CONTRACTOR DRG. No.	751-GD-B-303320	REV. Z1
COMPANY DRG. No.	SR03-0751-00-303320	
SCALE:	SIZE: A1	DOC. CLASS: 1

0751-E-111
(NOTE 2, 3, 12, 13)

Z1	04-11-14	IAB	ISSUED FOR AS BUILT	PCA	MAR	ASPH
2.1D	18-04-14	IFC	ISSUED FOR CONSTRUCTION	PCA	MAR	ASPH
2.1C	09-03-13	IFC	ISSUED FOR CONSTRUCTION	RL	CN	MZ
2.1B	06-08-12	IFC	ISSUED FOR CONSTRUCTION	DSC	CBR	SIN
2	02-12-11	IFC	ISSUED FOR CONSTRUCTION	DSC	CBR	SIN
1	28-07-11	IFCH	ISSUED FOR CONSTRUCTION WITH HOLDS	DSC	CBR	SIN
0	15-02-11	IFD	ISSUED CLIENT COMMENTS INCORPORATED	BSC	LMA	SIN
B1	30-09-10	ICR	ISSUED FOR CLIENT REVIEW	BSC	LMA	SIN
REV	DATE	STATUS	STATUS DESCRIPTION	BY	CKD	APP.

COMPANY:

Abu Dhabi Gas Development Co. Ltd.



CONTRACTOR:

 **saipem**


JOB No. 032090

PROJECT: SHAH GAS DEVELOPMENT (SGD) PROJECT

AGREEMENT No. 13525001

DRAWING TITLE: PIPING & INSTRUMENT DIAGRAM UNIT 0751 SULPHUR RECOVERY AND TAIL GAS TREATING UNIT			
EQUIPMENT DESCRIPTION		WASTE STEAM CONDENSER	
TAG/ITEM No.		0751-E-111	
CONTRACTOR DRG No.		751-GD-B-303321	REV. Z1
COMPANY DRG No.		SR03-0751-00-303321	
SCALE:	SIZE: A1	DOC. CLASS: 1	

THIS DOCUMENT IS THE PROPERTY OF ABU DHABI GAS DEVELOPMENT COMPANY LIMITED AND CONTAINS INFORMATION WHICH IS PROPRIETARY. THIS INFORMATION IS TO BE HELD IN CONFIDENCE. NO DISCLOSURE OR OTHER USE OF THIS DOCUMENT IS TO BE MADE WITHOUT THE PRIOR WRITTEN CONSENT OF ABU DHABI GAS DEVELOPMENT COMPANY LIMITED.

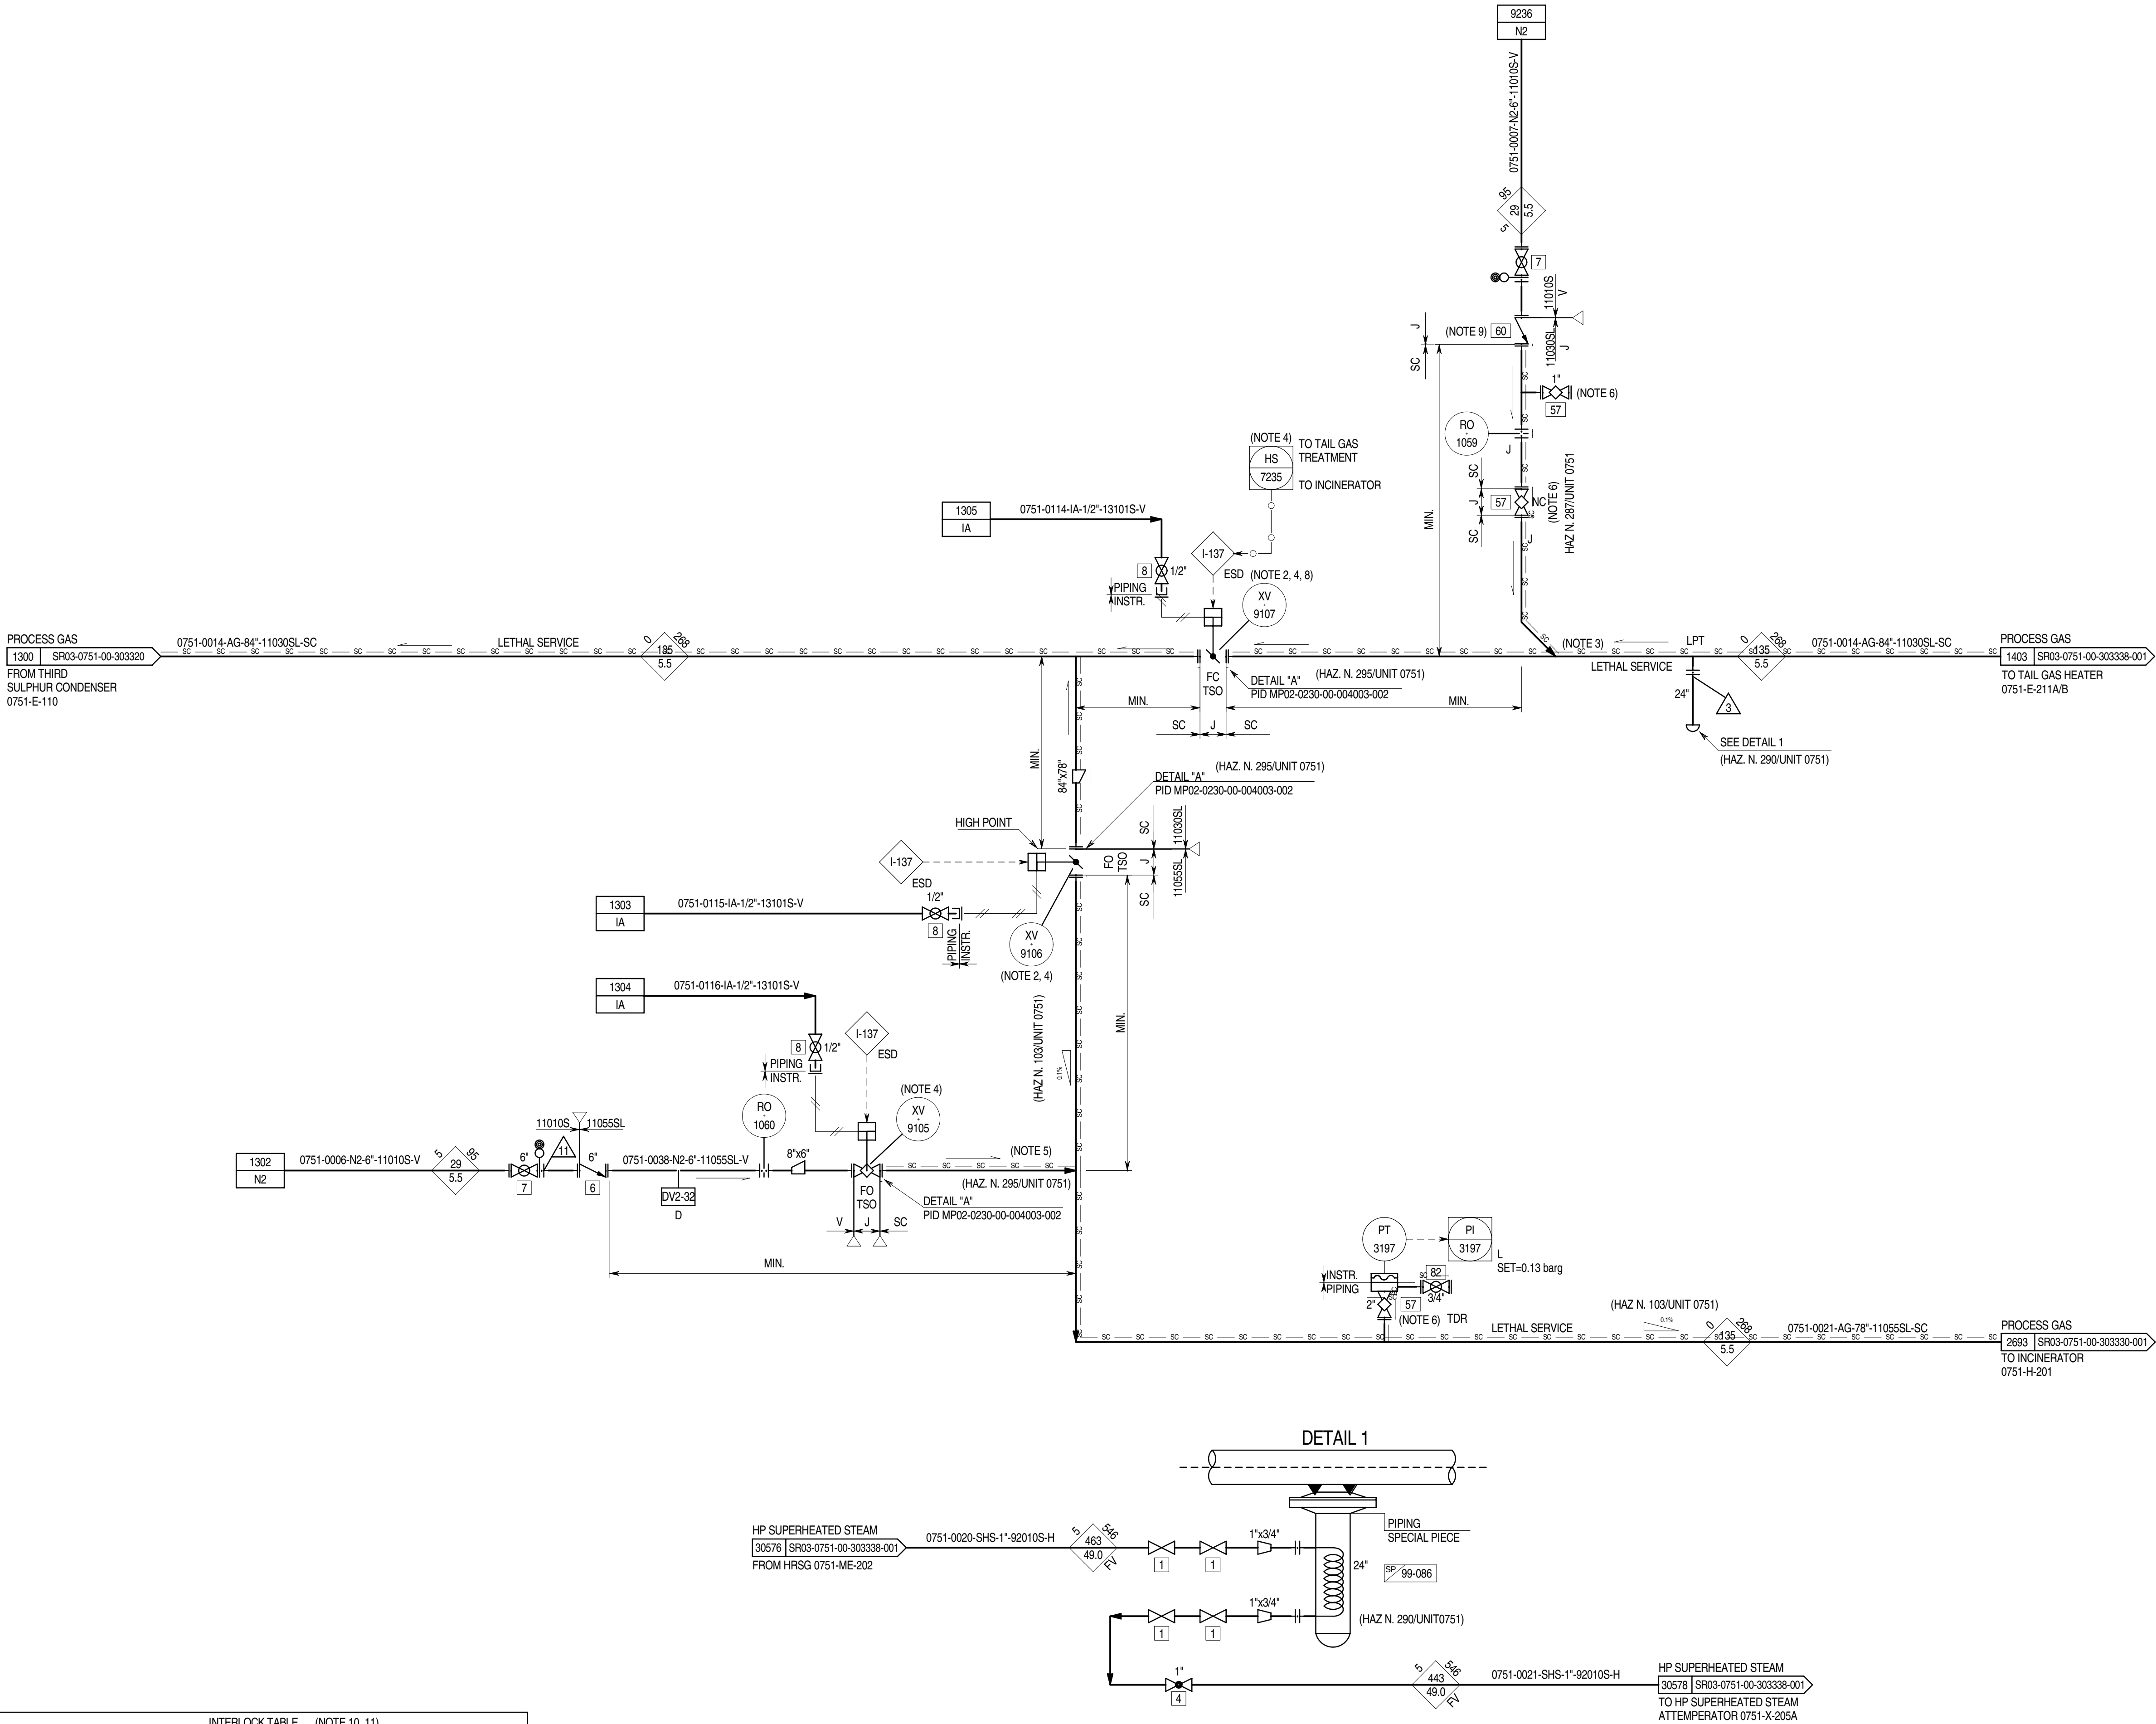

INTERLOCK TABLE (NOTE 10, 11)		
INTERLOCK NUMBER	LOGIC DESCRIPTION	REFERENCE DOCUMENT N.
I-137	TGTU BY-PASS	SR03-0751-00-303375

- GENERAL NOTES:**
- FOR STANDARD SYMBOLS, DETAILS, ABBREVIATIONS, SAMPLE CONNECTION TYPE, GENERAL NOTES & LEGEND SHEETS REFER TO DRAWING NO. MP02-0230-00-004000 TO 004015.
 - ALL INSTRUMENT TAG NUMBERS ON THIS P&ID INCLUDING PACKAGE UNITS ARE PREFIXED WITH UNIT NUMBER 0751 UNLESS OTHERWISE NOTED.
 - DELETED.
-
- DELETED.
 - VALVE WITH HEATED SHAFT AND DISC STEAM JACKETED.
 - TIE-IN ON TOP OF PIPE AND INCLINED AT 45° TO THE DIRECTION OF FLOW.
 - OPERATING MODE CAN BE MANUALLY SET BY OPERATOR, THROUGH SELECTOR 0751-HS-7235, BETWEEN NORMAL OPERATION (TO TAIL GAS TREATMENT) OR BY-PASS MODE (TO INCINERATOR). WHEN TAIL GAS TREATING UNIT MODE IS SELECTED, IF THE VALVE 0751-MOV-7037 LOCATED ON THE TOP OF TGTU ADSORBER IS COMPLETELY OPEN, ESD LOGIC I-137:
 - OPENS THE MAIN VALVE 0751-XV-9107;
 - CLOSES THE FIRST BYPASS VALVE 0751-XV-9106;
 - OPENS THE PURGE NITROGEN VALVE 0751-XV-9105;
 - AFTER 15 MINUTES, AUTOMATICALLY CLOSES THE SECOND BY PASS VALVE 0751-XV-9116;
 - AFTER 2 MINUTES, AUTOMATICALLY CLOSES THE NITROGEN VALVE 0751-XV-9105 TO KEEP FILLED WITH NITROGEN THE SECTION BETWEEN THE TWO BYPASS VALVES 0751-XV-9105 AND 0751-XV-9116.WHEN BYPASS MODE IS SELECTED, LOGIC:
 - OPENS THE TWO BYPASS VALVES 0751-XV-9106 AND 0751-XV-9116;
 - CLOSES THE MAIN VALVE 0751-XV-9107.MANUAL OVERRIDE OF THE ABOVE REQUIREMENTS IS NOT PERMITTED. FOR MORE DETAILS REFER TO SAFEGUARDING NARRATIVE (DOC. N° SR03-0751-00-SPE-303159).
 - CONNECT TO TOP OF LINE.
 - STEAM JACKETED VALVE.
 - DELETED.
 - VALVE XV-9107 CAN BE OPENED ONLY IF THE VALVE 0751-MOV-7037 (ON DWG. SR03-0751-00-303344) IS FULLY OPEN.
 - STEAM JACKETED CHECK VALVE TILTING DISK TYPE.
 - INTERLOCK TABLE IS FOR REFERENCE ONLY. CAUSE AND EFFECT MATRIX SR03-0751-00-CC-30155 SHALL GOVERN.
 - REFER TO CAUSE AND EFFECT CHART FOR FULLY REPRESENTATION OF INTERLOCK INITIATORS AND ACTIONS.

UTILITY REFERENCE TABLE		
IA	DRW. N°.	SR03-0751-00-PID-362305
N2	DRW. N°.	SR03-0751-00-PID-362310

ZI	DATE	IAB	ISSUED FOR AS BUILT	PCA	MAR	ASP
2.1D	18-04-14	IFC	ISSUED FOR CONSTRUCTION	PCA	MAR	ASP
2.1C	05-05-13	IFC	ISSUED FOR CONSTRUCTION	RL	MS	AS
2.1B	06-08-12	IFC	ISSUED FOR CONSTRUCTION	DSC	CBR	SIN
2	02-12-11	IFC	ISSUED FOR CONSTRUCTION	DSC	CBR	SIN
1	28-07-11	IFCH	ISSUED FOR CONSTRUCTION WITH HOLDS	DSC	CBR	SIN
0	15-02-11	IFD	ISSUED CLIENT COMMENTS INCORPORATED	BSC	LMA	SIN
B1	30-09-10	ICR	ISSUED FOR CLIENT REVIEW	BSC	LMA	SIN
REV	DATE	STATUS	STATUS DESCRIPTION	BY	CKD	APP.

COMPANY:

Abu Dhabi Gas Development Co. Ltd.

CONTRACTOR:

JOB No. 032090

PROJECT: SHAH GAS DEVELOPMENT (SGD) PROJECT


AGREEMENT No. **13525001**

DRAWING TITLE: PIPING & INSTRUMENT DIAGRAM UNIT 0751 SULPHUR RECOVERY AND TAIL GAS TREATING UNIT

EQUIPMENT DESCRIPTION	TAIL GAS BY-PASS CONTROL
TAGITEM No.	

CONTRACTOR DRG.No.	751-GD-B-303322	REV. Z1
COMPANY DRG.No.	SR03-0751-00-303322	
SCALE:	SIZE: A1	DOC. CLASS: 1

THIS DOCUMENT IS THE PROPERTY OF ABU DHABI GAS DEVELOPMENT COMPANY LIMITED AND CONTAINS INFORMATION WHICH IS PROPRIETARY. THIS INFORMATION IS TO BE HELD IN CONFIDENCE. NO DISCLOSURE OR OTHER USE OF THIS DOCUMENT IS TO BE MADE WITHOUT THE PRIOR WRITTEN CONSENT OF ABU DHABI GAS DEVELOPMENT COMPANY LIMITED.

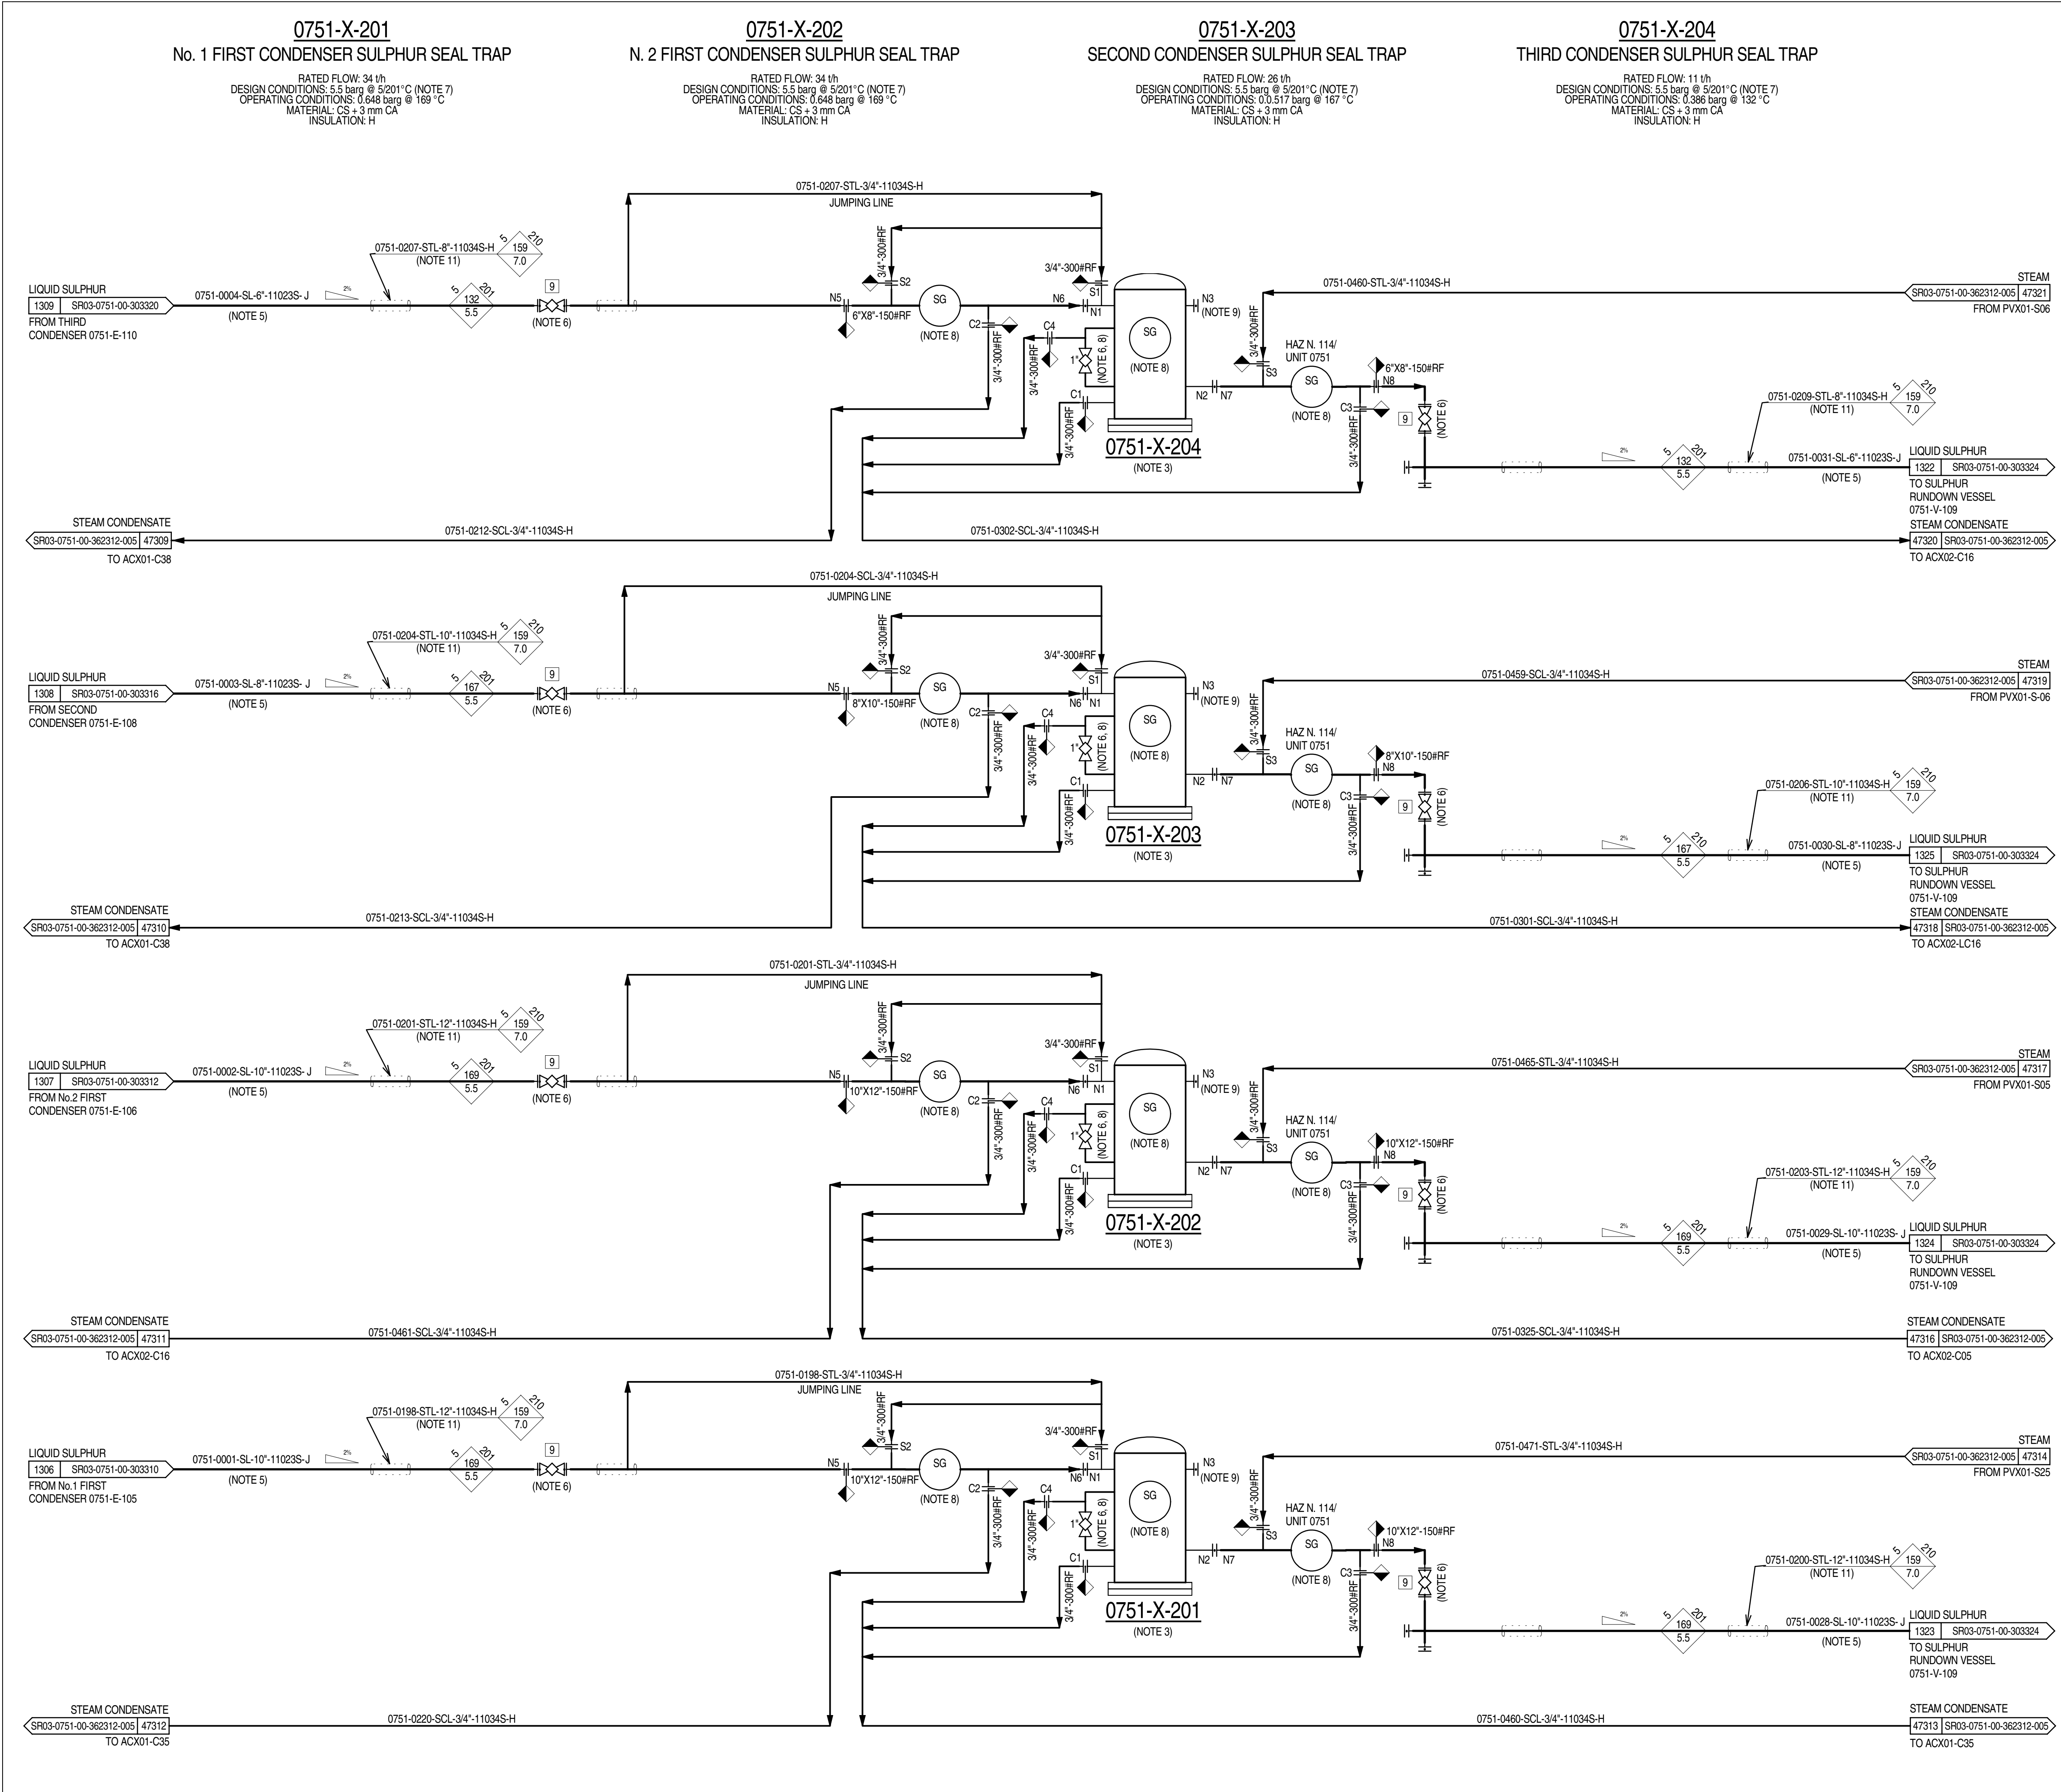

- GENERAL NOTES:**
- FOR STANDARD SYMBOLS, DETAILS, ABBREVIATIONS, SAMPLE CONNECTION TYPE, GENERAL NOTES & LEGEND SHEETS REFER TO DRAWING NO. MP02-0230-00-004000 TO 004015.
 - ALL INSTRUMENT TAG NUMBERS ON THIS P&ID INCLUDING PACKAGE UNITS ARE PREFIXED WITH UNIT NUMBER 0751 UNLESS OTHERWISE NOTED.
 - DELETED.
- NOTES:**
- DELETED.
 - DELETED.
 - STEAM JACKETED SULTRAP.
 - DELETED.
 - FOR SULPHUR JACKETED LINES PROVIDE FLANGED BREAKS AT STANDARD PIPE LENGTHS. FOR CHANGE IN DIRECTION PROVIDE FLANGED CROSSES.
 - STEAM JACKETED VALVE.
 - EXTERNAL JACKET DESIGN CONDITIONS: 7 barg @ 5/210°C AND FV @ 100°C.
 - INCLUDED IN VENDOR SCOPE OF SUPPLY.
 - ROD-OUT NOZZLE.
 - FOR DETAIL REFER TO DWG N°. SR03-0751-00-362303-003.
 - FOR STEAM SUPPLY AND CONDENSATE RETURN REFER TO TABLE 'A' AND 'B' ON P&ID SR03-0751-00-362312-005.
 - STEAM SUPPLY AND CONDENSATE RETURN MANIFOLDS ALSO USED FOR 0751-V-109 EXTERNAL BOLT ON STEAM JACKET PANELS (P&ID SR03-0751-00-030325-003).

UTILITY REFERENCE TABLE			
SCL	DRW. N°.	SR03-0751-00-PID-362303	
STL	DRW. N°.	SR03-0751-00-PID-362312	

Z1	04-11-14	IAB	ISSUED FOR AS BUILT	PCA	MAR	ASP
2.1D	18-04-14	IFC	ISSUED FOR CONSTRUCTION	PCA	MAR	ASP
2.1C	05-05-13	IFC	ISSUED FOR CONSTRUCTION	RL	MS	AS
2.1B	06-08-12	IFC	ISSUED FOR CONSTRUCTION	DSC	CBR	SIN
2	02-12-11	IFC	ISSUED FOR CONSTRUCTION	DSC	CBR	SIN
1	28-07-11	IFCH	ISSUED FOR CONSTRUCTION WITH HOLDS	DSC	CBR	SIN
0	15-02-11	IFD	ISSUED CLIENT COMMENTS INCORPORATED	BSC	LMA	SIN
B1	30-09-10	ICR	ISSUED FOR CLIENT REVIEW	BSC	LMA	SIN
REV	DATE	STATUS	STATUS DESCRIPTION	BY	CKD	APP.

COMPANY:

Abu Dhabi Gas Development Co. Ltd.

CONTRACTOR:

JOB No. 032090


PROJECT: **SHAH GAS DEVELOPMENT (SGD) PROJECT**

AGREEMENT No. **13525001**

DRAWING TITLE: PIPING & INSTRUMENT DIAGRAM UNIT 0751 SULPHUR RECOVERY AND TAIL GAS TREATING UNIT	
EQUIPMENT DESCRIPTION	SULPHUR SEALS
TAGITEM No.	0751-X-201 0751-X-202 0751-X-203 0751-X-204

CONTRACTOR DRG. No.	751-GD-B-303323	REV. Z1
COMPANY DRG. No.	SR03-0751-00-303323	
SCALE:	SIZE: A1 DOC. CLASS: 1	

THIS DOCUMENT IS THE PROPERTY OF ABU DHABI GAS DEVELOPMENT COMPANY LIMITED. NO DISCLOSURE OR OTHER USE OF THIS DOCUMENT IS TO BE MADE WITHOUT THE PRIOR WRITTEN CONSENT OF ABU DHABI GAS DEVELOPMENT COMPANY LIMITED.

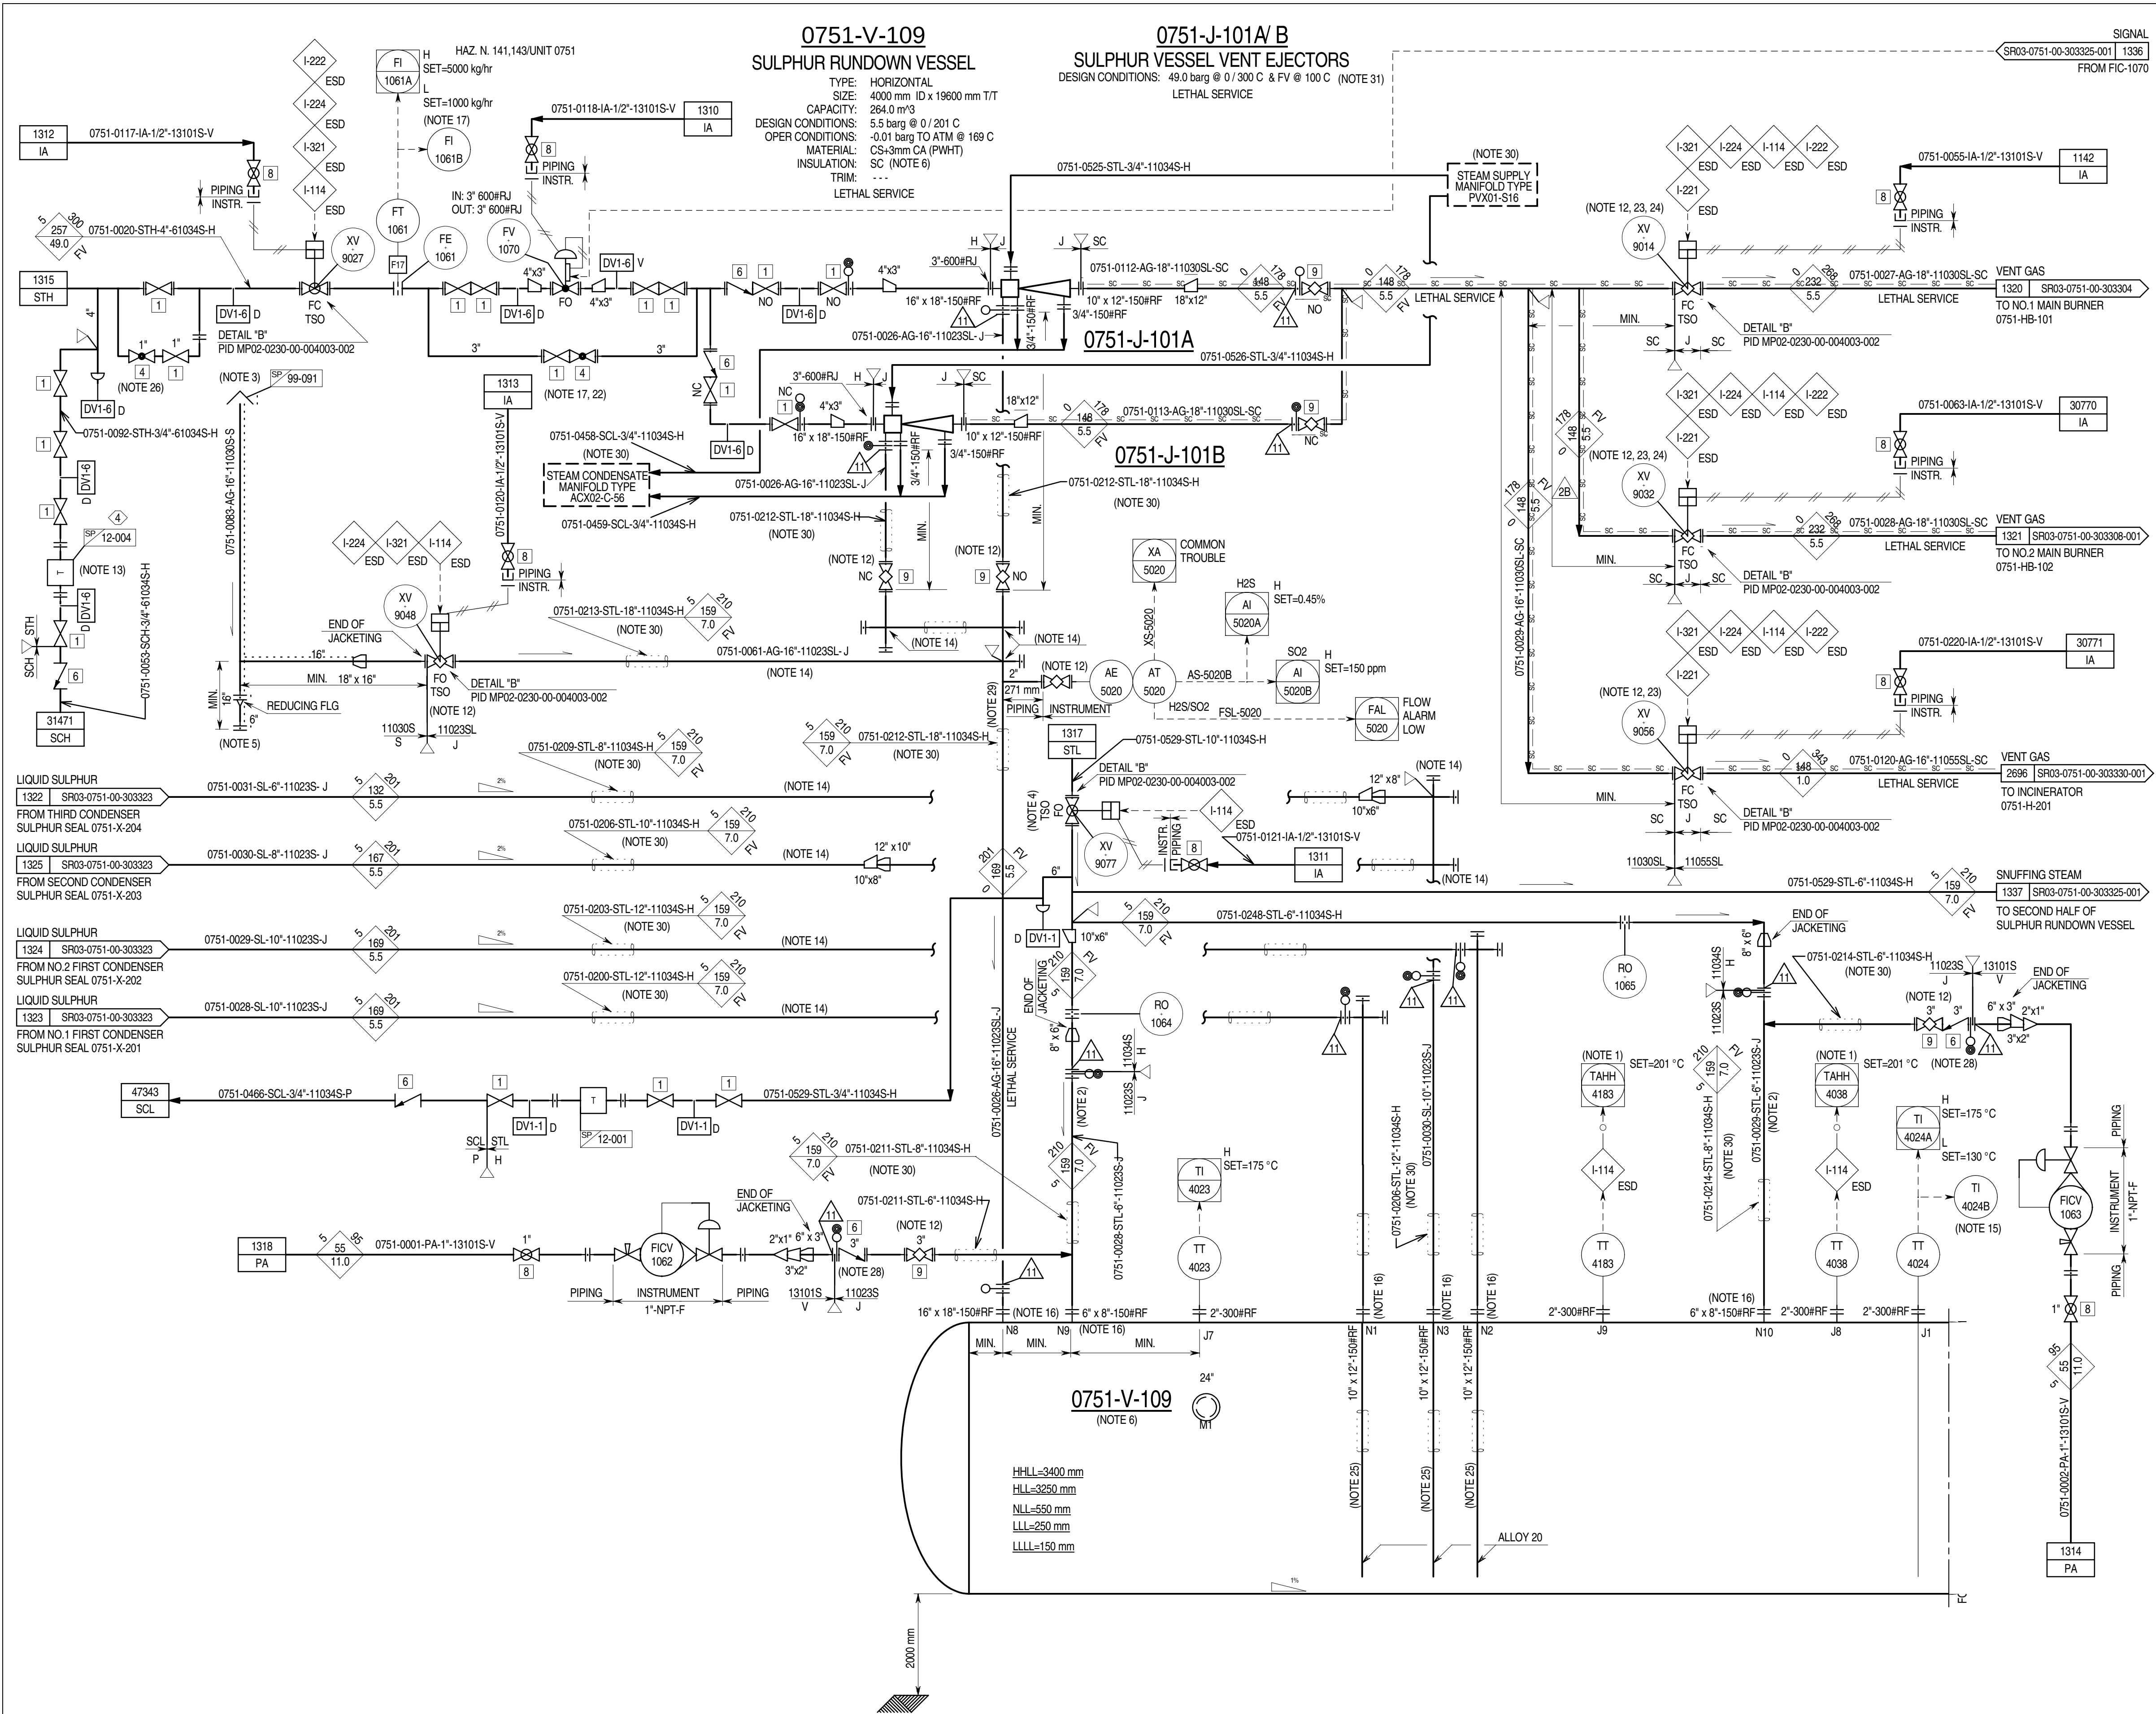

GENERAL NOTES:

- FOR STANDARD SYMBOLS, DETAILS, ABBREVIATIONS, SAMPLE CONNECTION TYPE, GENERAL NOTES & LEGEND SHEETS REFER TO DRAWING NO. MP02-0230-00-004000 TO 004015.
- ALL INSTRUMENT TAG NUMBERS ON THIS P&ID INCLUDING PACKAGE UNITS ARE PREFIXED WITH UNIT NUMBER 0751 UNLESS OTHERWISE NOTED.
- DELETED.

NOTES:

- FOR FIRE DETECTION IN VAPOUR SPACE.
- THE LAST ELBOW IN THE SNUFFING STEAM LINE PRIOR TO ITS CONNECTION INTO THE SULPHUR VESSEL SHALL BE AT LEAST 3m ABOVE THE VESSEL. THE LINE FROM THAT ELBOW TO THE VESSEL SHALL BE STEAM JACKETED.
- SULPHUR RUNDOWN VESSEL ALTERNATIVE ATMOSPHERIC VENT. HEIGHT WILL BE 15m MINIMUM ABOVE TOP OF SULPHUR RUNDOWN VESSEL AT A SAFE DISTANCE FROM OPERATING PLATFORM.
- LOCATE THE SULPHUR VESSEL SNUFFING STEAM BLOCK VALVE A MINIMUM OF 15m FROM THE VESSEL.
- BOOT FOR EMPTYING POSSIBLE SAND ACCUMULATION IN ATMOSPHERIC VENT.
- EXTERNAL BOLT ON STEAM JACKET PANELS AROUND VESSEL (SEE DWG. SR03-0751-00-303325-003).
- DELETED.
- DELETED.
- STEAM JACKETED VALVE.
- STEAM TRAP TO BE PROVIDED WITH INTEGRAL INLET STRAINER OTHERWISE A DEDICATED PIPING STRAINER TO BE INSTALLED UPSTREAM.
- FOR SULPHUR JACKETED LINES PROVIDE FLANGED BREAKS AT STANDARD PIPE LENGTHS. FOR CHANGE IN DIRECTION PROVIDE FLANGED CROSSES.
- TI-4024B TO BE READABLE FROM STEAM PANELS VALVES.
- STEAM JACKETED NOZZLE.
- FI-1061B TO BE READABLE FROM FV-1070 BY-PASS VALVE.
- DELETED.
- INTERLOCK TABLE IS FOR REFERENCE ONLY. CAUSE AND EFFECT MATRIX SR03-0751-00-CCC-303155 SHALL GOVERN.
- REFER TO CAUSE AND EFFECT CHART FOR FULL REPRESENTATION OF INTERLOCK INITIATORS AND ACTIONS.
- DELETED.
- FI-1070, ON DWG. SR03-0751-00-303325-001, TO BE READABLE FROM EJECTOR STEAM FLOW VALVE FV-1070 BY-PASS.
- VALVE TO BE PLACED AS CLOSE AS POSSIBLE TO SPLIT POINT.
- VENT GAS WILL BE SENT TO N. 1 MAIN BURNER 0751-HB-101 OR N. 2 MAIN BURNER 0751-HB-102.
- EXTENDED STEAM JACKETED LIQUID SULPHUR NOZZLES TO PROJECT INTO VESSEL TO A MINIMUM OF 50 mm BELOW LOW LIQUID LEVEL.
- GLOBE VALVE TO BE USED FOR WARM UP.
- DELETED.
- STEAM JACKETED CHECK VALVE TILTING DISK TYPE.
- FROM PIPE OD.
- FOR STEAM SUPPLY AND CONDENSATE RETURN REFERS TO TABLE 'A' AND 'B' ON P&ID.

UTILITY REFERENCE TABLE			
IA	DRW. N°	SR03-0751-00-PID-362305	
STL/STH/SCH	DRW. N°	SR03-0751-00-PID-362312	
PA	DRW. N°	SR03-0751-00-PID-362314	

Z1	04-11-14	IAB	ISSUED FOR AS BUILT	PCA	MAR	AS	
2.1F	18-04-14	IFC	ISSUED FOR COSTRUCTION	PCA	MAR	AS	
2.1E	28-02-14	IFC	ISSUED FOR CONSTRUCTION	PCA	MAR	AS	
2.1D	09-03-13	IFC	ISSUED FOR CONSTRUCTION	RL	CN	M2	
2.1C	31-10-12	IFC	ISSUED FOR CONSTRUCTION	RL	MF	M2	
2.1B	06-08-12	IFC	ISSUED FOR CONSTRUCTION		DSC	CBR	SIN
2	02-12-11	IFC	ISSUED FOR CONSTRUCTION		DSC	CBR	SIN
1	28-07-11	IFCH	ISSUED FOR CONSTRUCTION WITH HOLDS		DSC	CBR	SIN
0	15-02-11	IFD	ISSUED CLIENT COMMENTS INCORPORATED		BSC	LMA	SIN
B1	30-09-10	ICR	ISSUED FOR CLIENT REVIEW		BSC	LMA	SIN
REV	DATE	STATUS	STATUS DESCRIPTION	BY	CKD	APP	

COMPANY:

Abu Dhabi Gas Development Co. Ltd.



CONTRACTOR:



saipem

JOB No. 032090


PROJECT: SHAH GAS DEVELOPMENT (SGD) PROJECT

AGREEMENT No. 13525001

DRAWING TITLE: PIPING & INSTRUMENT DIAGRAM UNIT 0751
SULPHUR RECOVERY AND TAIL GAS TREATING UNIT

EQUIPMENT DESCRIPTION	SULPHUR RUNDOWN VESSEL - SHEET 1 OF 2
TAGITEM No.	0751-J-101A/B 0751-V-109

CONTRACTOR DRG.No.	751-GD-B-303324	REV. Z1
COMPANY DRG.No.	SR03-0751-00-303324	
SCALE:	SIZE: A1	DOC. CLASS: 1

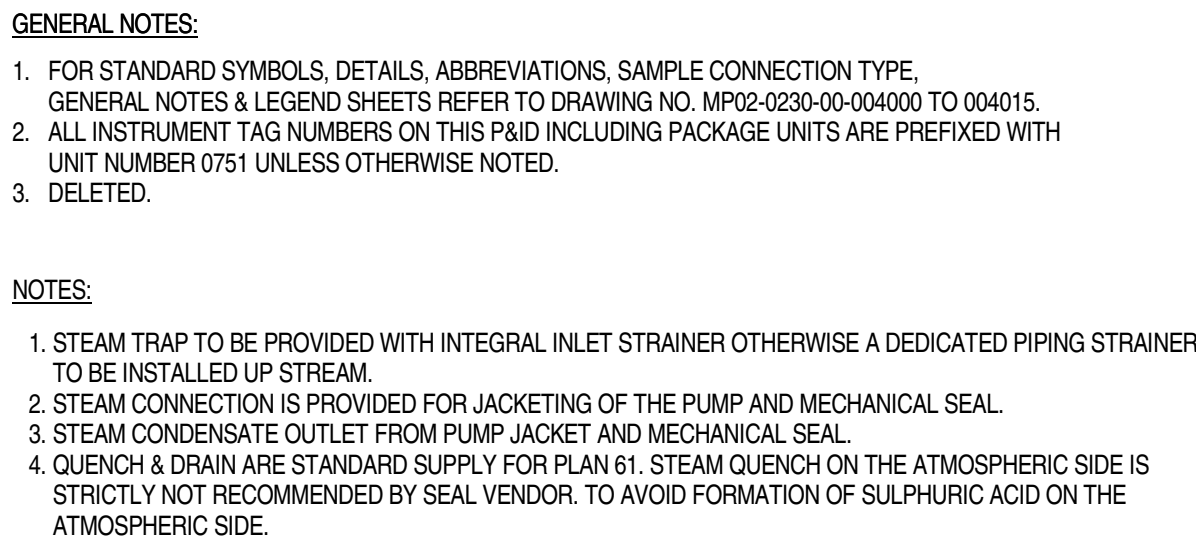

Z1	04-11-14	IAB	ISSUED FOR AS BUILT	PCA	MAR	AS
2.1F	18-04-14	IFC	ISSUED FOR CONSTRUCTION	PCA	MAR	AS
2.1E	28-02-14	IFC	ISSUED FOR CONSTRUCTION	PCA	MAR	AS
2.1D	15-06-13	IFC	ISSUED FOR CONSTRUCTION	RL	MS	AS
2.1C	31-10-12	IFC	ISSUED FOR CONSTRUCTION	RL	MF	M
2.1B	06-08-12	IFC	ISSUED FOR CONSTRUCTION	DSC	CBR	SI
2	02-12-11	IFC	ISSUED FOR CONSTRUCTION	DSC	CBR	SI
1	28-07-11	IFCH	ISSUED FOR CONSTRUCTION WITH HOLDS	DSC	CBR	SI
REV	DATE	STATUS	STATUS DESCRIPTION	BY	CKD	APP

COMPANY:

Abu Dhabi Gas Development Co. Ltd.




AGREEMENT No. 1352500-


EQUIPMENT DESCRIPTION	API PLAN 0751-P-102A/B
TAG/ITEM No.	

	DATE: 07/07/2015 09:00:00		21

THIS DOCUMENT IS THE PROPERTY OF ABU DHABI GAS DEVELOPMENT COMPANY LIMITED AND CONTAINS INFORMATION WHICH IS PROPRIETARY. THIS INFORMATION IS TO BE HELD IN CONFIDENCE. NO DISCLOSURE OR OTHER USE OF THIS DOCUMENT IS TO BE MADE WITHOUT THE PRIOR WRITTEN CONSENT OF ABU DHABI GAS DEVELOPMENT COMPANY LIMITED.

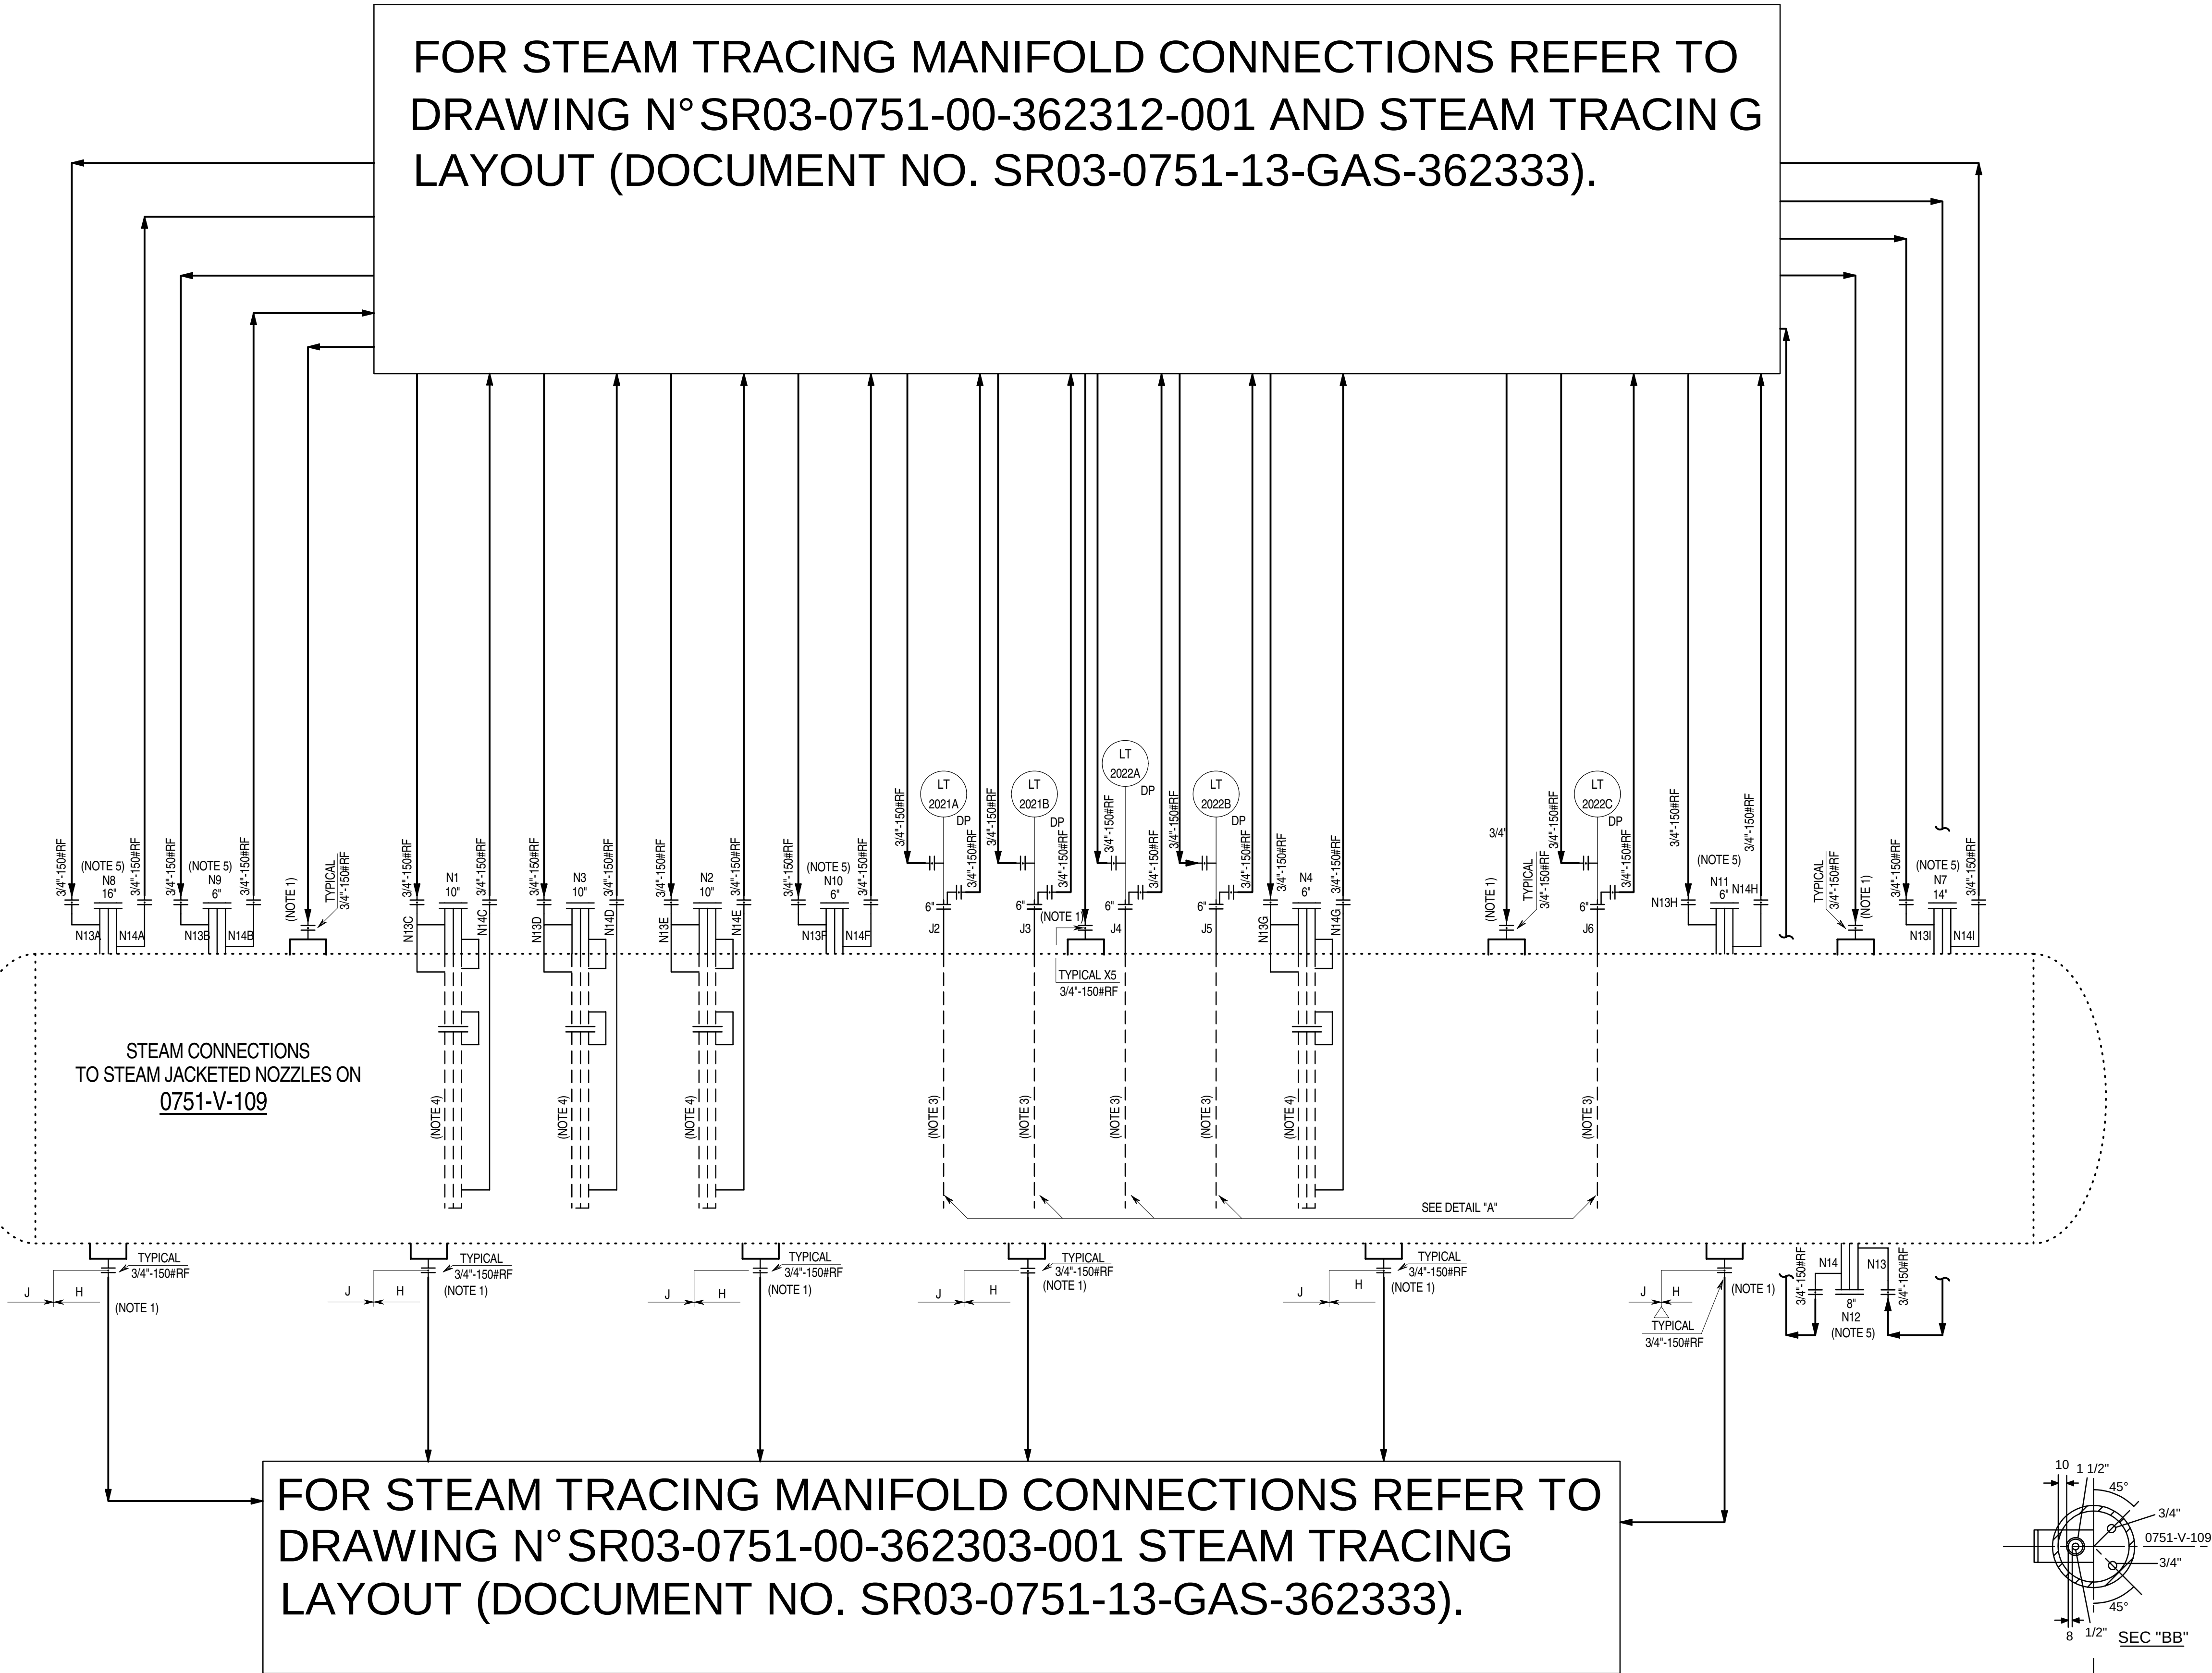

- GENERAL NOTES:
- FOR STANDARD SYMBOLS, DETAILS, ABBREVIATIONS, SAMPLE CONNECTION TYPE, GENERAL NOTES & LEGEND SHEETS REFER TO DRAWING NO. MP02-0230-00-004000 TO 004015.
 - ALL INSTRUMENT TAG NUMBERS ON THIS P&ID INCLUDING PACKAGE UNITS ARE PREFIXED WITH UNIT NUMBER 0751 UNLESS OTHERWISE NOTED.
 - DELETED.
- NOTES:
- EXTERNAL BOLT ON STEAM JACKET PANELS AROUND VESSEL. WITH N°22 NOZZLE 3/4"-150RF FOR STEAM IN AND N°33 NOZZLE 3/4"-150RF STEAM CONDENSATE OUT
 - DELETED.
 - STEAM JACKETED TUBING.
 - EXTENDED STEAM JACKETED LIQUID SULPHUR NOZZLES TO PROJECT INTO VESSEL AT MINIMUM 50 mm BELOW LOW LIQUID LEVEL.
 - STEAM JACKETED NOZZLES.

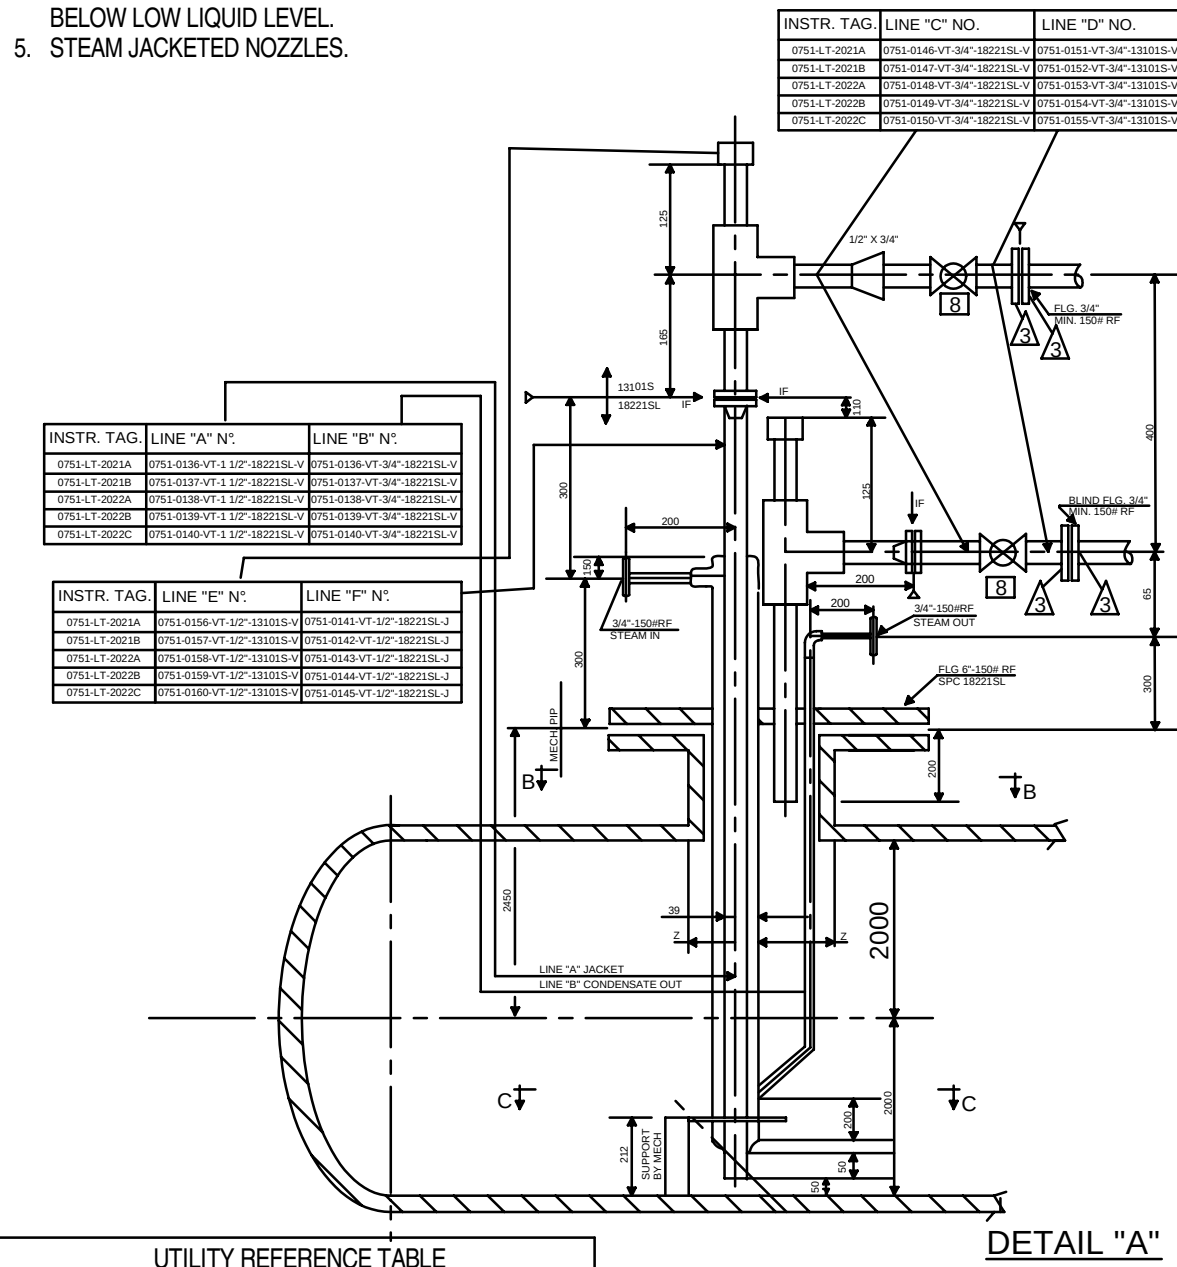

UTILITY REFERENCE TABLE					
SCL	DRW. N°.	SR03-0751-00-PID-362303			
STL	DRW. N°.	SR03-0751-00-PID-362312			
Z1	04-11-14	IAB	ISSUED FOR AS BUILT		PCA MAR ASP
2.1F	18-04-14	IFC	ISSUED FOR CONSTRUCTION		PCA MAR ASP
2.1E	28-02-14	IFC	ISSUED FOR CONSTRUCTION		PCA MAR ASP
2.1D	05-05-13	IFC	ISSUED FOR CONSTRUCTION		RL MS AS
2.1C	31-10-12	IFC	ISSUED FOR CONSTRUCTION		RL MF MZ
2.1B	06-08-12	IFC	ISSUED FOR CONSTRUCTION		DSC CBR SIN
2	02-12-11	IFC	ISSUED FOR CONSTRUCTION		DSC CBR SIN
1	28-07-11	IFCH	ISSUED FOR CONSTRUCTION WITH HOLDS		DSC CBR SIN
REV	DATE	STATUS	STATUS DESCRIPTION		BY CKD APP.

COMPANY:

Abu Dhabi Gas Development Co. Ltd.

CONTRACTOR:

JOB No. 032090

PROJECT:

SHAH GAS DEVELOPMENT (SGD) PROJECT

AGREEMENT No. 13525001

DRAWING TITLE: PIPING & INSTRUMENT DIAGRAM UNIT 0751 SULPHUR RECOVERY AND TAIL GAS TREATING UNIT

EQUIPMENT DESCRIPTION	SULPHUR RUNDOWN VESSEL STEAM JACKET
TAGITEM No.	


CONTRACTOR DRG. No.	751-GD-B-303325	REV. Z1
COMPANY DRG. No.	SR03-0751-00-303325-003	
SCALE:	SIZE: A1	DOC. CLASS: 1

THIS DOCUMENT IS THE PROPERTY OF ABU DHABI GAS DEVELOPMENT COMPANY LIMITED. NO DISCLOSURE OR OTHER USE OF THIS DOCUMENT IS TO BE MADE WITHOUT THE PRIOR WRITTEN CONSENT OF ABU DHABI GAS DEVELOPMENT COMPANY LIMITED.

GENERAL NOTES:
1. FOR STANDARD SYMBOLS, DETAILS, ABBREVIATIONS, SAMPLE CONNECTION TYPE.
GENERAL NOTES & LEGEND SHEETS REFER TO DRAWING NO. MP02-0230-00-004000 TO 004015.
2. ALL INSTRUMENT TAG NUMBERS ON THIS PAID INCLUDING PACKAGE UNITS ARE PREFIXED WITH UNIT NUMBER 0751 UNLESS OTHERWISE NOTED.
3. DELETED.

0751-E-112
SULPHUR COOLER

TYPE: SHELL AND TUBE
TEMA TYPE: NKN
DESIGN DUTY: 1220 Mcal/hr
HEAT TRANSFER AREA: 887.0 m²
SHELL DESIGN CONDITIONS: 10.6 barg @ 5/210 C & PV @ 100 C
OPER CONDITIONS (IN): 1.05 barg @ 122.0 C (OUT): 1.03 barg @ 120.0 C
MATERIAL: CS+3mm CA
INSULATION: H
TRIM: VT-0017-31034S-H
VT-0056-33023S-LJ

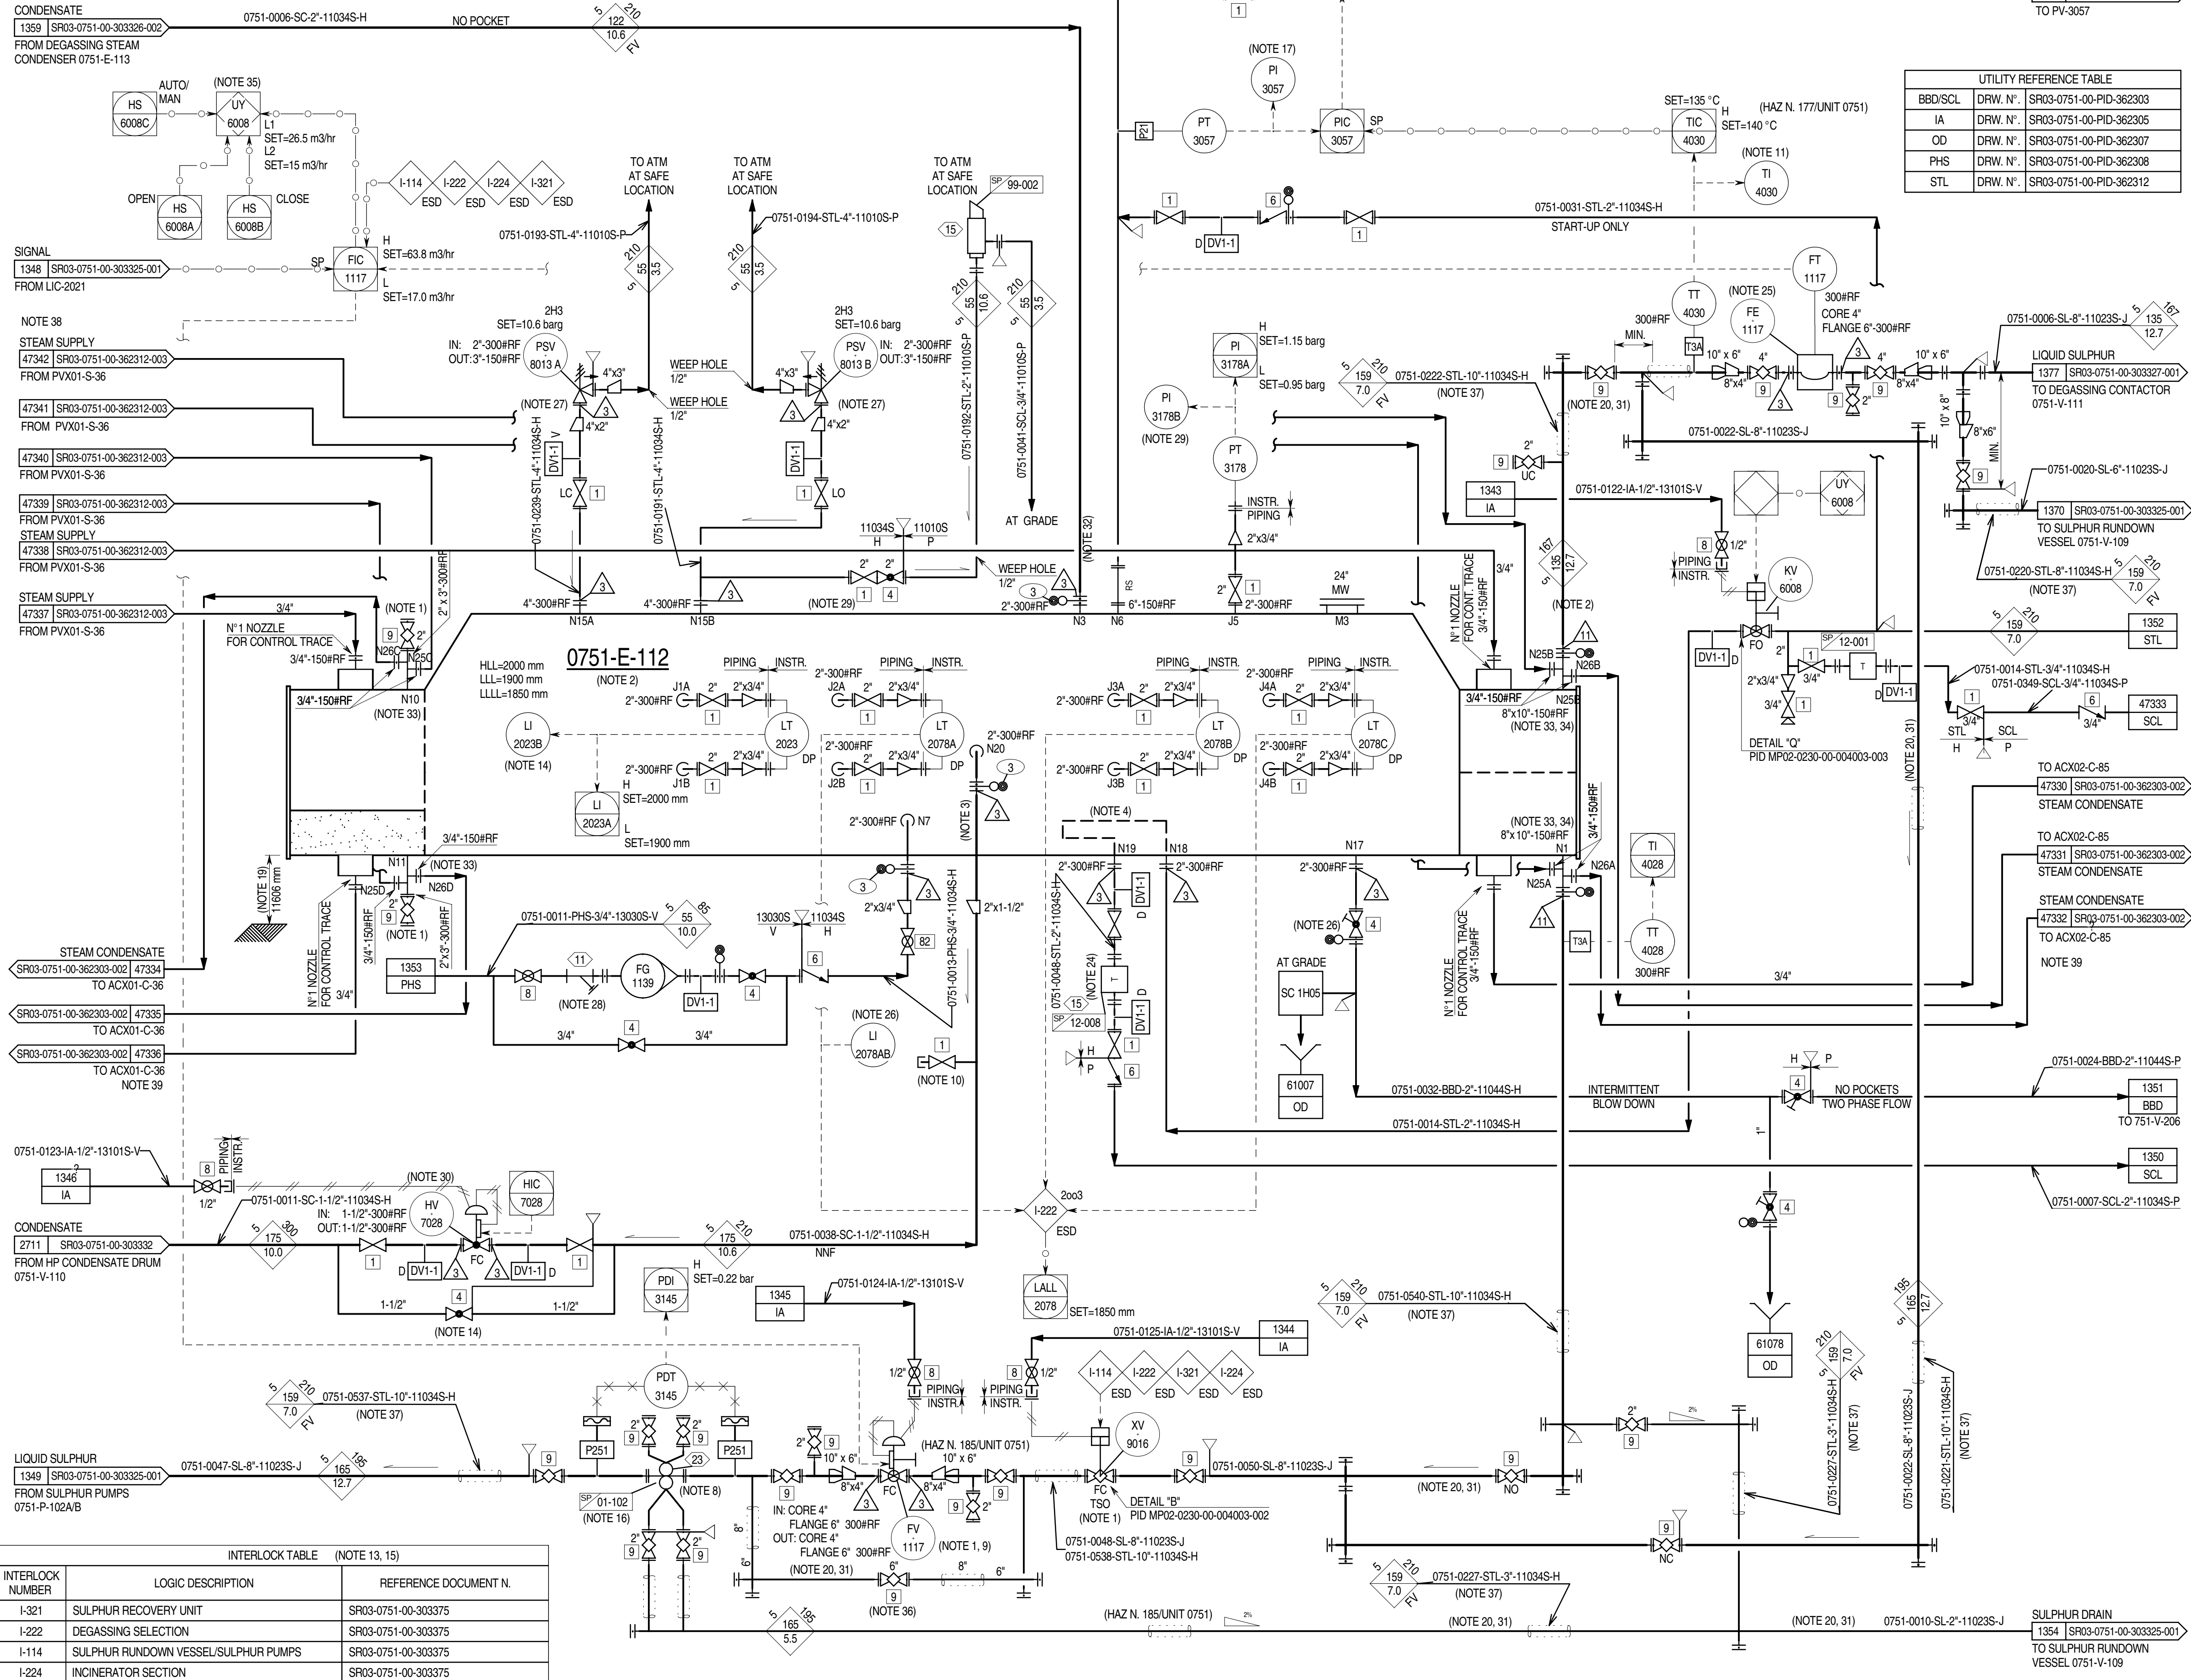

UTILITY REFERENCE TABLE

BBD/SCL	DRW. N°	SR03-0751-00-303323-003
IA	DRW. N°	SR03-0751-00-PID-362305
OD	DRW. N°	SR03-0751-00-PID-362307
PHS	DRW. N°	SR03-0751-00-PID-362308
STL	DRW. N°	SR03-0751-00-PID-362312

INTERLOCK TABLE (NOTE 13, 15)

INTERLOCK NUMBER	LOGIC DESCRIPTION	REFERENCE DOCUMENT N.
I-321	SULPHUR RECOVERY UNIT	SR03-0751-00-303375
I-222	DEGASSING SELECTION	SR03-0751-00-303375
I-114	SULPHUR RUNDOWN VESSEL/SULPHUR PUMPS	SR03-0751-00-303375
I-224	INCINERATOR SECTION	SR03-0751-00-303375

- NOTES:**
- STEAM JACKETED VALVE.
 - CONTRACOR IS PROVIDED ON FULL CIRCUMFERENCE OF EXCHANGER CHANNEL ENDS. HAZ N.172/UNIT 0751.
 - LP CONDENSATE MAKE-UP IS LOCATED AT CENTER LINE.
 - 2" STEAM COIL TO BE LOCATED IN BOTTOM OF 0751-E-112.
 - DELETED.
 - DELETED.
 - DELETED.
 - STEAM JACKETED DUPLEX STRAINER WITH SCREEN 20 MESH.
 - FISCHER "V" BALL TYPE CONTROL VALVE REQUIRED FOR FV-1117.
 - ACID WASH CONNECTION.
 - TI-4030 TO BE READABLE FROM PV-3057 BY-PASS, ON DRAWING SR03-0751-00-303326-002.
 - DELETED.
 - INTERLOCK TABLE IS FOR REFERENCE ONLY CAUSE AND EFFECT MATRIX SR03-0751-00-CCC-303155 SHALL GOVERN.
 - LI-2023B TO BE READABLE FROM HV-7028 BY-PASS VALVE.
 - REFER TO CAUSE AND EFFECT CHART FOR FULL REPRESENTATION OF INTERLOCK INITIATORS AND ACTIONS.
 - MANUFACTURER TO SUPPLY INLET AND OUTLET VALVES FOR STRAINER.
 - PI-3057 TO BE READABLE FROM PV-3057 BY-PASS, ON DRAWING SR03-0751-00-303326-002.
 - DELETED.
 - SULPHUR COOLER TO BE AT MINIMUM ELEVATION TO BE FREE DRAINING TO SULPHUR RUNDOWN VESSEL 0751-V-109.
 - FOR SULPHUR JACKETED LINES PROVIDE FLANGED BREAKS AT STANDARD PIPE LENGTHS. FOR CHANGE IN DIRECTION PROVIDE FLANGED CROSSES.
 - DELETED.
 - DELETED.
 - DELETED.
 - STEAM TRAP TO BE PROVIDED WITH INTEGRAL INLET STRAINER OTHERWISE A DEDICATED PIPING STRAINER TO BE INSTALLED UPSTREAM.
 - PI-1117 IS STEAM JACKETED. (HAZ N. 168/UNIT 0751).
 - LI-2078AB TO BE READABLE FROM BLOWDOWN VALVE. (HAZ N. 197/UNIT 0751).
 - PSV-8013 SIZING CASE: BLOCKED DISCHARGE.
 - STRAINER WITH SCREEN 20 MESH.
 - PI-3178B TO BE READABLE FROM MANUAL VENT VALVE OF PSV-8013.
 - LOCATE HV-7028 AT GRADE AT MINIMUM DISTANCE FROM 0751-E-112.
 - ALL VALVES (CONTROL, BLOCK, DRAINS) AND FITTINGS ON SULPHUR JACKETED LINES TO BE STEAM JACKETED.
 - NOZZLE N3 TO INCORPORATE DISTRIBUTOR TO RETURN CONDENSATE BETWEEN NLL AND TOP TUBE ROW ALONG 1/3 OF BUNDLE LENGTH.
 - STEAM JACKETED NOZZLE.
 - NOZZLE JACKET WILL BE PART OF RELEVANT LINE JACKET.
 - IN ORDER TO PREVENT THE SULPHUR FREEZING, DCS LOGIC UY-6008 OPENS KV-6008 ON LP STEAM JACKET LINE WHEN LIQUID SULPHUR FLOW RATE (FT-1117) IS LOWER THAN L2 AND CLOSSES IT WHEN FLOW RATE RISES ABOVE THE L1.
 - LI-2021AB (SHOWN ON PAID SR03-0751-00-303325-001) TO BE READABLE FROM FV-1117 BY PASS VALVE.
 - FOR STEAM SUPPLY AND CONDENSATE RETURN REFERS TO TABLE 'A' AND 'B' ON PAID SR03-0751-00-362312-005.
 - THERE IS ONE SUPPLY STEAM MANIFOLD (PVX). FOR DETAIL REFER TO DRAWING N° SR03-0751-00-362312-003 AND TO STEAM TRACING LAYOUT DOC. N° 0751-13-GAS-362333.
 - THERE ARE TWO STEAM CONDENSATE MANIFOLDS (ACX). FOR DETAIL REFER TO DRAWING N° SR03-0751-00-362303-002 AND TO STEAM TRACING LAYOUT DOC. N° 0751-13-GAS-362333.

ZI	04-11-14	IAB	ISSUED FOR AS BUILT	PCA	MAR	ASP
2.1G	18-04-14	IFC	ISSUED FOR CONSTRUCTION	PCA	MAR	ASP
2.1F	28-02-14	IFC	ISSUED FOR CONSTRUCTION	PCA	MAR	ASP
2.1E	05-05-13	IFC	ISSUED FOR CONSTRUCTION	RL	MS	AS
2.1D	10-03-13	IFC	ISSUED FOR CONSTRUCTION	RL	CN	MZ
2.1C	31-10-12	IFC	ISSUED FOR CONSTRUCTION	RL	MF	MZ
2.1B	06-08-12	IFC	ISSUED FOR CONSTRUCTION	DSC	CBR	SIN
2	02-12-11	IFC	ISSUED FOR CONSTRUCTION	DSC	CBR	SIN
1	28-07-11	IFCH	ISSUED FOR CONSTRUCTION WITH HOLDS	DSC	CBR	SIN
0	15-02-11	IFD	ISSUED CLIENT COMMENTS INCORPORATED	BSC	LMA	SIN
B1	30-09-10	ICR	ISSUED FOR CLIENT REVIEW	BSC	LMA	SIN
REV	DATE	STATUS	STATUS DESCRIPTION	BY	CKD	APP.

COMPANY:


Abu Dhabi Gas Development Co. Ltd.

CONTRACTOR:

PROJECT: SHAH GAS DEVELOPMENT (SGD) PROJECT

AGREEMENT No. 13525001

DRAWING TITLE: PIPING & INSTRUMENT DIAGRAM UNIT 0751 SULPHUR RECOVERY AND TAIL GAS TREATING UNIT		
EQUIPMENT DESCRIPTION	SULPHUR COOLER	
TAGITEM No.	0751-E-112	
CONTRACTOR DRG.No.	751-GD-B-303326	REV. Z1
COMPANY DRG.No.	SR03-0751-00-303326-001	
SCALE:	SIZE: A1	DOC. CLASS: 1

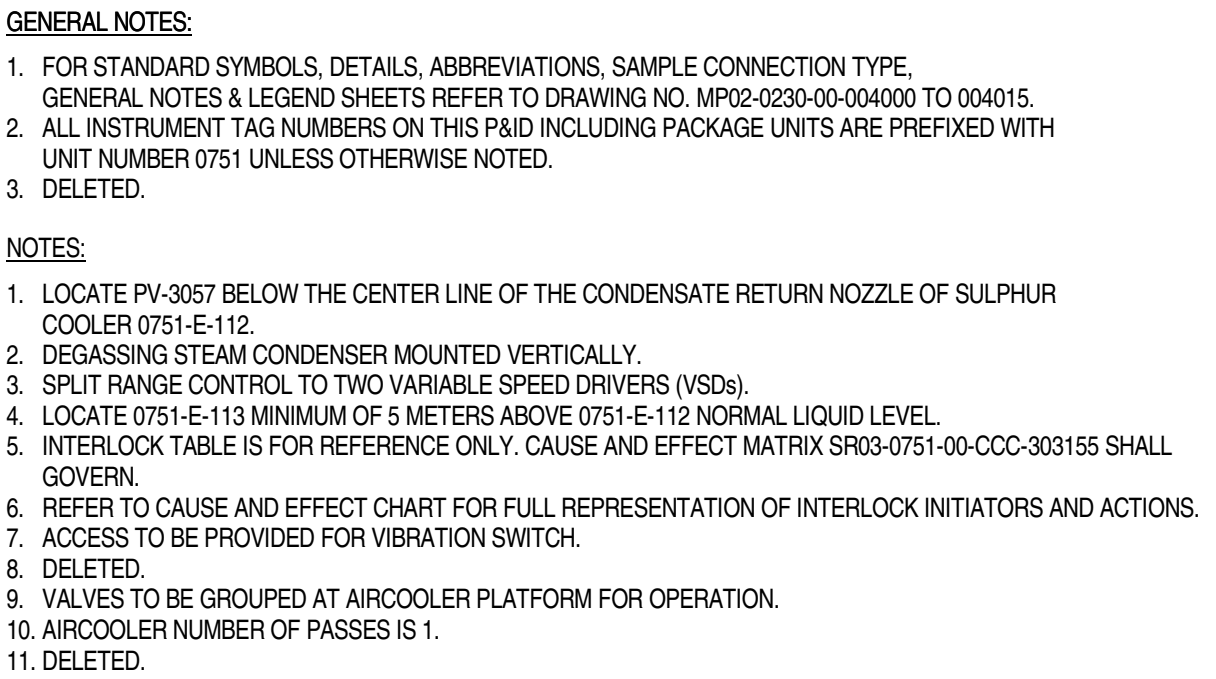

Z1	04-11-14	IAB	ISSUED FOR AS BUILT	PCA	MAR	ASP
2.1G	18-04-14	IFC	ISSUED FOR CONSTRUCTION	PCA	MAR	ASP
2.1F	28-02-14	IFC	ISSUED FOR CONSTRUCTION	PCA	MAR	ASP
2.1E	05-05-13	IFC	ISSUED FOR CONSTRUCTION	RL	MS	AS
2.1D	10-03-13	IFC	ISSUED FOR CONSTRUCTION	RL	MS	AS
2.1C	31-10-12	IFC	ISSUED FOR CONSTRUCTION	RL	MF	MZ
2.1B	06-08-12	IFC	ISSUED FOR CONSTRUCTION	DSC	CBR	SIN
2	02-12-11	IFC	ISSUED FOR CONSTRUCTION	DSC	CBR	SIN
1	28-07-11	IFCH	ISSUED FOR CONSTRUCTION WITH HOLDS	DSC	CBR	SIN
0	15-02-11	IFD	ISSUED CLIENT COMMENTS INCORPORATED	BSC	LMA	SIN
B1	30-09-10	ICR	ISSUED FOR CLIENT REVIEW	BSC	LMA	SIN
REV	DATE	STATUS	STATUS DESCRIPTION	BY	CKD	APP.

CONTRACTOR:

 **saipem**

JOB No. 032090

DRAWING TITLE: PIPING & INSTRUMENT DIAGRAM UNIT 0751
SULPHUR RECOVERY AND TAIL GAS TREATING UNIT

CONTRACTOR DRG No.		751-GD-B-303326	REV.
COMPANY DRG No.		SR03-0751-00-303326-002	
SCALE:	SIZE: A1	DOC. CLASS 1	


THIS DOCUMENT IS THE PROPERTY OF ABU DHABI GAS DEVELOPMENT COMPANY LIMITED. NO DISCLOSURE OR OTHER USE OF THIS DOCUMENT IS TO BE MADE WITHOUT THE PRIOR WRITTEN CONSENT OF ABU DHABI GAS DEVELOPMENT COMPANY LIMITED.

GENERAL NOTES:

- FOR STANDARD SYMBOLS, DETAILS, ABBREVIATION, SAMPLE CONNECTION TYPE, GENERAL NOTES & LEGEND SHEETS REFER TO DRAWING NO. MP02-0230-00-004000 TO 004015.
- ALL INSTRUMENT TAG NUMBERS ON THIS P&ID INCLUDING PACKAGE UNITS ARE PREFIXED WITH UNIT NUMBER 0751 UNLESS OTHERWISE NOTED.
- DELETED.

UTILITY REFERENCE TABLE	
IA	DRW. N°. SR03-0751-00-PID-362305

DETAIL "I"

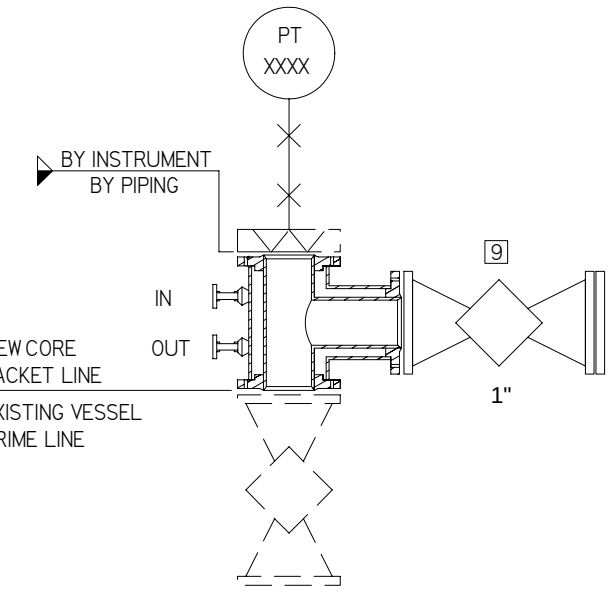


INSTRUMENT	CORE PIPE	JACKET LINE	IN - STEAM LINE	OUT - CONDENSATE LINE	REMARK
PT- 3059	0052-SL	0554-STL	0492-STL-3/4"	0381-SCL-3/4"	FOR LINES SIZE AND VALVES OPTION REFER TO PIPING ASSEMBLY P250 DOC. N. 230-GA-E-061508
PT- 3220	0053-SL	0555-STL	PVX01-S-42	ACX01-S-82	
PT- 3189	0054-SL	0556-STL			

0751-V-111 DEGASSING CONTACTOR

TYPE: VERTICAL
SIZE: 2300 mm ID x 11100 mm T/T
CAPACITY: 48.7 m³
DESIGN CONDITIONS: 12.7 barg @ 0 C / 167 C (NOTE 22)
OPER CONDITIONS TOP: 4.8 barg @ 135 C
OPER CONDITIONS BOTTOM: 6.5 barg @ 137 C
MATERIAL: CS (NOTE 35)
INSULATION: H (NOTE 14)
TOP OF HEAD TRIM: VT-0019-33023SL-J
TRIM MODEL: VT-0020-11023SL-J

LETHAL SERVICE

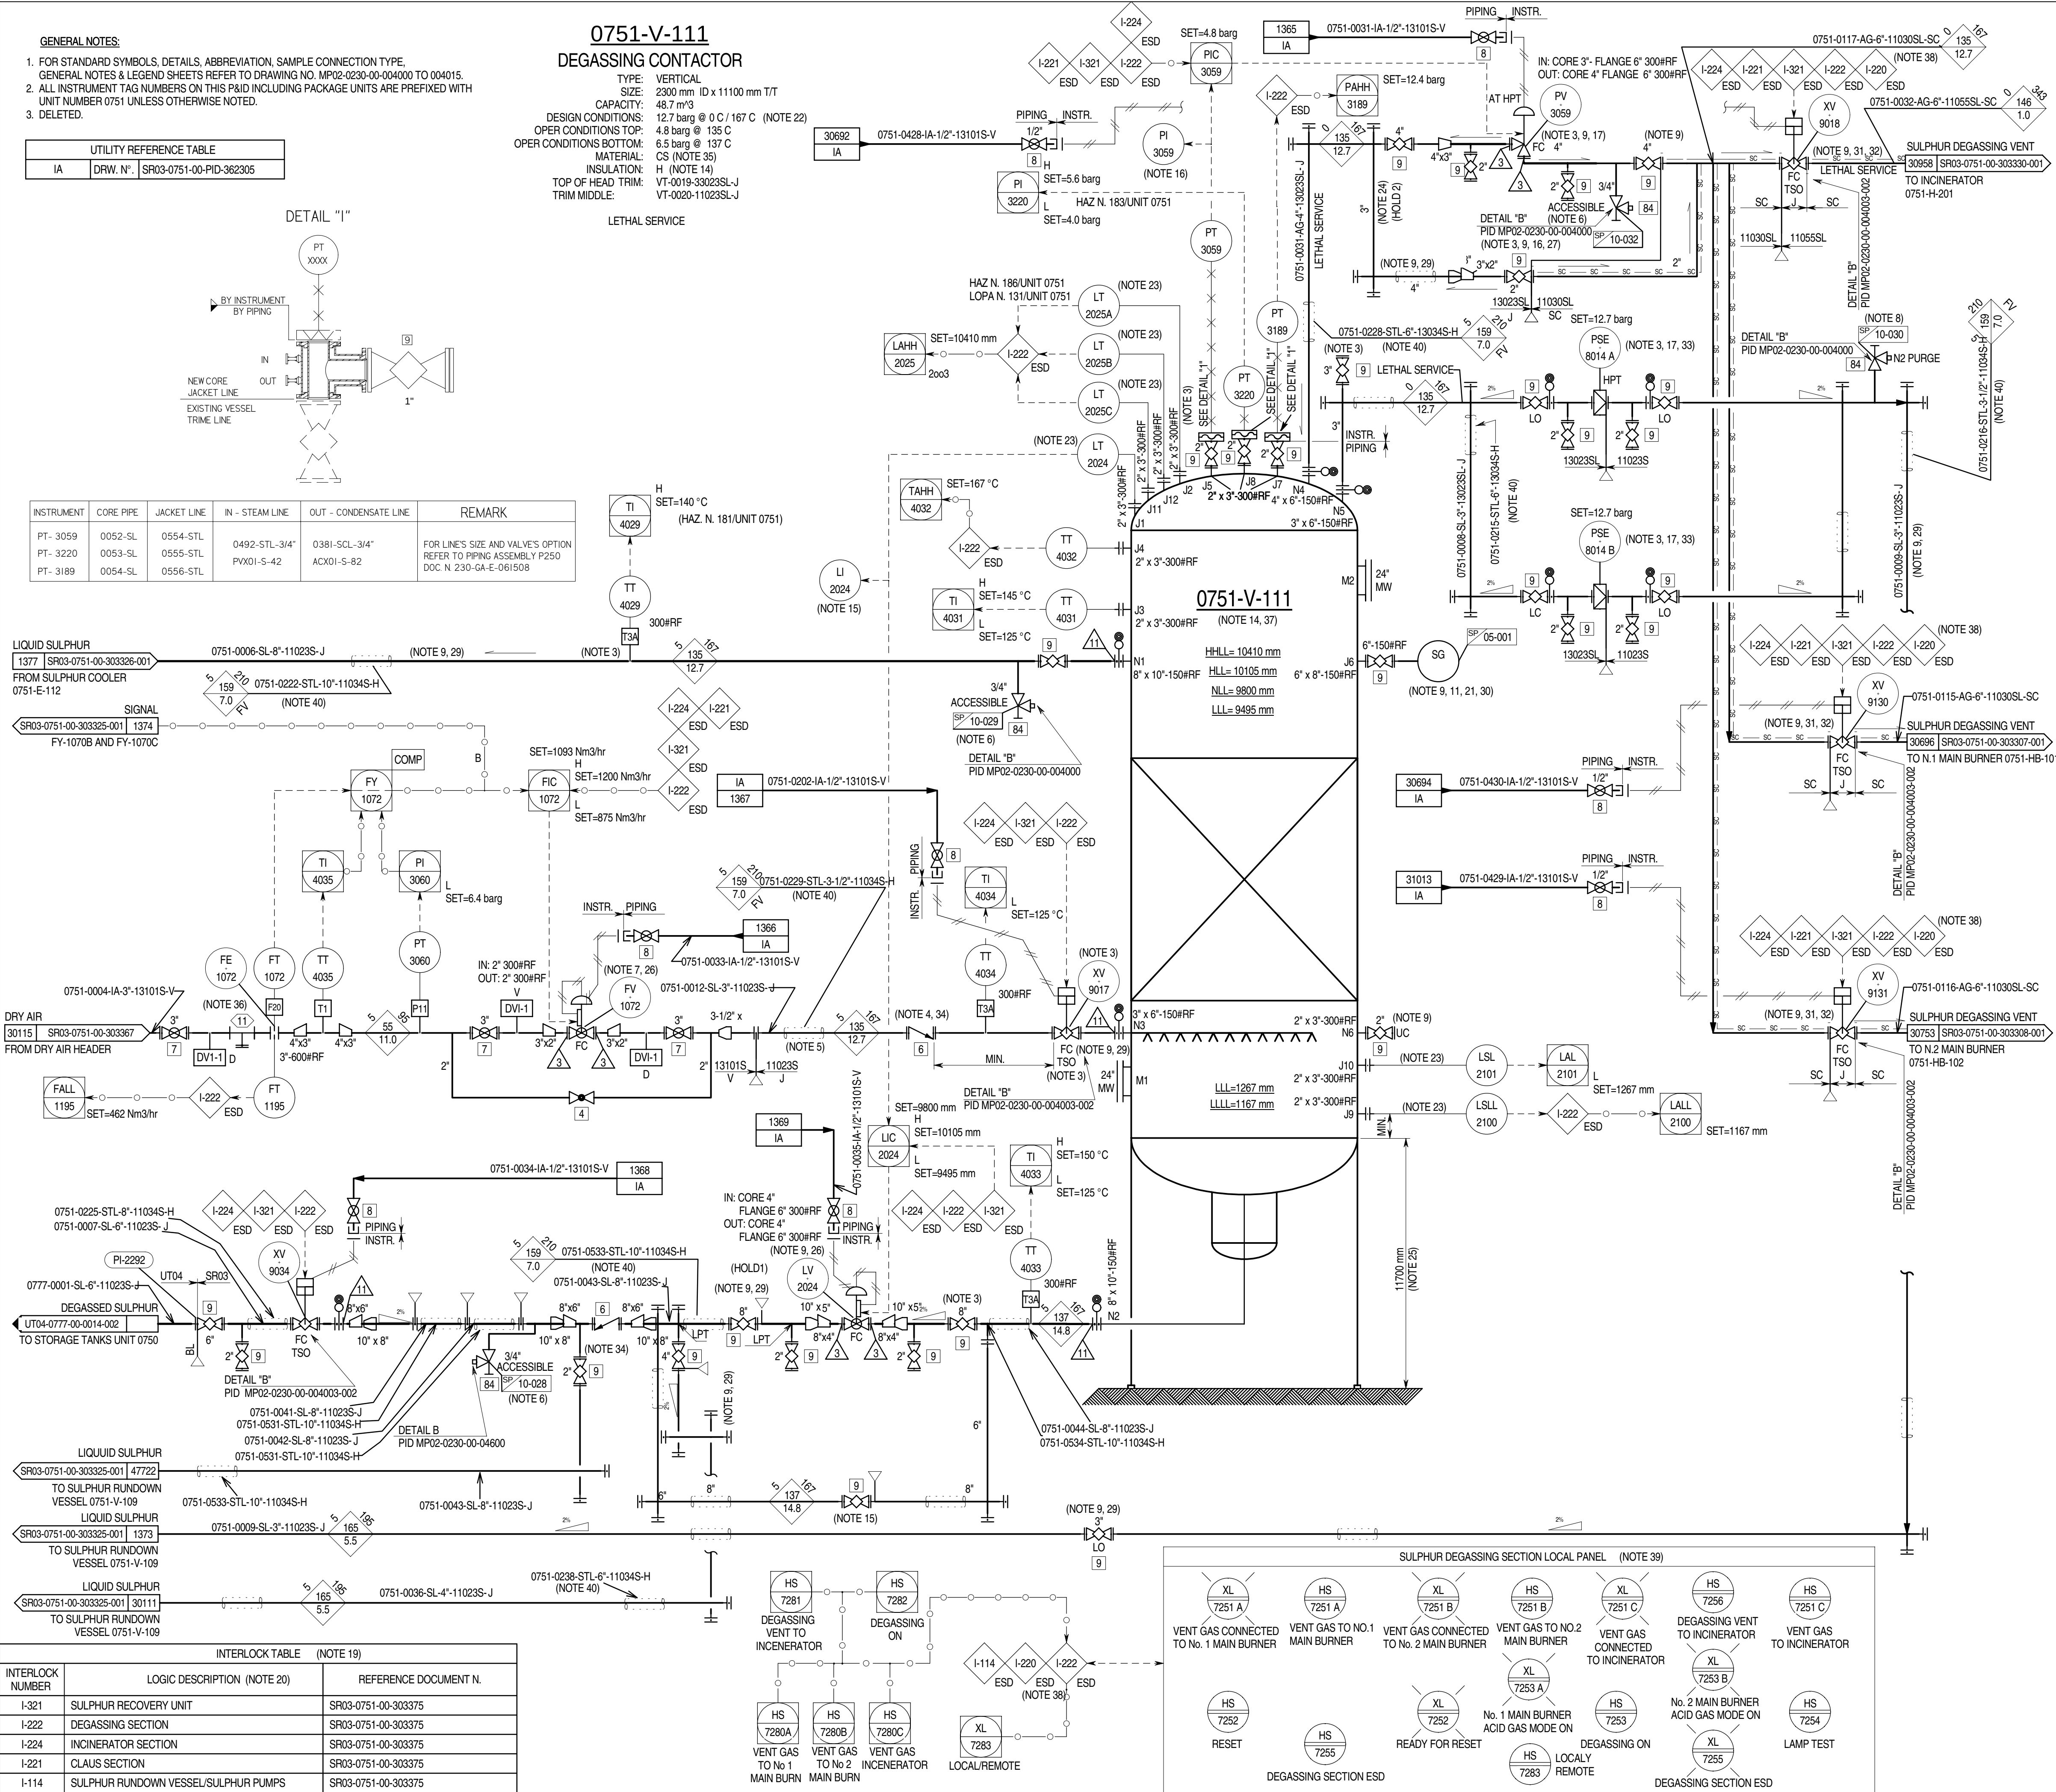

INTERLOCK TABLE (NOTE 19)		
INTERLOCK NUMBER	LOGIC DESCRIPTION (NOTE 20)	REFERENCE DOCUMENT N.
I-321	SULPHUR RECOVERY UNIT	SR03-0751-00-303375
I-222	DEGASSING SECTION	SR03-0751-00-303375
I-224	INCINERATOR SECTION	SR03-0751-00-303375
I-221	CLAUS SECTION	SR03-0751-00-303375
I-114	SULPHUR RUNDOWN VESSEL/SULPHUR PUMPS	SR03-0751-00-303375

NOTES:

- DELETED.
- DELETED.
- LOCATE AS NEAR TO 0751-V-111 AS PRACTICAL (MIN. PIPING).
- MOUNT IN HORIZONTAL RUN WITH WAFER HINGES IN VERTICAL LOW TORQUE SPRINGS.
- 15m MINIMUM JACKETED LENGTH. TO HEAT THE AIR TO AT LEAST 135° C.
- LOCATE STRAHMAN VALVE ACCESSIBLE ON SIDE OF PIPE WITH 457mm (18") CLEARANCE UNDER VALVE OUTLET DISCHARGE DOWNWARD. 60°x30
- MOUNT FV-1072 ABOVE NORMAL LIQUID LEVEL IN 0751-V-111.
- 3/4" STRAHMAN VALVE FOR N2 PURGE FOR DISK REPLACEMENT.
- ALL VALVES (CONTROL, BLOCK, DRAINS) AND FITTINGS ON SULPHUR JACKETED LINES TO BE STEAM JACKETED.
- DELETED.
- PROVIDE REMOVABLE INSULATION PLUG WITH HANDLE OVER SIGHT GLASS.
- DELETED.
- DELETED.
- VESSEL TO BE FURNISHED WITH MULTIPLE STEAM JACKETS SECTIONS (BETWEEN STIFFENING RINGS). FOR LIQUID FILLED SECTION BELOW 8763 mm OPERATING STEAM JACKETING CONDITIONS ARE 2.4 BARG @ 138° C. FOR VAPOUR FILLED SECTION ABOVE 8763 mm OPERATING CONDITIONS ARE 5 BARG @ 159° C.
- LI-2024 TO BE READABLE FROM LV-2024 BY-PASS VALVE.
- PI-3059 TO BE READABLE FROM PV-3059 BY-PASS VALVE.
- LOCATE PSE-8014A/B AND PV-3059 AT HIGH POINT, RELEVANT PIPING SHALL BE IN FLAT HORIZONTAL PLANE WITH NO POCKETS.
- DELETED.
- INTERLOCK TABLE IS FOR REFERENCE ONLY. CAUSE AND EFFECT MATRIX SR03-0751-00-CCC-303155 SHALL GOVERN.
- REFER TO CAUSE AND EFFECT CHART FOR FULL REPRESENTATION OF INTERLOCK INITIATORS AND ACTIONS.
- DEGASSING SIGHT GLASS TO BE ACCESSIBLE FROM PLATFORM.
- EXTERNAL JACKET DESIGN CONDITIONS: 7 BARG @ 5/210° C AND FV@100° C. VESSEL SHELL EXTERNAL DESIGN PRESSURE IS HV@150° C VESSEL SHELL EXTERNAL DESIGN PRESSURE SHALL NOT BE CONSIDERED TOGETHER WITH STEAM JACKETING DESIGN CONDITION.
- CAPACITANCE TYPE LEVEL INSTRUMENT.
- PV-3059 BY-PASS TO BE IN FLAT HORIZONTAL PLANE WITH NO POCKETS.
- ELEVATION FOR FREE DRAINING INTO THE SULPHUR RUNDOWN VESSEL.
- FISHER "V" BALL TYPE CONTROL VALVE REQUIRED FOR LV-2024, FV-1072.
- MANUAL BY-PASS FOR PV-3059 IS TO BE MANUALLY OPERATED "V" BALL TYPE FISHER VALVE.
- DELETED.
- FOR SULPHUR JACKETED LINES PROVIDE FLANGED BREAKS AT STANDARD PIPE LENGTHS. FOR CHANGE IN DIRECTION PROVIDE FLANGED CROSSES.
- SIGHT GLASS NOZZLE LOCATED AT OPPOSITE SIDE FROM LIQUID SULPHUR INLET NOZZLE.
- VALVE TO BE PLACED AS CLOSE AS POSSIBLE TO SPLIT POINT.
- SULPHUR DEGASSING VENT WILL BE SENT TO No. 1 MAIN BURNER 0751-HB-101 (ON DRAWING SR03-0751-00-PID-303307-001) OR No.2 MAIN BURNER 0751-HB-102 (ON DRAWING SR03-0751-00-PID-303308-001)
- PSE-8014 SIZING CASE: FIRE.
- JACKETED CHECK VALVE TILTING DISK TYPE.
- THE TOP HEAD AND THE TOP 2.3mm OF THE SHELL ARE CS WITH 3mm OF 316L SS CLADDING. THE REMAINING NON CLADDIED SHELL SHALL HAVE A CORROSION ALLOWANCE OF 4.5mm (3mm INTERNAL CA + 1.5mm EXTERNAL CA).
- STRAINER WITH SCREEN 20 MESH.
- ALL NOZZLES EXCEPT MANWAYS ARE STEAM JACKETED.
- SIGNAL TO BE SEGREGATED REFERENCE TO BE MADE TO MAIN BURNERS AND CLAUS SECTION ESD
- 0751-1220/0751-1221 LOGIC SYSTEM DESCRIPTION DOCUMENT NO. SR03-0751-00-SPE-303161.
- REFER TO 0751-1222 LOGIC SYSTEM DESCRIPTION (DOC. N. SR03-0751-00-SPE-303126) FOR DEGASSING SECTION START-UP.
- FOR STEAM SUPPLY AND CONDENSATE RETURN REFERS TO TABLE 'A' AND 'B' ON P&ID SR03-0751-00-362312-005.

Z1	04-11-14	IAB	ISSUED FOR AS BUILT	PCA	MAR	ASP
2.1F	18-04-14	IFC	ISSUED FOR CONSTRUCTION	PCA	MAR	ASP
2.1E	28-02-14	IFC	ISSUED FOR CONSTRUCTION	PCA	MAR	ASP
2.1D	09-03-13	IFC	ISSUED FOR CONSTRUCTION	RL	CN	MZ
2.1C	31-10-12	IFC	ISSUED FOR CONSTRUCTION	RL	MF	MZ
2.1B	06-08-12	IFC	ISSUED FOR CONSTRUCTION	DSC	CBR	SIN
2	02-12-11	IFC	ISSUED FOR CONSTRUCTION	DSC	CBR	SIN
1	28-07-11	IFCH	ISSUED FOR CONSTRUCTION WITH HOLDS	DSC	CBR	SIN
0	15-02-11	IFD	ISSUED CLIENT COMMENTS INCORPORATED	BSC	LMA	SIN
B1	30-09-10	ICR	ISSUED FOR CLIENT REVIEW	BSC	LMA	SIN
REV	DATE	STATUS	STATUS DESCRIPTION	BY	CKD	APP.

COMPANY:

Abu Dhabi Gas Development Co. Ltd.

الحصن للغاز
Al Hosn Gas

CONTRACTOR:

eni saipem

JOB No. 032090

PROJECT: SHAH GAS DEVELOPMENT (SGD) PROJECT

AGREEMENT No. 13525001

DRAWING TITLE: PIPING & INSTRUMENT DIAGRAM UNIT 0751
SULPHUR RECOVERY AND TAIL GAS TREATING UNIT

EQUIPMENT DESCRIPTION	DEGASSING CONTACTOR
TAGITEM No.	0751-V-111

CONTRACTOR DRG. No.	751-GD-B-303327	REV. Z1
COMPANY DRG. No.	SR03-0751-00-303327-001	
SCALE:	SIZE: A1	DOC. CLASS: 1

1. FOR STANDARD SYMBOLS, DETAILS, ABBREVIATIONS, SAMPLE CONNECTION TYPE, GENERAL NOTES & LEGEND SHEETS REFER TO DRAWING NO. MP02-0230-00-004000 TO 004015.
2. ALL INSTRUMENT TAG NUMBERS ON THIS P&ID INCLUDING PACKAGE UNITS ARE PREFIXED WITH UNIT NUMBER 0751 UNLESS OTHERWISE NOTED.
3. DELETED.

1. VESSEL TO BE FURNISHED WITH MULTIPLE STEAM JACKET SECTIONS (BETWEEN STIFFENING RINGS) FOR LIQUID FILLED SECTION BELOW 2763 mm OPERATING STEAM JACKETING CONDITIONS ARE 2.4 BARG @ 138°C; FOR VAPOUR FILLED SECTION ABOVE 2763 mm OPERATING CONDITIONS ARE 5 BARG @ 159°C. EACH SECTION WILL HAVE A STEAM CONNECTION, VENT CONNECTION AND A CONDENSATE CONNECTION. REFER TO EQUIPMENT DATA SHEET FOR DETAILS.
2. PI-3187 TO BE READABLE FROM PI-3187 BY-PASS.
3. STEAM TRAP TO BE PROVIDED WITH INTEGRAL INLET STRAINER, OTHERWISE A DEDICATED PIPING STRAINER TO BE INSTALLED UPSTREAM.
4. DELETED.

Z1	20-10-14	IAB	ISSUED FOR AS BUILT	PCA	MAR	A
2.1F	18-04-14	IFC	ISSUED FOR CONSTRUCTION	PCA	MAR	A
2.1E	28-02-14	IFC	ISSUED FOR CONSTRUCTION	PCA	MAR	AS
2.1D	09-03-13	IFC	ISSUED FOR CONSTRUCTION	RL	CN	M
2.1C	31-10-12	IFC	ISSUED FOR CONSTRUCTION	RL	MF	M
2.1B	06-08-12	IFC	ISSUED FOR CONSTRUCTION	DSC	CBR	SI
2	02-12-11	IFC	ISSUED FOR CONSTRUCTION	DSC	CBR	S
1	28-07-11	IFCH	ISSUED FOR CONSTRUCTION WITH HOLDS	DSC	CBR	S
0	15-02-11	IFD	ISSUED CLIENT COMMENTS INCORPORATED	BSC	LMA	SI
B1	30-09-10	ICR	ISSUED FOR CLIENT REVIEW	BSC	LMA	S
REV	DATE	STATUS	STATUS DESCRIPTION	BY	CKD	AP

Abu Dhabi Gas Development Co. Ltd.



PROJECT:


SHAH GAS DEVELOPMENT (SGD) PROJECT

AGREEMENT No. 13525001

DRAWING TITLE: PIPING & INSTRUMENT DIAGRAM UNIT 075
SULPHUR RECOVERY AND TAIL GAS TREATING UNIT

CONTRACTOR DRG No.		751-GD-B-303327	REV. Z1
COMPANY DRG No.		SR03-0751-00-303327-002	
SCALE:	SIZE: A1	DOC. CLASS: 1	


THIS DOCUMENT IS THE PROPERTY OF ABU DHABI GAS DEVELOPMENT COMPANY LIMITED AND CONTAINS INFORMATION WHICH IS PROPRIETARY. THIS INFORMATION IS TO BE HELD IN CONFIDENCE. NO DISCLOSURE OR OTHER USE OF THIS DOCUMENT IS TO BE MADE WITHOUT THE PRIOR WRITTEN CONSENT OF ABU DHABI GAS DEVELOPMENT COMPANY LIMITED.

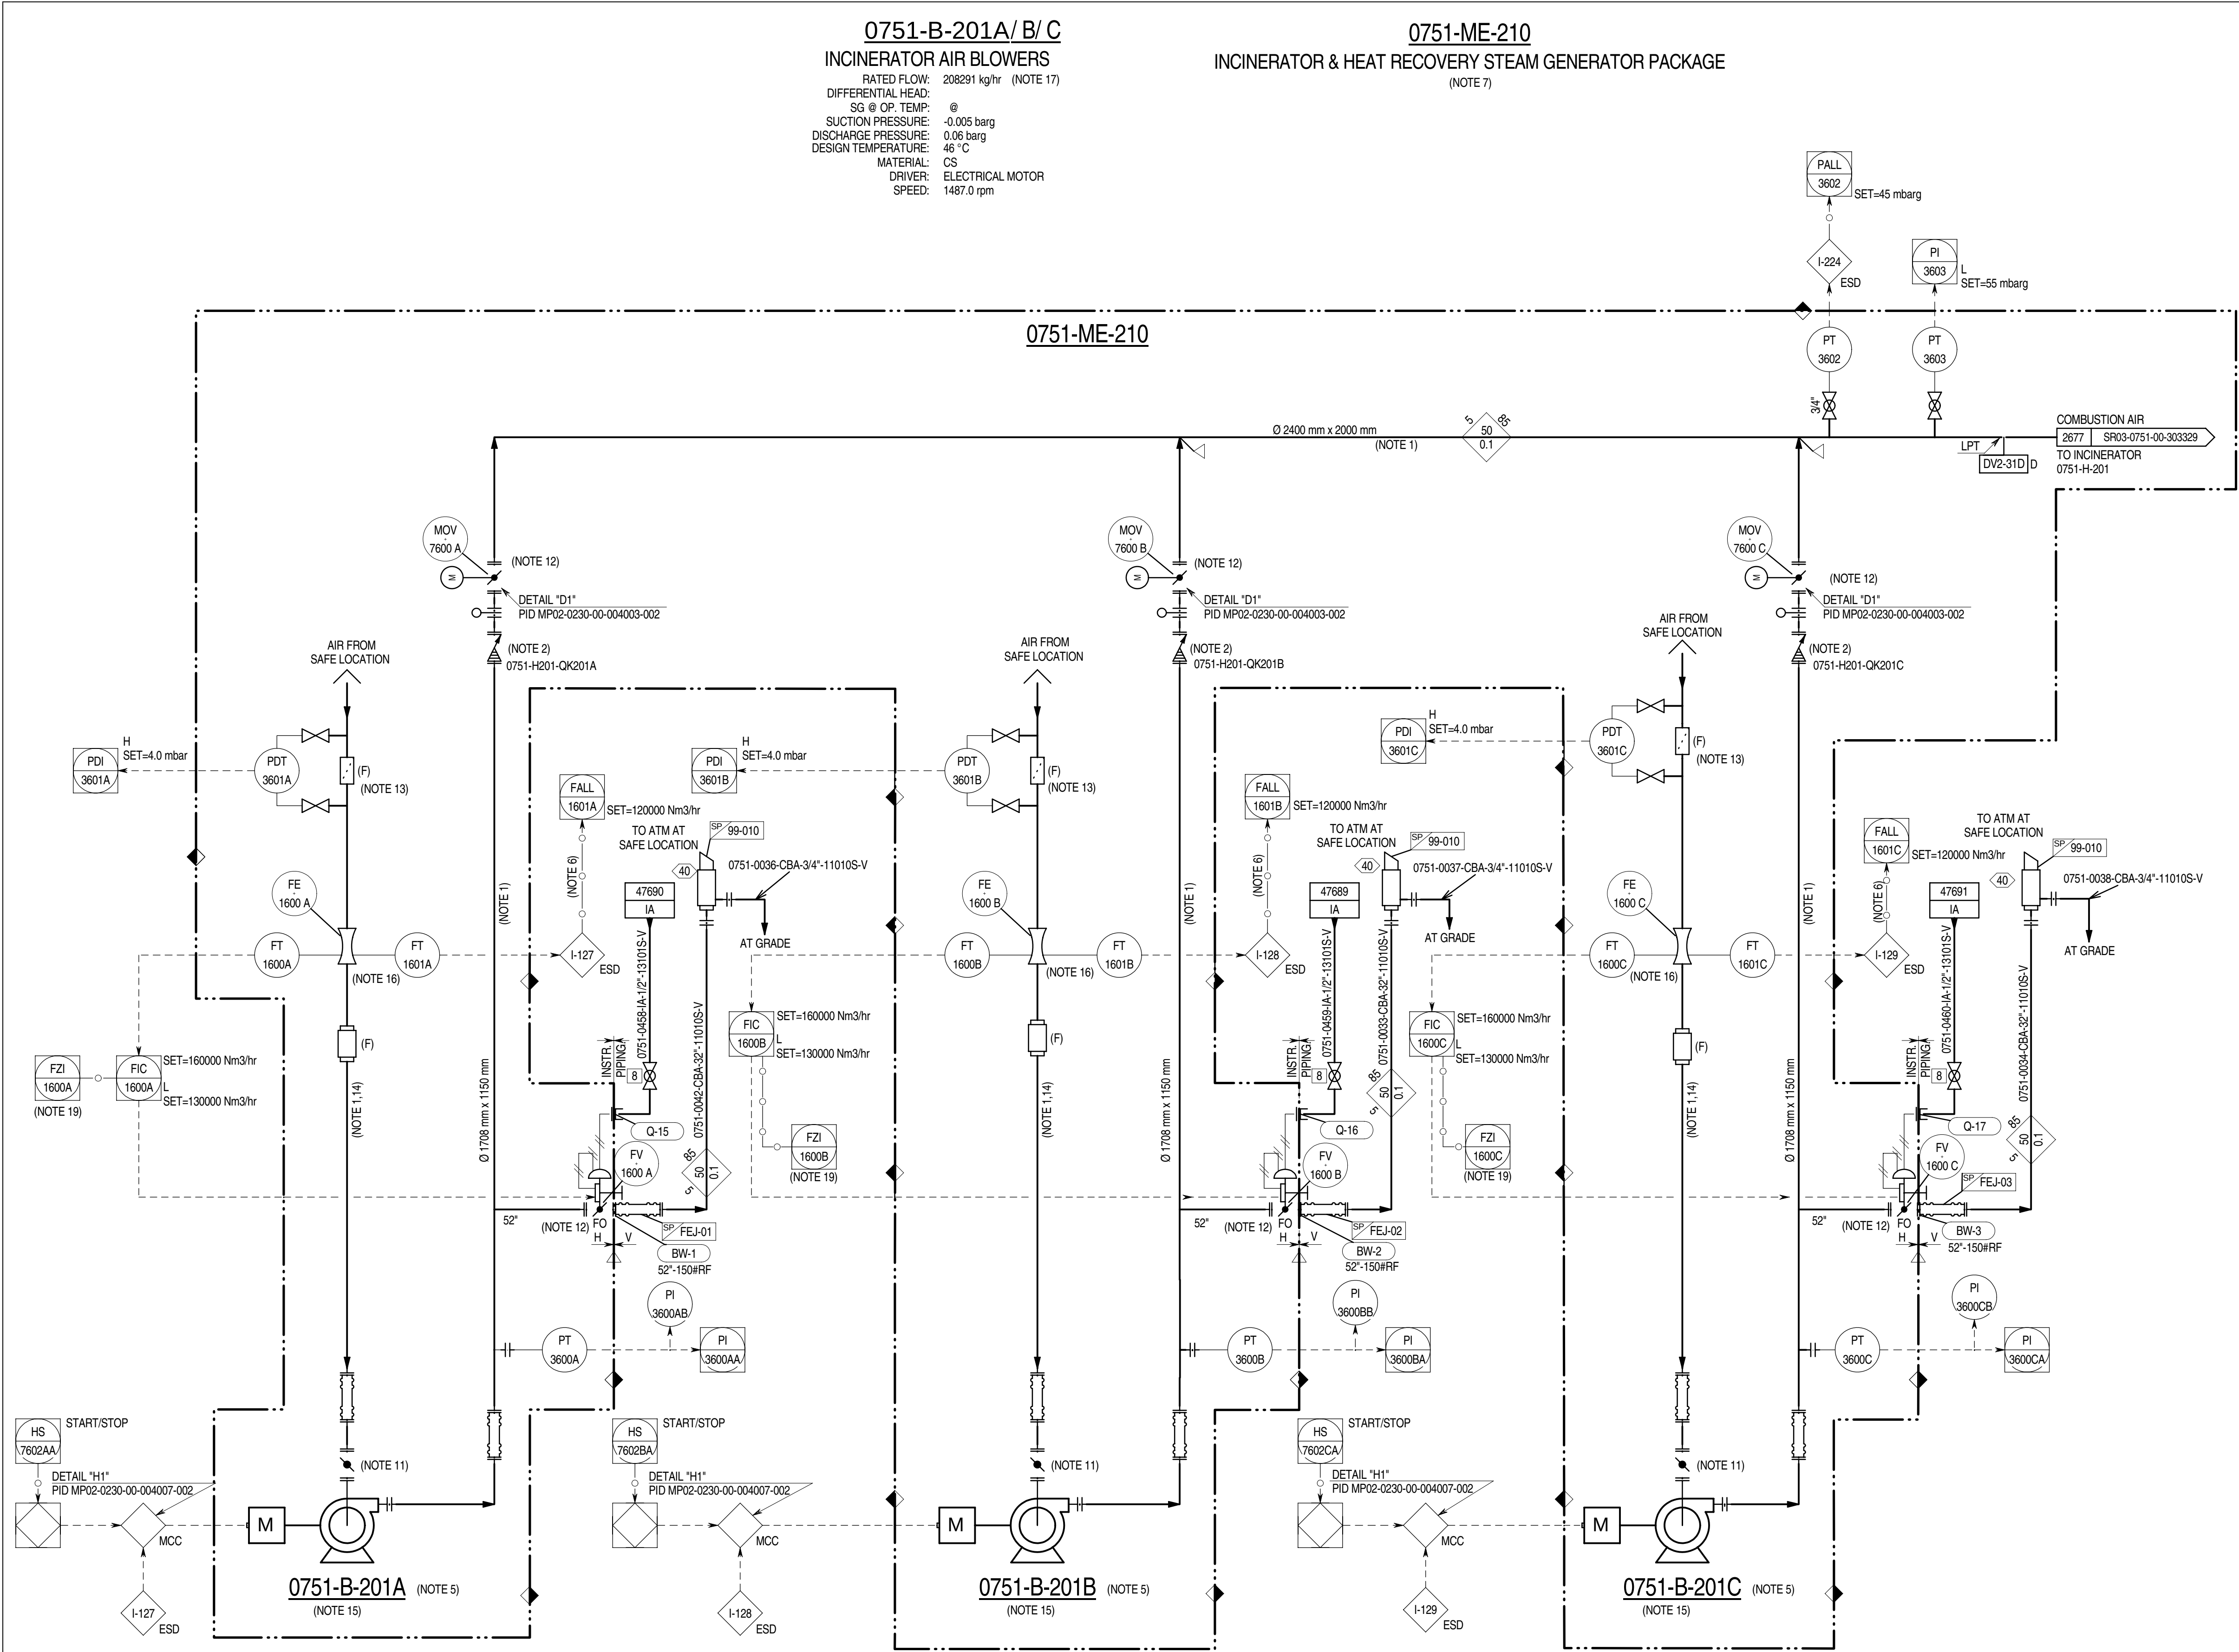

- GENERAL NOTES:**
- FOR STANDARD SYMBOLS, DETAILS, ABBREVIATIONS, SAMPLE CONNECTION TYPE, GENERAL NOTES & LEGEND SHEETS REFER TO DRAWING NO. MP02-0230-00-004000 TO 004015.
 - ALL INSTRUMENT TAG NUMBERS ON THIS P&ID INCLUDING PACKAGE UNITS ARE PREFIXED WITH UNIT NUMBER 0751 UNLESS OTHERWISE NOTED.
 - DELETED.
- NOTES:**
- STEEL WORK AIR DUCTS IS IN VENDOR SCOPE OF SUPPLY.
 - CHECK VALVE TO BE NON-SLAM AND LOW PRESSURE DROP TYPE.
 - INTERLOCK TABLE IS FOR REFERENCE ONLY. CAUSE AND EFFECT MATRIX SR03-0751-00-CCC-303155 SHALL GOVERN.
 - REFER TO CAUSE AND EFFECT CHART FOR FULL REPRESENTATION OF INTERLOCK INITIATORS AND ACTIONS.
 - MACHINE DESIGN SHALL BE 2x50% BLOWERS RUNNING IN PARALLEL DURING NORMAL OPERATION, WITHOUT VENTING THROUGH BLOW-OFF VALVES, WHILE THE THIRD BLOWER WILL BE IN STAND-BY.
 - TRIP BLOWER JUST BEFORE ITS SURGE POINT, SURGE POINT TO BE DETERMINED FROM BLOWER VENDOR.
 - INCINERATOR PACKAGE 0751-ME-210 INCLUDES: 0751-B-201A/B/C, 0751-H-201, 0751-ME-202, 0751-S-201.
 - DELETED.
 - DELETED.
 - DELETED.
 - DELETED.
 - MANUAL IGV VALVE MULTI BLADE TYPE (MANUAL CONTROL). TO BE USED DURING COMMISSIONING PHASE ONLY.
 - SINGLE BLADE TYPE (TOP ORIENTED).
 - SELF CLEANING FILTER (SAND TRAP TYPE).
 - COMBUSTION AIR BLOWER SUCTION FILTER SILENCER TOWER.
 - FOR BLOWER/MOTOR MMS REFER TO VENDOR P&ID'S (P&ID SR0301022-0751-C01376130).
 - AIR FOIL TYPE VENTURI.
 - RATED FLOW IS 110% OF HIGHEST OPERATING CASE FLOW.
 - DELETED.
 - POSITION INDICATOR FROM VALVE POSITIONER (HART)

INTERLOCK TABLE (NOTE 3, 4)		
INTERLOCK NUMBER	LOGIC DESCRIPTION	REFERENCE DOCUMENT N.
I-224	INCINERATOR SECTION	SR03-0751-00-303375
I-127	INCINERATOR AIR BLOWER A	SR03-0751-00-303375
I-128	INCINERATOR AIR BLOWER B	SR03-0751-00-303375
I-129	INCINERATOR AIR BLOWER C	SR03-0751-00-303375

THIS DOCUMENT IS THE PROPERTY OF ABU DHABI GAS DEVELOPMENT COMPANY LIMITED AND CONTAINS INFORMATION WHICH IS PROPRIETARY. THIS INFORMATION IS TO BE HELD IN CONFIDENCE. NO DISCLOSURE OR OTHER USE OF THIS DOCUMENT IS TO BE MADE WITHOUT THE PRIOR WRITTEN CONSENT OF ABU DHABI GAS DEVELOPMENT COMPANY LIMITED.

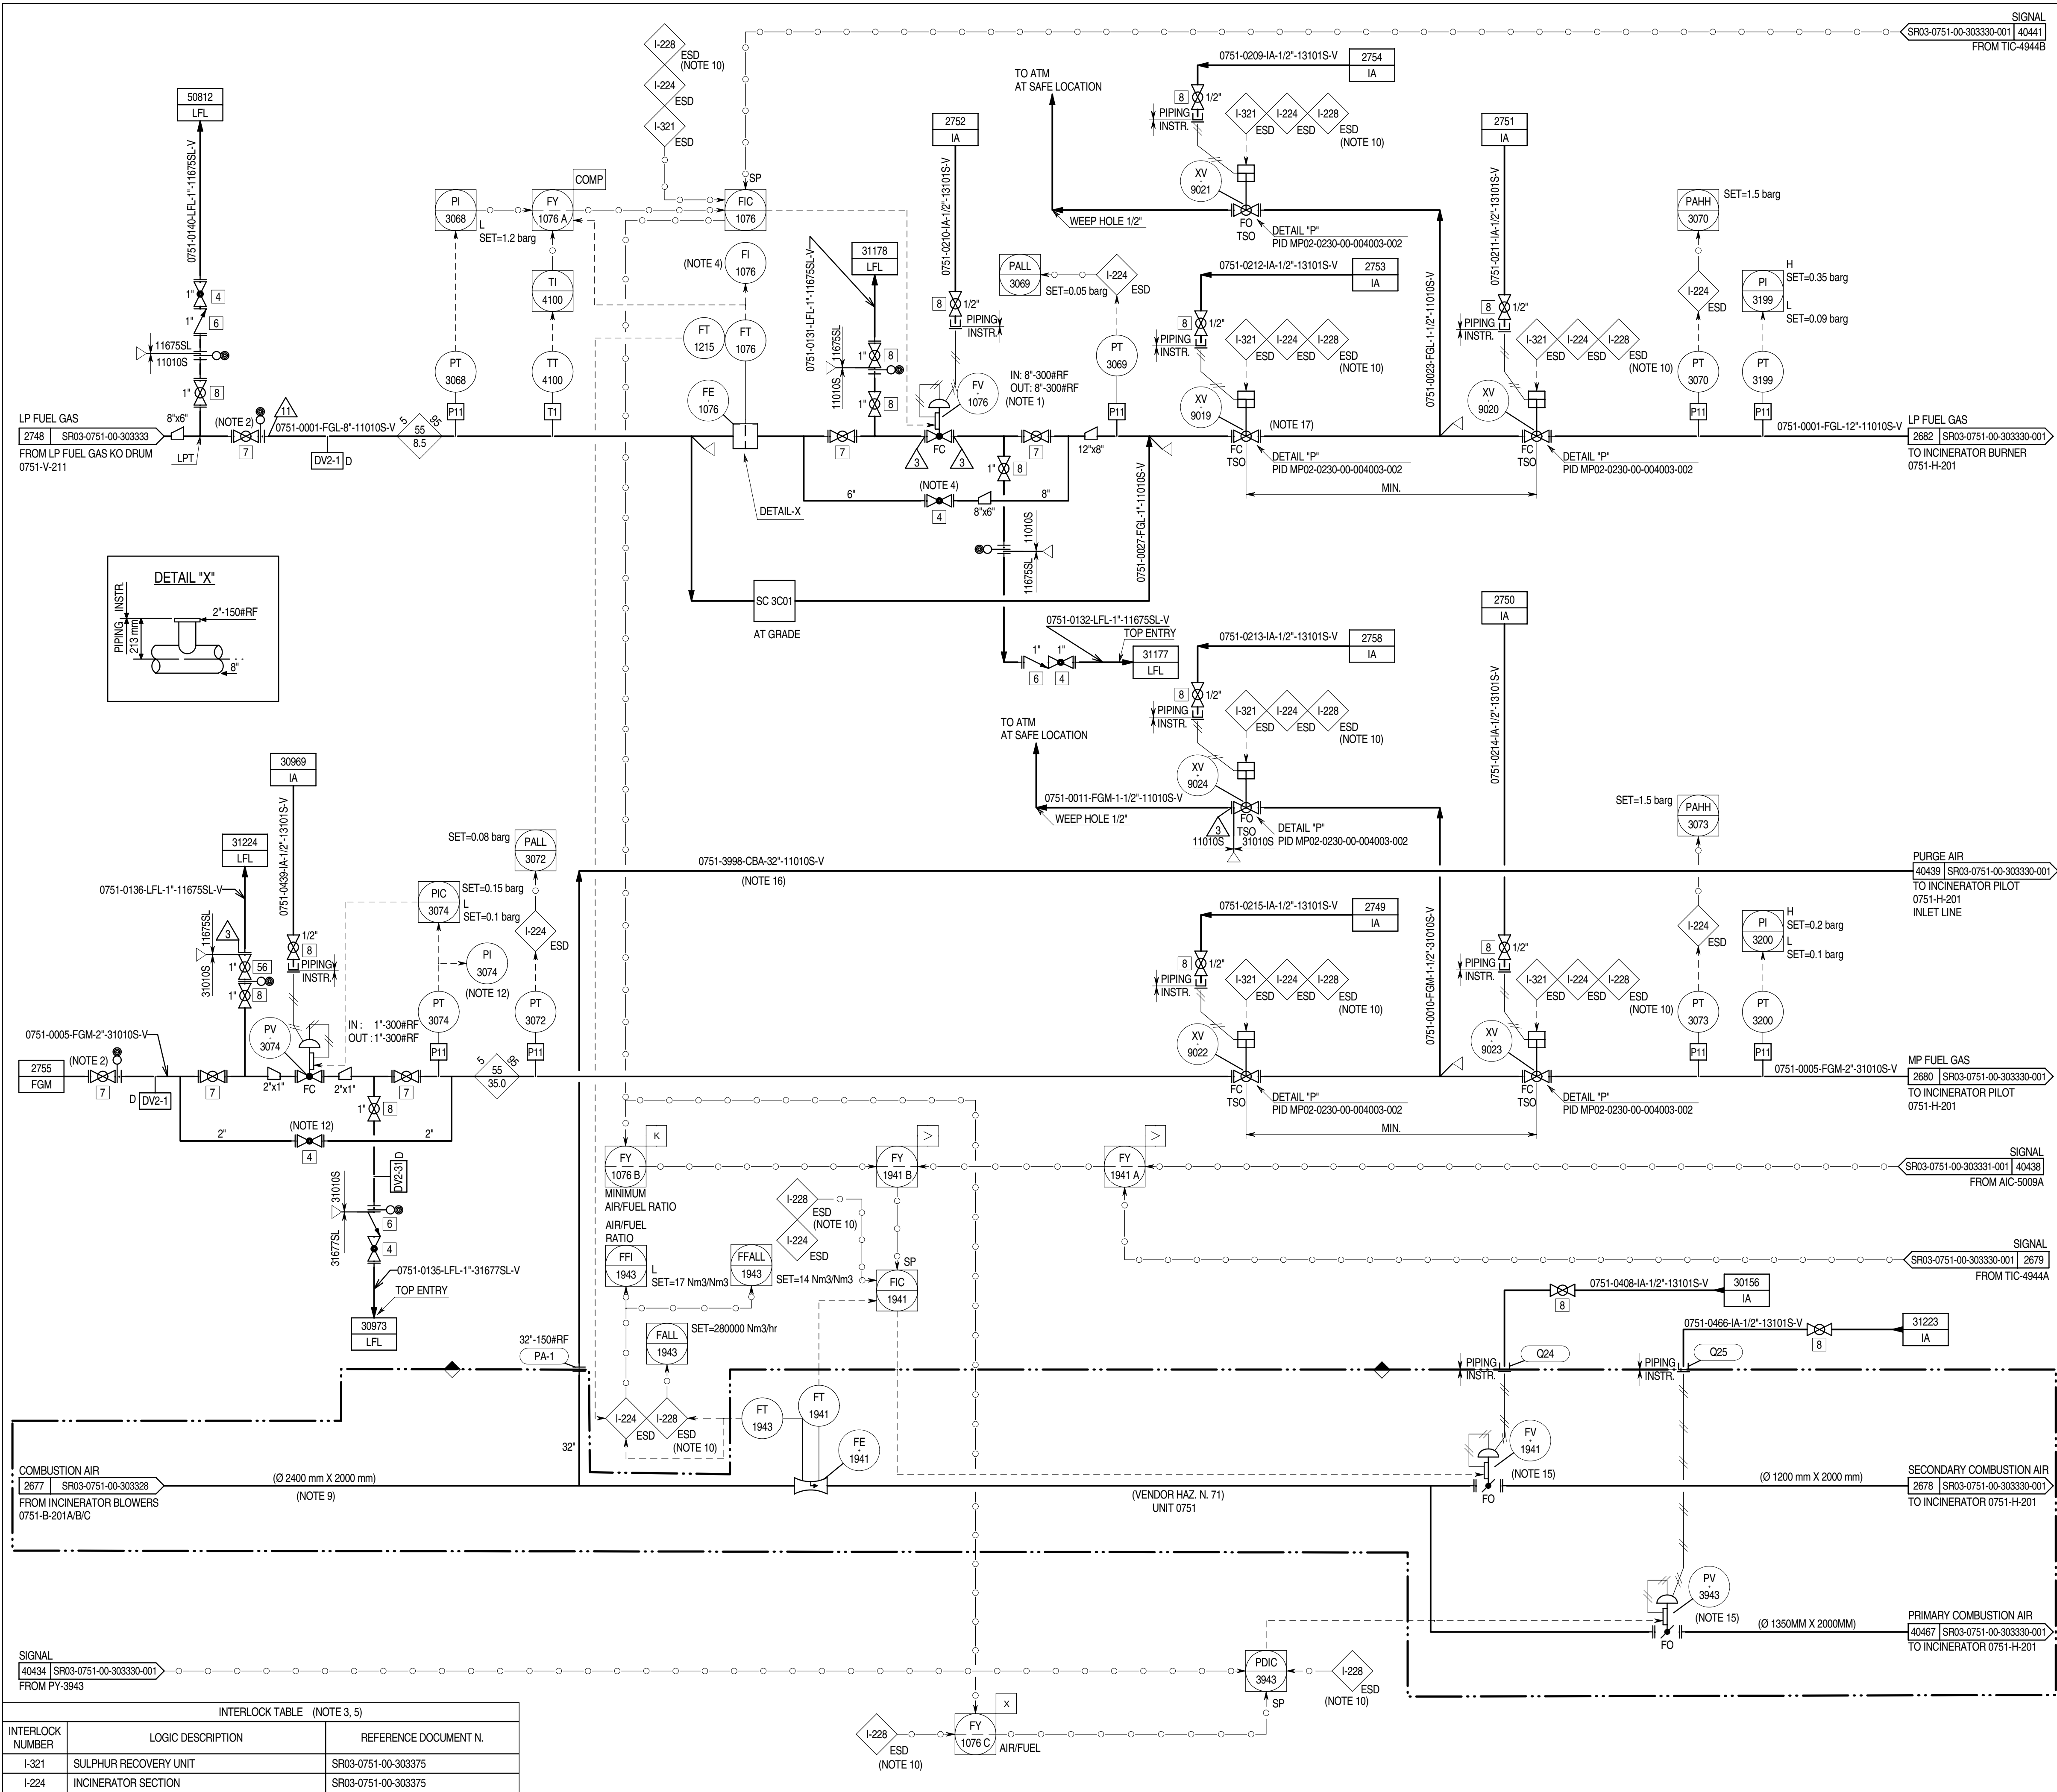

- GENERAL NOTES:**
- FOR STANDARD SYMBOLS, DETAILS, ABBREVIATION, SAMPLE CONNECTION TYPE, GENERAL NOTES & LEGEND SHEETS REFER TO DRAWING NO. MP02-0230-00-004000 TO 004015.
 - ALL INSTRUMENT TAG NUMBERS ON THIS P&ID INCLUDING PACKAGE UNITS ARE PREFIXED WITH UNIT NUMBER 0751 UNLESS OTHERWISE NOTED.
 - DELETED.
- NOTES:**
- VALVE FV-1076 IS EQUIPPED WITH MECHANICAL STOP.
 - LOCATE VALVE AT LEAST 15 m FROM INCINERATOR.
 - INTERLOCK TABLE IS FOR REFERENCE ONLY. CAUSE AND EFFECT MATRIX SR03-0751-00-CCC-303155 SHALL GOVERN.
 - FI-1076 TO BE READABLE FROM FV-1076 BY-PASS VALVE.
 - REFER TO CAUSE AND EFFECT CHART FOR FULL REPRESENTATION OF INTERLOCK INITIATORS AND ACTIONS.
 - DELETED.
 - DELETED.
 - DELETED.
 - STEEL WORK AIR DUCT.
 - SIGNAL TO BE SEGREGATED. REFERENCE TO BE MADE TO INCINERATOR AND HRSG SECTION ESD 0751-I-224/ 0751-I-228 LOGIC SYSTEM DESCRIPTION (DOC. NO SR03-0751-00-SPE-303169).
 - DELETED.
 - PI-3074 TO BE READABLE FROM PV-3074 BY-PASS VALVE.
 - DELETED.
 - DELETED.
 - FV-1941 AND PV-3943 ARE EQUIPPED WITH TECHNICAL STOP TO LIMIT CLOSED POSITION.
 - ENGINEERING ISO'S PROVIDED BY VENDOR MATERIAL SUPPLIES BY SAIPEM.
 - INSTALLED VALVE TAG IS 0754-XV-9019. DUE TO CONSTRUCTION, UNIT 0751 VALVE IS REPLACED WITH THE IDENTICAL ONE FROM UNIT 0754

UTILITY REFERENCE TABLE		
FGM	DRW. N°.	SR03-0751-00-PID-362310
IA	DRW. N°.	SR03-0751-00-PID-362305
LFL	DRW. N°.	SR03-0751-00-PID-362313

Z1	04-11-14	IAB	ISSUED FOR AS BUILT	PCA	MAR	ASP
2.1D	18-04-14	IFC	ISSUED FOR CONSTRUCTION	PCA	MAF	ASP
2.1C	28-02-14	IFC	ISSUED FOR CONSTRUCTION	PCA	MAR	ASP
2.1B	06-08-12	IFC	ISSUED FOR CONSTRUCTION	DSC	CBR	SIN
2	29-12-11	IFC	ISSUED FOR CONSTRUCTION	DSC	CBR	SIN
1	12-08-11	IFCH	ISSUED FOR CONSTRUCTION WITH HOLDS	DSC	CBR	SIN
0	06-03-11	IFD	ISSUED CLIENT COMMENTS INCORPORATED	BSC	LMA	SIN
B1	30-09-10	ICR	ISSUED FOR CLIENT REVIEW	BSC	LMA	SIN
REV	DATE	STATUS	STATUS DESCRIPTION	BY	CKD	APP.

COMPANY:

Abu Dhabi Gas Development Co. Ltd.



CONTRACTOR:



JOB No. 032090

PROJECT: SHAH GAS DEVELOPMENT (SGD) PROJECT

AGREEMENT No. 13525001


DRAWING TITLE: PIPING & INSTRUMENT DIAGRAM UNIT 0751
SULPHUR RECOVERY AND TAIL GAS TREATING UNIT

EQUIPMENT DESCRIPTION	INCINERATOR CONTROLS
TAGITEM No.	

CONTRACTOR DRG. No.	751-GD-B-303329	REV. Z1
COMPANY DRG. No.	SR03-0751-00-303329	
SCALE:	SIZE: A1 DOC. CLASS: 1	


THIS DOCUMENT IS THE PROPERTY OF ABU DHABI GAS DEVELOPMENT COMPANY LIMITED AND CONTAINS INFORMATION WHICH IS PROPRIETARY. THIS INFORMATION IS TO BE HELD IN CONFIDENCE. NO DISCLOSURE OR OTHER USE OF THIS DOCUMENT IS TO BE MADE WITHOUT THE PRIOR WRITTEN CONSENT OF ABU DHABI GAS DEVELOPMENT COMPANY LIMITED.

- GENERAL NOTES:**
- FOR STANDARD SYMBOLS, DETAILS, ABBREVIATIONS, SAMPLE CONNECTION TYPE, GENERAL NOTES & LEGEND SHEETS REFER TO DRAWING NO. MP02-0230-00-004000 TO 004015.
 - ALL INSTRUMENT TAG NUMBERS ON THIS P&ID INCLUDING PACKAGE UNITS ARE PREFIXED WITH UNIT NUMBER 0751 UNLESS OTHERWISE NOTED.
 - DELETED.

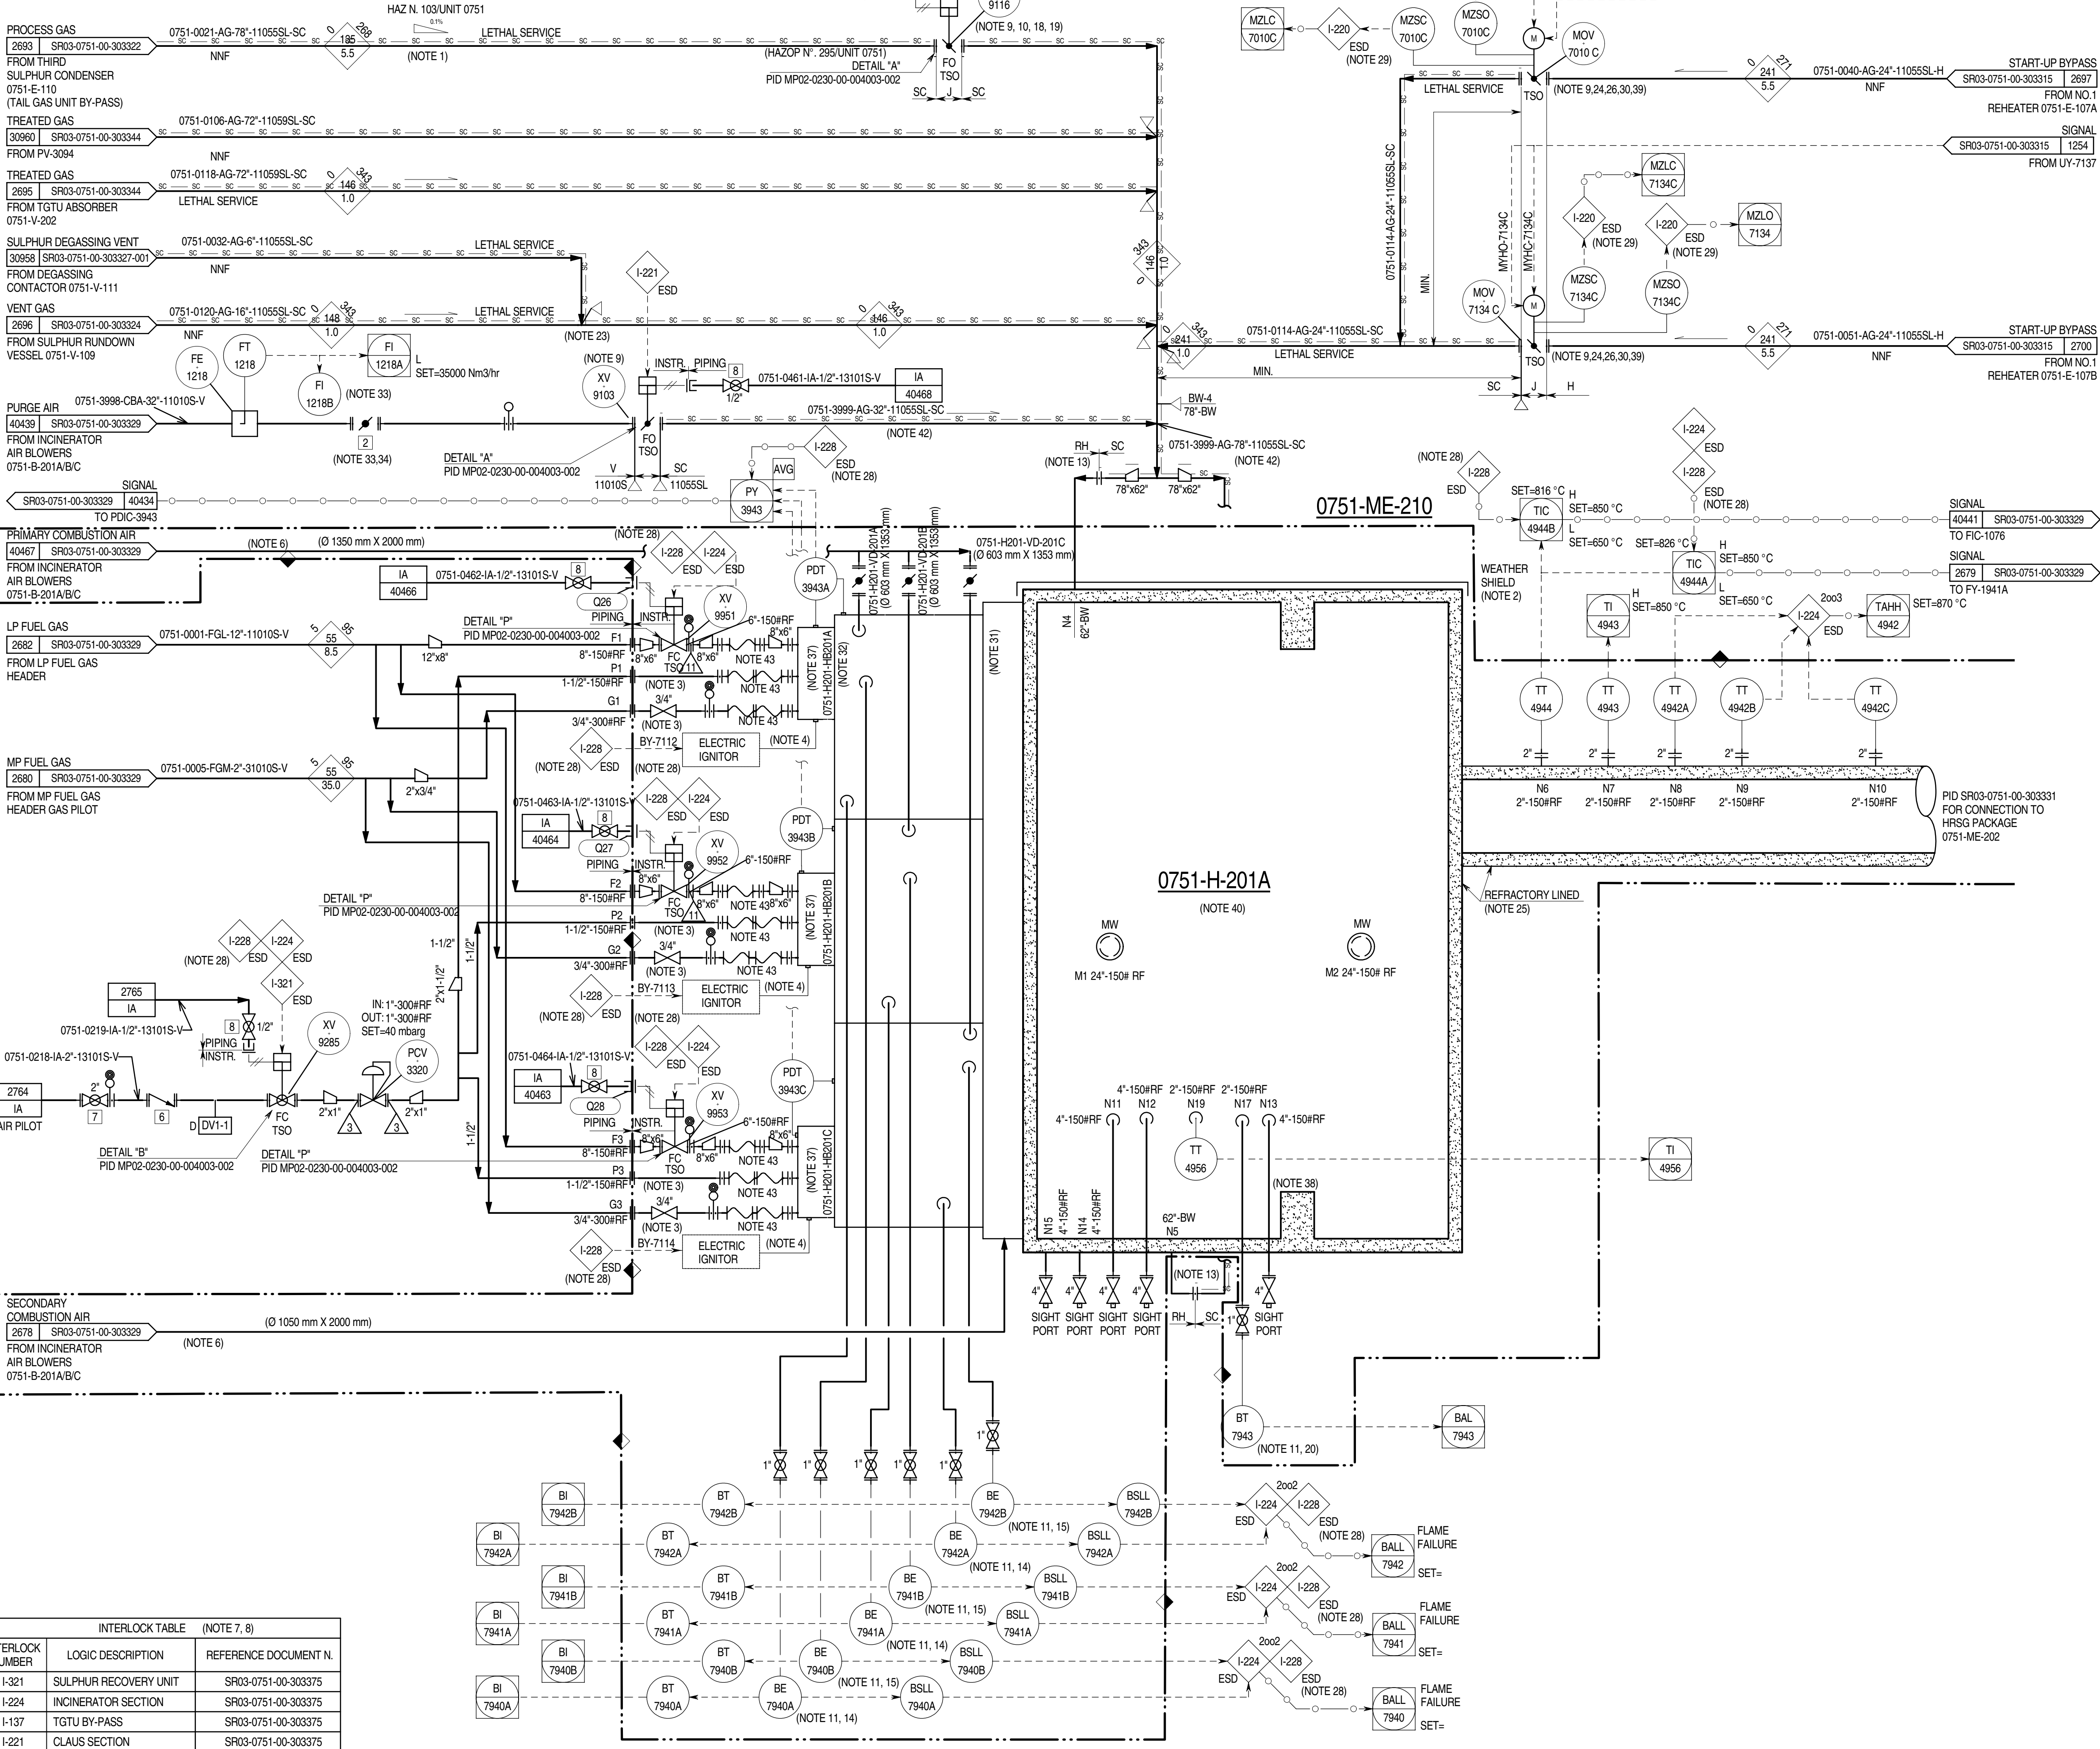

THIS DOCUMENT IS THE PROPERTY OF ABU DHABI GAS DEVELOPMENT COMPANY LIMITED AND CONTAINS INFORMATION WHICH IS PROPRIETARY. THIS INFORMATION IS TO BE HELD IN CONFIDENCE. NO DISCLOSURE OR OTHER USE OF THIS DOCUMENT IS TO BE MADE WITHOUT THE PRIOR WRITTEN CONSENT OF ABU DHABI GAS DEVELOPMENT COMPANY LIMITED.

INTERLOCK TABLE (NOTE 2,3)		
INTERLOCK NUMBER	LOGIC DESCRIPTION	REFERENCE DOC. NO.
I-224	INCINERATOR SECTION	SR03-0751-00-303375
I-221	CLAUS SECTION	SR03-0751-00-303375

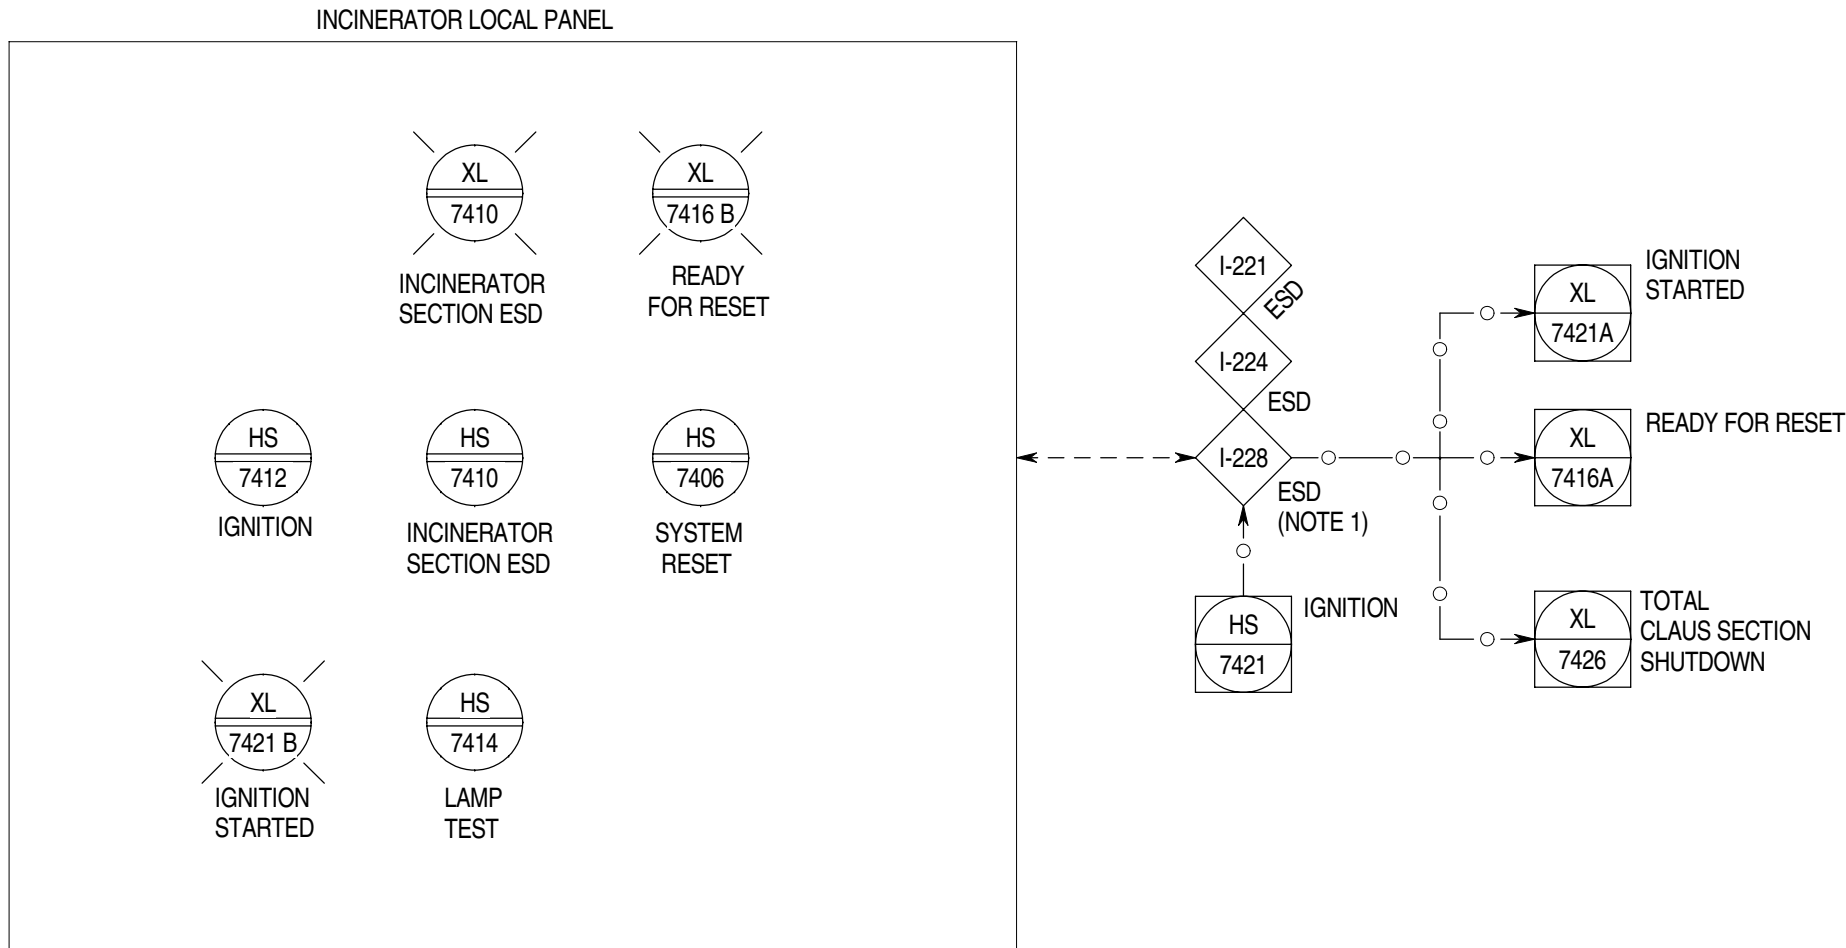

- GENERAL NOTES:**
- FOR STANDARD SYMBOLS, DETAILS, ABBREVIATIONS, SAMPLE CONNECTION TYPE, GENERAL NOTES & LEGEND SHEETS REFER TO DRAWING NO. MP02-0230-00-004000 TO 004015.
 - ALL INSTRUMENT TAG NUMBERS ON THIS P&ID INCLUDING PACKAGE UNITS ARE PREFIXED WITH UNIT NUMBER 0751 UNLESS OTHERWISE NOTED.
 - DELETED.
- NOTES:**
- SIGNAL TO BE SEGREGATED. REFERENCE TO BE MADE TO INCINERATOR AND HRSS SECTION ESD 0751-I-224/0751-I-228 LOGIC SYSTEM DESCRIPTION, DOCUMENT NO. SR03-0751-00-SPE-303169.
 - INTERLOCK TABLE IS FOR REFERENCE ONLY. CAUSE AND EFFECT MATRIX SR03-0751-00-CCC-303155 SHALL GOVERN.
 - REFERENCE TO CAUSE AND EFFECT CHART FOR FULL REPRESENTATION OF INTERLOCK INITIATORS AND ACTIONS.

Z1	04-11-14	IAB	ISSUED FOR AS BUILT	PCA	MAR	ASP
2.1E	18-04-14	IFC	ISSUED FOR CONSTRUCTION	PCA	MAR	ASP
2.1D	01-05-13	IFC	ISSUED FOR CONSTRUCTION	RL	CN	MZ
2.1C	31-10-12	IFC	ISSUED FOR CONSTRUCTION	RL	MF	MZ
2.1B	06-08-12	IFC	ISSUED FOR CONSTRUCTION	DSC	CBR	SIN
2	29-12-11	IFC	ISSUED FOR CONSTRUCTION	DSC	CBR	SIN
1	12-08-11	IFCH	ISSUED FOR CONSTRUCTION WITH HOLDS	DSC	CBR	SIN
0	06-03-11	IFD	ISSUED CLIENT COMMENTS INCORPORATED	BSC	LMA	SIN
B1	30-09-10	ICR	ISSUED FOR CLIENT REVIEW	BSC	LMA	SIN
REV	DATE	STATUS	STATUS DESCRIPTION	BY	CKD	APP.

COMPANY:

Abu Dhabi Gas Development Co. Ltd.

CONTRACTOR:

JOB No. 032090

PROJECT: SHAH GAS DEVELOPMENT (SGD) PROJECT

AGREEMENT No. 13525001


DRAWING TITLE: PIPING & INSTRUMENT DIAGRAM UNIT 0751 SULPHUR RECOVERY AND TAIL GAS TREATING UNIT

EQUIPMENT DESCRIPTION	INCINERATOR LOCAL PANEL
TAGITEM No.	

CONTRACTOR DRG.No.	751-GD-B-303330	REV. Z1
COMPANY DRG.No.	SR03-0751-00-303330-002	
SCALE:	SIZE: A1 DOC. CLASS: 1	

THIS DOCUMENT IS THE PROPERTY OF ABU DHABI GAS DEVELOPMENT COMPANY LIMITED AND CONTAINS INFORMATION WHICH IS PROPRIETARY. THIS INFORMATION IS TO BE HELD IN CONFIDENCE. NO DISCLOSURE OR OTHER USE OF THIS DOCUMENT IS TO BE MADE WITHOUT THE PRIOR WRITTEN CONSENT OF ABU DHABI GAS DEVELOPMENT COMPANY LIMITED.

0751-ME-210
INCINERATOR & HEAT RECOVERY STEAM GENERATOR PACKAGE
(NOTE 1)

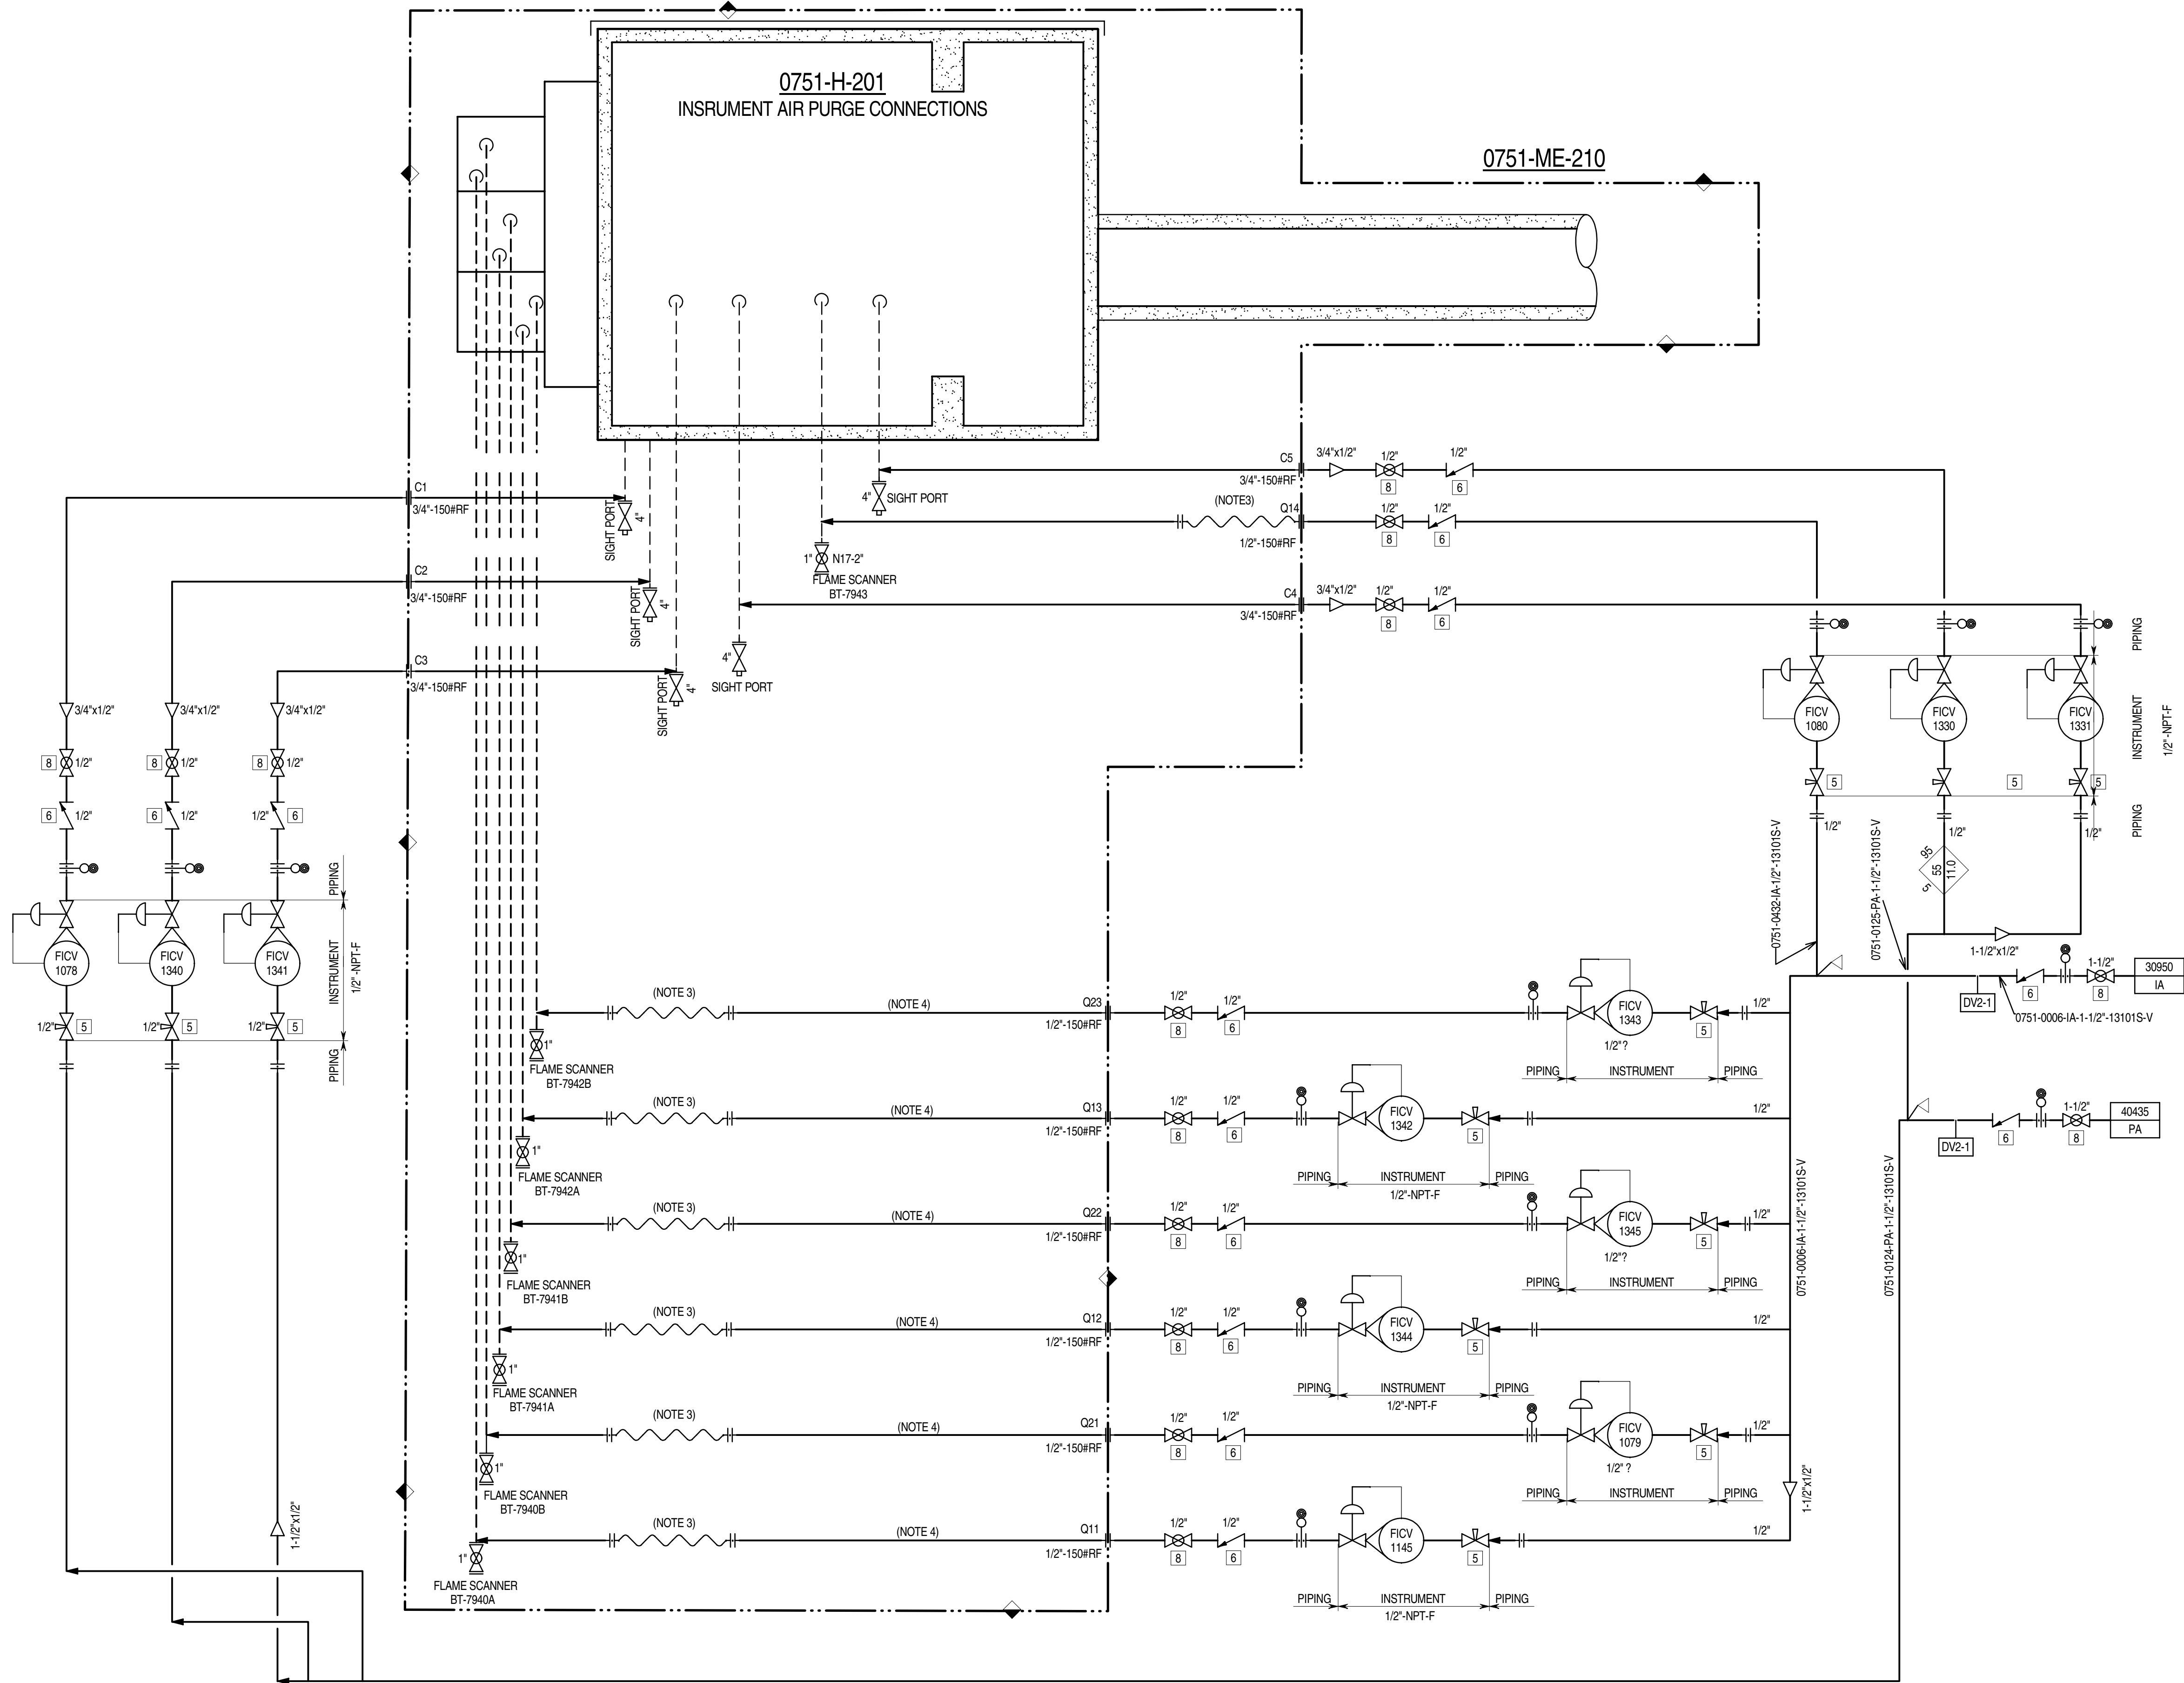

- GENERAL NOTES:**
- FOR STANDARD SYMBOLS, DETAILS, ABBREVIATIONS, SAMPLE CONNECTION TYPE, GENERAL NOTES & LEGEND SHEETS REFER TO DRAWING NO. MP02-0230-00-004000 TO 004015.
 - ALL INSTRUMENT TAG NUMBERS ON THIS P&ID INCLUDING PACKAGE UNITS ARE PREFIXED WITH UNIT NUMBER 0751 UNLESS OTHERWISE NOTED.
 - DELETED.
- NOTES:**
- INCINERATOR PACKAGE 0751-ME-210 INCLUDES: 0751-B-201A/B/C, 0751-H-201, 0751-ME-202, 0751-S-201.
 - DELETED.
 - FLEXIBLE CONNECTION.
 - DROP OUT PIPE SPOOL FOR BURNER REMOVAL.

UTILITY REFERENCE TABLE		
PA	DRW. N°.	SR03-0751-00-PID-362314
IA	DRW. N°.	SR03-0751-00-PID-362305

Z1	04-11-14	IAB	ISSUED FOR AS BUILT	PCA	MAR	ASP
2.1E	18-04-14	IFC	ISSUED FOR CONSTRUCTION	PCA	MAR	ASP
2.1D	01-05-13	IFC	ISSUED FOR CONSTRUCTION	RL	CN	MZ
2.1C	31-10-12	IFC	ISSUED FOR CONSTRUCTION	RL	MF	MZ
2.1B	06-08-12	IFC	ISSUED FOR CONSTRUCTION	DSC	CBR	SIN
2	29-12-11	IFC	ISSUED FOR CONSTRUCTION	DSC	CBR	SIN
1	12-08-11	IFCH	ISSUED FOR CONSTRUCTION WITH HOLDS	DSC	CBR	SIN
REV	DATE	STATUS	STATUS DESCRIPTION	BY	CKD	APP.

COMPANY:

Abu Dhabi Gas Development Co. Ltd.

CONTRACTOR:

JOB No. 032090

PROJECT: SHAH GAS DEVELOPMENT (SGD) PROJECT

AGREEMENT No. 13525001

DRAWING TITLE: PIPING & INSTRUMENT DIAGRAM UNIT 0751 SULPHUR RECOVERY AND TAIL GAS TREATING UNIT

EQUIPMENT DESCRIPTION	INCINERATOR PURGE SYSTEM
TAGITEM No.	

CONTRACTOR DRG.No.	751-GD-B-303330	REV. Z1
COMPANY DRG.No.	SR03-0751-00-303330-003	
SCALE:	SIZE: A1	DOC. CLASS: 1

0751-ME-202
HRSG PACKAGE

DUTY: 82200 Mcal/hr
DESIGN CONDITIONS: 49 barg @ 5/546 C & FV @ 100 c

0751-ME-210
INCINERATOR & HEAT RECOVERY STEAM GENERATOR PACKAGE
(NOTE 10)

0751-S-201
INCINERATOR STACK

MATERIAL: CS-3mm CA / SS (3m TO TOP OF STACK)
SIZE: 5.5 m (DIA) 60.0 m (HGT.)
DESIGN CONDITIONS: 5 / 343 (METAL)
INSULATION: REFRACTORY LINED

GENERAL NOTES:

- FOR STANDARD SYMBOLS, DETAILS, ABBREVIATIONS, SAMPLE CONNECTION TYPE, GENERAL NOTES & LEGEND SHEETS REFER TO DRAWING NO. MP02-0230-00-004000 TO 004015.
 - ALL INSTRUMENT TAG NUMBERS ON THIS P&ID INCLUDING PACKAGE UNITS ARE PREFIXED WITH UNIT NUMBERS 0751 UNLESS OTHERWISE NOTED.
 - DELETED.
- NOTES:
- DELETED.
 - LOCATE FOUR SAMPLE CONNECTIONS AT THE SAME ELEVATION 90° APART.
 - ENTER AT STACK BOTTOM.
 - CONNECTION TO INCLUDE REFRACTORY-LINED ELBOW TO PROTECT VENT PIPE FROM RADIANT HEAT (VENDOR SCOPE OF SUPPLY).
 - DELETED.
 - DELETED.
 - LI-2940 AND FI-1083 TO BE READABLE FROM FV-1083 BY-PASS VALVE.
 - FI-1082 TO BE READABLE FROM FV-1082 BY-PASS VALVE.
 - INTERLOCK TABLE IS FOR REFERENCE ONLY. CAUSE AND EFFECT MATRIX SR03-0751-00-CCC-303155 SHALL GOVERN.
 - INCINERATOR PACKAGE 0751-ME-210 INCLUDES: 0751-B-201A/B/C, 0751-H-201, 0751-ME-202, 0751-S-201.
 - REFER TO CAUSE AND EFFECT CHART FOR FULL REPRESENTATION OF INTERLOCK INITIATORS AND ACTIONS.
 - DELETED.
 - CEMS (CONTINUOUS EMISSION MONITORING SYSTEM).
 - COMBINE LINES AS CLOSE AS POSSIBLE TO SOURCES TO MINIMIZE DUAL PIPING RUNS.
 - STRAINER WITH SCREEN 20 MESH.
 - AT LOW LEVEL, L2 (LY-2940B) THE DCS LOGIC WILL PUT THE FLOW CONTROLLER OF CONTINUOUS BLOWDOWN ON MANUAL MODE AND WILL FORCE ITS OUTPUT TO 0%, CLOSING FV-1083.
 - AS THE LEVEL RAISES TO L1 (LY-2940B), AN ALARM WILL SOUND AND OPERATOR WILL PLACE THE BLOWDOWN FLOW CONTROLLER BACK IN AUTO.
 - SEE DATA SHEET FOR REFRACTORY LINING DETAIL.
 - DELETED.
 - VALVE FV-1083 TO BE PROVIDED WITH LOCAL SIGN: "WARNING: TRIM SIZE AFFECTS RELIEF VALVE CAPACITY".
 - DELETED.
 - BOTH XV-9050 AND XV-9075 SHALL BE KEPT OPEN IN NORMAL OPERATION (VENDOR HAZ. N. 10/UNIT 0751).
 - SEE TABLE FOR 1 FOR THE LIST OF SIGNALS CONNECTED TO FY-1177. FOR DETAILS REFER TO PROCESS CONTROL NARRATIVE DOC. NO. SR03-0751-00-SPE-303163.
 - DELETED.
 - SEAM TRAP TO BE PROVIDED WITH INTEGRAL INLET STRAINER, OTHERWISE A DEDICATED PIPING STRAINER TO BE INSTALLED UPSTREAM.
 - IF THE HS-7087 IS SELECTED AS "1 ELEMENT":
 - CONTROLLER LIC-2940B IS REGULATING.IF THE HS-7087 IS SELECTED AS "3 ELEMENT":
 - CONTROLLERS LIC-2940A AND FIC-1082 ARE REGULATING;
 - CONTROLLER LIC-2940B OUTPUT IS IN TRACKING.

UTILITY REFERENCE TABLE			
BBD	DRW. N°:	SR03-0751-00-PID-362303	
BFW	DRW. N°:	SR03-0751-00-PID-362304	
IA	DRW. N°:	SR03-0751-00-PID-362305	
OD	DRW. N°:	SR03-0751-00-PID-362307	
STH	DRW. N°:	SR03-0751-00-PID-362312	

Z1	04-11-14	IAB	ISSUED FOR AS BUILT	PCA	MAR	ASP
2.1E	18-04-14	IFC	ISSUED FOR CONSTRUCTION	PCA	MAR	ASP
2.1D	28-02-14	IFC	ISSUED FOR CONSTRUCTION	PCA	MAR	ASP
2.1C	10-03-13	IFC	ISSUED FOR CONSTRUCTION	RL	CN	MZ
2.1B	06-08-12	IFC	ISSUED FOR CONSTRUCTION	DSC	CBR	SIN
2	29-12-11	IFC	ISSUED FOR CONSTRUCTION	DSC	CBR	SIN
1	12-08-11	IFCH	ISSUED FOR CONSTRUCTION WITH HOLDS	DSC	CBR	SIN
0	06-03-11	IFD	ISSUED CLIENT COMMENTS INCORPORATED	BSC	LMA	SIN
B1	30-09-10	ICR	ISSUED FOR CLIENT REVIEW	BSC	LMA	SIN
REV	DATE	STATUS	STATUS DESCRIPTION	BY	CKD	APP.

COMPANY:

Abu Dhabi Gas Development Co. Ltd.

الحصن للغاز
Al Hosn Gas

CONTRACTOR:

eni saipem

JOB No. 032090

PROJECT:

SHAH GAS DEVELOPMENT (SGD) PROJECT


AGREEMENT No. 13525001

DRAWING TITLE: PIPING & INSTRUMENT DIAGRAM UNIT 0751
SULPHUR RECOVERY AND TAIL GAS TREATING UNIT

EQUIPMENT DESCRIPTION	HRSG PACKAGE AND STACK
TAGITEM No.	0751-S-201

CONTRACTOR DRG. No.	751-GD-B-303331	REV. Z1
COMPANY DRG. No.	SR03-0751-00-303331-001	
SCALE:	SIZE: A1	DOC. CLASS: 1


THIS DOCUMENT IS THE PROPERTY OF ABU DHABI GAS DEVELOPMENT COMPANY LIMITED. NO DISCLOSURE OR OTHER USE OF THIS DOCUMENT IS TO BE MADE WITHOUT THE PRIOR WRITTEN CONSENT OF ABU DHABI GAS DEVELOPMENT COMPANY LIMITED.

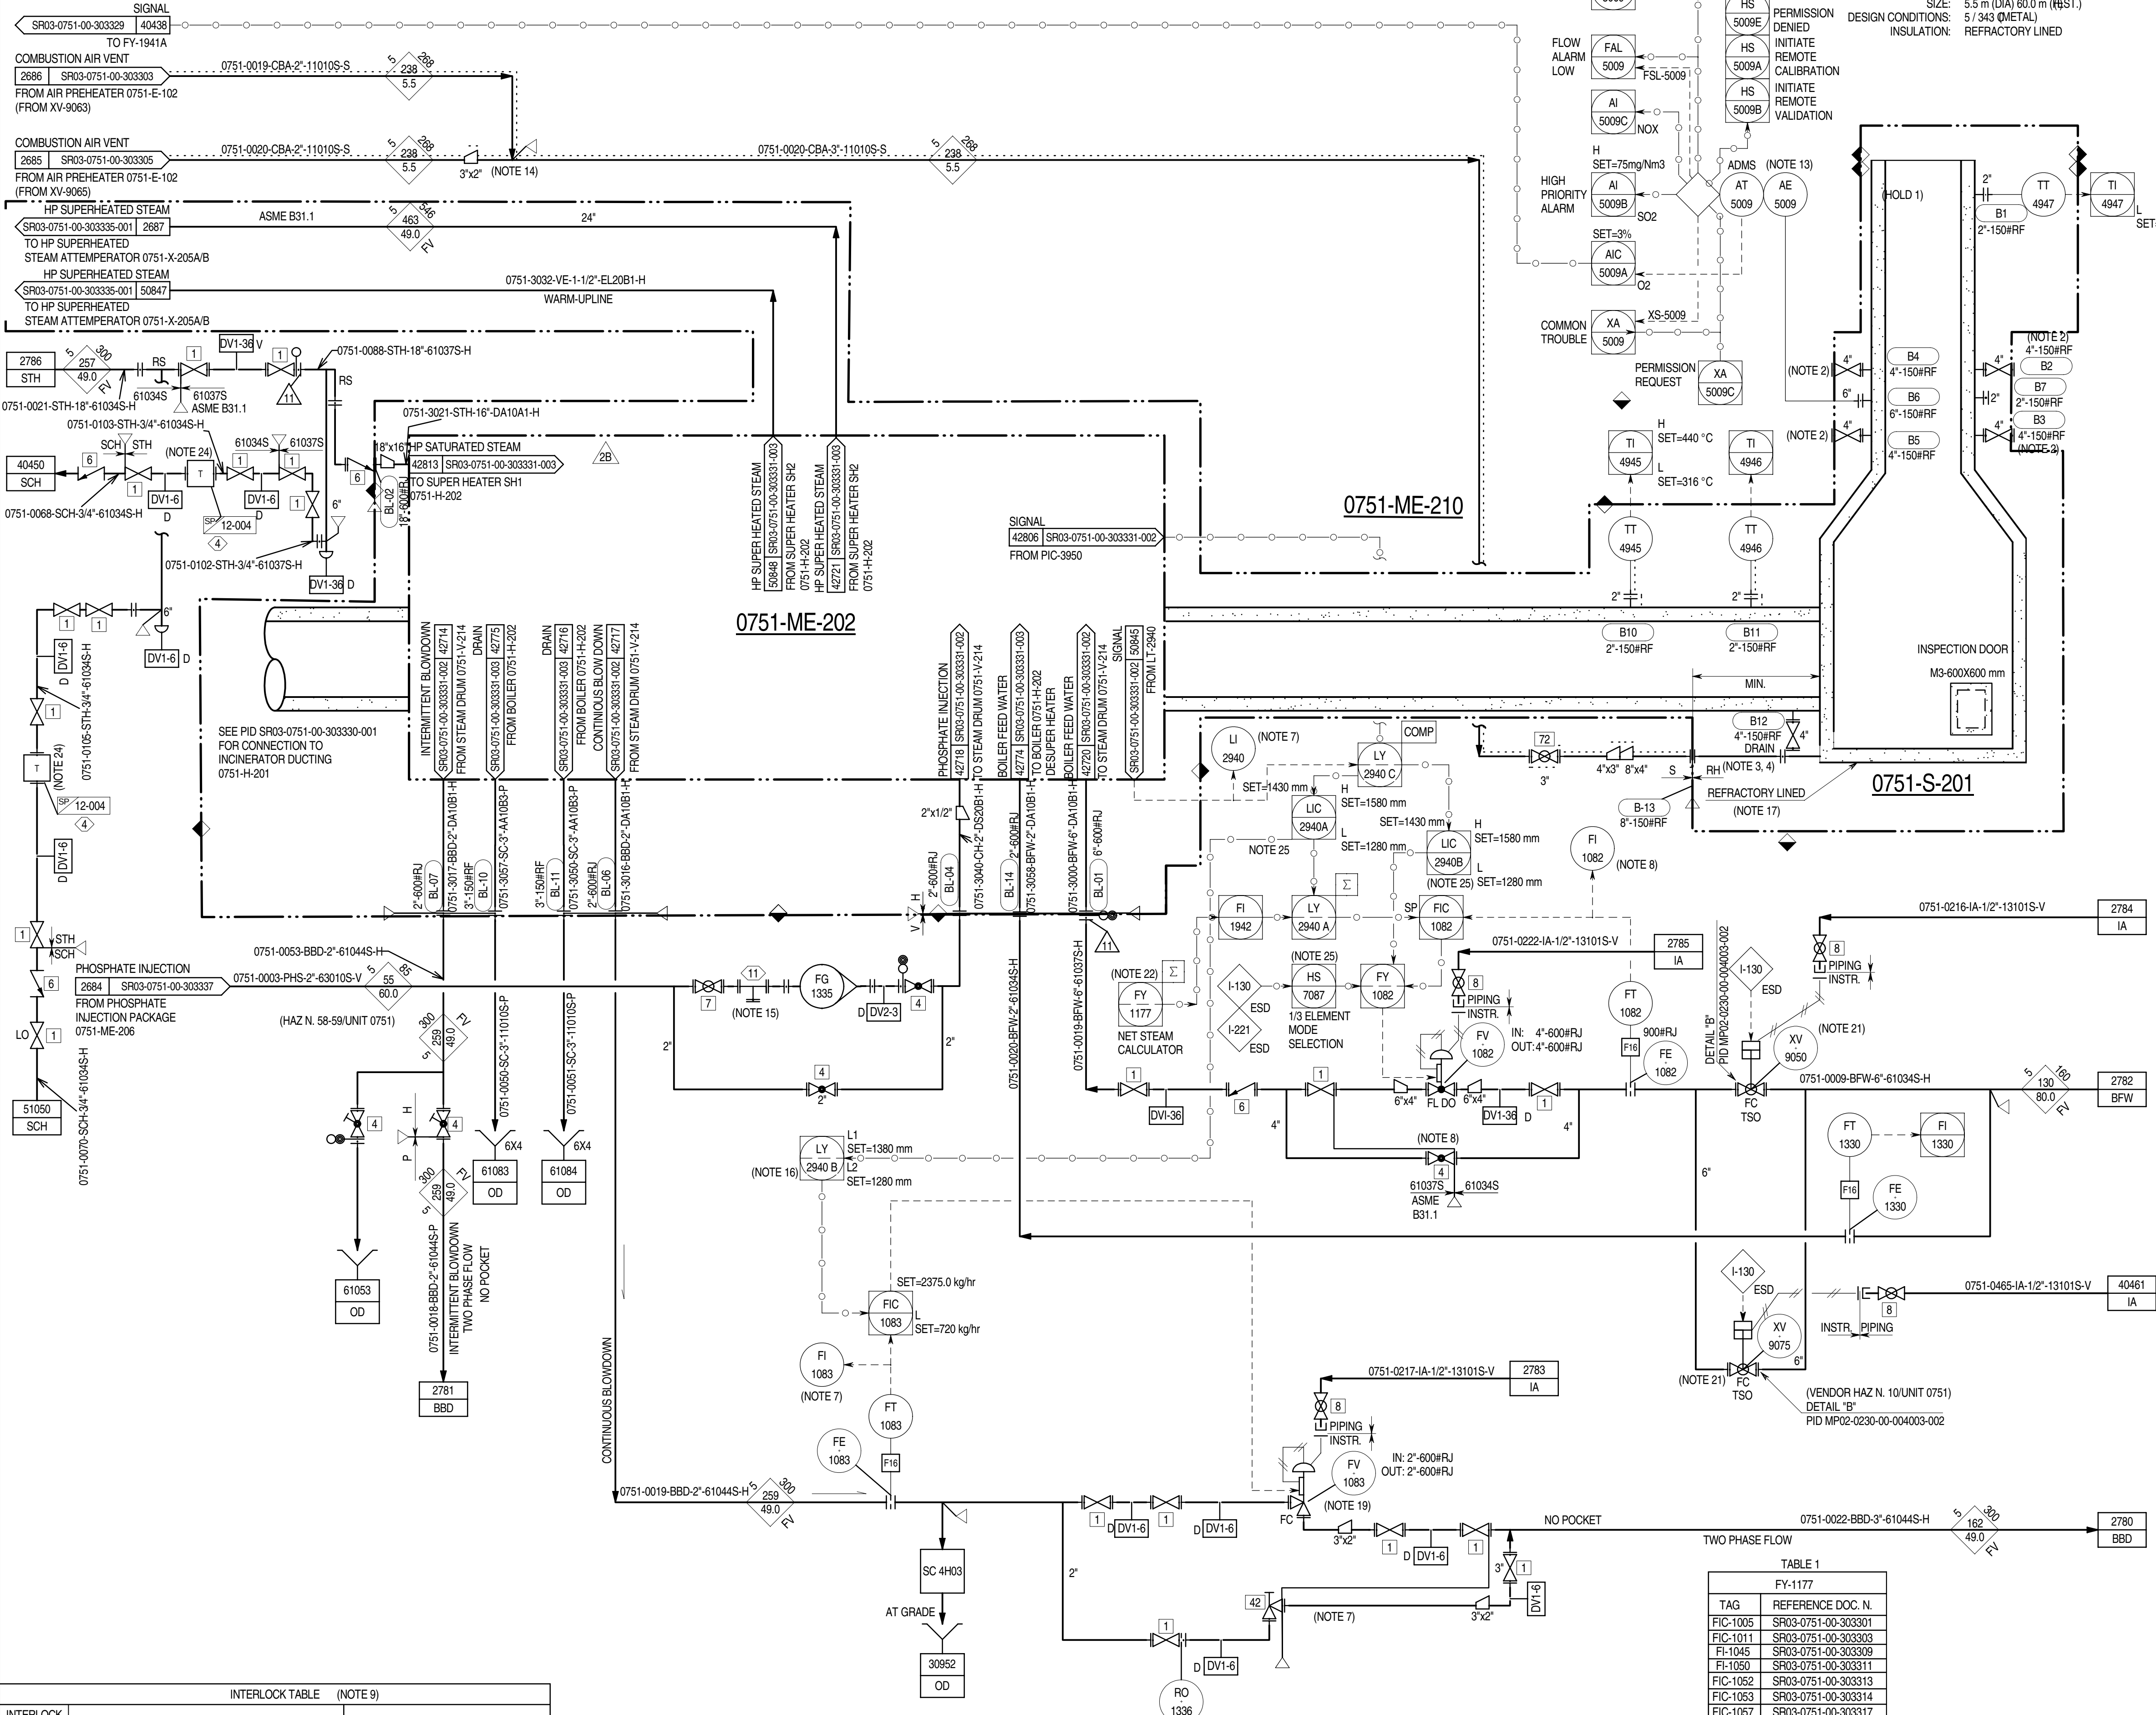

INTERLOCK TABLE (NOTE 9)		
INTERLOCK NUMBER	LOGIC DESCRIPTION (NOTE 11)	REFERENCE DOCUMENT N.
I-130	HRSG PACKAGE	SR03-0751-00-303375
I-221	CLAUS SECTION	SR03-0751-00-303375
I-224	INCINERATOR SECTION	SR03-0751-00-303375

TABLE 1 FY-1177	
TAG	REFERENCE DOC. N.
FIC-1005	SR03-0751-00-303301
FIC-1011	SR03-0751-00-303303
FI-1045	SR03-0751-00-303309
FI-1050	SR03-0751-00-303311
FIC-1052	SR03-0751-00-303313
FIC-1053	SR03-0751-00-303314
FIC-1057	SR03-0751-00-303317
FIC-1058	SR03-0751-00-303319
FI-1061A	SR03-0751-00-303324
FI-1086	SR03-0751-00-303338-002
FI-1124	SR03-0751-00-303335-001
FI-1330	SR03-0751-00-303331-001

21

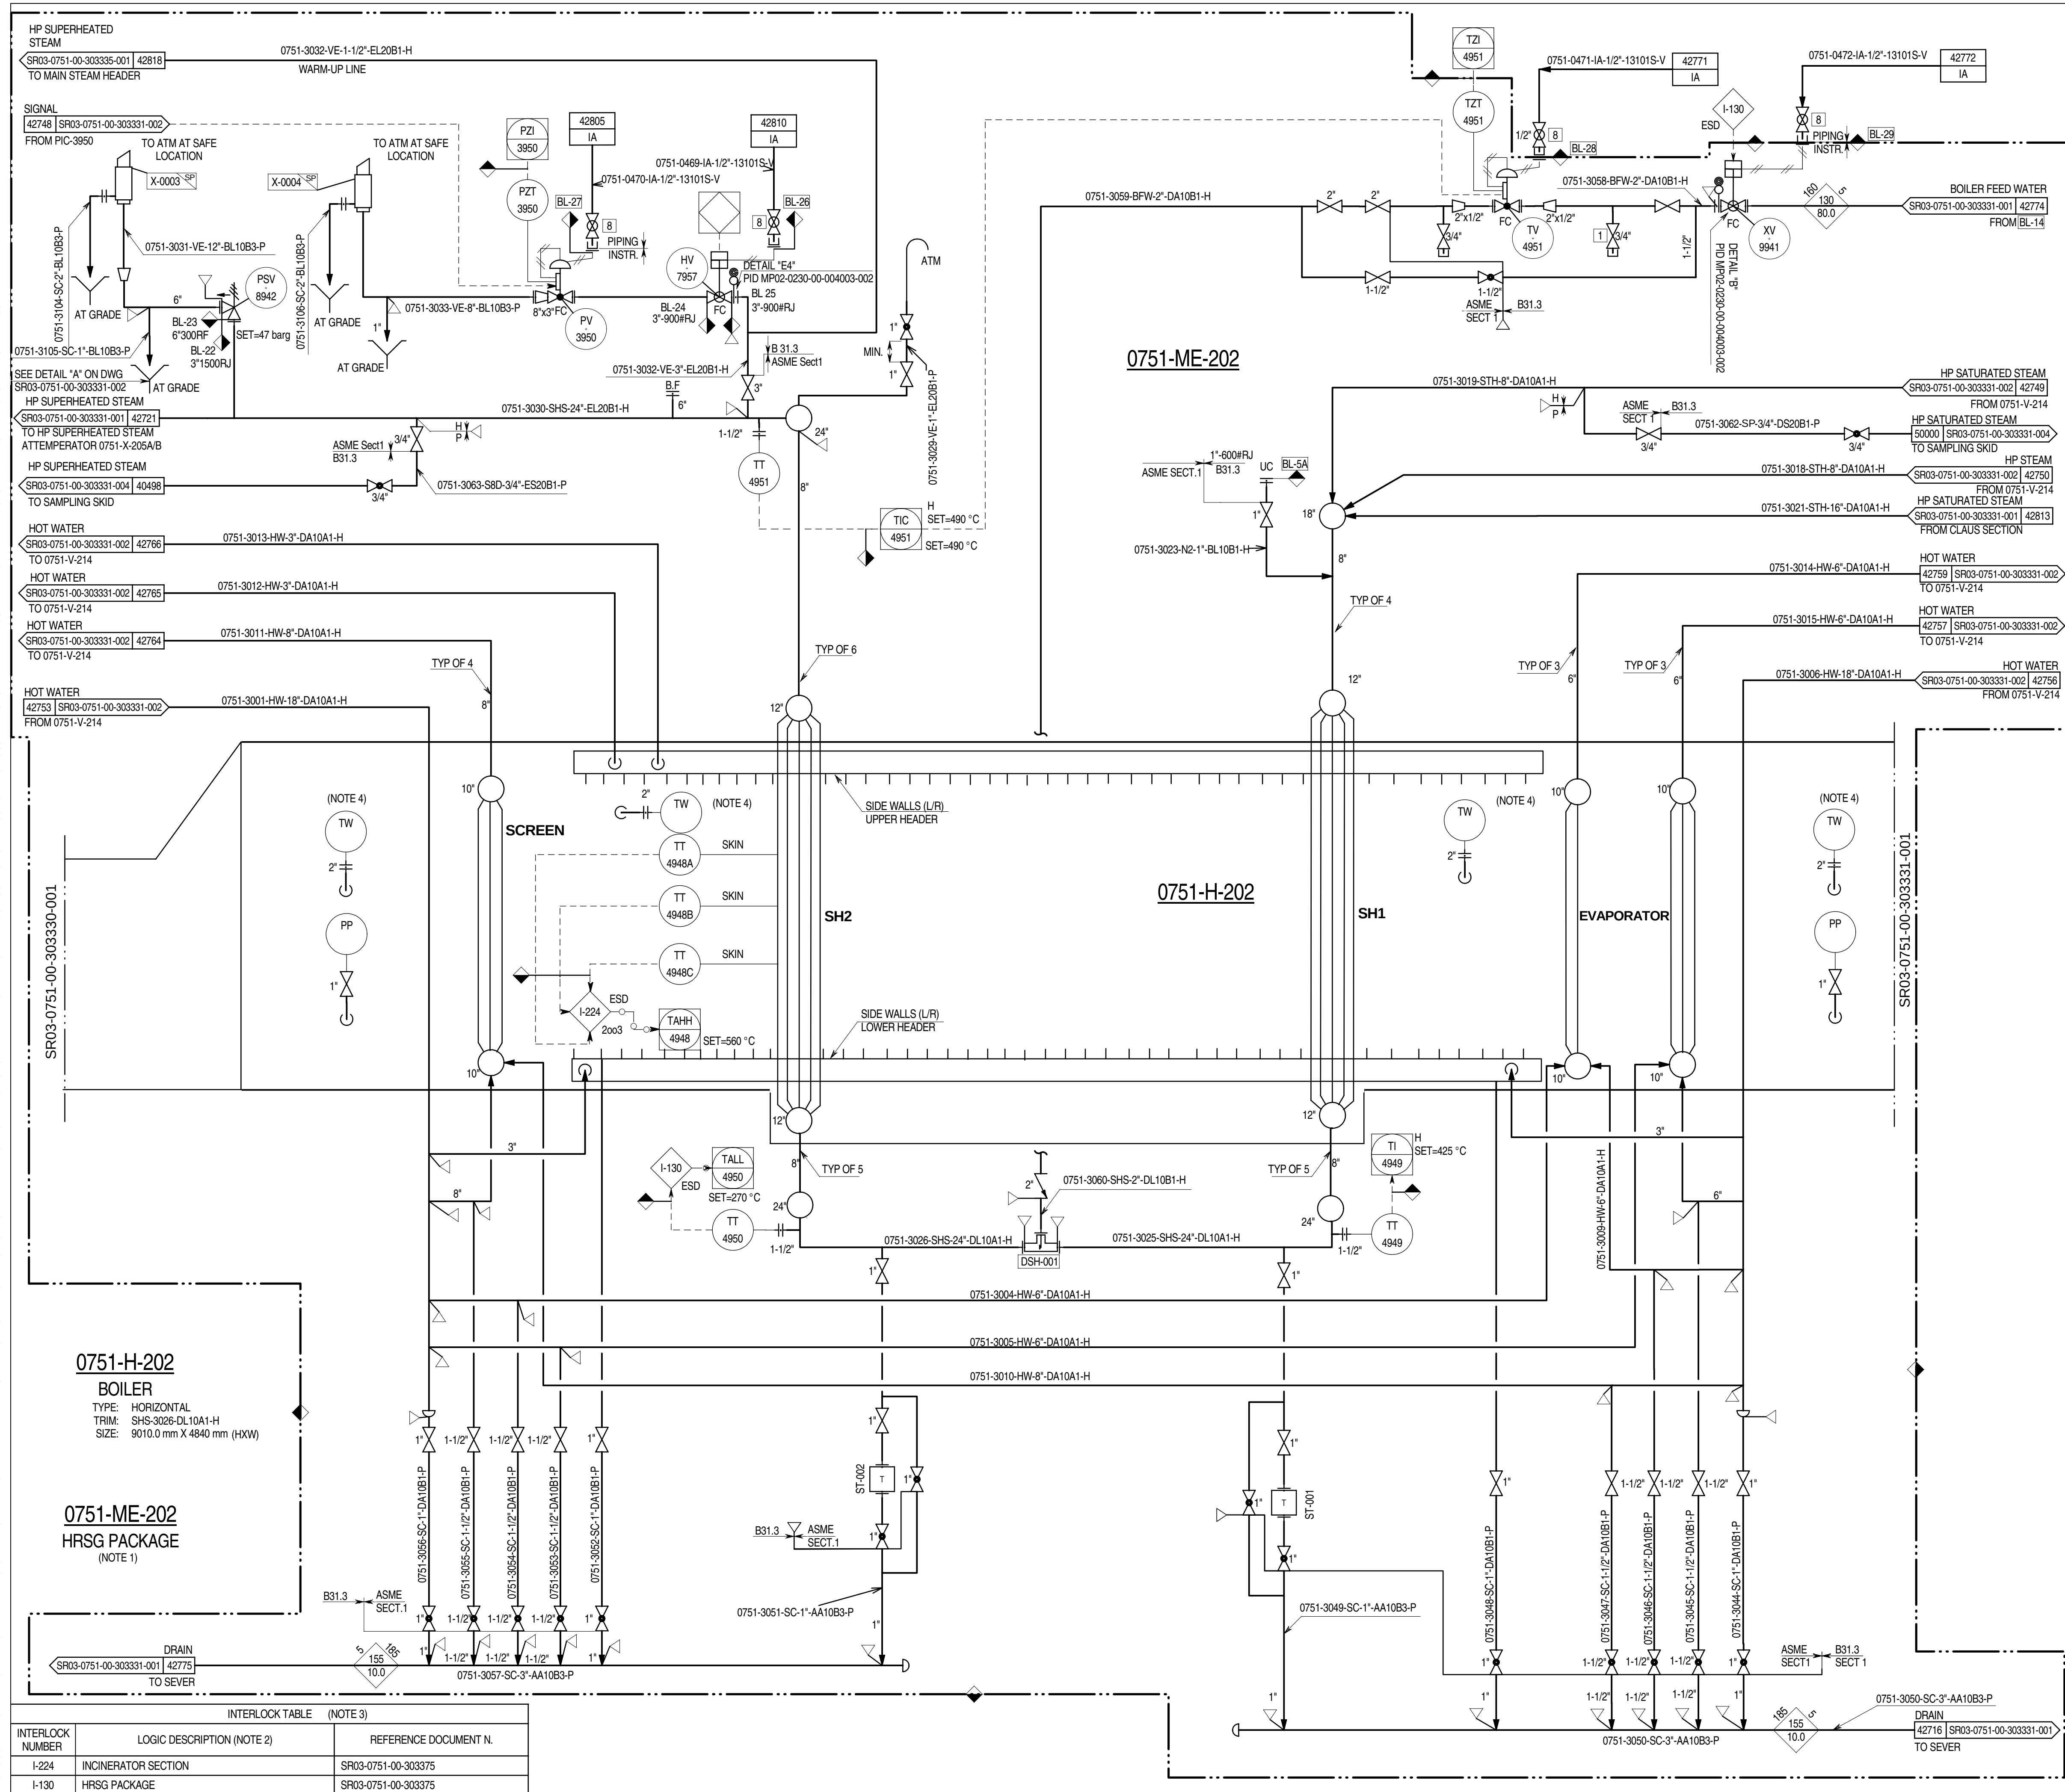

GENERAL NOTES:

1. FOR STANDARD SYMBOLS, DETAILS, ABBREVIATION, SAMPLE CONNECTION, GENERAL NOTES & LEGEND SHEETS REFER TO DRAWING NO. MP02-0230-00-004000 TO 004015.
 2. ALL INSTRUMENT TAG NUMBERS ON THIS PAID INCLUDING PACKAGE UNITS ARE PREFIXED WITH UNIT NUMBER 0751 UNLESS OTHERWISE NOTED.
- NOTES:
1. INCINERATOR PACKAGE 0751-ME-210 INCLUDES: 0751-B-201A/B/C, 0751-H-201, 0751-ME-202, 0751-S-201.
 2. REFER TO CAUSE AND EFFECT MATRIX FOR FULL REPRESENTATION OF INTERLOCK INITIATORS AND ACTIONS.
 3. INTERLOCK TABLE IS FOR REFERENCE ONLY. CAUSE AND EFFECT MATRIX SR03-0751-CCC-303155 SHALL GOVERN.
 4. THERMOWELL ALREADY INSTALLED AND BLIND INTO TEMPERATURE POINT.

UTILITY REFERENCE TABLE		
IA	DRW. N°.	SR03-0751-00-PID-362305

Z1	04-11-14	IAB	ISSUED FOR AS BUILT	PCA	MAR	ASP
2.1E	18-04-14	IFC	ISSUED FOR CONSTRUCTION	PCA	MAR	ASP
2.1D	28-02-14	IFC	ISSUED FOR CONSTRUCTION	PCA	MAR	ASP
2.1C	01-05-13	IFC	ISSUED FOR CONSTRUCTION	RL	CN	MZ
2.1B	06-08-12	IFC	ISSUED FOR CONSTRUCTION	DCS	CBR	SIN
REV	DATE	STATUS	STATUS DESCRIPTION	BY	CKD	APP.

COMPANY:

Abu Dhabi Gas Development Co. Ltd.



CONTRACTOR:



JOB No. 032090

PROJECT:

SHAH GAS DEVELOPMENT (SGD) PROJECT

AGREEMENT No. 13525001

DRAWING TITLE: PIPING & INSTRUMENT DIAGRAM UNIT 0751
SULPHUR RECOVERY AND TAIL GAS TREATING UNIT

EQUIPMENT DESCRIPTION	HRSG BOILER
TAGITEM No.	0751-H-202

CONTRACTOR DRG.No.	751-GD-B-303331		REV. Z1
COMPANY DRG.No.	SR03-0751-00-303331-003		
SCALE:	SIZE: A1	DOC. CLASS: 1	

1. IT IS EXPECTED TO MEASURE IN CONTINUOUS MODE ONLY THE CONDUCTIVITY, OTHER MEASURES ARE PROVIDED FOR PERIODIC ANALYSIS OFF-LINE.
THE MINIMUM ANALYSIS REQUIRED ARE:
a) PH- FOR BOILER FEED WATER & BOILER WATER
b) CONDUCTIVITY FOR BOILER FEED WATER, BOILER WATER, SATURATED & SUPERHEATED STEAM.
PERIODIC ANALYSIS MUST BE PROVIDED ALSO FOR SATURATED IMPORTED STEAM.

Z1	04-11-14	IAB	ISSUED FOR AS BUILT	PCA	MAR	ASP
2.1E	18-04-14	IFC	ISSUED FOR CONSTRUCTION	PCA	MAR	ASP
2.1D	28-02-14	IFC	ISSUED FOR CONSTRUCTION	PCA	MAR	ASF
2.1C	01-05-13	IFC	ISSUED FOR CONSTRUCTION	RL	CN	MZ
2.1B	06-08-12	IFC	ISSUED FOR CONSTRUCTION	DCS	CBR	SIN
REV	DATE	STATUS	STATUS DESCRIPTION	BY	CKD	APP.

JOB No. 032090

SHAH GAS DEVELOPMENT (SGD) PROJECT
SHAH SULPHUR RECOVERY UNIT


DRAWING TITLE: PIPING & INSTRUMENT DIAGRAM UNIT 0751
SULPHUR RECOVERY AND TAIL GAS TREATING UNIT

CONTRACTOR DRG NO.		751-GD-B-303331		REV. Z1
COMPANY DRG NO.		SR03-0751-00-303331-004		
SCALE:	SIZE: A1		DOC. CLASS: 1	

ALE:	SIZE: A1	DOC. CLASS: 1
------	----------	---------------

71

TYPE: VERTICAL
SIZE: 1000 mm ID x 2800 mm T/T
CAPACITY: 2.5 m³
DESIGN CONDITIONS: 8.5 barg @ 5/95 C & HV @ 150 C
OPER CONDITIONS: 4.9 barg @ 55 C
MATERIAL: CS+3mm CA
INSULATION: V
TRIM: VT-0053-31010S-V

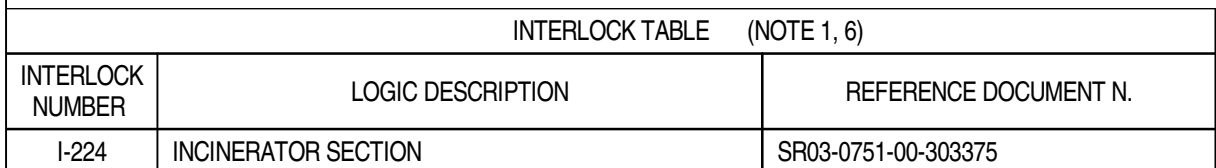

UTILITY REFERENCE TABLE		
IA	DRW. N°.	SR03-0751-00-PID-362305
OD	DRW. N°.	SR03-0751-00-PID-362307
FGL	DRW. N°.	SR03-0751-00-PID-362310
LFL	DRW. N°.	SR03-0751-00-PID-362313

COMPANY:

Abu Dhabi Gas Development Co. Ltd.




PROJECT: SHAH GAS DEVELOPMENT (SGD) PROJECT

AGREEMENT No. 13525001

EQUIPMENT DESCRIPTION	LP FUEL GAS DRUM
TAG/ITEM No.	0751-V-211

CONTRACTOR DRG No.		751-GD-B-303333	REV. Z1
COMPANY DRG No.		SR03-0751-00-303333	
SCALE:	SIZE: A1	DOC. CLASS: 1	

THIS DOCUMENT IS THE PROPERTY OF ABU DHABI GAS DEVELOPMENT COMPANY LIMITED AND CONTAINS INFORMATION WHICH IS PROPRIETARY. THIS INFORMATION IS TO BE HELD IN CONFIDENCE. NO DISCLOSURE OR OTHER USE OF THIS DOCUMENT IS TO BE MADE WITHOUT THE PRIOR WRITTEN CONSENT OF ABU DHABI GAS DEVELOPMENT COMPANY LIMITED.

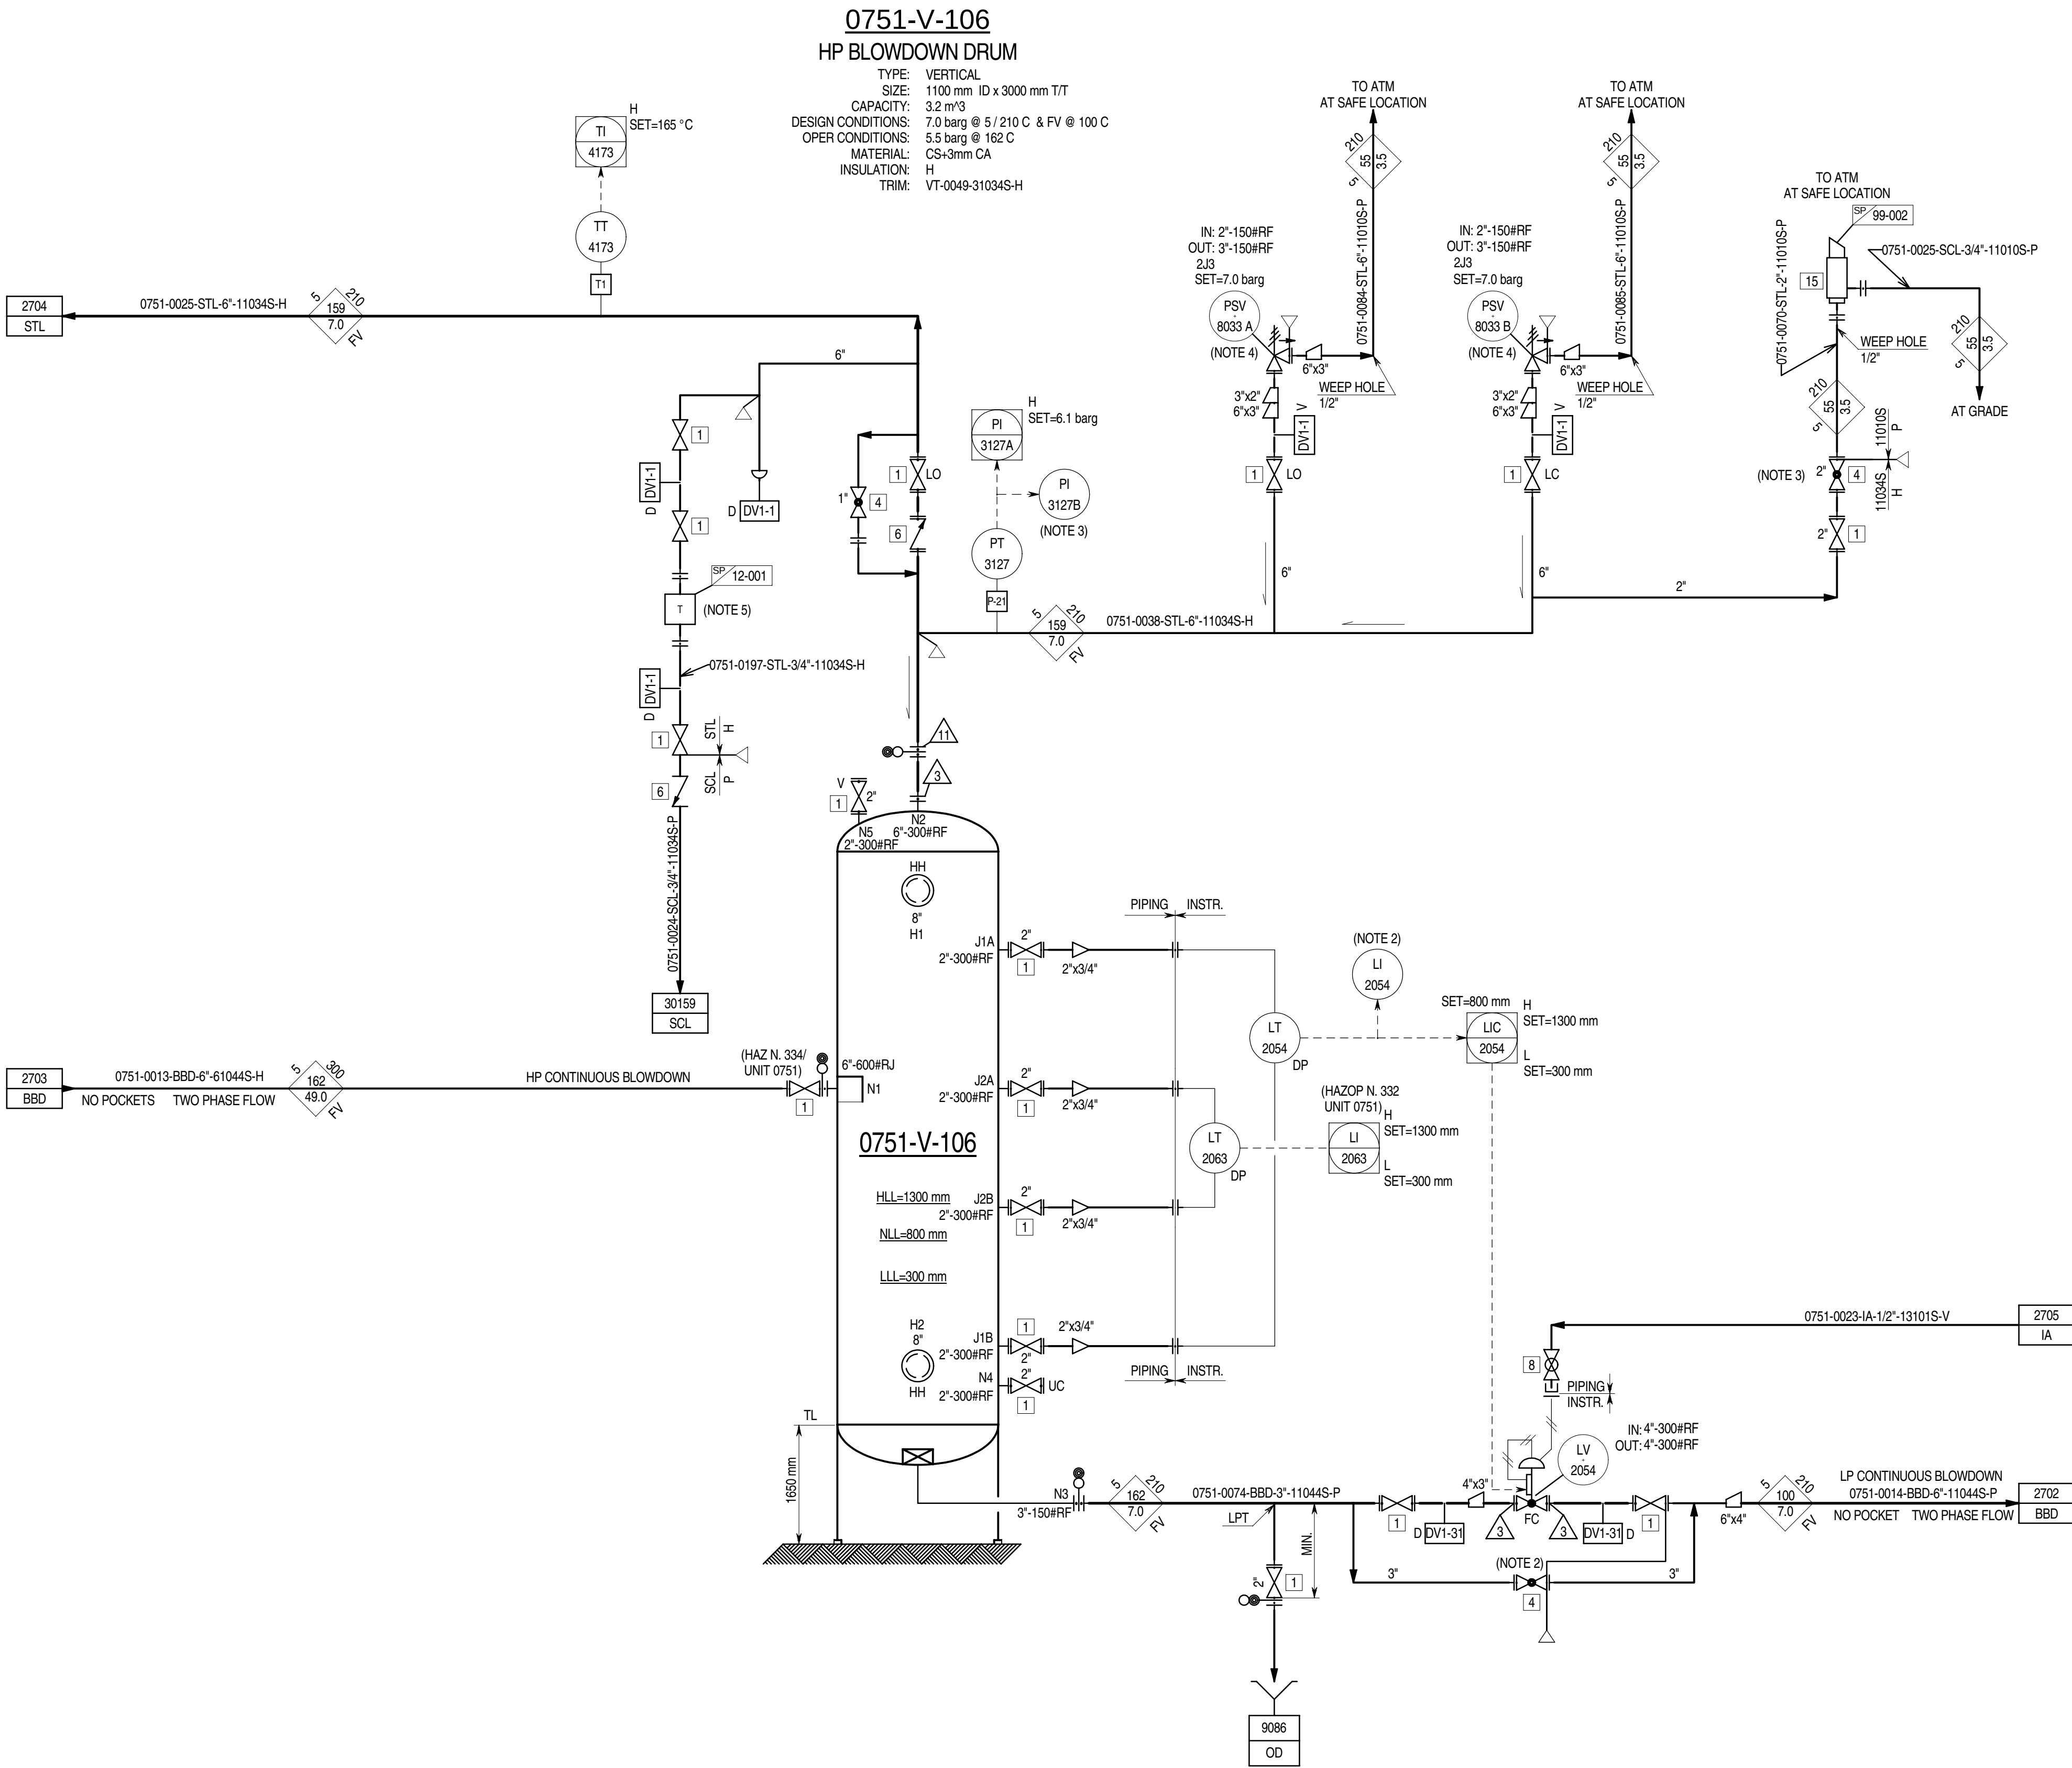

- GENERAL NOTES:**
- FOR STANDARD SYMBOLS, DETAILS, ABBREVIATIONS, SAMPLE CONNECTION TYPE. GENERAL NOTES & LEGEND SHEETS REFER TO DRAWING NO. MP02-0230-00-004000 TO 004015.
 - ALL INSTRUMENT TAG NUMBERS ON THIS P&ID INCLUDING PACKAGE UNITS ARE PREFIXED WITH UNIT NUMBERS 0751 UNLESS OTHERWISE NOTED.
 - DELETED.
- NOTES:**
- DELETED.
 - LI-2054 TO BE READABLE FROM LV-2054 BY-PASS VALVE.
 - PI-3127B TO BE READABLE FROM PSV-8033A/B MANUAL VENT.
 - PSV SIZING CASE: BLOCKED OUTLET.
 - STEAM TRAP TO BE PROVIDED WITH INTEGRAL INLET STRAINER OTHERWISE A DEDICATED PIPING STRAINER TO BE INSTALLED.

UTILITY REFERENCE TABLE		
BBD/SCL/STL	DRW. N°.	SR03-0751-00-PID-362303
IA	DRW. N°.	SR03-0751-00-PID-362305
OD	DRW. N°.	SR03-0751-00-PID-362307

Z1	04-11-14	IAB	ISSUED FOR AS BUILT	PCA	MAR	ASP
2.1B	06-08-12	IFC	ISSUED FOR CONSTRUCTION	DSC	CBR	SIN
2	29-12-11	IFC	ISSUED FOR CONSTRUCTION	DSC	CBR	SIN
1	12-08-11	IFCH	ISSUED FOR CONSTRUCTION WITH HOLDS	DSC	CBR	SIN
0	06-03-11	IFD	ISSUED CLIENT COMMENTS INCORPORATED	BSC	LMA	SIN
B1	30-09-10	ICR	ISSUED FOR CLIENT REVIEW	BSC	LMA	SIN
REV	DATE	STATUS	STATUS DESCRIPTION	BY	CKD	APP.

COMPANY:

Abu Dhabi Gas Development Co. Ltd.

الحصن للغاز
Al Hosn Gas

CONTRACTOR:

eni saipem

JOB No. 032090

PROJECT: SHAH GAS DEVELOPMENT (SGD) PROJECT


AGREEMENT No. 13525001

DRAWING TITLE: PIPING & INSTRUMENT DIAGRAM UNIT 0751 SULPHUR RECOVERY AND TAIL GAS TREATING UNIT

EQUIPMENT DESCRIPTION	HP BLOWDOWN DRUM
TAGITEM No.	0751-V-106

CONTRACTOR DRG. No.	751-GD-B-303334	REV. Z1
COMPANY DRG. No.	SR03-0751-00-303334	
SCALE:	SIZE: A1	DOC. CLASS: 1

THIS DOCUMENT IS THE PROPERTY OF ABU DHABI GAS DEVELOPMENT COMPANY LIMITED AND CONTAINS INFORMATION WHICH IS PROPRIETARY. THIS INFORMATION IS TO BE HELD IN CONFIDENCE. NO DISCLOSURE OR OTHER USE OF THIS DOCUMENT IS TO BE MADE WITHOUT THE PRIOR WRITTEN CONSENT OF ABU DHABI GAS DEVELOPMENT COMPANY LIMITED.

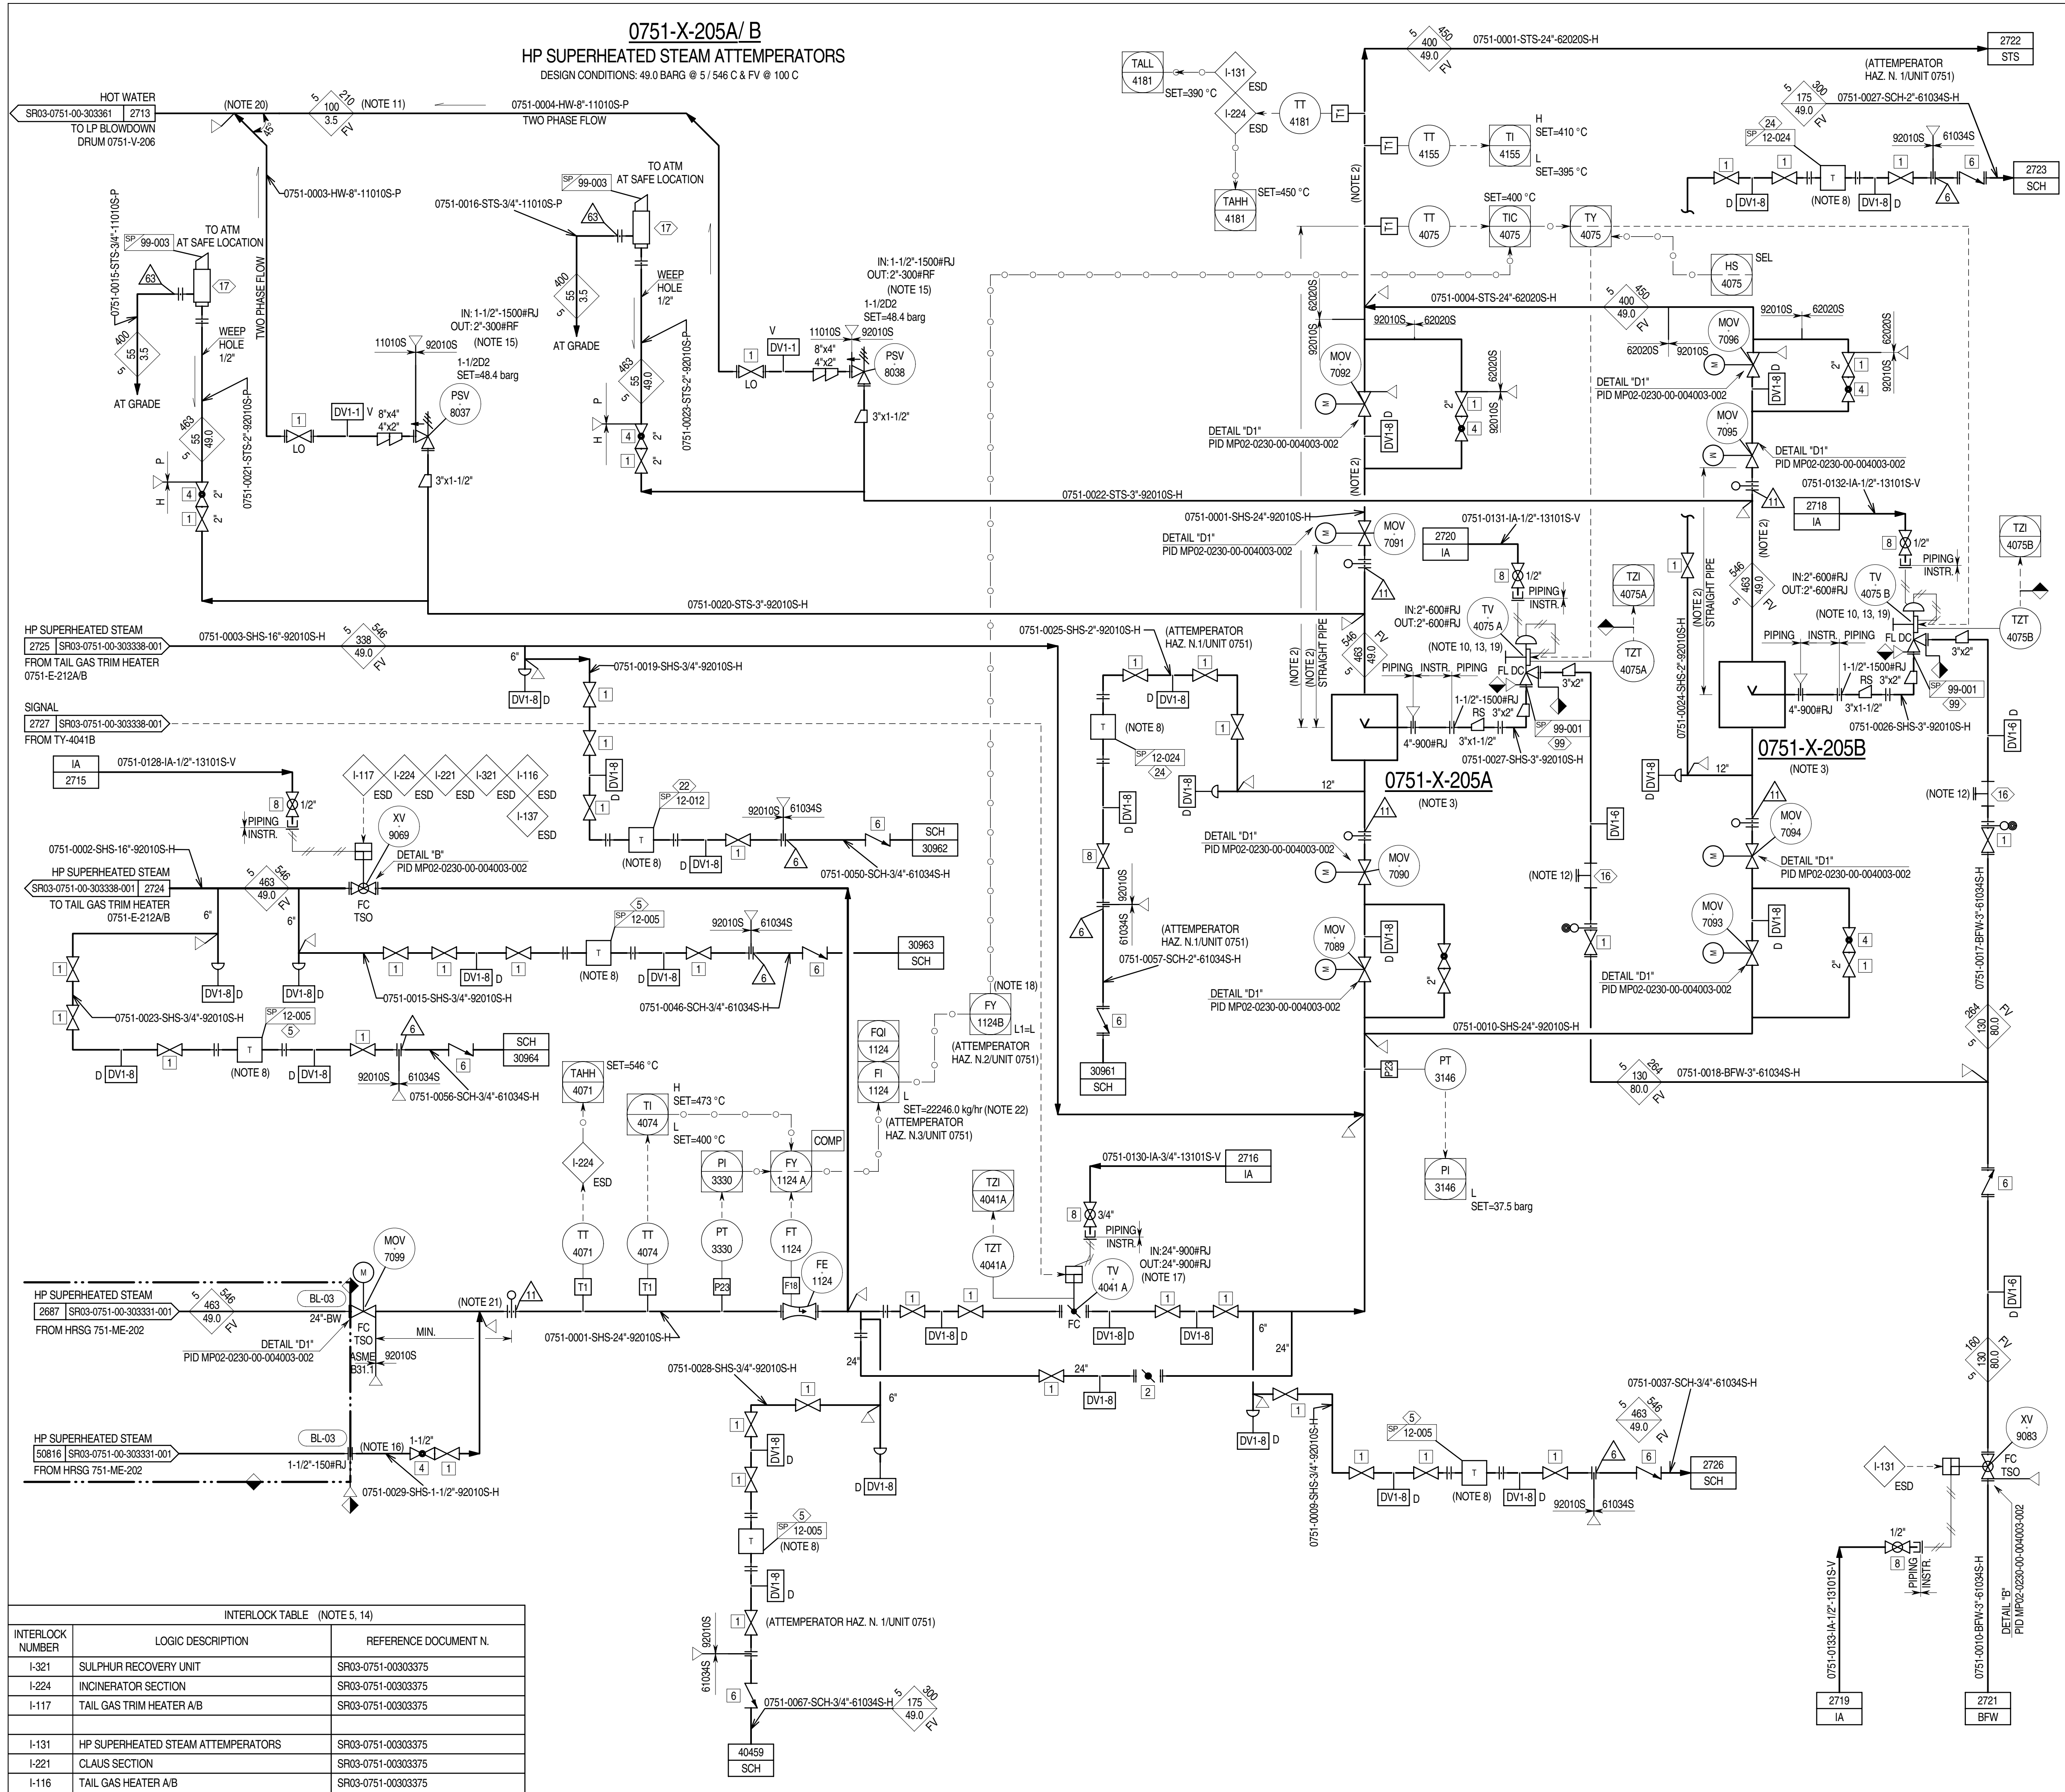

- GENERAL NOTES:**
- FOR STANDARD SYMBOLS, DETAILS, ABBREVIATIONS, SAMPLE CONNECTION TYPE, GENERAL NOTES & LEGEND SHEETS REFER TO DRAWING NO. MP02-0230-00-004000 TO 004015.
 - ALL INSTRUMENT TAG NUMBERS ON THIS P&ID INCLUDING PACKAGE UNITS ARE PREFIXED WITH UNIT NUMBER 0751 UNLESS OTHERWISE NOTED.
 - DELETED.
- NOTES:**
- DELETED.
 - MINIMUM STRAIGHT LENGTH DOWNSTREAM THE DESUPERHEATER SHOULD BE 3m. MINIMUM DISTANCE BETWEEN THE WATER INJECTION POINT AND THE TEMPERATURE SENSOR SHOULD BE 6.2m.
 - HP SUPERHEATER STEAM ATTEMPERATOR 0751-X-205A/B LOCATED ON TOP OF PIPE RACK.
 - DELETED.
 - INTERLOCK TABLE IS FOR REFERENCE ONLY. CAUSE AND EFFECT MATRIX SR03-0751-00-CCC-303155 SHALL GOVERN.
 - DELETED.
 - DELETED.
 - STEAM TRAP TO BE PROVIDED WITH INTEGRAL INLET STRAINER, OTHERWISE A DEDICATED PIPING STRAINER TO BE INSTALLED UPSTREAM.
 - DELETED.
 - TV-4075A/B INCLUDED IN 0751-X-205A/B VENDOR SCOPE OF SUPPLY.
 - DURING UPSET CONDITION TEMPERATURE CAN REACH 400 °C.
 - STRAINER WITH SCREEN 100 MESH.
 - VALVES TV-4075 A/B ARE EQUIPPED WITH MECHANICAL STOP TO LIMIT VALVE OPENING.
 - REFER TO CAUSE AND EFFECT CHART FOR FULL REPRESENTATION OF INTERLOCK INITIATORS AND ACTIONS.
 - PSV SIZING CASE: BLOCKED OUTLET.
 - 1 1/2" GLOBE VALVE USED FOR WARM-UP.
 - TV-4041A PROVIDED WITH AIR VOLUME TANK ONLY FOR STROKE FAIL POSITION.
 - AT LOW FLOW L1 THE LOGIC WILL PUT THE TEMPERATURE CONTROL TIC-4075 ON MANUAL MODE AT 0% OUTPUT, CLOSING TV-4075A/B.
 - VALVE TO BE PROVIDED WITH LOCAL SIGN: "WARNING: TRIM SIZE AFFECTS RELIEF VALVE CAPACITY".
 - USE 45" TOP ENTRY CONNECTION.
 - N.1 W.N. FLANGE 24" 900#RJ SUPPLY LOSE BY 0751-ME-202 VENDOR.
 - SET POINT TO BE ADJUSTED DURING COMMISSIONING.

UTILITY REFERENCE TABLE		
BWF	DRW. N°.	SR03-0751-00-PID-362304
IA	DRW. N°.	SR03-0751-00-PID-362305
STH/SCH/STS	DRW. N°.	SR03-0751-00-PID-362312

Z1	04-11-14	IAB	ISSUED FOR AS BUILT	PCA	MAR	ASP
2.1D	18-04-14	IFC	ISSUED FOR CONSTRUCTION	PCA	MAR	ASP
2.1C	28-02-14	IFC	ISSUED FOR CONSTRUCTION	PCA	MAR	ASP
2.1B	06-08-12	IFC	ISSUED FOR CONSTRUCTION	DSC	CBR	SIN
2	29-12-11	IFC	ISSUED FOR CONSTRUCTION	DSC	CBR	SIN
1	12-08-11	IFCH	ISSUED FOR CONSTRUCTION WITH HOLDS	DSC	CBR	SIN
0	06-03-11	IFD	ISSUED CLIENT COMMENTS INCORPORATED	BSC	LMA	SIN
B1	30-09-10	ICR	ISSUED FOR CLIENT REVIEW	BSC	LMA	SIN
REV	DATE	STATUS	STATUS DESCRIPTION	BY	CKD	APP.

COMPANY:

Abu Dhabi Gas Development Co. Ltd.

الحصن للغاز
Al Hosn Gas

CONTRACTOR:

eni saipem

JOB No. 032090

PROJECT:


SHAH GAS DEVELOPMENT (SGD) PROJECT

AGREEMENT No. 13525001

DRAWING TITLE: PIPING & INSTRUMENT DIAGRAM UNIT 0751
SULPHUR RECOVERY AND TAIL GAS TREATING UNIT

EQUIPMENT DESCRIPTION	HP STEAM ATTEMPERATORS
TAGITEM No.	0751-X-205A / B

CONTRACTOR DRG. No.	751-GD-B-303335	REV. Z1
COMPANY DRG. No.	SR03-0751-00-303335-001	
SCALE:	SIZE: A1	DOC. CLASS: 1

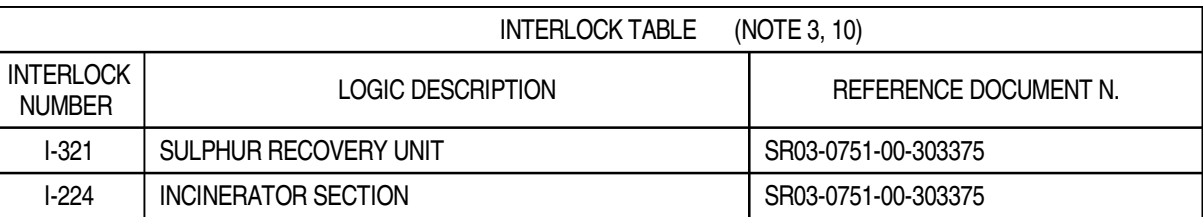

1. FOR STANDARD SYMBOLS, DETAILS, ABBREVIATIONS, SAMPLE CONNECTION TYPE, GENERAL NOTES & LEGEND SHEETS REFER TO DRAWING NO. MP02-0230-00-004000 TO 004015.
2. ALL INSTRUMENT TAG NUMBERS ON THIS P&ID INCLUDING PACKAGE UNITS ARE PREFIXED WITH UNIT NUMBER 0751 UNLESS OTHERWISE NOTED.
3. DELETED.

1. MINIMUM STRAIGHT LENGTH DOWNSTREAM THE DESUPERHEATER SHOULD BE 3 M. MINIMUM DISTANCE BETWEEN THE WATER INJECTION POINT AND THE TEMPERATURE SENSOR SHOULD BE 7.3 M.
2. DELETED.
3. INTERLOCK TABLE IS FOR REFERENCE ONLY. CAUSE AND EFFECT MATRIX SR03-0751-00-CCC-303155 SHALL GOVERN.
4. PI-3211B TO BE READABLE FROM MANUAL VENT.
5. STRAINER WITH SCREEN 100 MESH.
6. DELETED.
7. TV-4076 INCLUDED IN 0751-X-206 VENDOR SCOPE OF SUPPLY.
8. DURING UPSET CONDITION TEMPERATURE CAN REACH 257 °C.
9. VALVE TV-4076 IS EQUIPPED WITH MECHANICAL STOP.
10. REFER TO CAUSE AND EFFECT CHART FOR FULL REPRESENTATION OF INTERLOCK INITIATORS AND ACTION.
11. PSV SIZING CASE: BLOCKED OUTLET.
12. 1" GLOBE VALVE USED FOR WARM-UP.
13. USE 45° TOP ENTRY CONNECTION.
14. VALVE TO BE PROVIDED W/LOCAL SIGN: "WARNING: TRIM SIZE AFFECTS RELIEF VALVE CAPACITY"
15. STEAM TRAP TO BE PROVIDED WITH INTEGRAL INLET STRAINER, OTHERWISE A DEDICATED PIPING STRAINER TO BE INSTALLED.

UTILITY REFERENCE TABLE		
BWF	DRW. N°.	SR03-0751-00-PID-362304
IA	DRW. N°.	SR03-0751-00-PID-362305
STH	DRW. N°.	SR03-0751-00-PID-362312
STS	DRW. N°.	SR03-0751-00-PID-362312
SCH	DRW. N°.	SR03-0751-00-PID-362312

Z1	04-11-14	IAB	ISSUED FOR AS BUILT	PCA	MAR	ASFB
2.1D	18-04-14	IFC	ISSUED FOR CONSTRUCTION	PCA	MAR	ASFB
2.1C	28-02-14	IFC	ISSUED FOR CONSTRUCTION	PCA	MAR	ASFB
2.1B	06-08-12	IFC	ISSUED FOR CONSTRUCTION	DSC	CBR	SIN
2	29-12-11	IFC	ISSUED FOR CONSTRUCTION	DSC	CBR	SIN
1	12-08-11	IFCH	ISSUED FOR CONSTRUCTION WITH HOLDS	DSC	CBR	SIN
0	06-03-11	IFD	ISSUED CLIENT COMMENTS INCORPORATED	BSC	LMA	SIN
B1	30-09-10	ICR	ISSUED FOR CLIENT REVIEW	BSC	LMA	SIN
REV	DATE	STATUS	STATUS DESCRIPTION	BY	CKD	APP.

Abu Dhabi Gas Development Co. Ltd.



saipem

JOB No. 032090

SHAH GAS DEVELOPMENT (SGD) PROJECT

AGREEMENT No. 13525001

DRAWING TITLE: PIPING & INSTRUMENT DIAGRAM UNIT 075
SULPHUR RECOVERY AND TAIL GAS TREATING UNIT

EQUIPMENT DESCRIPTION	START UP HP STEAM ATTEMPERATOR
TAG/ITEM No.	0751-X-206

CONTRACTOR ORG. No.		751-GD-B-303335	REV. Z1
COMPANY ORG. No.		SR03-0751-00-303335-002	
SCALE:	SIZE: A1	DOC. CLASS: 1	

1. DELETED.
2. INTERLOCK TABLE IS FOR REFERENCE ONLY. CAUSE AND EFFECT MATRIX SR03-0751-00-CCC-303155 SHALL GOVERN.
3. SET POINT BY PACKAGE VENDOR.
4. ONE PNEUMATIC PORTABLE PUMP WITH CONNECTION COUPLING WILL BE SUPPLIED BY VENDOR FOR PURE ANTI-FOAM LOADING. PUMP IS COMMON FOR UNITS 0751/0752/0753/0754.
5. REFER TO CAUSE AND EFFECT CHART FOR FULL REPRESENTATION OF INTERLOCK INITIATORS AND ACTIONS.
6. ANTI-FOAM INJECTION PACKAGE INCLUDES: 0751-ME-201-V1/V2,0751-ME-201-P1/P2/P3/P4,0751-ME-201-AG1/AG2.
7. LEVEL DETAILS SHOWN ARE IN REFERENCE FROM TANK BOTTOM.
8. TANK DRAINING CONNECTION.
9. PLANT AIR FOR 0751-ME-201-P4 TO BE PROVIDED FROM THE NEAREST UTILITY STATION.
10. ONLY ONE TANK TO BE IN OPERATION AT THE TIME.
11. DIAPHRAGM SEAL TYPE LEVEL TRANSMITTER WITH INTEGRAL INDICATOR TO BE READABLE FROM CORRESPONDING GATE VALVE.

Z1	04-11-14	IAB	ISSUED FOR AS BUILT	PCA	MAR	ASP
2.B1	06-08-12	IFC	ISSUED FOR CONSTRUCTION	DSC	CBR	SIN
2	29-12-11	IFC	ISSUED FOR CONSTRUCTION	DSC	CBR	SIN
1	12-08-11	IFCH	ISSUED FOR CONSTRUCTION WITH HOLDS	DSC	CBR	SIN
0	06-03-11	IFD	ISSUED CLIENT COMMENTS INCORPORATED	BSC	LMA	SIN
B1	30-09-10	ICR	ISSUED FOR CLIENT REVIEW	BSC	LMA	SIN
REV	DATE	STATUS	STATUS DESCRIPTION	BY	CKD	APP.

JOB No. 032090

DRAWING TITLE: PIPING & INSTRUMENT DIAGRAM UNIT 0751
SULPHUR RECOVERY AND TAIL GAS TREATING UNIT

CONTRACTOR DRG. No.		751-GD-B-303336	REV. Z1
COMPANY DRG. No.		SR03-0751-00-303336-001	
SCALE:	SIZE: A1	DOC. CLASS: 1	

CONTRACTOR DRG No.	751-GD-B-303337		REV.
COMPANY DRG.No.	SR03-0751-00-303337		
SCALE:	SIZE: A1	DOC. CLASS: 1	
Z1			

THIS DOCUMENT IS THE PROPERTY OF ABU DHABI GAS DEVELOPMENT COMPANY LIMITED AND CONTAINS INFORMATION WHICH IS PROPRIETARY. THIS INFORMATION IS TO BE HELD IN CONFIDENCE. NO DISCLOSURE OR OTHER USE OF THIS DOCUMENT IS TO BE MADE WITHOUT THE PRIOR WRITTEN CONSENT OF ABU DHABI GAS DEVELOPMENT COMPANY LIMITED.

0751-E-211A/B

TAIL GAS HEATER

TYPE: SHELL & TUBE

TEMA TYPE: BXU

DESIGN DUTY: 13420 Mcal/hr

HEAT TRANSFER AREA: 820.0 m²

DESIGN CONDITIONS: 5.5 barg @ 0/268 C & HV

OPER CONDITIONS (IN): 0.36 barg @ 132.0 C

(OUT): 0.36 barg @ 238.0 C

MATERIAL: CS-3mm CA

INSULATION: H

TRIM: VT-0076-11030SL-H (E-211A)

VT-0133-11030SL-H (E-211B)

LETHAL SERVICE

TUBE

49.0 barg @ 5/300 C & FV @ 100 C

(IN): 43.68 barg @ 257.0 C

(OUT): 43.65 barg @ 257.0 C

CS+0.8mm CA

VT-0077-61034S-H (E-211A)

VT-0132-61034S-H (E-211B)

0751-E-212A/B

TAIL GAS TRIM HEATER

TYPE: SHELL & TUBE

TEMA TYPE: CXU

DESIGN DUTY: 5500 Mcal/hr

HEAT TRANSFER AREA: 167.0 m²

DESIGN CONDITIONS: 5.5 barg @ 0/315 C & HV @ 315 C

OPER CONDITIONS (IN): 0.36 barg @ 238.0 C

(OUT): 0.33 barg @ 285.0 C


MATERIAL: CS-3mm CA

INSULATION: H

TRIM: VT-0079-H (0751-E-212A)

VT-0131-92010S-H (0751-E-212-B)

LETHAL SERVICE

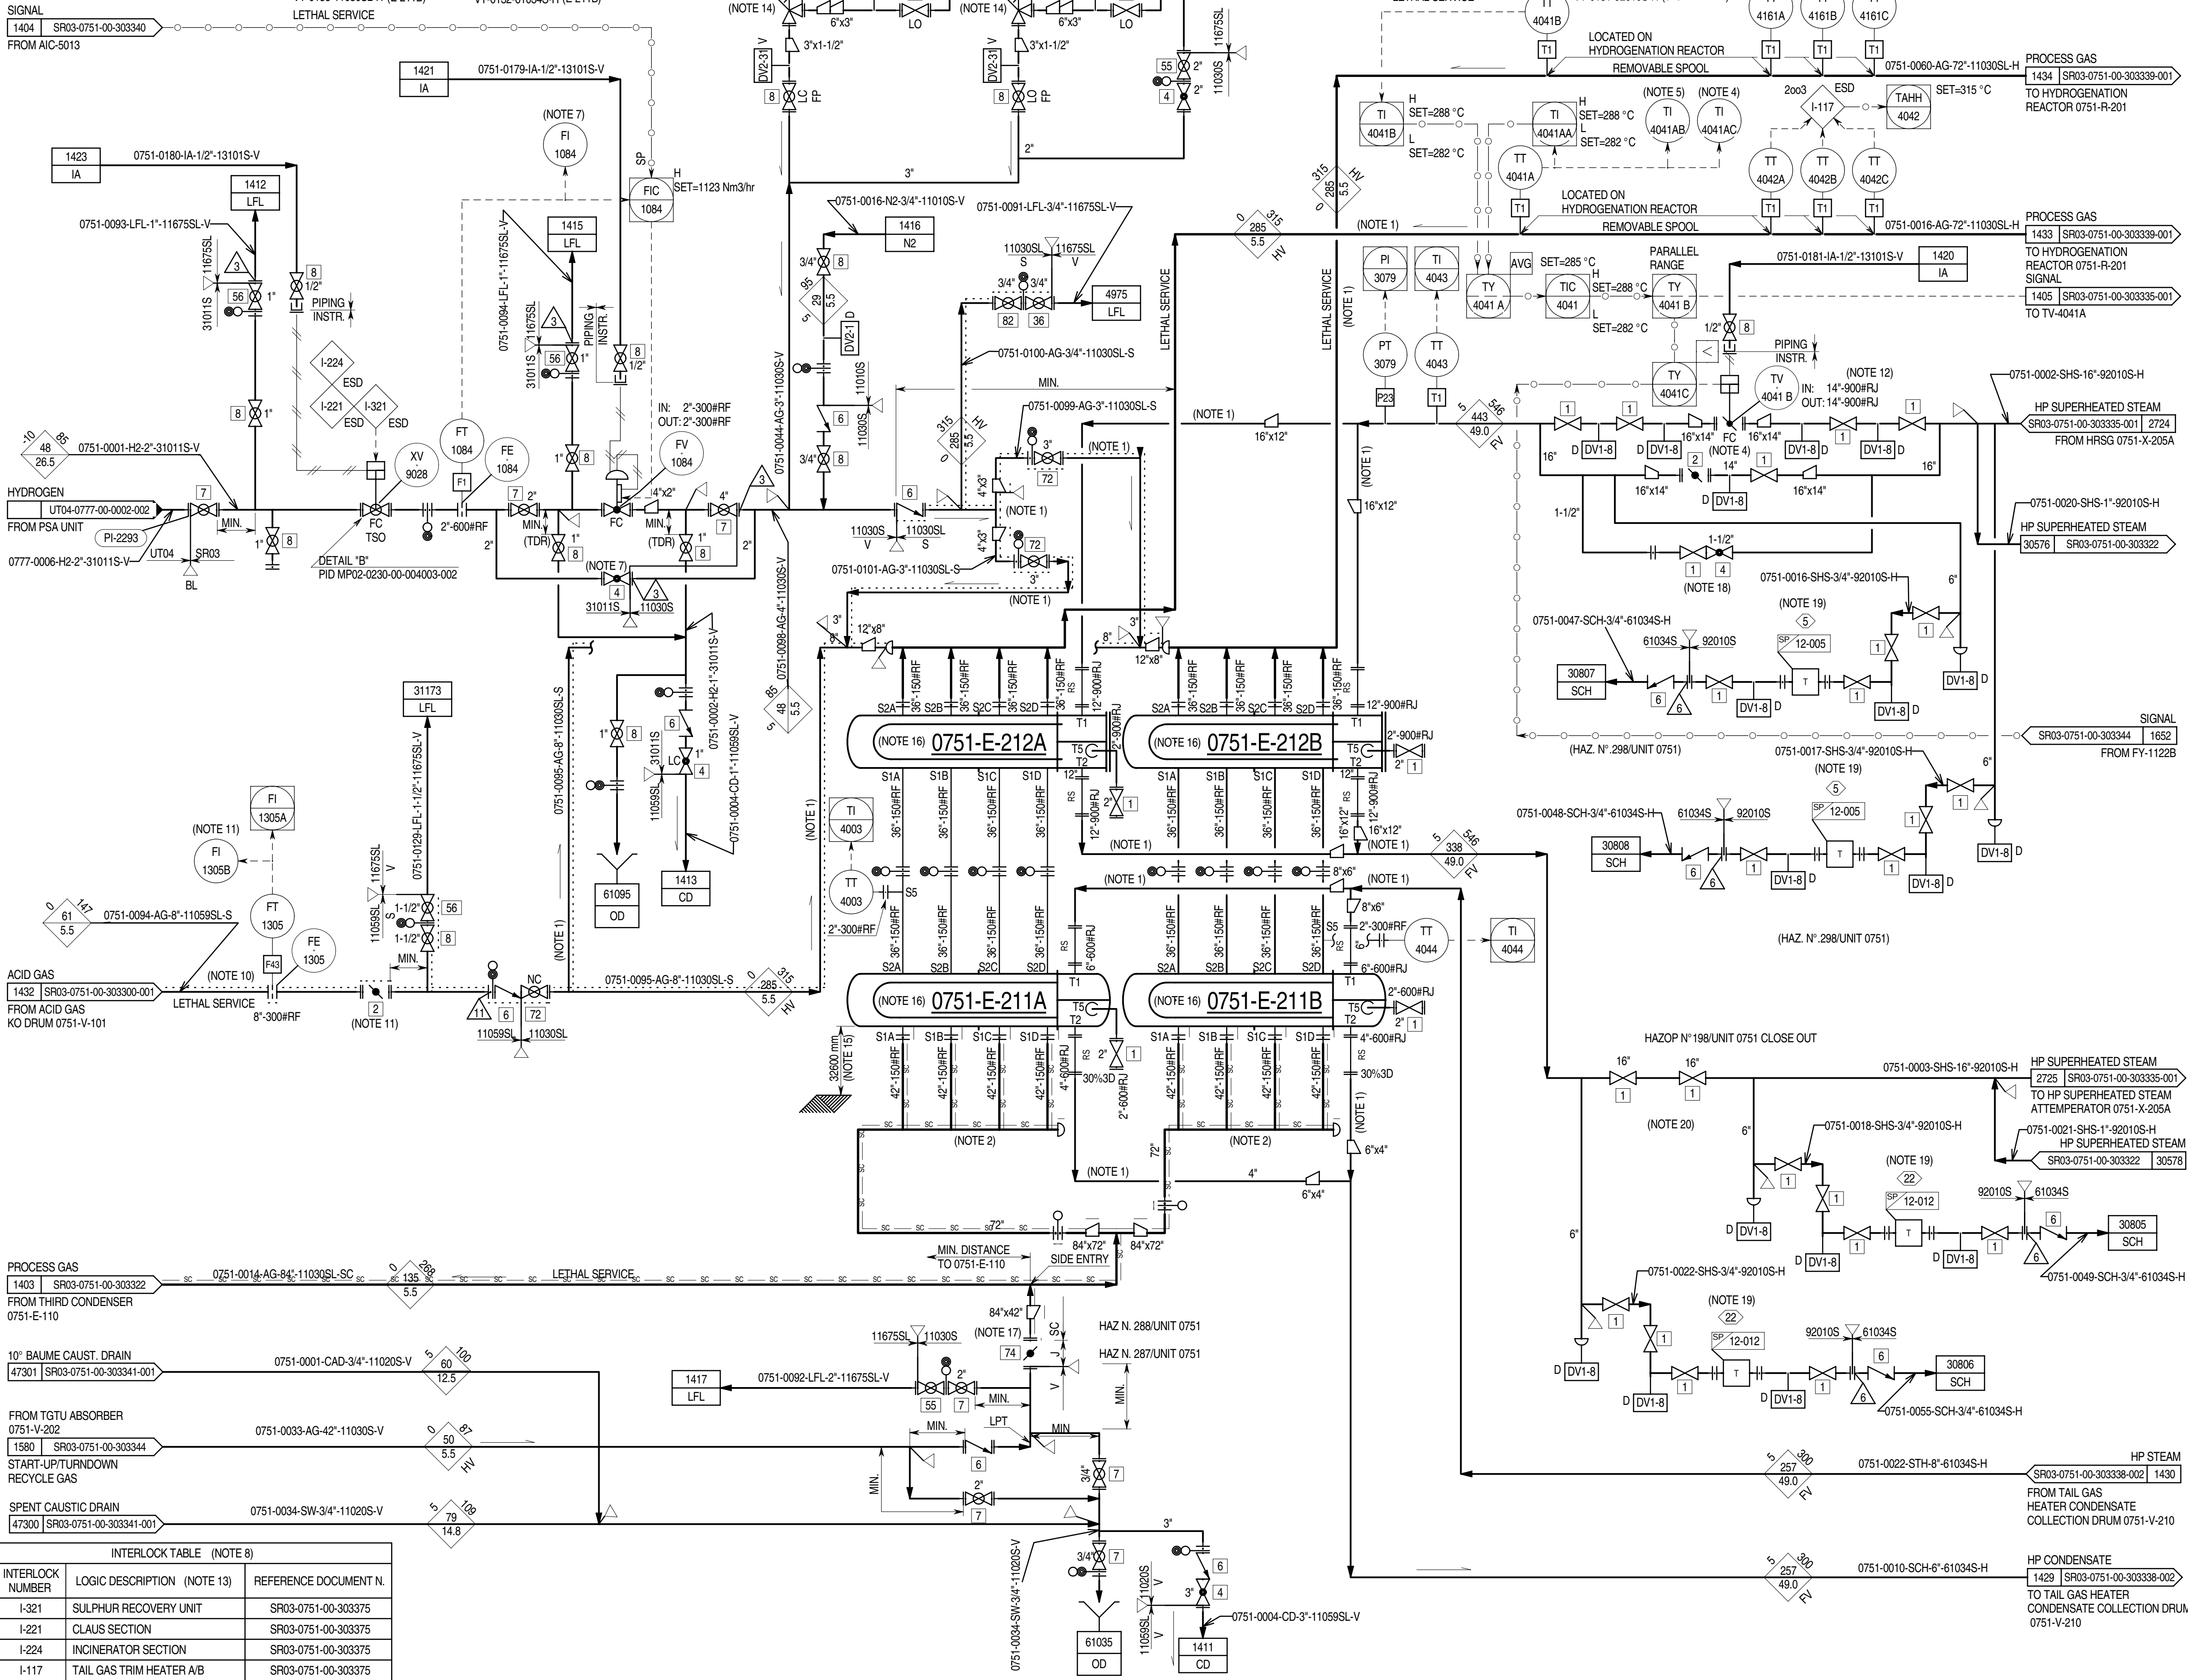

GENERAL NOTES:

- FOR STANDARD SYMBOLS, DETAILS, ABBREVIATIONS, SAMPLE CONNECTION TYPE.
- GENERAL NOTES & LEGEND SHEETS REFER TO DRAWING NO. MP02-0230-00-004000 TO 004015.
- ALL INSTRUMENT TAG NUMBERS ON THIS P&ID INCLUDING PACKAGE UNITS ARE PREFIXED WITH UNIT NUMBERS 0751 UNLESS OTHERWISE NOTED.
- DELETED.
- DELETED.
- SYMMETRICAL PIPING.
- MAXIMUM ALLOWABLE MALDISTRIBUTION BETWEEN FLOW PATHS IS 5%.
- DELETED.
- TI-4041AC TO BE READABLE FROM TV-4041B BYPASS VALVE.
- TI-4041AB TO BE READABLE FROM TV-4041A (ON DRAWING SR03-0751-00-303335-001) BYPASS VALVE.
- DELETED.
- FI-1084 TO BE READABLE FROM FV-1084 BYPASS VALVE.
- INTERLOCK TABLE IS FOR REFERENCE ONLY. CAUSE AND EFFECT MATRIX SR03-0751-00-CCC-303155 SHALL GOVERN.
- DELETED.
- TO BE USED FOR CATALYST PRESULPHIDING.
- FI-1305 TO BE READABLE FROM MANUAL BUTTERFLY VALVE.
- TV-4041B PROVIDED WITH AIR VOLUME TANK ONLY FOR STORAGE FAIL POSITION.
- REFER TO CAUSE AND EFFECT CHART FOR FULL REPRESENTATION OF INTERLOCK INITIATORS AND ACTIONS.
- PSV SIZING CASE: BLOCKED OUTLET.
- 0751-E-211 BOTTOM TANGENT LINE TO BE LOCATED 900mm MIN ABOVE 0751-V-210 HIGH LIQUID LEVEL (ON DRAWING SR03-0751-00-303338-002).
- HEAT EXCHANGER 0751-E-212A/B IS STACKED ABOVE THE HEAT EXCHANGER 0751-E-211A/B.
- 1-1/2" GLOBE VALVE USED FOR WARMUP.
- STEAM TRAP TO BE PROVIDED WITH INTEGRAL INLET STRAINER, OTHERWISE A DEDICATED PIPING STRAINER TO BE INSTALLED UPSTREAM.
- 20 LINE SHALL BE ERECTED AND TESTED WITHOUT INDICATED VALVES AS PER PREVIOUS REVISION OF ISO. VALVES WILL BE INSTALLED ONCE AVAILABLE.

UTILITY REFERENCE TABLE			
OD	DRW. N°	SR03-0751-00-PID-362307	
CD	DRW. N°	SR03-0751-00-PID-362306	
IA	DRW. N°	SR03-0751-00-PID-362305	
LFL	DRW. N°	SR03-0751-00-PID-362313	
N2	DRW. N°	SR03-0751-00-PID-362310	
SCH	DRW. N°	SR03-0751-00-PID-362312	

Z1	04-11-14	IAB	ISSUED FOR AS BUILT	PCA	MAR	ASP
2.1F	18-04-14	IFC	ISSUED FOR CONSTRUCTION	PCA	MAR	ASP
2.1E	28-02-14	IFC	ISSUED FOR CONSTRUCTION	PCA	MAR	ASP
2.1D	09-03-13	IFC	ISSUED FOR CONSTRUCTION	RL	CN	MZ
2.1C	31-10-12	IFC	ISSUED FOR CONSTRUCTION	RL	MF	MZ
2.1B	06-08-12	IFC	ISSUED FOR CONSTRUCTION	DSC	CBR	SIN
2	29-12-11	IFC	ISSUED FOR CONSTRUCTION	DSC	CBR	SIN
1	12-08-11	IFCH	ISSUED FOR CONSTRUCTION WITH HOLDS	DSC	CBR	SIN
0	01-03-11	IFD	ISSUED CLIENT COMMENTS INCORPORATED	BSC	LMA	SIN
B1	30-09-10	ICR	ISSUED FOR CLIENT REVIEW	BSC	LMA	SIN
REV	DATE	STATUS	STATUS DESCRIPTION	BY	CKD	APP.

COMPANY:

Abu Dhabi Gas Development Co. Ltd.



CONTRACTOR:



saipem

JOB No. 032090

PROJECT:

SHAH GAS DEVELOPMENT (SGD) PROJECT

AGREEMENT No. 13525001

DRAWING TITLE: PIPING & INSTRUMENT DIAGRAM UNIT 0751
SULPHUR RECOVERY AND TAIL GAS TREATING UNIT


INTERLOCK TABLE (NOTE 8)		
INTERLOCK NUMBER	LOGIC DESCRIPTION (NOTE 13)	REFERENCE DOCUMENT N.
I-321	SULPHUR RECOVERY UNIT	SR03-0751-00-303375
I-221	CLAUS SECTION	SR03-0751-00-303375
I-224	INCINERATOR SECTION	SR03-0751-00-303375
I-117	TAIL GAS TRIM HEATER A/B	SR03-0751-00-303375

EQUIPMENT DESCRIPTION		FEED HEATERS	
TAGITEM No.	0751-E-211A/B 0751-E-212A/B		
CONTRACTOR DRG. No.	751-GD-B-303338	REV.	Z1
COMPANY DRG. No.	SR03-0751-00-303338-001		
SCALE:	SIZE: A1	DOC. CLASS: 1	

THIS DOCUMENT IS THE PROPERTY OF ABU DHABI GAS DEVELOPMENT COMPANY LIMITED AND CONTAINS INFORMATION WHICH IS PROPRIETARY. THIS INFORMATION IS TO BE HELD IN CONFIDENCE. NO DISCLOSURE OR OTHER USE OF THIS DOCUMENT IS TO BE MADE WITHOUT THE PRIOR WRITTEN CONSENT OF ABU DHABI GAS DEVELOPMENT COMPANY LIMITED.

0751-V-210
TAIL GAS HEATER CONDENSATE COLLECTION DRUM

TYPE: VERTICAL
SIZE: 1200 mm ID x 1800 mm T/T
CAPACITY: 2.5 m³
DESIGN CONDITIONS: 49.0 barg @ 5/300 C & FV @ 100 C
OPER CONDITIONS: 43.7 barg @ 257 C
MATERIAL: CS+1.5mm CA
INSULATION: H
TRIM: VT-0022-61034S-H

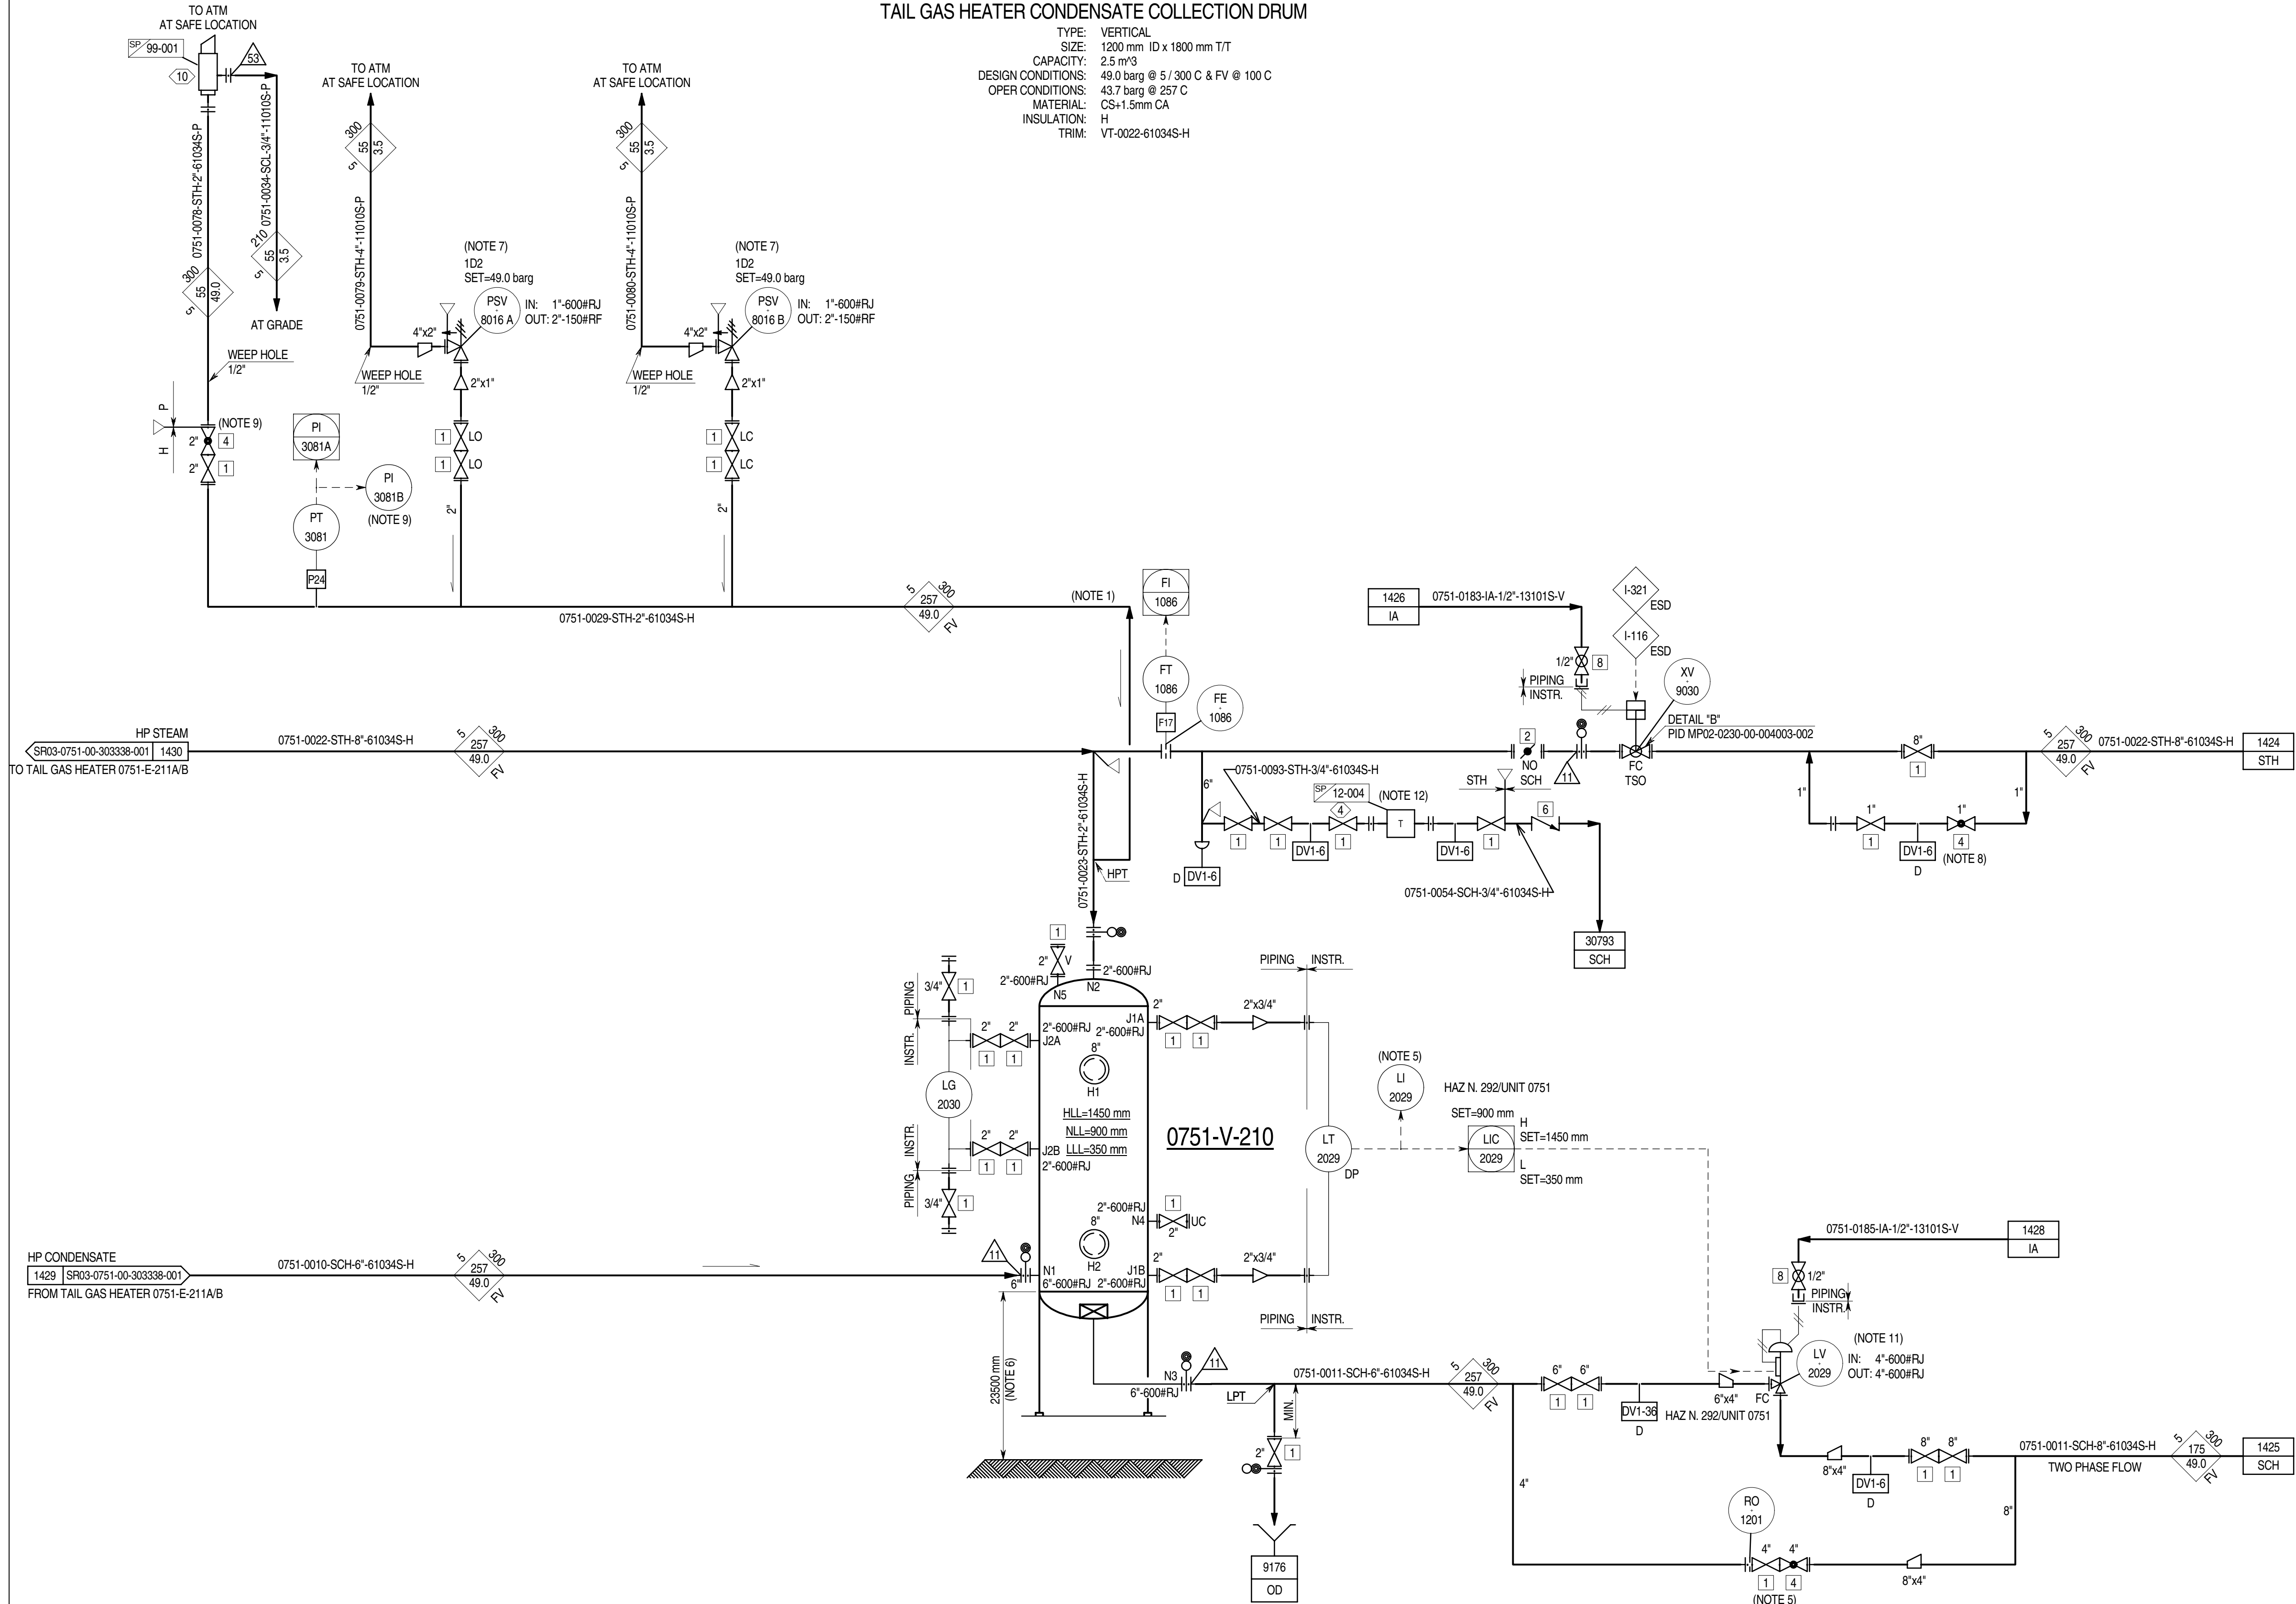

INTERLOCK TABLE (NOTE 4, 10)		
INTERLOCK NUMBER	LOGIC DESCRIPTION	REFERENCE DOCUMENT N.
I-321	SULPHUR RECOVERY UNIT ESD	SR03-0751-00-303375
I-116	TAIL GAS HEATER	SR03-0751-00-303375

- GENERAL NOTES:**
- FOR STANDARD SYMBOLS, DETAILS, ABBREVIATIONS, SAMPLE CONNECTION TYPE, GENERAL NOTES & LEGEND SHEETS REFER TO DRAWING NO. MP02-0230-00-004001 TO 004015.
 - ALL INSTRUMENT TAG NUMBERS ON THIS P&ID INCLUDING PACKAGE UNITS ARE PREFIXED WITH UNIT NUMBERS 0751 UNLESS OTHERWISE NOTED.
 - DELETED.
- NOTES:**
- LOCATE PSV VENT CONNECTION AT HIGH POINT.
 - DELETED.
 - DELETED.
 - INTERLOCK TABLE IS FOR REFERENCE ONLY. CAUSE AND EFFECT MATRIX SR03-0751-00-CCC-303155 SHALL GOVERN.
 - LI-2029 TO BE READABLE FROM LV-2029 BYPASS VALVE.
 - 0751-E-211A/B BOTTOM TANGENT LINE (ON DRAWING SR03-0751-00-303338-001) TO BE LOCATED 900mm MIN. ABOVE 0751-V-210 HIGH LIQUID LEVEL.
 - PSV SIZING CASE: FIRE.
 - GLOBE VALVE USED FOR WARM UP.
 - PI-3081B TO BE READABLE FROM PSV-8016A/B MANUAL VENT VALVE.
 - REFER TO CAUSE AND EFFECT CHART FOR FULL REPRESENTATION OF INTERLOCK INITIATIONS AND ACTIONS.
 - VALVE 0751-LV-2029 TO BE PROVIDED WITH LOCAL SIGN: "WARNING: TRIM SIZE AFFECTS RELIEF VALVE CAPACITY".
 - STEAM TRAP TO BE PROVIDED WITH INTEGRAL INLET STRAINER OTHERWISE A DEDICATED PIPING STRAINER TO BE INSTALLED UPSTREAM.

UTILITY REFERENCE TABLE			
IA	DRW. N°:	SR03-0751-00-PID-362305	
STH / SCH	DRW. N°:	SR03-0751-00-PID-362312	
OD	DRW. N°:	SR03-0751-00-PID-362307	

Z1	04-11-14	IAB	ISSUED FOR AS BUILT	PCA	MAR	ASP
2.1F	18-04-14	IFC	ISSUED FOR CONSTRUCTION	PCA	MAR	ASP
2.1E	28-02-14	IFC	ISSUED FOR CONSTRUCTION	PCA	MAR	ASP
2.1D	01-05-13	IFC	ISSUED FOR CONSTRUCTION	RL	CN	MZ
2.1C	31-10-12	IFC	ISSUED FOR CONSTRUCTION	RL	MF	MZ
2.1B	06-08-12	IFC	ISSUED FOR CONSTRUCTION	DSC	CBR	SIN
2	29-12-11	IFC	ISSUED FOR CONSTRUCTION	DSC	CBR	SIN
1	12-08-11	IFCH	ISSUED FOR CONSTRUCTION WITH HOLDS	DSC	CBR	SIN
0	01-03-11	IFD	ISSUED CLIENT COMMENTS INCORPORATED	BSC	LMA	SIN
B1	30-09-10	ICR	ISSUED FOR CLIENT REVIEW	BSC	LMA	SIN
REV	DATE	STATUS	STATUS DESCRIPTION	BY	CKD	APP.

COMPANY:
Abu Dhabi Gas Development Co. Ltd.



CONTRACTOR:



JOB No. 032090

PROJECT: SHAH GAS DEVELOPMENT (SGD) PROJECT

AGREEMENT No. 13525001

DRAWING TITLE: PIPING & INSTRUMENT DIAGRAM UNIT 0751
SULPHUR RECOVERY AND TAIL GAS TREATING UNIT

EQUIPMENT DESCRIPTION	TAIL GAS HEATER CONDENSATE DRUM	
TAGITEM No.	0751-V-210	

CONTRACTOR DRG.No.		751-GD-B-303338		REV. Z1
COMPANY DRG.No.		SR03-0751-00-303338-002		
SCALE:	SIZE:	A1	DOC. CLASS: 1	


THIS DOCUMENT IS THE PROPERTY OF ABU DHABI GAS DEVELOPMENT COMPANY LIMITED AND CONTAINS INFORMATION WHICH IS PROPRIETARY. THIS INFORMATION IS TO BE HELD IN CONFIDENCE. NO DISCLOSURE OR OTHER USE OF THIS DOCUMENT IS TO BE MADE WITHOUT THE PRIOR WRITTEN CONSENT OF ABU DHABI GAS DEVELOPMENT COMPANY LIMITED.

0751-R-201
HYDROGENATION REACTOR

TYPE: HORIZONTAL
SIZE: 7700 mm ID x 30800 mm T/T
CAPACITY: 585247 m3/h
DESIGN CONDITIONS: 5.5 barg @ 0 / 369 C & HV @ 369 C
OPER CONDITIONS: 0.3 barg @ 285 C
MATERIAL: CS-3mm / INTERNAL REFRACTORY LINED: 50mm
INSULATION: RH
TRIM: VT-0089-31059SL-H
LETHAL SERVICE

TABLE 1

TW	TE
TW-4125	TE-4125A to C
TW-4126	TE-4126A to C
TW-4127	TE-4127A to C
TW-4128	TE-4128A to C
TW-4129	TE-4129A to C
TW-4130	TE-4130A to C
TW-4131	TE-4131A to C
TW-4132	TE-4132A to C
TW-4133	TE-4133A to C
TW-4134	TE-4134A to C
TW-4135	TE-4135A to C
TW-4136	TE-4136A to C
TW-4137	TE-4137A to C
TW-4138	TE-4138A to C
TW-4139	TE-4139A to C
TW-4140	TE-4140A to C
TW-4141	TE-4141A to C
TW-4142	TE-4142A to C
TW-4143	TE-4143A to C
TW-4144	TE-4144A to C

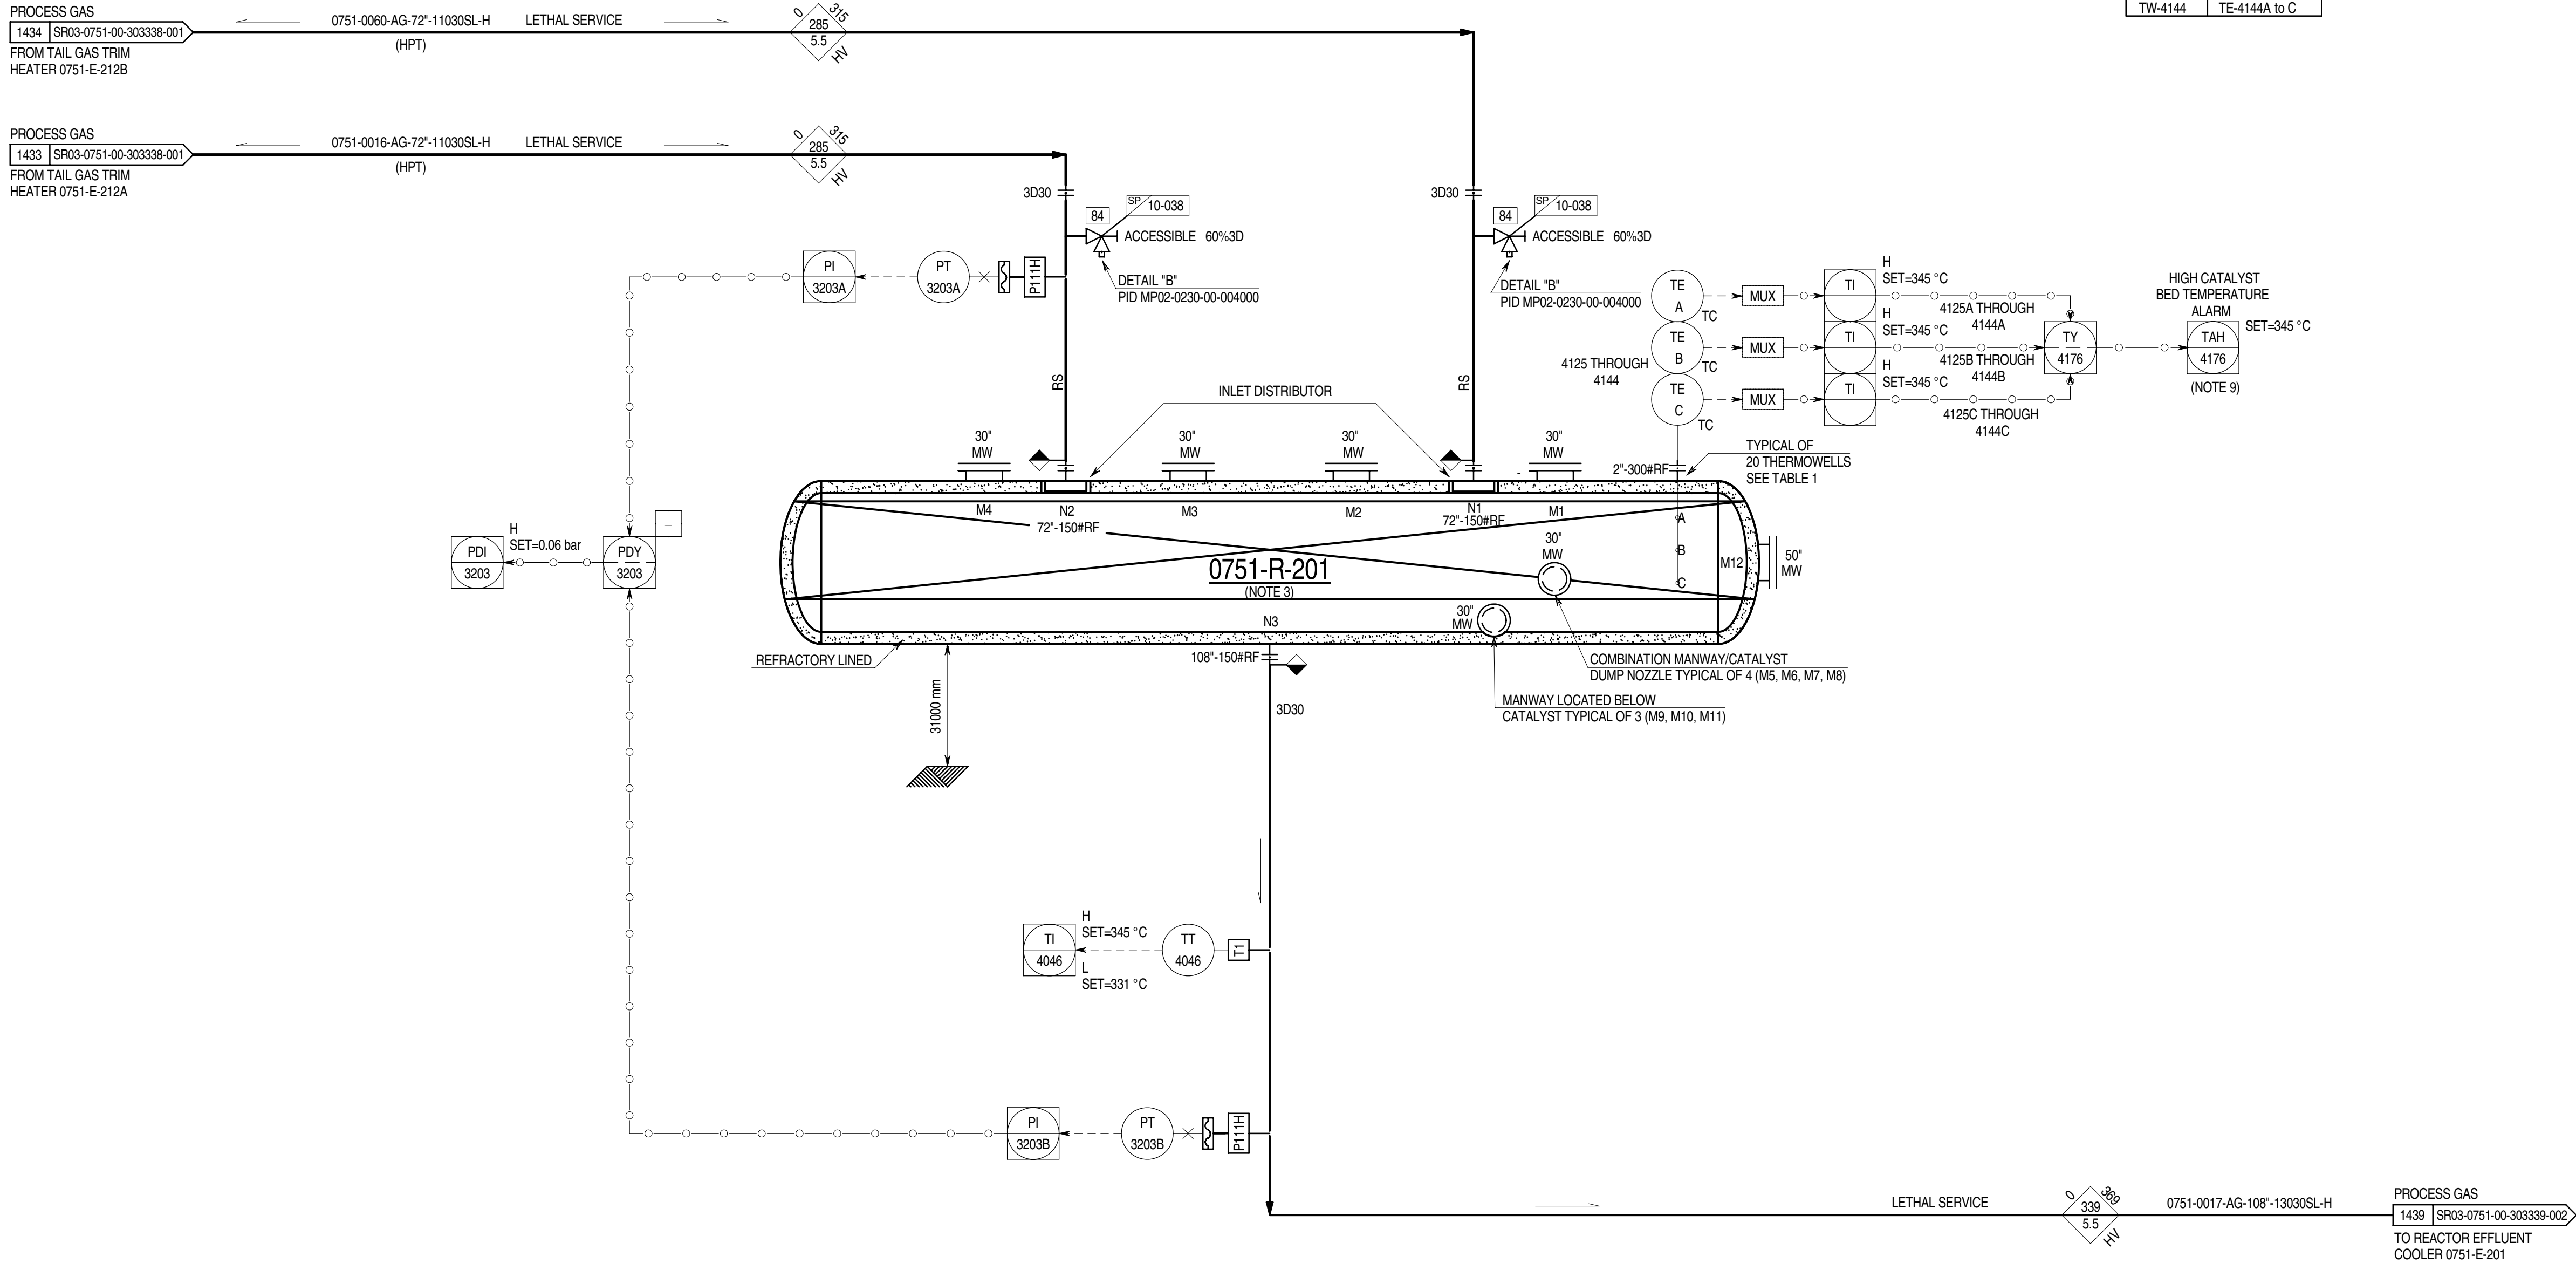

- GENERAL NOTES:**
- FOR STANDARD SYMBOLS, DETAILS, ABBREVIATIONS, SAMPLE CONNECTION TYPE, GENERAL NOTES & LEGEND SHEETS REFER TO DRAWING NO. MP02-0230-00-004000 TO 004015.
 - ALL INSTRUMENT TAG NUMBERS ON THIS P&ID INCLUDING PACKAGE UNITS ARE PREFIXED WITH UNIT NUMBER 0751 UNLESS OTHERWISE NOTED.
 - DELETED.
- NOTES:**
- DELETED.
 - DELETED.
 - SEE DATASHEET FOR REFRACTORY LINING DETAILS.
 - DELETED.
 - DELETED.
 - TAH-4176 IS ACTIVE WHEN AT LEAST 15 OUT OF 60 TEMPERATURE ELEMENTS DETECT HIGH TEMPERATURE.

Z1	04-11-14	IAB	ISSUED FOR AS BUILT	PCA	MAR	ASP
2.1F	18-04-14	IFC	ISSUED FOR CONSTRUCTION	PCA	MAR	ASP
2.1E	28-02-14	IFC	ISSUED FOR CONSTRUCTION	PCA	MAR	ASP
2.1D	15-06-13	IFC	ISSUED FOR CONSTRUCTION	RL	MS	AS
2.1C	01-05-13	IFC	ISSUED FOR CONSTRUCTION	RL	CN	MZ
2.1B	06-08-12	IFC	ISSUED FOR CONSTRUCTION	DSC	CBR	SIN
2	29-12-11	IFC	ISSUED FOR CONSTRUCTION	DSC	CBR	SIN
1	12-08-11	IFCH	ISSUED FOR CONSTRUCTION WITH HOLDS	DSC	CBR	SIN
0	01-03-11	IFD	ISSUED CLIENT COMMENTS INCORPORATED	BSC	LMA	SIN
B1	30-09-10	ICR	ISSUED FOR CLIENT REVIEW	BSC	LMA	SIN
REV	DATE	STATUS	STATUS DESCRIPTION	BY	CKD	APP.

COMPANY:

Abu Dhabi Gas Development Co. Ltd.

CONTRACTOR:

PROJECT:

SHAH GAS DEVELOPMENT (SGD) PROJECT

AGREEMENT No. 13525001

DRAWING TITLE: PIPING & INSTRUMENT DIAGRAM UNIT 0751
SULPHUR RECOVERY AND TAIL GAS TREATING UNIT

EQUIPMENT DESCRIPTION	HYDROGENATION REACTOR
TAGITEM No.	0751-R-201

CONTRACTOR DRG.No.	751-GD-B-303339	REV. Z1
COMPANY DRG.No.	SR03-0751-00-303339-001	
SCALE:	SIZE: A1	DOC. CLASS: 1


THIS DOCUMENT IS THE PROPERTY OF ABU DHABI GAS DEVELOPMENT COMPANY LIMITED AND CONTAINS INFORMATION WHICH IS PROPRIETARY. THIS INFORMATION IS TO BE HELD IN CONFIDENCE. NO DISCLOSURE OR OTHER USE OF THIS DOCUMENT IS TO BE MADE WITHOUT THE PRIOR WRITTEN CONSENT OF ABU DHABI GAS DEVELOPMENT COMPANY LIMITED.

0751-E-201 REACTOR EFFLUENT COOLER

TYPE: FIXED TUBESHEET SPECIAL
TEMA TYPE: 22000 Mcal/hr
DESIGN DUTY: 9733.0 m²
HEAT TRANSFER AREA:
SHELL: 5.5 barg @ 5/210 C & FV @ 100 C
TUBE: 5.5 barg @ 0/343 C & HV @ 343 C (METAL)
OPER CONDITIONS (IN): 6.000 barg @ 165.0 C
(OUT): 5.500 barg @ 162.0 C
MATERIAL: CS+3mm CA (PWHT)
INSULATION: H
TRIM: VT-0072-31034S-H
VT-0023-11030SL-H
LETHAL SERVICE

0751-J-201 START-UP EJCTOR

DESIGN CONDITIONS: 49 barg @ 0.900 C & FV @ 100 C
LETHAL SERVICE

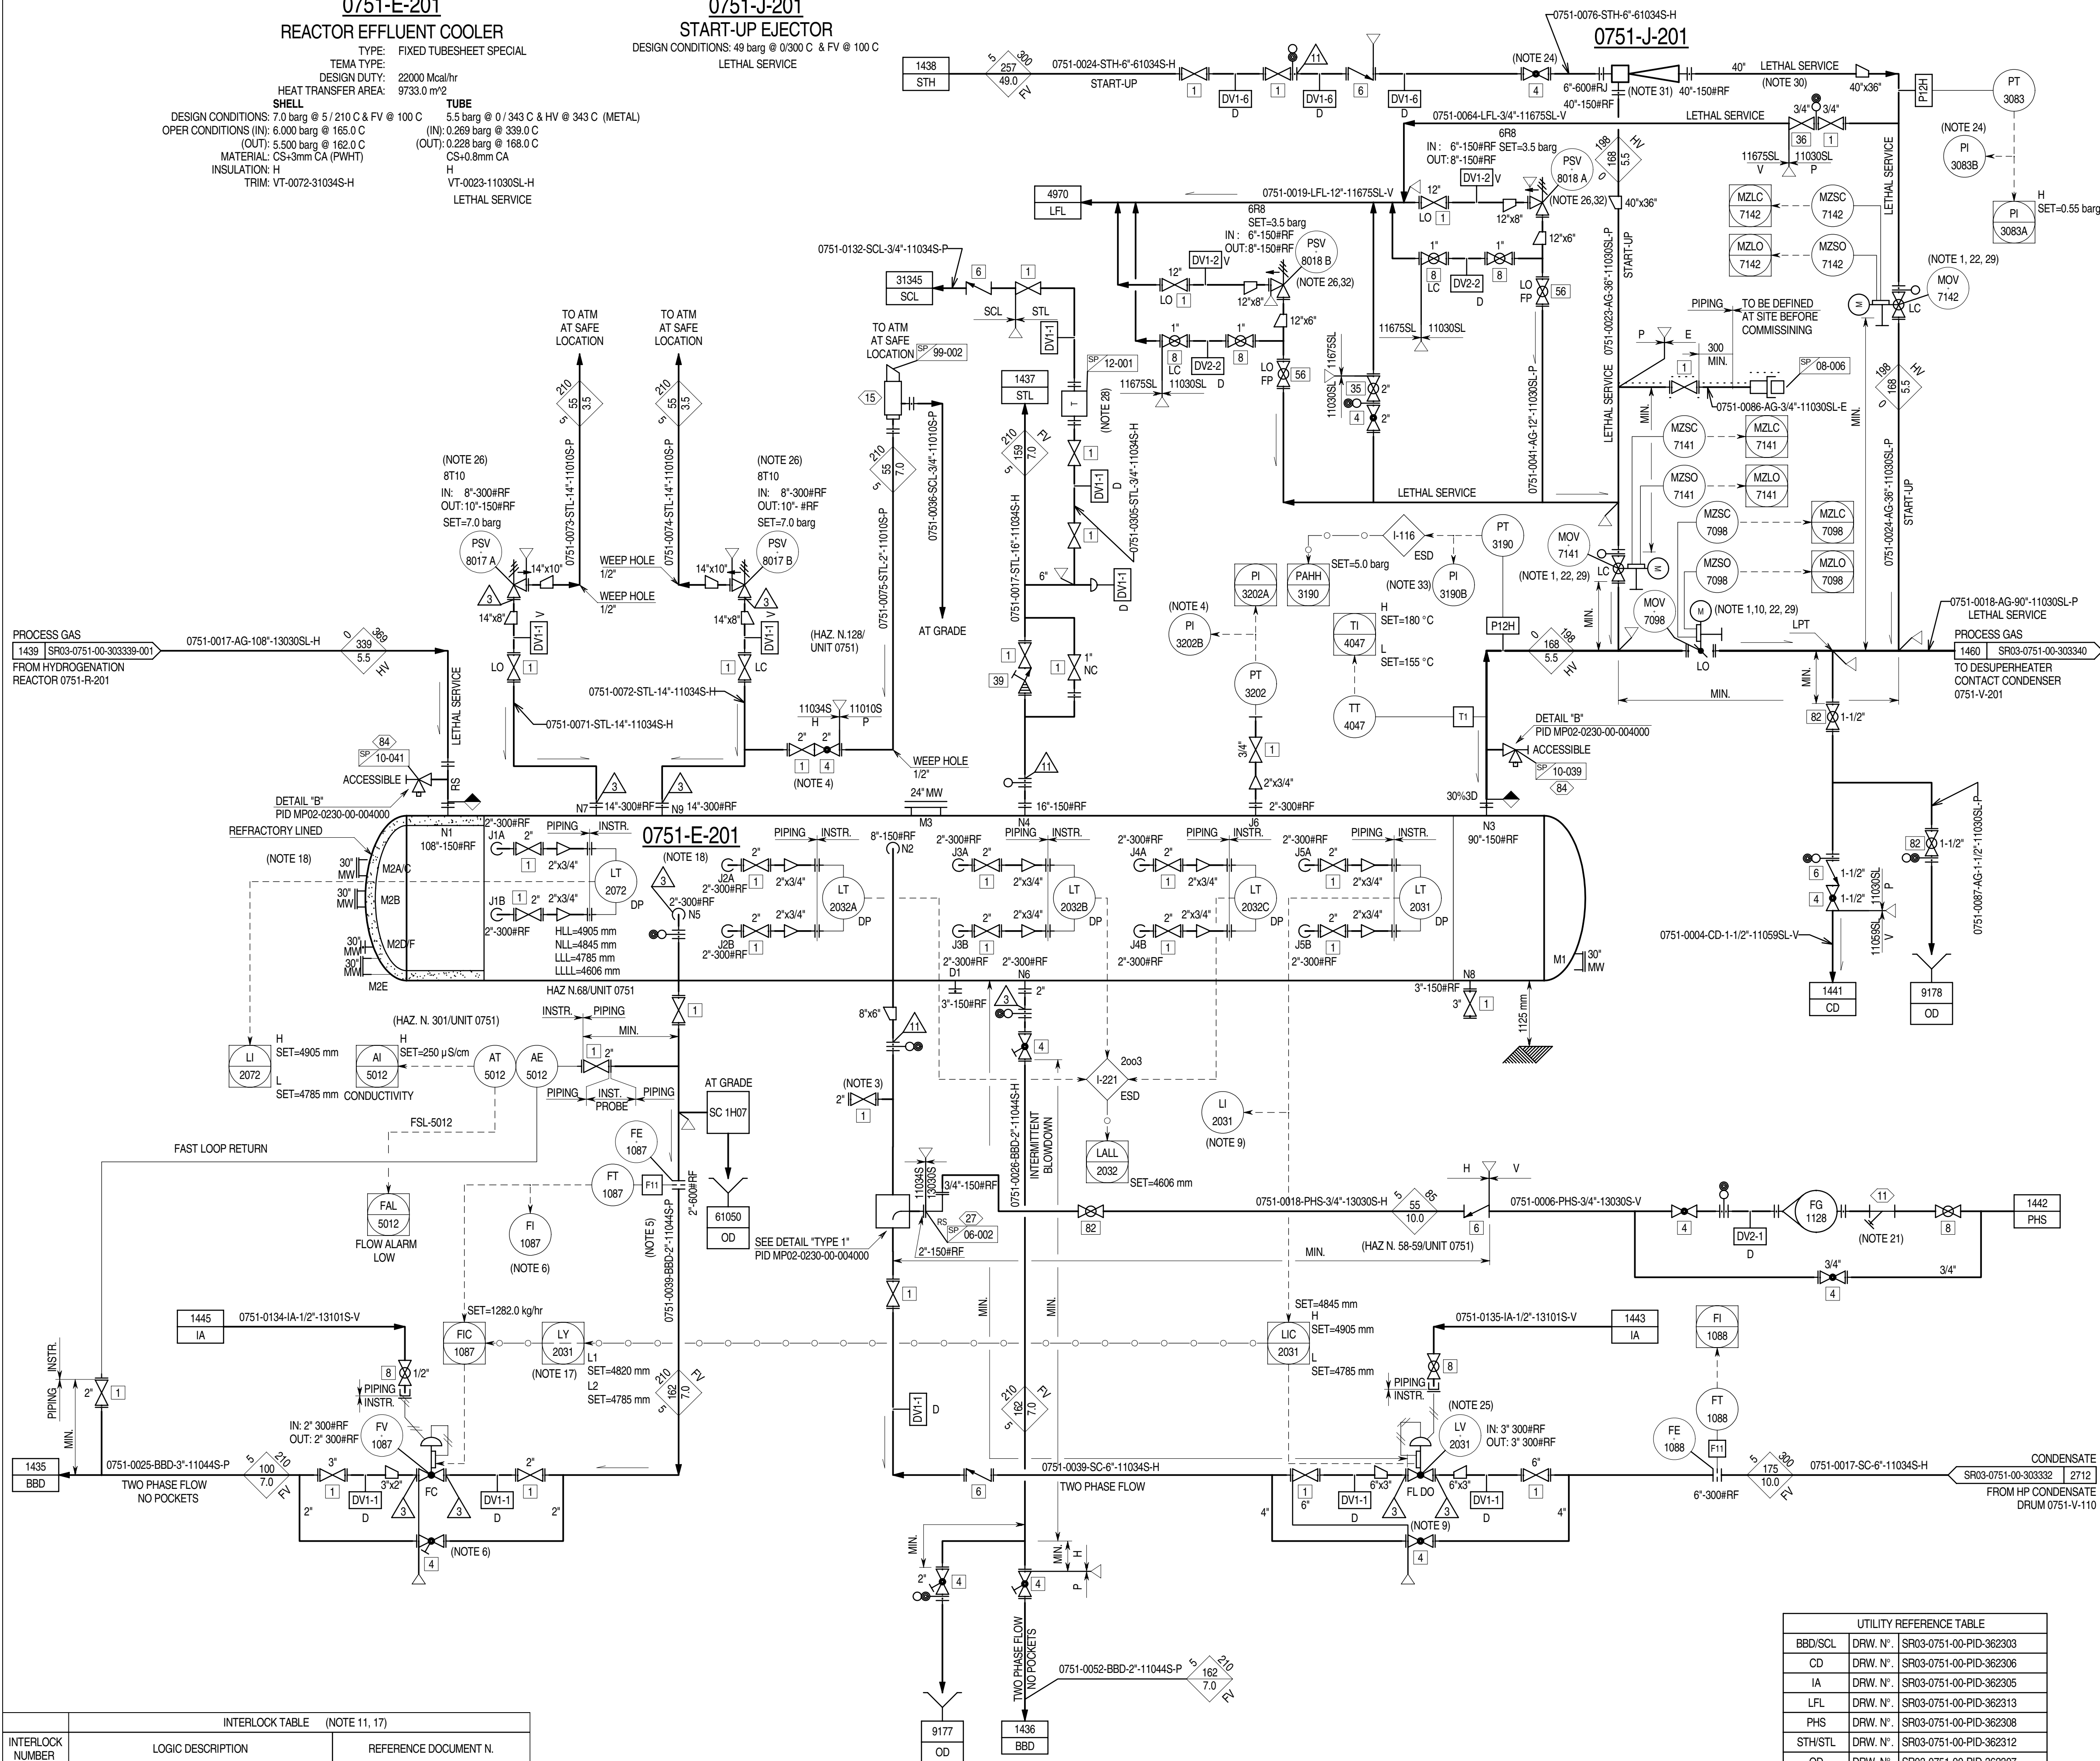

GENERAL NOTES:

- FOR STANDARD SYMBOLS, DETAILS, ABBREVIATIONS, SAMPLE CONNECTION TYPE, GENERAL NOTES & LEGEND SHEETS REFER TO DRAWING NO. MP02-0230-00-004000 TO 004015.
 - ALL INSTRUMENT TAG NUMBERS ON THIS P&ID INCLUDING PACKAGE UNITS ARE PREFIXED WITH UNIT NUMBER 0751 UNLESS OTHERWISE NOTED.
 - DELETED.
- NOTES:
- MOV-7141/7142/7098 ARE NOT ACTUATED BY DCS. MOV-7141 AND MOV-7142 MUST BE FULLY OPEN BEFORE TO CLOSE MOV-7098 (ACTUATED IN FIELD BY OPERATOR).
 - DELETED. (HAZ N.128/UNIT 0751)
 - ACID WASH CONNECTION.
 - PI-3202B TO BE READABLE FROM PSV-8017A/B MANUAL VENT.
 - CONTINUOUS BLOWDOWN.
 - FI-1087 TO BE READABLE FROM FV-1087 BYPASS VALVE.
 - DELETED.
 - DELETED.
 - LI-2031 TO BE READABLE FROM LV-2031 BYPASS VALVE.
 - VALVE LOCATED AT HIGH POINT 500mm. ABOVE INLET NOZZLE ON 0751-V-201 (DRW N. SR03-0751-00-303340).
 - INTERLOCK TABLE IS FOR REFERENCE ONLY CAUSE AND EFFECT MATRIX SR03-0751-00-CCC-303155 SHALL GOVERN.
 - DELETED.
 - DELETED.
 - DELETED.
 - DELETED. (HAZ N.128/UNIT 0751)
 - DELETED.
 - WHEN LIQUID LEVEL DETECTED BY LIC-2031 REDUCES TO L2 (LY-2031) THE CONTINUOUS BLOWDOWN FLOW CONTROL WILL GO TO MANUAL AND ZERO OUTPUT. CLOSING FLOW CONTROL VALVE FV-1087. AS LIQUID LEVEL RAISES TO L1 (LY-2031), ANOTHER ALARM WILL SOUND AND THE OPERATOR WILL SWITCH BLOWDOWN FLOW CONTROL BACK TO AUTO.
 - SEE DATASHEET FOR REFRACTORY LINING DETAILS.
 - DELETED.
 - DELETED.
 - STRAINER WITH SCREEN 20 MESH.
 - MOV TO BE PROVIDED WITH OPEN/CLOSE/STOP LOCAL CONTROLS.
 - DELETED.
 - PI-3083B TO BE READABLE FROM GLOBE VALVE ON STEAM LINE.
 - LOCATE LV-2031 AT GRADE AT MINIMUM DISTANCE FROM 0751-E-201.
 - PSV SIZING CASE: BLOCKED OUTLET.
 - REFER TO CAUSE AND EFFECT CHART FOR FULL REPRESENTATION OF INTERLOCK INITIATORS AND ACTIONS.
 - STEAM TRAP TO BE PROVIDED WITH INTEGRAL INLET STRAINER, OTHERWISE A DEDICATED PIPING STRAINER TO BE INSTALLED UPSTREAM.
 - MOV-7141/7142/7098 ARE KEY INTERLOCKED VALVES. (HAZ N. 309/UNIT 0751).
 - AS PER VENDOR REQUIREMENT PROVIDE 5 METER MINIMUM OF 40" PIPE.
 - EJECTORS SHALL BE NOISE INSULATED AT SITE BY CONTRACTOR.
 - A COMMON WAREHOUSE SPARE 0751-PSV-8018Z IS PROVIDED FOR UNITS 0751/0752/0753 AND 0754.
 - 075-PI-3190B SHALL BE LOCATED CLOSE TO 0751-PI3202B.

Z1	04-11-14	IAB	ISSUED FOR AS BUILT	PCA	MAR	ASP
2.1F	18-04-14	IFC	ISSUED FOR CONSTRUCTION	PCA	MAR	ASP
2.1E	28-02-14	IFC	ISSUED FOR CONSTRUCTION	PCA	MAR	ASP
2.1D	05-05-13	IFC	ISSUED FOR CONSTRUCTION	RL	MS	AS
2.1C	10-03-13	IFC	ISSUED FOR CONSTRUCTION	RL	CN	MZ
2.1B	06-08-12	IFC	ISSUED FOR CONSTRUCTION	DSC	CBR	SIN
2	29-12-11	IFC	ISSUED FOR CONSTRUCTION	DSC	CBR	SIN
1	12-08-11	IFCH	ISSUED FOR CONSTRUCTION WITH HOLDS	DSC	CBR	SIN
0	01-03-11	IFD	ISSUED CLIENT COMMENTS INCORPORATED	BSC	LMA	SIN
B1	30-09-10	ICR	ISSUED FOR CLIENT REVIEW	BSC	LMA	SIN
REV	DATE	STATUS	STATUS DESCRIPTION	BY	CKD	APP.

COMPANY:

Abu Dhabi Gas Development Co. Ltd.

الحصن للغاز
Al Hosn Gas

CONTRACTOR:

eni saipem

JOB No. 032090

PROJECT:

SHAH GAS DEVELOPMENT (SGD) PROJECT


AGREEMENT No. 13525001

DRAWING TITLE:

PIPING & INSTRUMENT DIAGRAM UNIT 0751
SULPHUR RECOVERY AND TAIL GAS TREATING UNIT

EQUIPMENT DESCRIPTION	REACTOR EFFLUENT COOLER
TAGITEM No.	0751-E-201 0751-J-201

CONTRACTOR DRG. No.	751-GD-B-303339	REV.	Z1
COMPANY DRG. No.	SR03-0751-00-303339-002		
SCALE:	SIZE: A1	DOC. CLASS: 1	

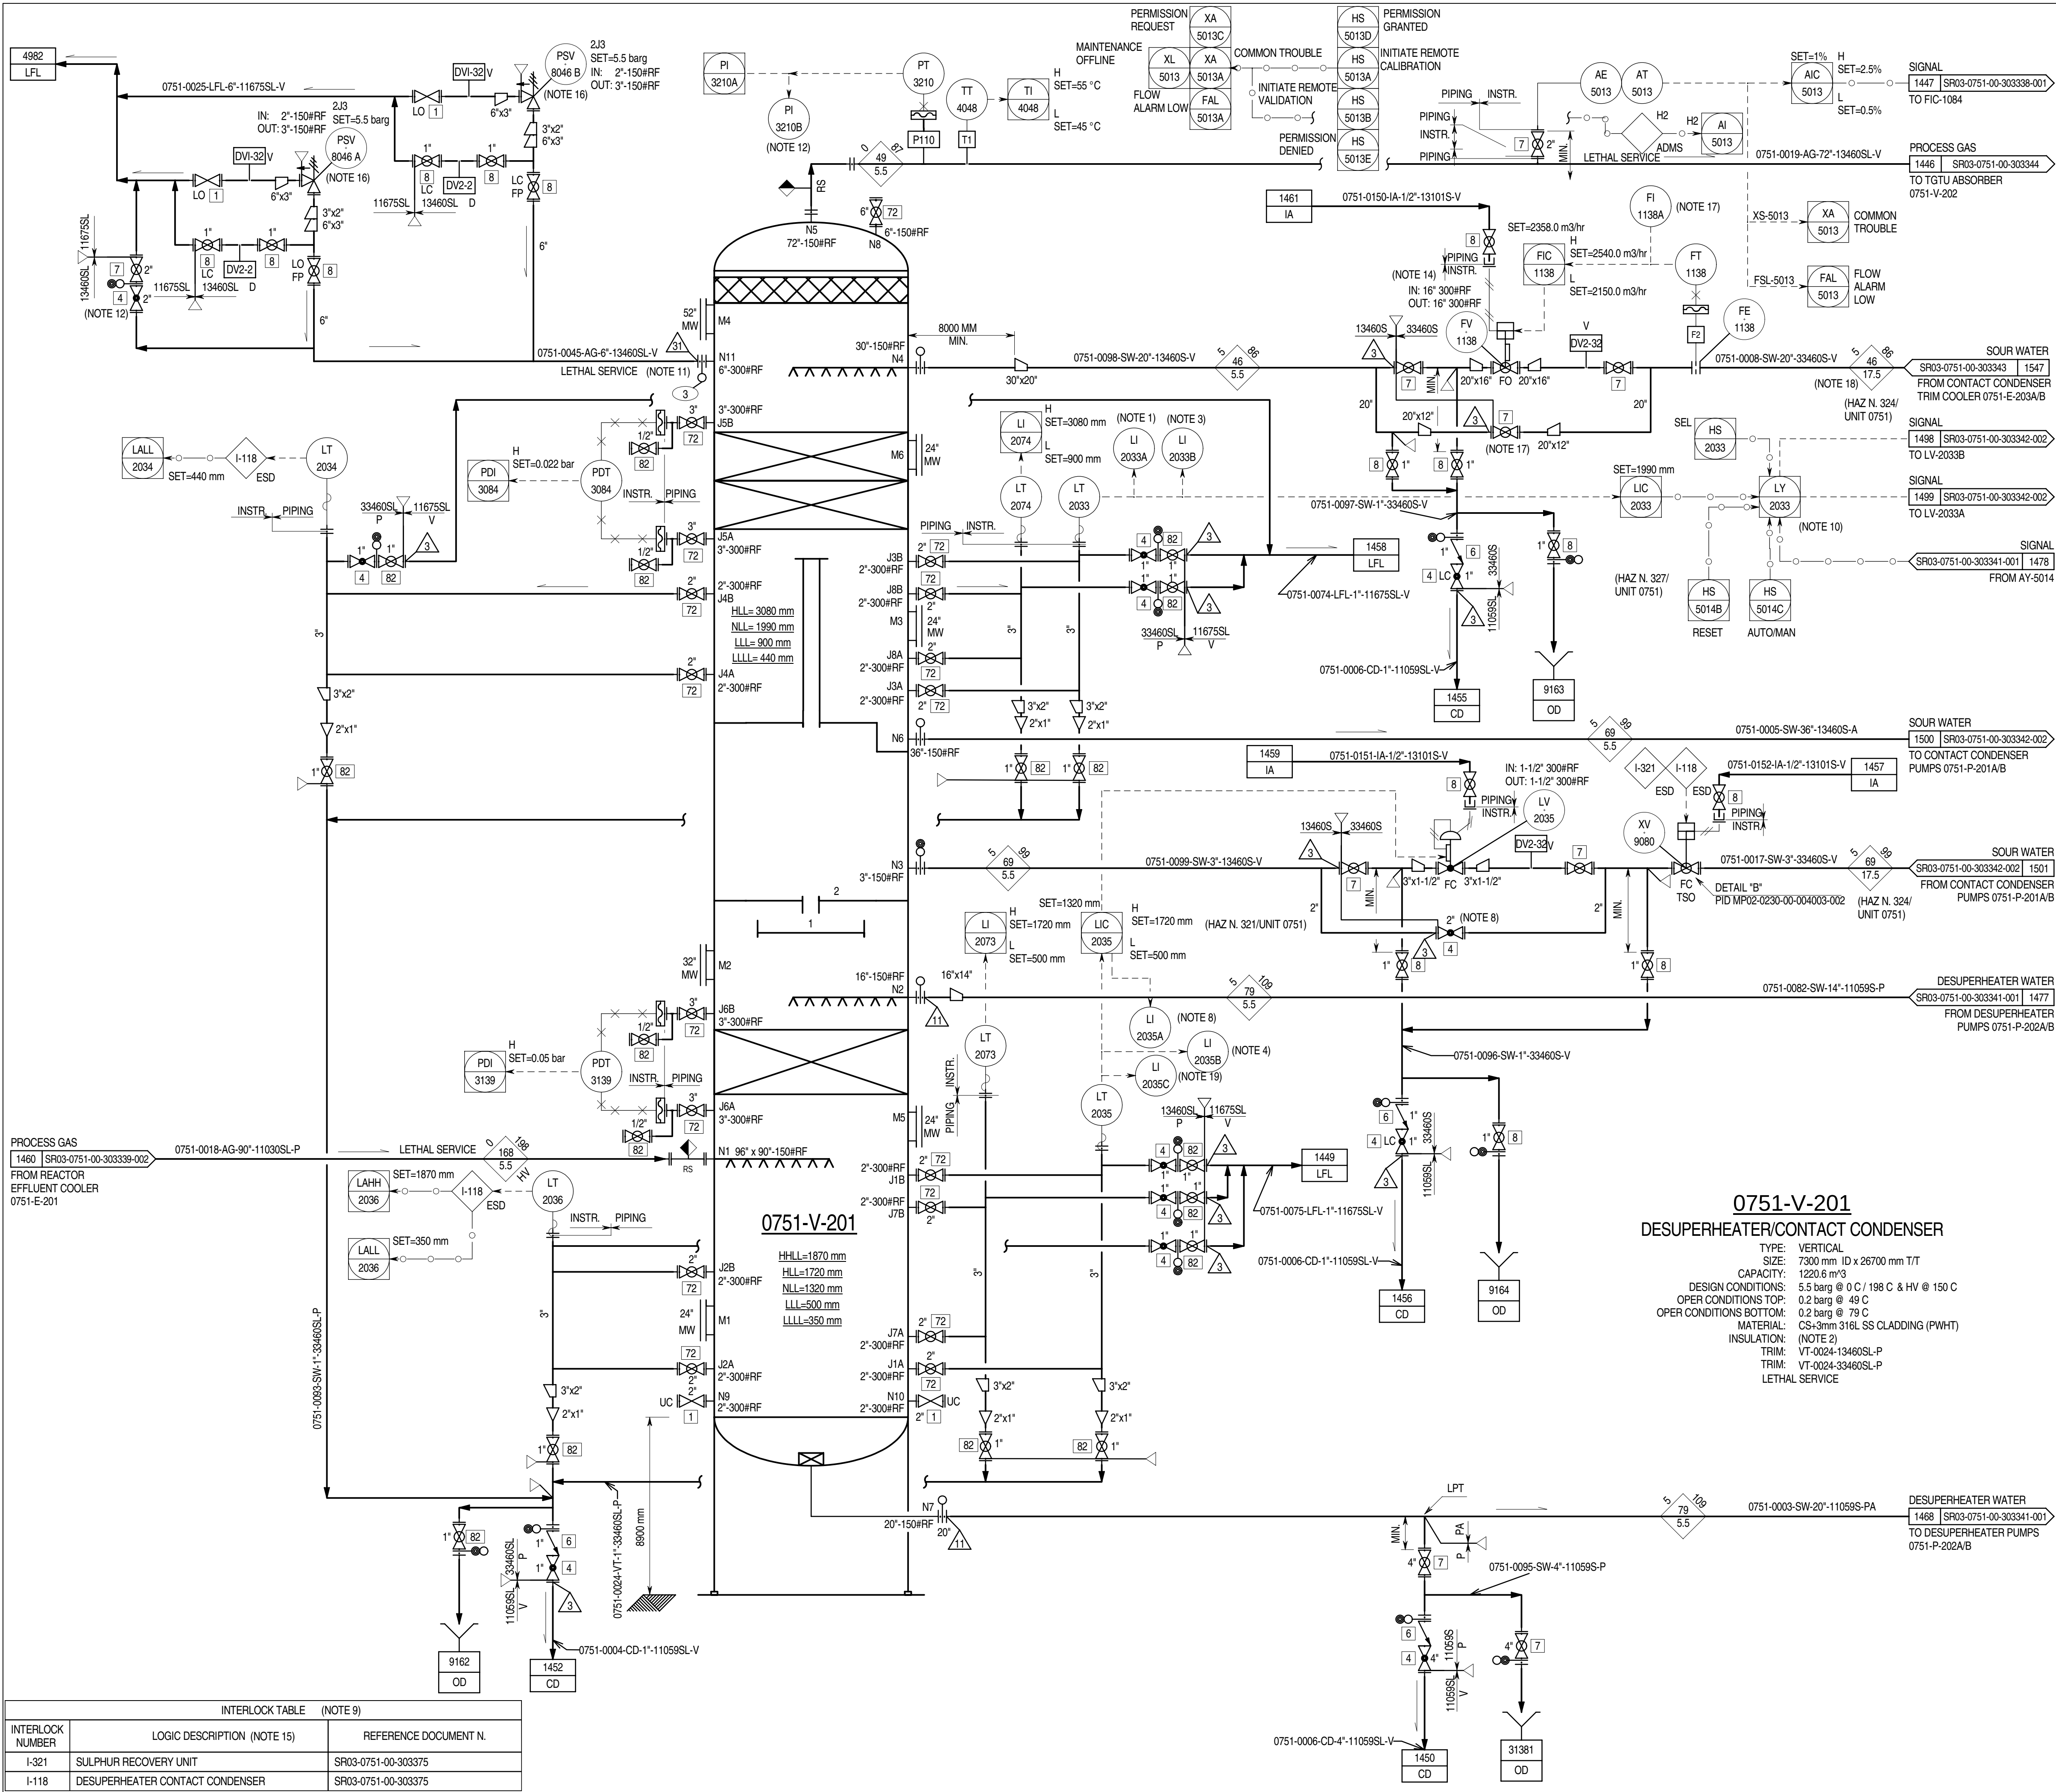

GENERAL NOTES:

1. FOR STANDARD SYMBOLS, DETAILS, ABBREVIATIONS, SAMPLE CONNECTION TYPE, GENERAL NOTES & LEGEND SHEETS REFER TO DRAWING NO. MP02-0230-00-004000 TO 004015.
2. ALL INSTRUMENT TAG NUMBERS ON THIS P&ID INCLUDING PACKAGE UNITS ARE PREFIXED WITH UNIT NUMBER 0751 UNLESS OTHERWISE NOTED.
3. DELETED.

NOTES:

1. LI-2033A TO BE READABLE FROM LV-2033A BYPASS VALVE ON DRAWING SR03-0751-00-303342-002.
2. PERSONNEL PROTECTION IS REQUIRED UP TO TOP OF THE UPPER PACKING. INSULATION IS NOT REQUIRED FOR THE TOP PORTION.
3. LI-2033B TO BE READABLE FROM LV-2033B BYPASS VALVE ON DRAWING SR03-0751-00-303342-002.
4. LI-2035B TO BE READABLE FROM HV-7109 AND HV-7110 ON DRAWING SR03-0751-00-303341-001.
5. DELETED.
6. DELETED.
7. DELETED.
8. LI-2035A TO BE READABLE FROM LV-2035 BYPASS VALVE.
9. INTERLOCK TABLE IS FOR REFERENCE ONLY. CAUSE AND EFFECT CHART SR03-0751-00-CCC-203155 SHALL GOVERN.
10. LOW pH SIGNAL FROM THE SELECTED ANALYZER WILL SWITCH LEVEL CONTROL TO LV-2033B, RESET IS REQUIRED TO RETURN CONTROL TO LV-2033A.
11. SPACER TO BE PROVIDED REGARDLESS OF NOZZLE SIZE.
12. PI-3210B TO BE READABLE FROM PSV-3046/A MANUAL VENT.
13. DELETED.
14. FV-1138 PROVIDED WITH AIR VOLUME TANK ONLY FOR STROKE FAULT POSITION.
15. REFER TO CAUSE AND EFFECT CHART FOR FULL REPRESENTATION OF INTERLOCK INITIATORS AND ACTIONS.
16. PSV SIZING CASE: FINE.
17. FI-1138A TO BE READABLE FROM FV-1138 BYPASS VALVE.
18. SYSTEM DESIGN PRESSURE IS 17.5 barg. ACTUAL P-201 PUMP SHUT OFF PRESSURE IS 16.1 barg. (HAZ N. 324/UNIT 0751)
19. LI-2035C TO BE READABLE FROM MV-7110 ON DRAWING SR03-0751-00-303341-001.

UTILITY REFERENCE TABLE		
CD	DRW. N°	SR03-0751-00-PID-362306
IA	DRW. N°	SR03-0751-00-PID-362305
LFL	DRW. N°	SR03-0751-00-PID-362313
OD	DRW. N°	SR03-0751-00-PID-362307

Z1	04-11-14	IAB	ISSUED FOR AS BUILT	PCA	MAR	AS
2.1E	18-04-14	IFC	ISSUED FOR CONSTRUCTION	PCA	MAR	AS
2.1D	28-04-14	IFC	ISSUED FOR CONSTRUCTION	PCA	MAR	AS
2.1C	31-10-12	IFC	ISSUED FOR CONSTRUCTION	RL	MF	MZ
2.1B	06-08-12	IFC	ISSUED FOR CONSTRUCTION	DSC	CBR	SIN
2	29-12-11	IFC	ISSUED FOR CONSTRUCTION	DSC	CBR	SIN
1	12-08-11	IFCH	ISSUED FOR CONSTRUCTION WITH HOLDS	DSC	CBR	SIN
0	01-03-11	IFD	ISSUED CLIENT COMMENTS INCORPORATED	BSC	LMA	SIN
B1	30-09-10	ICR	ISSUED FOR CLIENT REVIEW	BSC	LMA	SIN
REV	DATE	STATUS	STATUS DESCRIPTION	BY	CKD	APP

COMPANY

Abu Dhabi Gas Development Co. Ltd.



CONTRACTOR:



saipem

JOB No. 032090

PROJECT:


SHAH GAS DEVELOPMENT (SGD) PROJECT

AGREEMENT No. 13525001

DRAWING TITLE: PIPING & INSTRUMENT DIAGRAM UNIT 0751
SULPHUR RECOVERY AND TAIL GAS TREATING UNIT

EQUIPMENT DESCRIPTION		DESUPERHEATER/CONTACT CONDENSER	
TAG/ITEM No.			
		0751-V-201	
CONTRACTOR DRG. No.		751-GD-B-303340	
COMPANY DRG. No.		SR03-0751-00-303340	
SCALE:	SIZE: A1	DOC. CLASS: 1	REV. Z1

THIS DOCUMENT IS THE PROPERTY OF ABU DHABI GAS DEVELOPMENT COMPANY LIMITED AND CONTAINS INFORMATION WHICH IS PROPRIETARY. THIS INFORMATION IS TO BE HELD IN CONFIDENCE. NO DISCLOSURE OR OTHER USE OF THIS DOCUMENT IS TO BE MADE WITHOUT THE PRIOR WRITTEN CONSENT OF ABU DHABI GAS DEVELOPMENT COMPANY LIMITED.

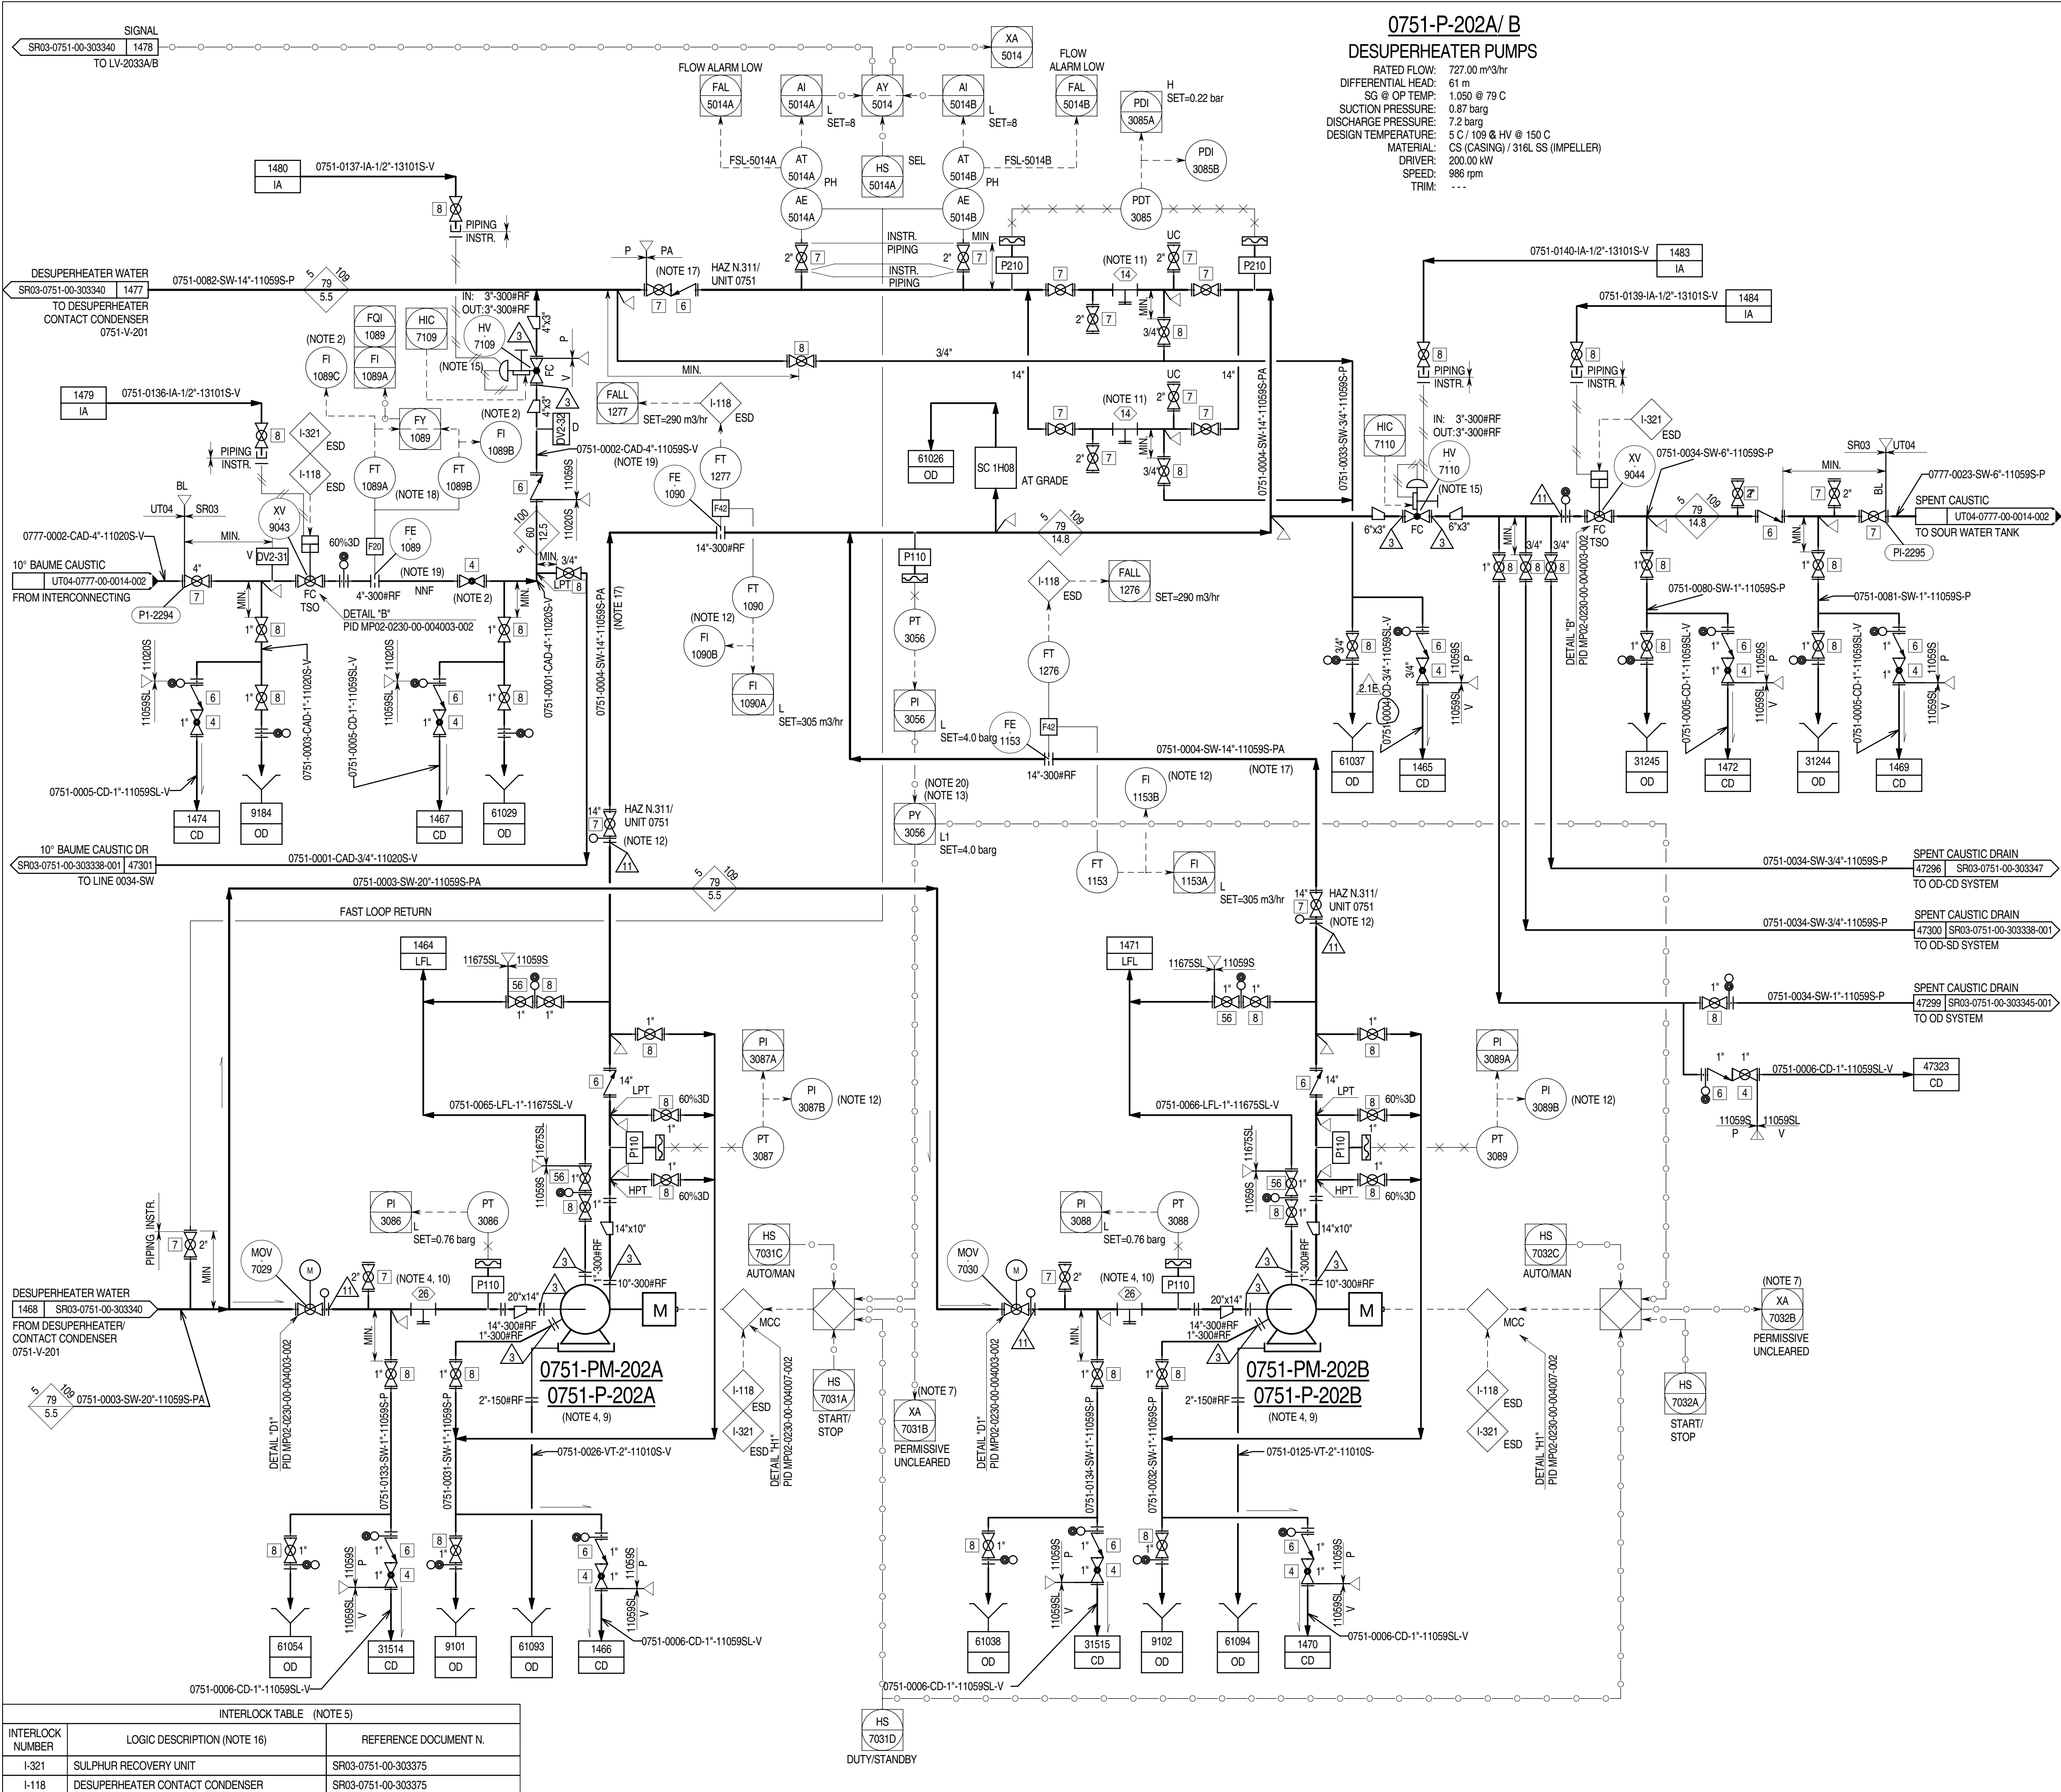

Z1	04-11-14	IAB	ISSUED FOR AS BUILT	PCA	MAR	ASP
2.1E	18-04-14	IFC	ISSUED FOR CONSTRUCTION	PCA	MAR	ASP
2.1D	09-03-13	IFC	ISSUED FOR CONSTRUCTION	RL	CN	MZ
2.1C	31-10-12	IFC	ISSUED FOR CONSTRUCTION	RL	MF	MZ
2.1B	06-08-12	IFC	ISSUED FOR CONSTRUCTION	DSC	CBR	SIN
2	29-12-11	IFC	ISSUED FOR CONSTRUCTION	DSC	CBR	SIN
1	12-08-11	IFCH	ISSUED FOR CONSTRUCTION WITH HOLDS	DSC	CBR	SIN
0	01-03-11	IFD	ISSUED CLIENT COMMENTS INCORPORATED	BSC	LMA	SIN
B1	30-09-10	ICR	ISSUED FOR CLIENT REVIEW	BSC	LMA	SIN
REV	DATE	STATUS	STATUS DESCRIPTION	BY	CKD	APP.

COMPANY:

Abu Dhabi Gas Development Co. Ltd.



CONTRACTOR:



JOB No. 032090

PROJECT:

SHAH GAS DEVELOPMENT (SGD) PROJECT

AGREEMENT No. 13525001

DRAWING TITLE: PIPING & INSTRUMENT DIAGRAM UNIT 0751
SULPHUR RECOVERY AND TAIL GAS TREATING UNIT

EQUIPMENT DESCRIPTION	DESUPERHEATER PUMPS
TAGITEM No.	0751-P-202A

CONTRACTOR DRG. No.	751-GD-B-303341	REV.
COMPANY DRG. No.	SR03-0751-00-303341-001	Z1
SCALE:	SIZE: A1	DOC. CLASS: 1

THIS DOCUMENT IS THE PROPERTY OF ABU DHABI GAS DEVELOPMENT COMPANY LIMITED AND CONTAINS INFORMATION WHICH IS PROPRIETARY. THIS INFORMATION IS TO BE HELD IN CONFIDENCE. NO DISCLOSURE OR OTHER USE OF THIS DOCUMENT IS TO BE MADE WITHOUT THE PRIOR WRITTEN CONSENT OF ABU DHABI GAS DEVELOPMENT COMPANY LIMITED.

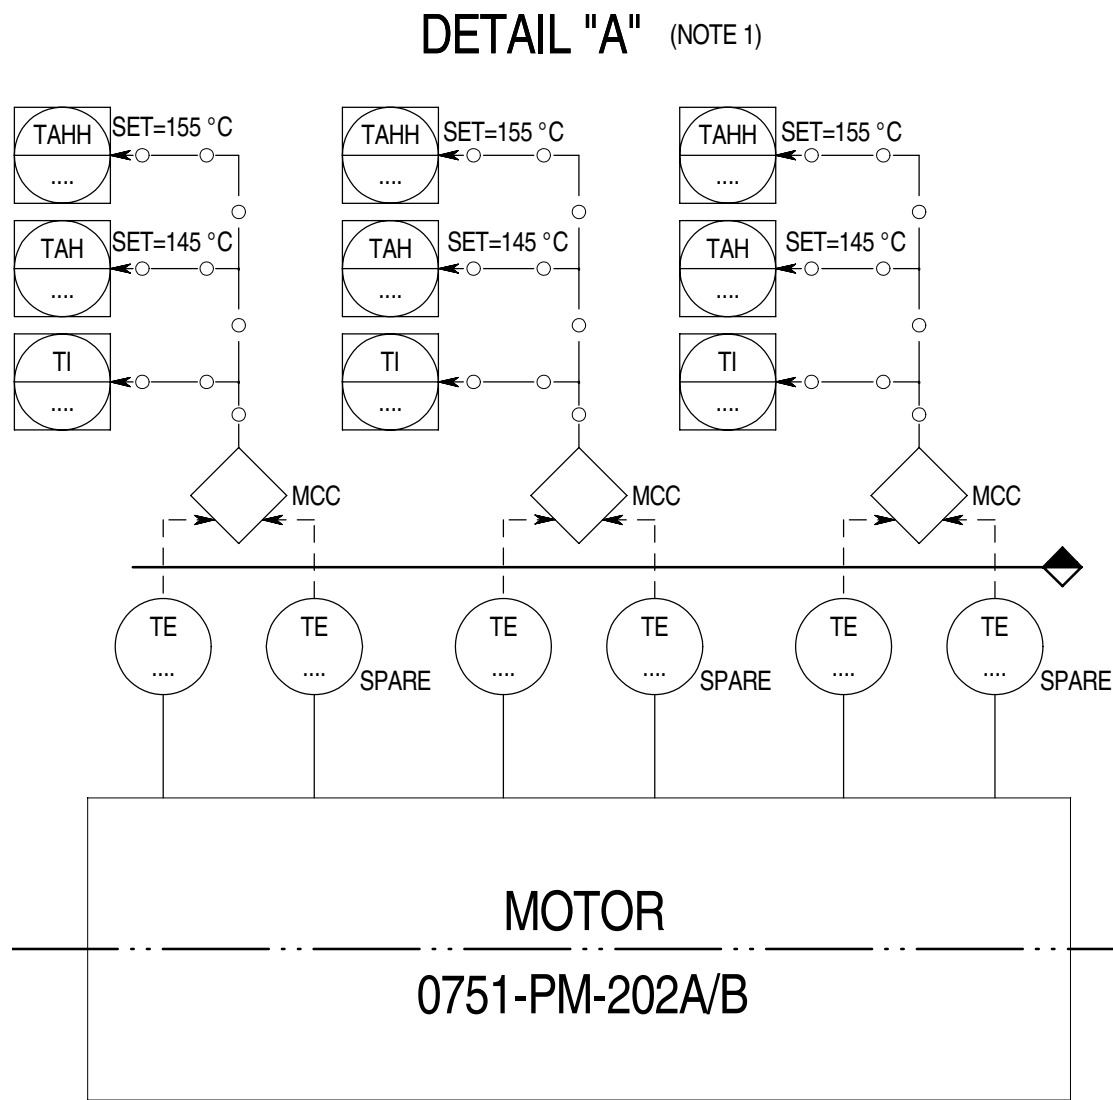
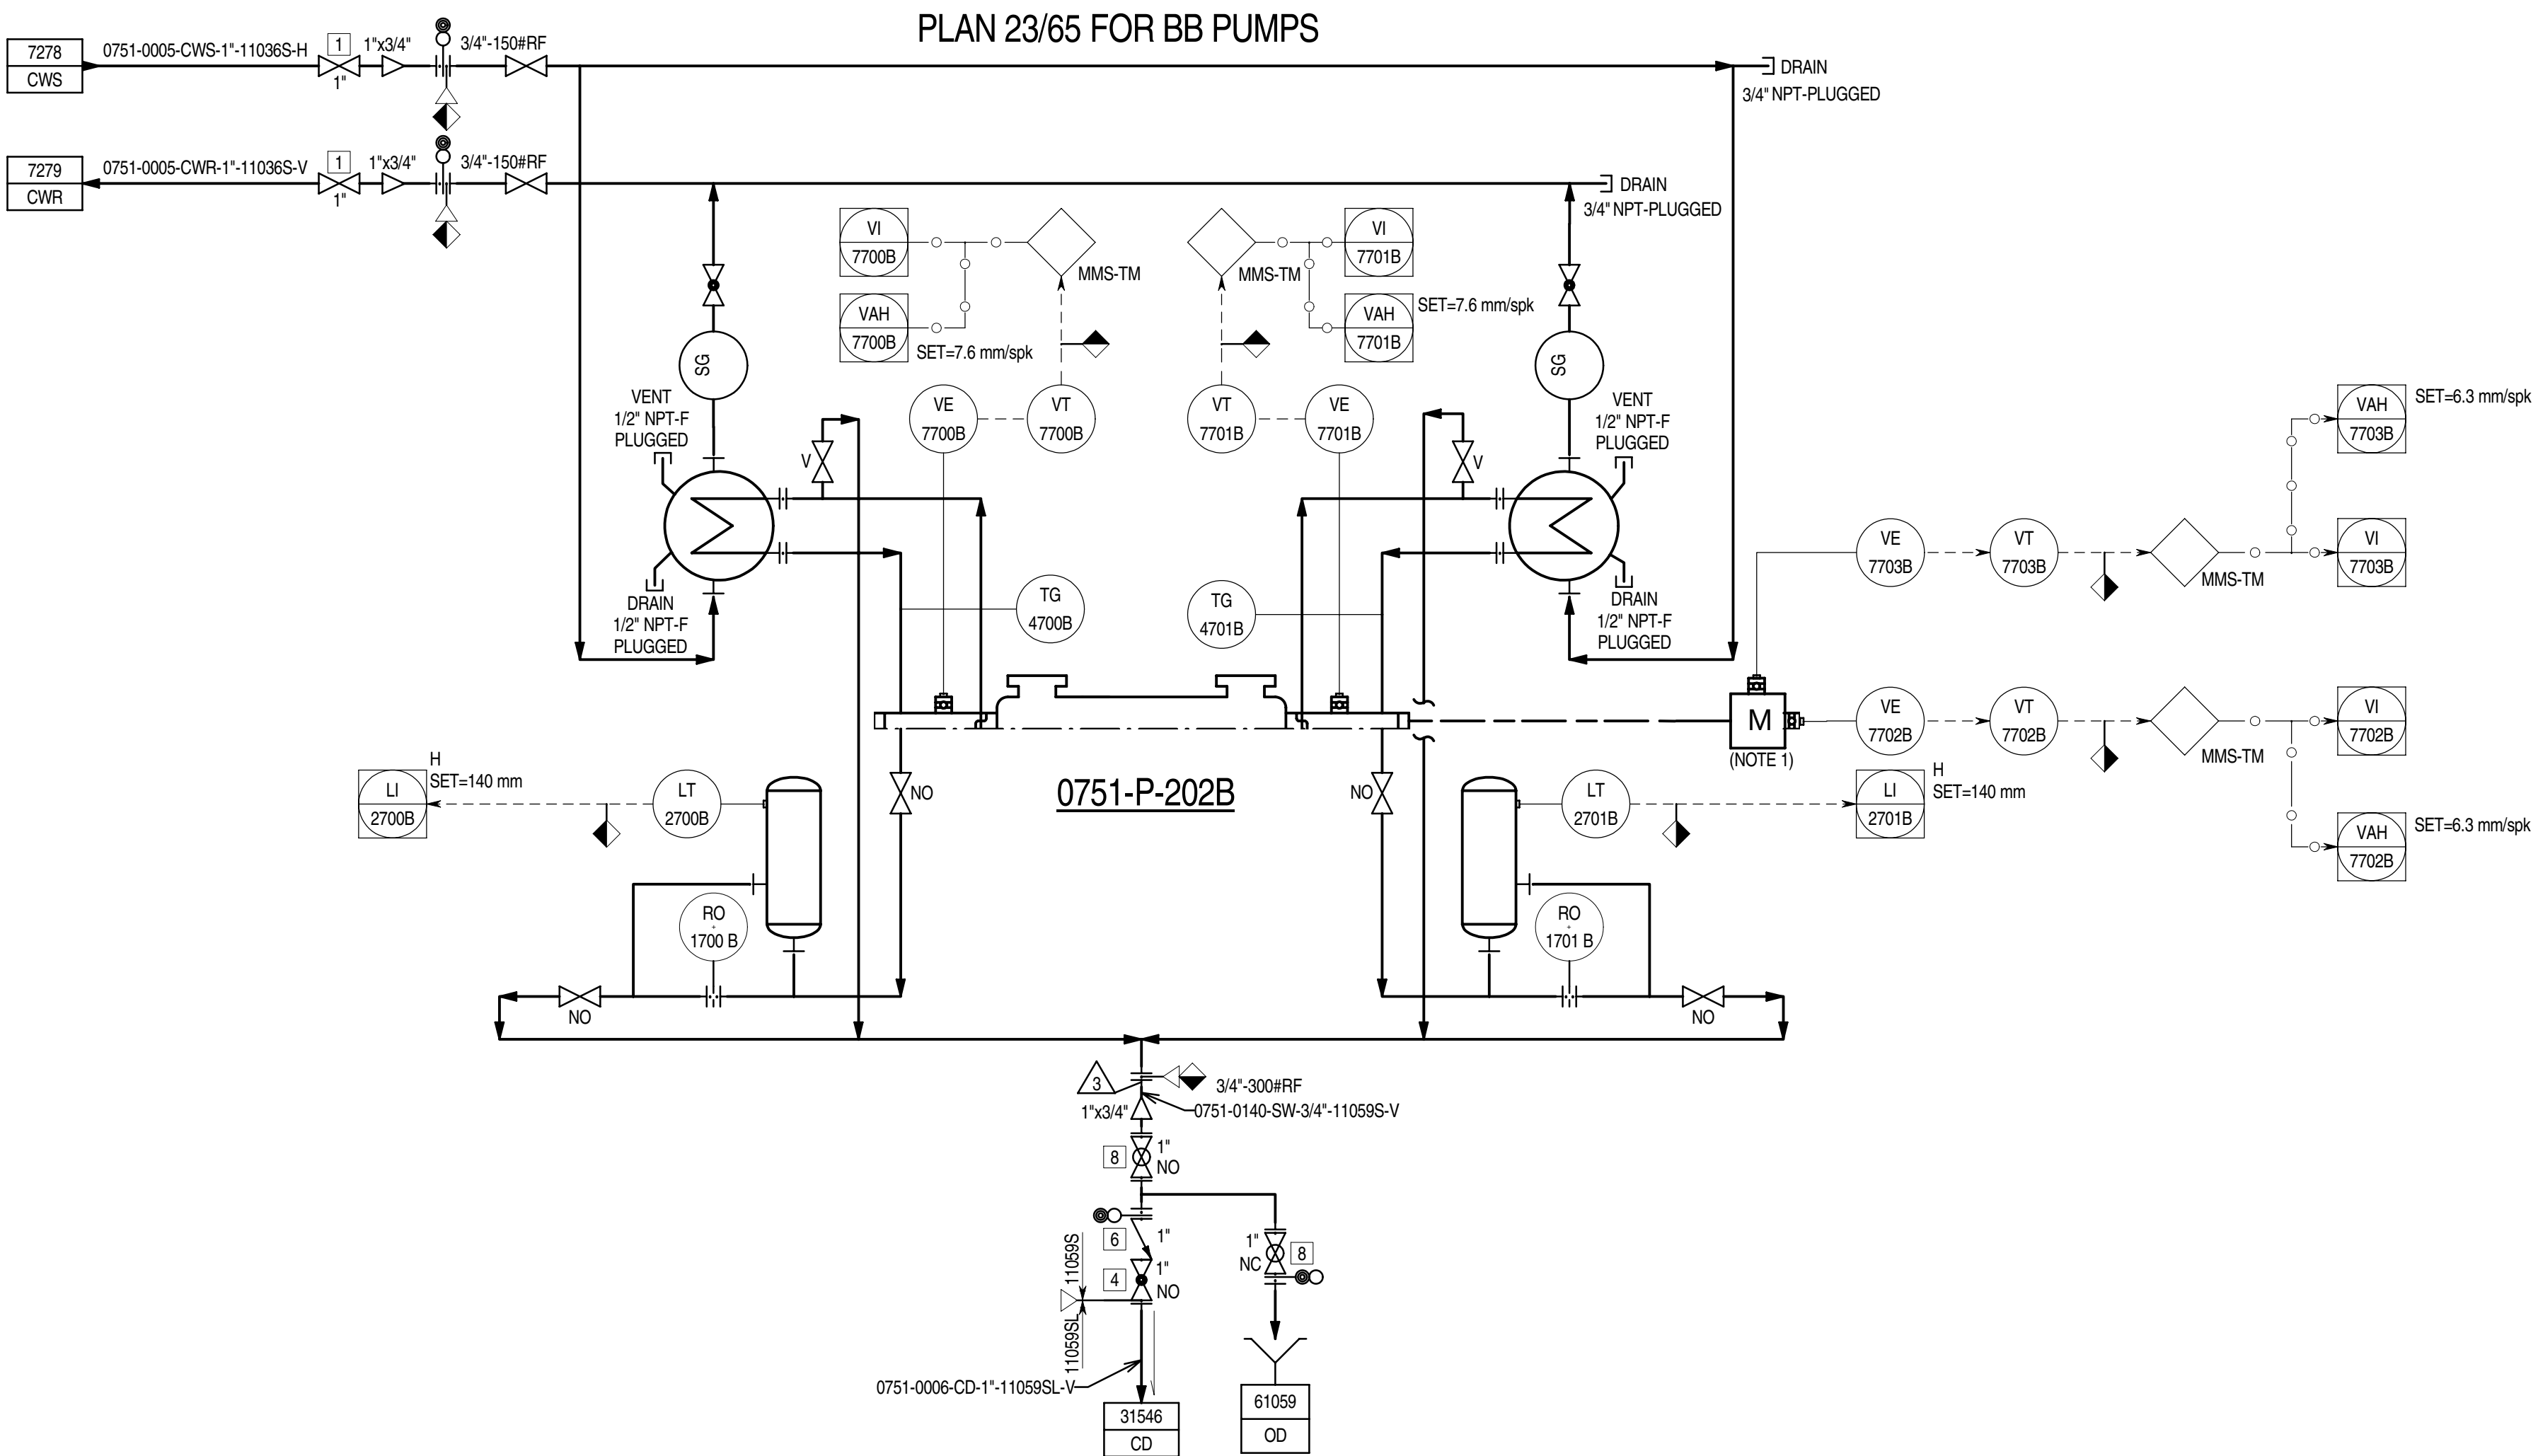
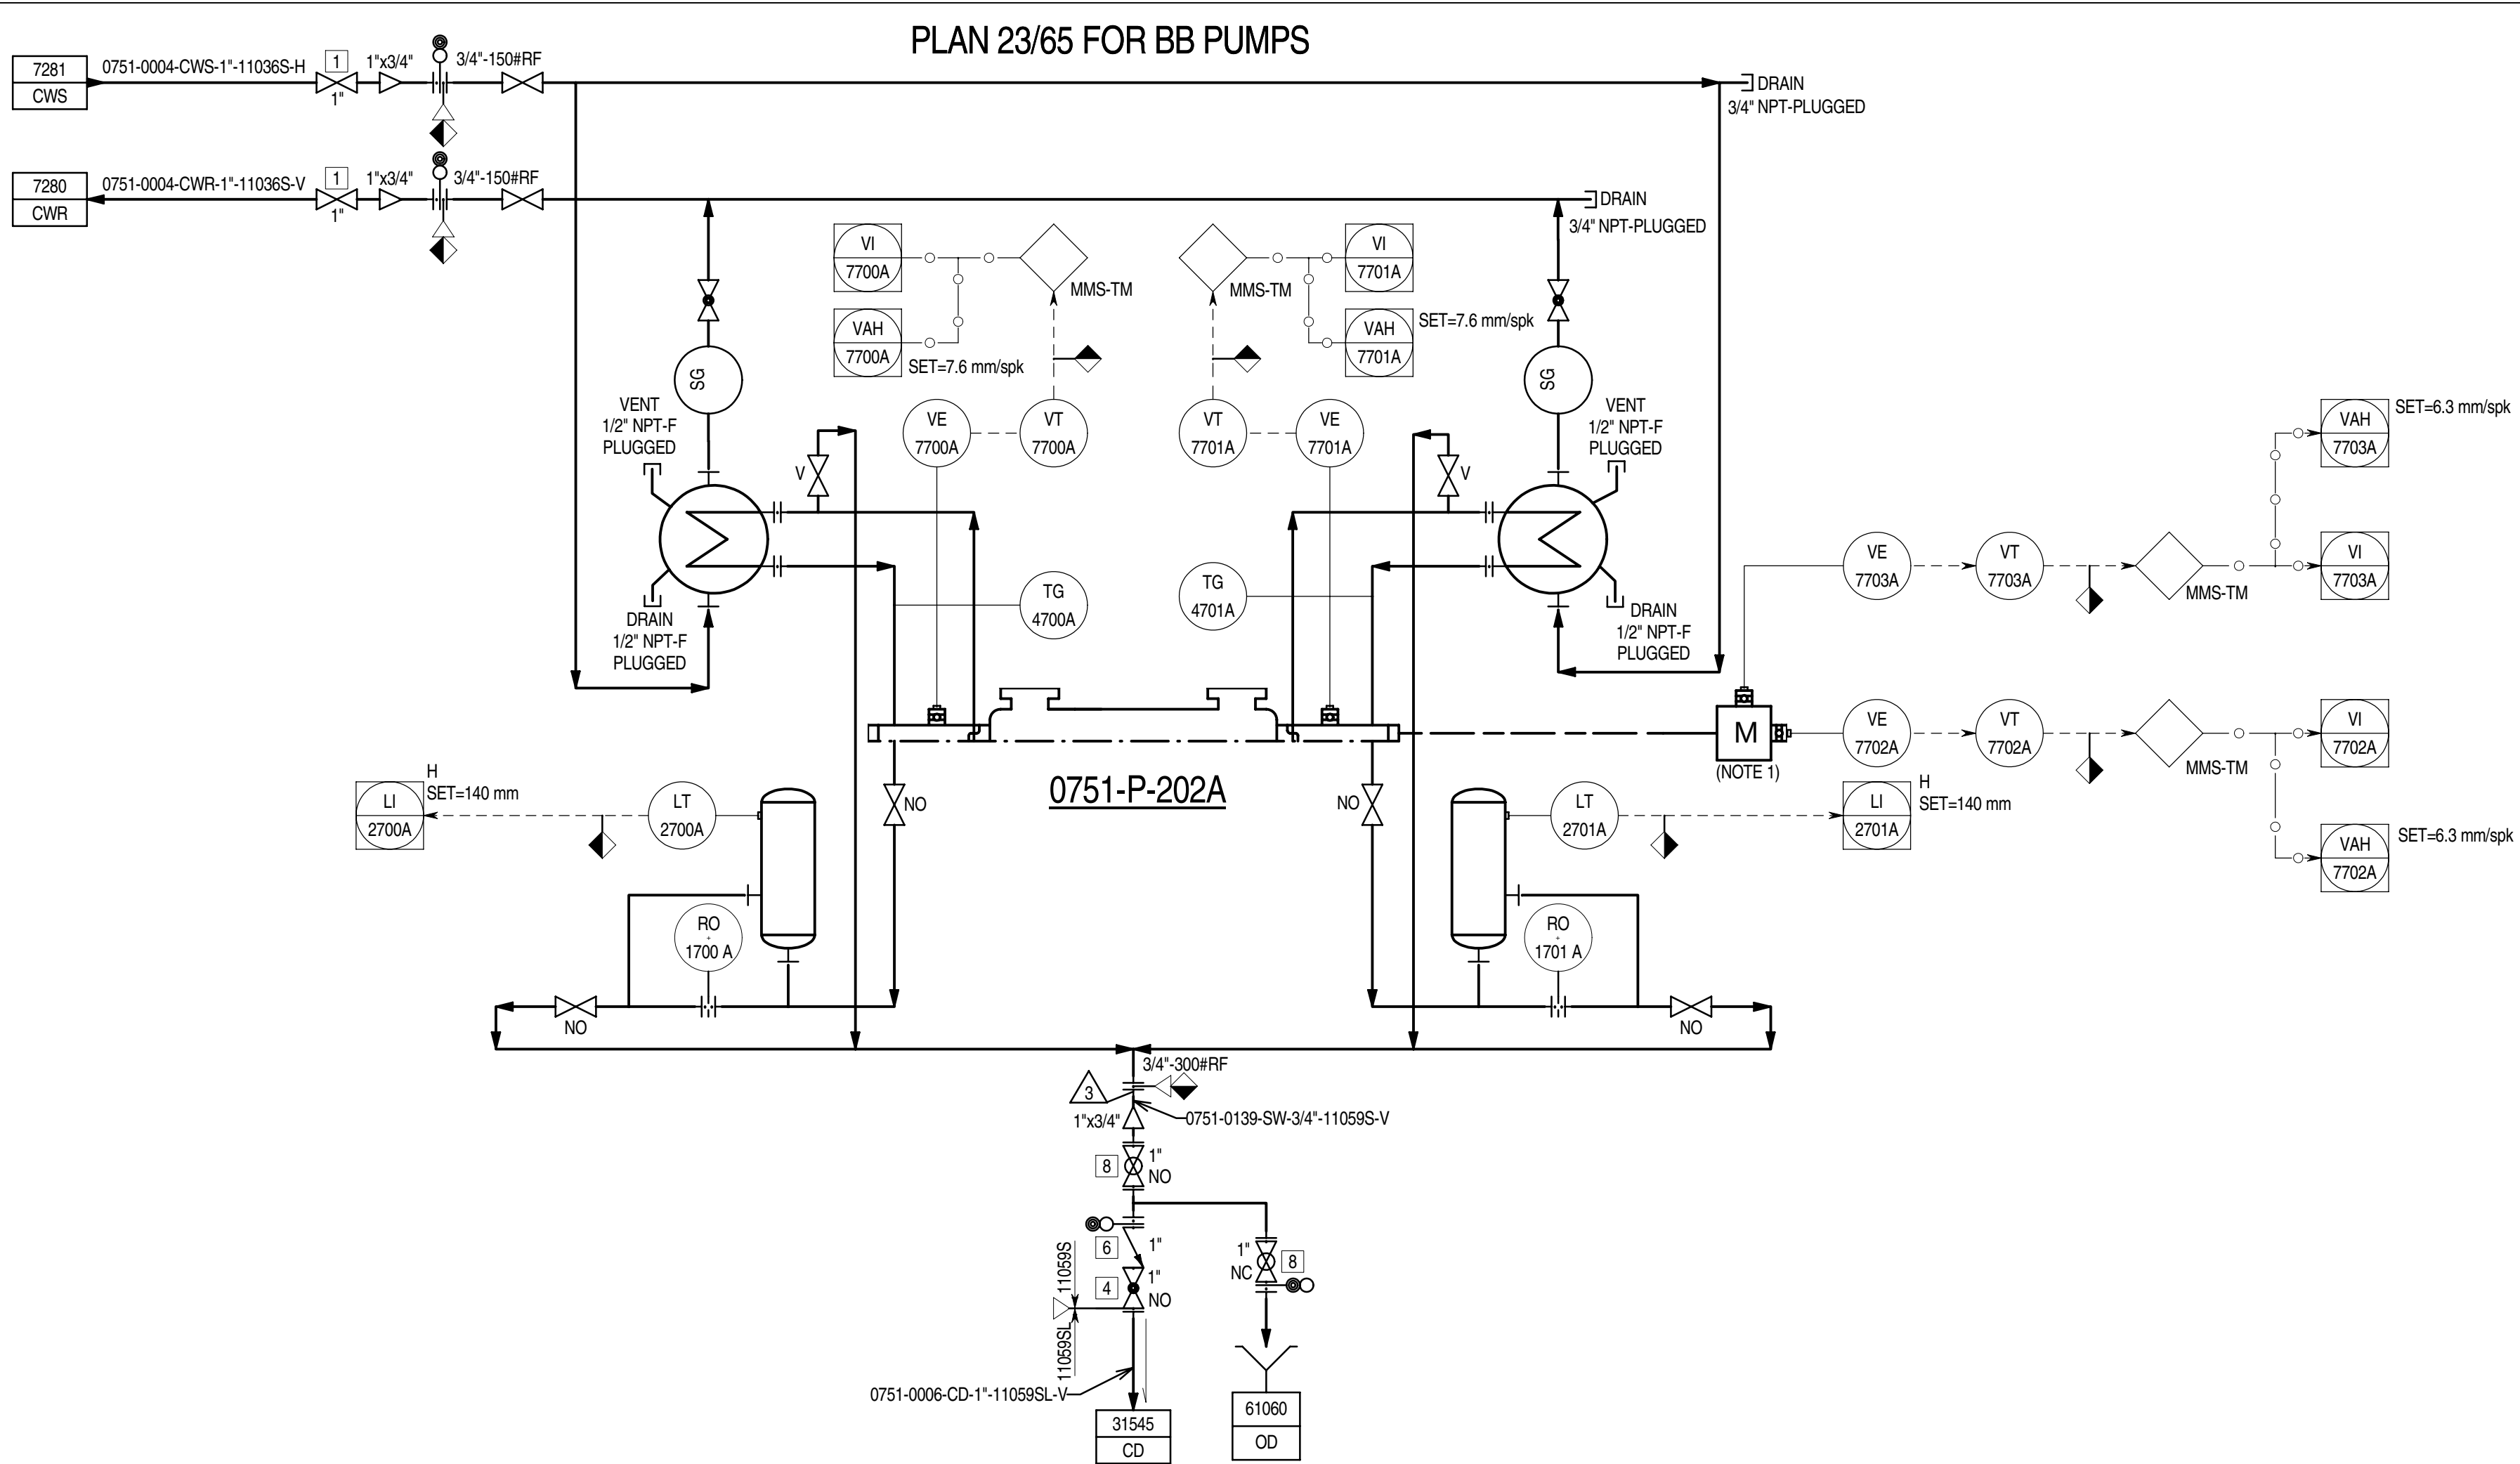


TABLE 1 (NOTE 1)

MOTOR PUMP	TE	TI	TAH	TAHH	TE (SPARE)
0751-PM-202A	TE-4702AA	TI-4702A	TAH-4702A	TAHH-4702A	TE-4702AB
	TE-4703AA	TI-4703A	TAH-4703A	TAHH-4703A	TE-4703AB
	TE-4704AA	TI-4704A	TAH-4704A	TAHH-4704A	TE-4704AB
0751-PM-202B	TE-4702BA	TI-4702B	TAH-4702B	TAHH-4702B	TE-4702BB
	TE-4703BA	TI-4703B	TAH-4703B	TAHH-4703B	TE-4703BB
	TE-4704BA	TI-4704B	TAH-4704B	TAHH-4704B	TE-4704BB

- GENERAL NOTES:
- FOR STANDARD SYMBOLS, DETAILS, ABBREVIATIONS, SAMPLE CONNECTION TYPE, GENERAL NOTES & LEGEND SHEETS REFER TO DRAWING NO. MP02-0230-00-004000 TO 004015.
 - ALL INSTRUMENT TAG NUMBERS ON THIS P&ID INCLUDING PACKAGE UNITS ARE PREFIXED WITH UNIT NUMBER 0751 UNLESS OTHERWISE NOTED.
 - DELETED.
- NOTES:
- FOR DETAIL OF TEMPERATURE MEASUREMENTS ON ELECTRICAL MOTOR REFER TO DETAIL "A" AND TABLE 1.

UTILITY REFERENCE TABLE			
CWR/CWS	DRW. N°.	MP03-0751-00-PID-362308	
OD	DRW. N°.	MP03-0751-00-PID-362307	

Z1	04-11-14	IAB	ISSUED FOR AS BUILT	PCA	MAR	ASP
2.1E	18-04-14	IFC	ISSUED FOR CONSTRUCTION	PCA	MAR	ASP
2.1D	01-05-13	IFC	ISSUED FOR CONSTRUCTION	RL	CN	MZ
2.1C	31-10-12	IFC	ISSUED FOR CONSTRUCTION	RL	MF	MZ
2.1B	06-08-12	IFC	ISSUED FOR CONSTRUCTION	DSC	CBR	SIN
2	29-12-11	IFC	ISSUED FOR CONSTRUCTION	DSC	CBR	SIN
1	12-08-11	IFCH	ISSUED FOR CONSTRUCTION WITH HOLDS	DSC	CBR	SIN
REV	DATE	STATUS	STATUS DESCRIPTION	BY	CKD	APP.

COMPANY:

Abu Dhabi Gas Development Co. Ltd.

CONTRACTOR:

JOB No. 032090


PROJECT: SHAH GAS DEVELOPMENT (SGD) PROJECT

AGREEMENT No. 13525001


DRAWING TITLE: PIPING & INSTRUMENT DIAGRAM UNIT 0751 SULPHUR RECOVERY AND TAIL GAS TREATING UNIT

EQUIPMENT DESCRIPTION	API PLAN 0751-P-202 A/B AND VIBRATION MONITORING
TAGITEM No.	

CONTRACTOR DRG. No.	751-GD-B-303341	REV. Z1
COMPANY DRG. No.	SR03-0751-00-303341-002	
SCALE:	SIZE: A1	
		DOC. CLASS: 1

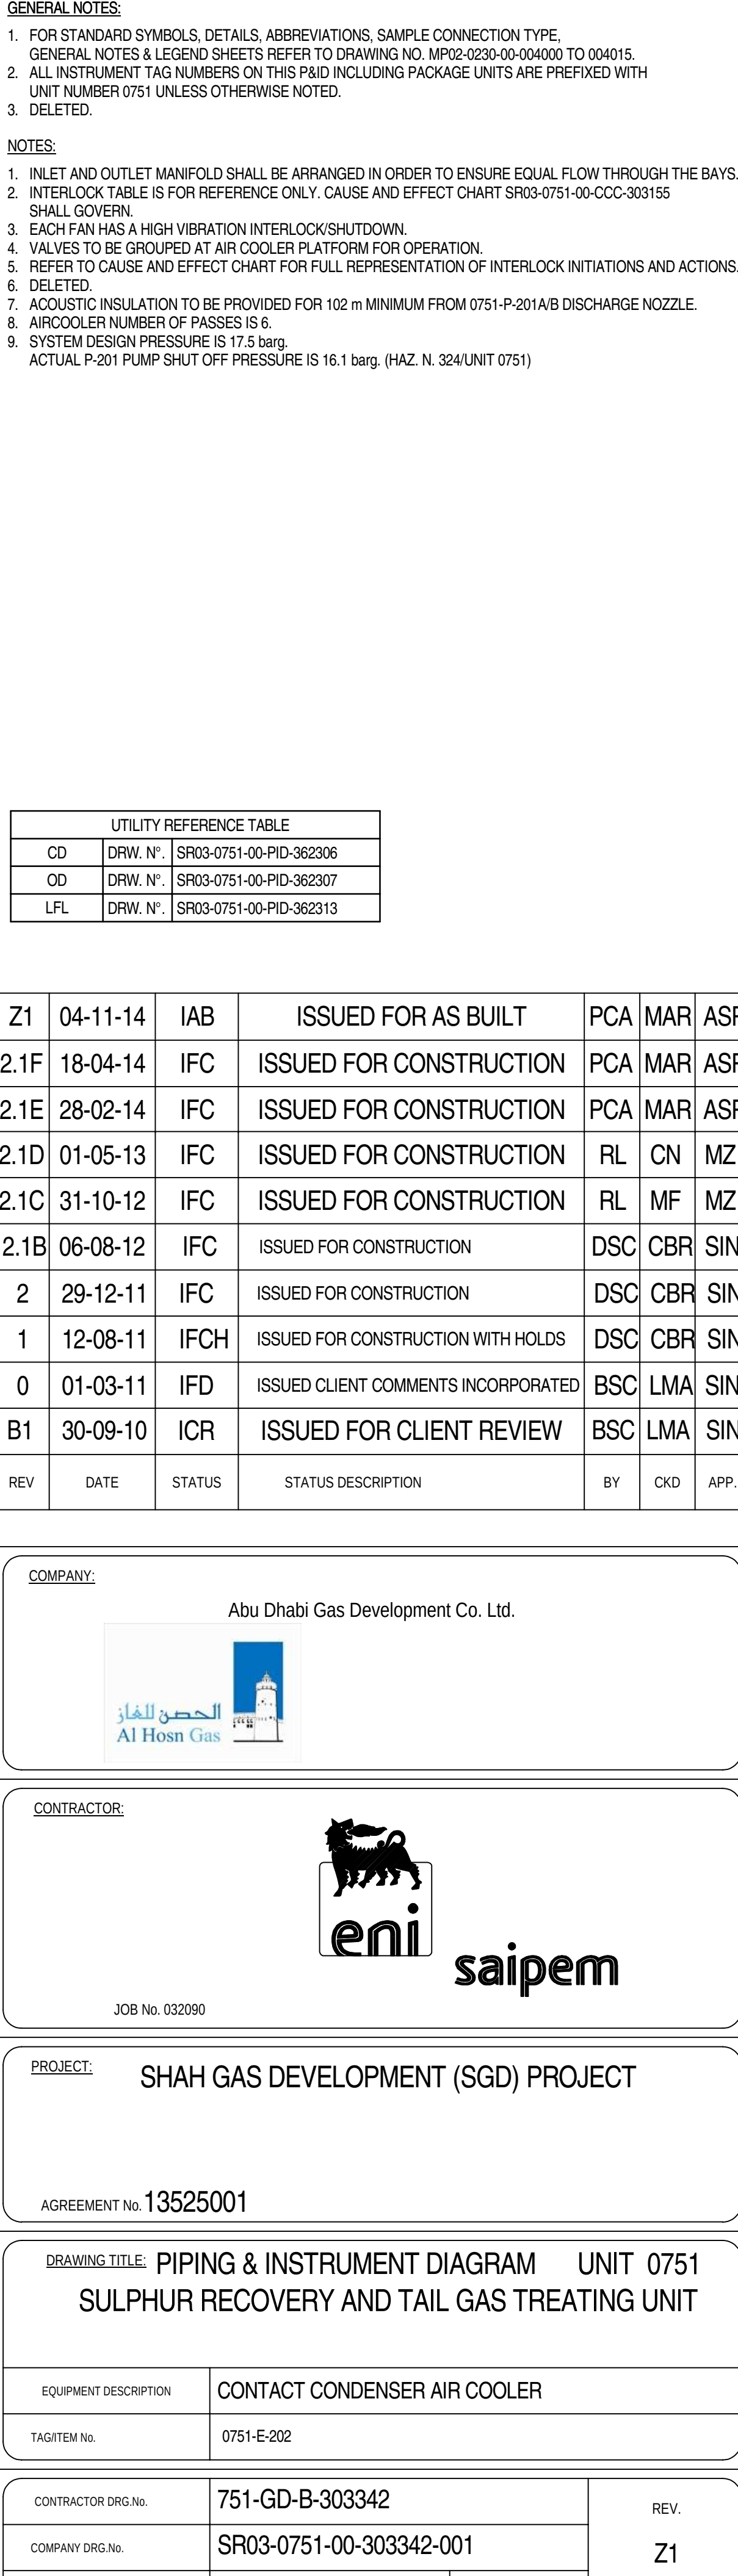

THIS DOCUMENT IS THE PROPERTY OF ABU DHABI GAS DEVELOPMENT COMPANY LIMITED AND CONTAINS INFORMATION WHICH IS PROPRIETARY. THIS INFORMATION IS TO BE HELD IN CONFIDENCE. NO DISCLOSURE OR OTHER USE OF THIS DOCUMENT IS TO BE MADE WITHOUT THE PRIOR WRITTEN CONSENT OF ABU DHABI GAS DEVELOPMENT COMPANY LIMITED.

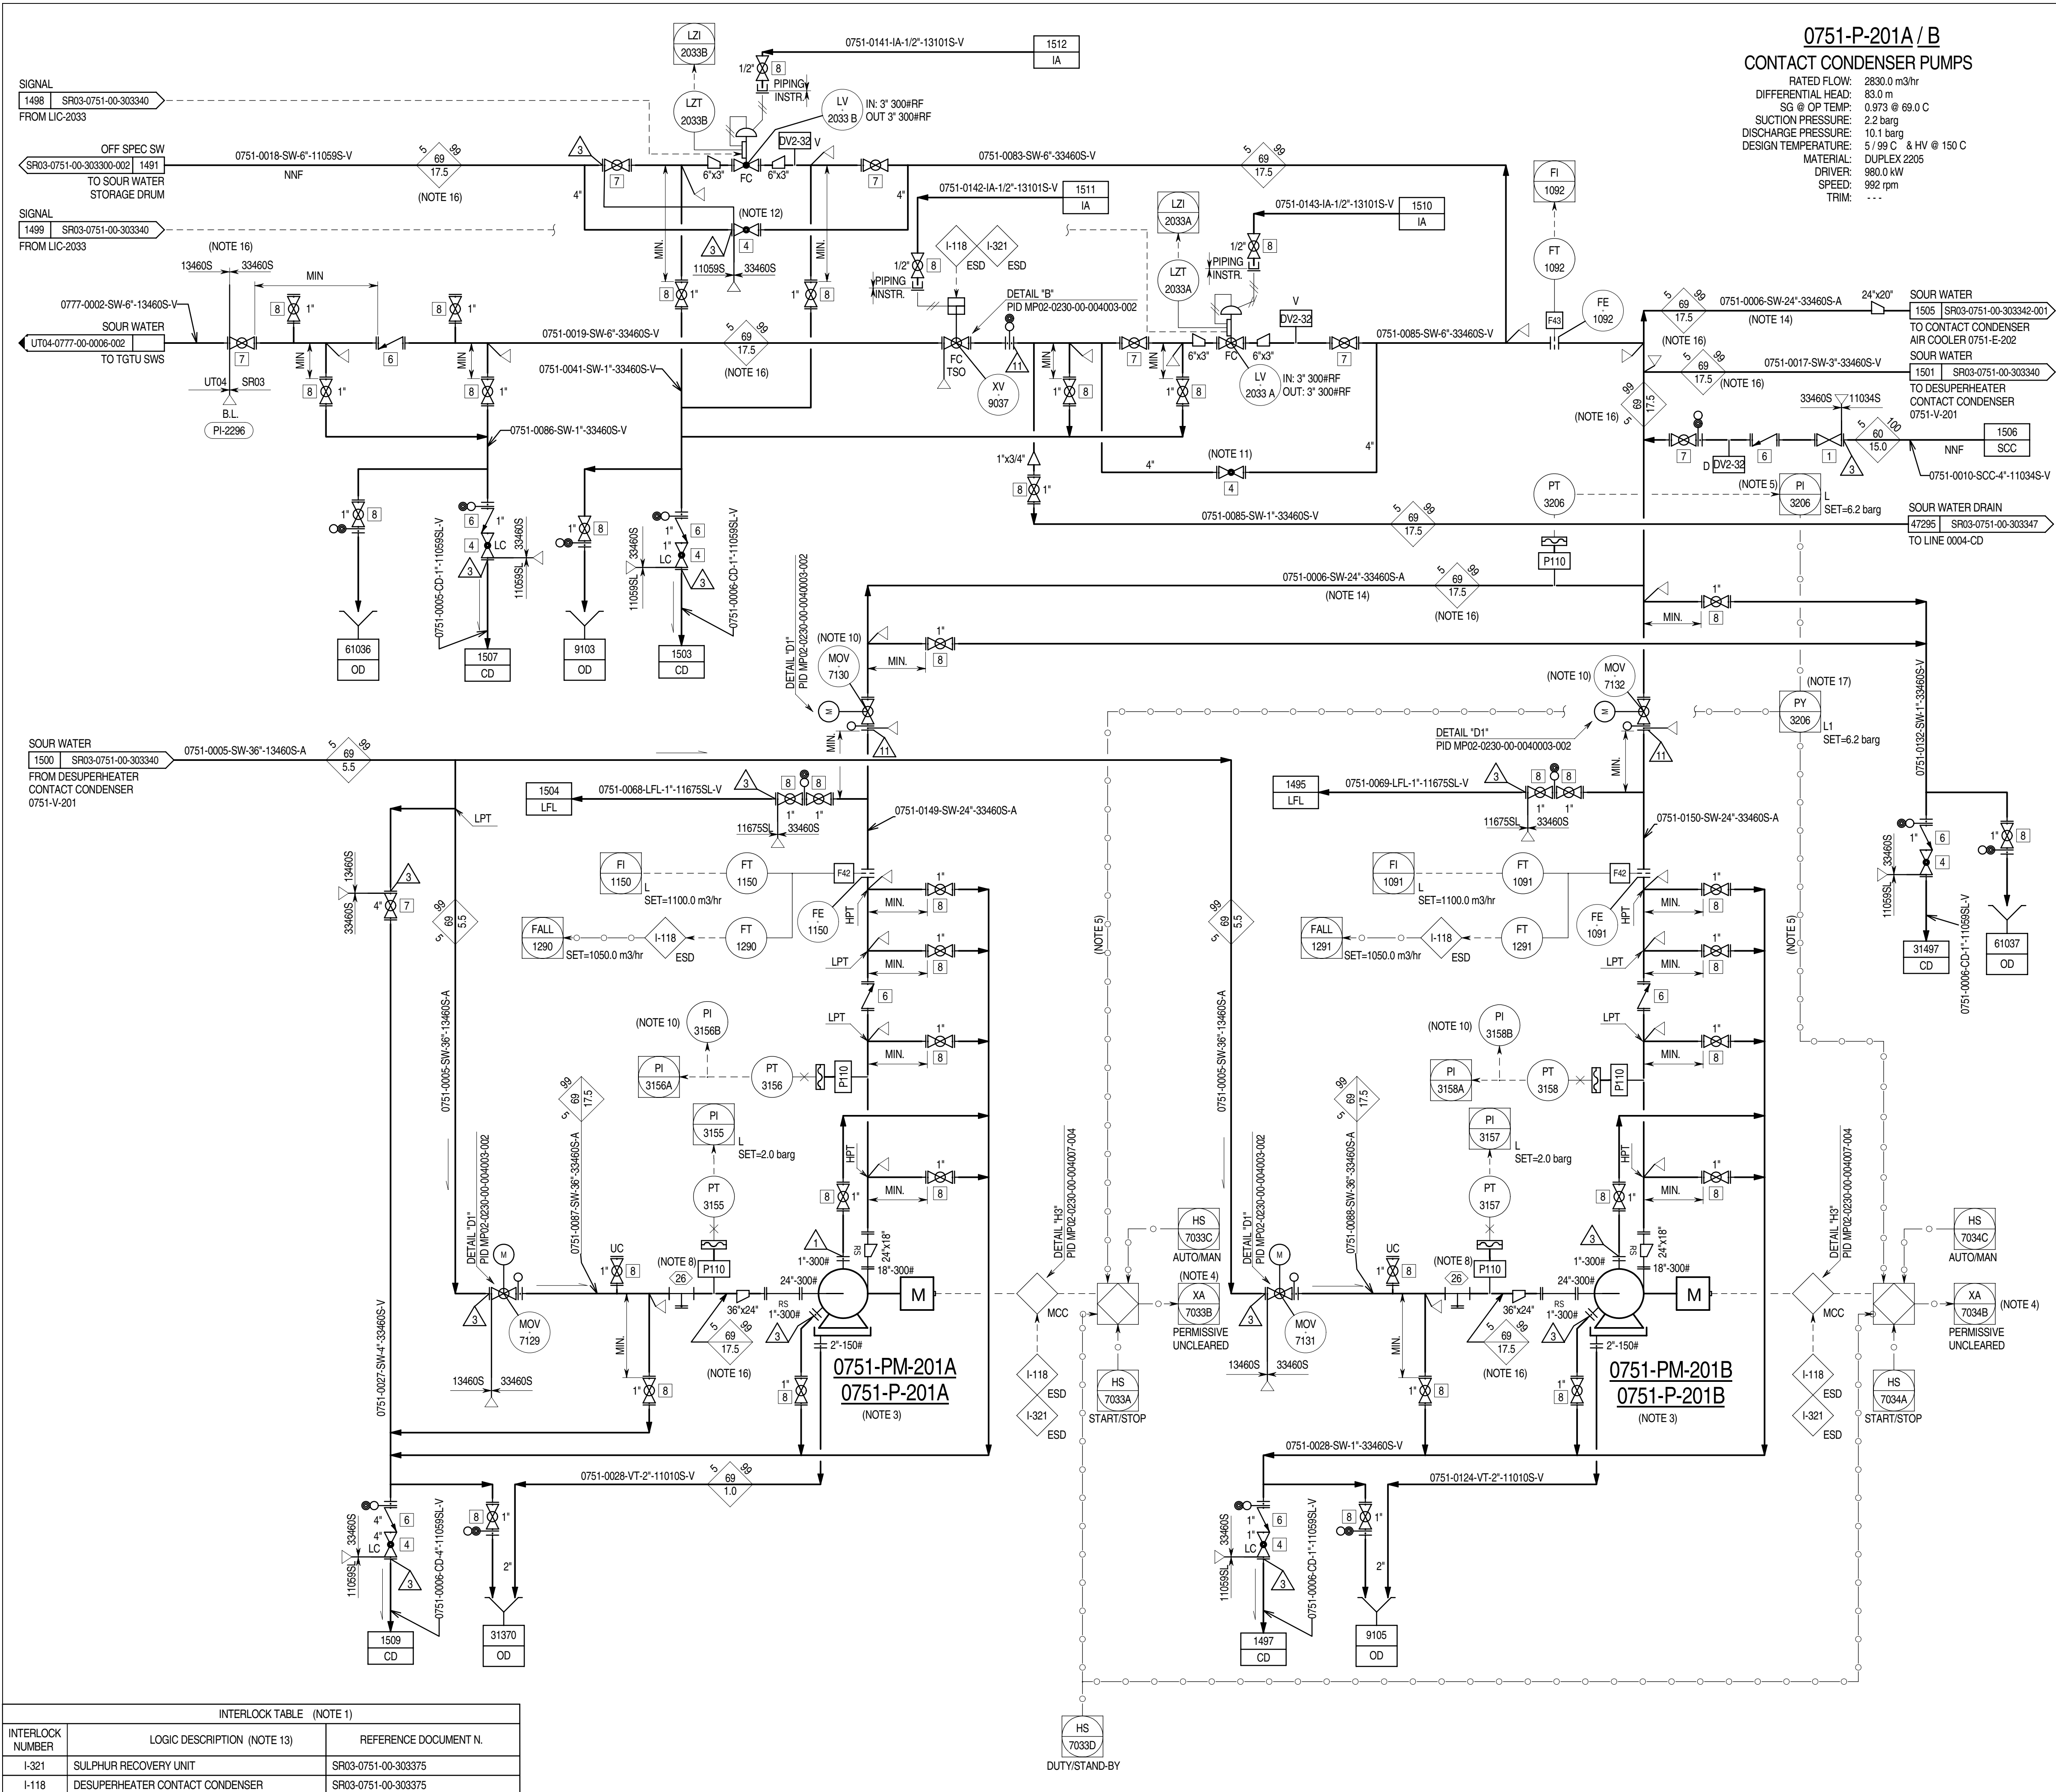


Z1	04-11-14	IAB	ISSUED FOR AS BUILT	PCA	MAR	ASP
2.1F	18-04-14	IFC	ISSUED FOR CONSTRUCTION	PCA	MAR	ASP
2.1E	28-02-14	IFC	ISSUED FOR CONSTRUCTION	PCA	MAR	ASP
2.1D	09-03-13	IFC	ISSUED FOR CONSTRUCTION	RL	CN	MZ
2.1C	31-10-12	IFC	ISSUED FOR CONSTRUCTION	RL	MF	MZ
2.1B	06-08-12	IFC	ISSUED FOR CONSTRUCTION	DSC	CBR	SIN
2	29-12-11	IFC	ISSUED FOR CONSTRUCTION	DSC	CBR	SIN
1	12-08-11	IFCH	ISSUED FOR CONSTRUCTION WITH HOLDS	DSC	CBR	SIN
0	01-03-11	IFD	ISSUED CLIENT COMMENTS INCORPORATED	BSC	LMA	SIN
B1	30-09-10	ICR	ISSUED FOR CLIENT REVIEW	BSC	LMA	SIN
REV	DATE	STATUS	STATUS DESCRIPTION	BY	CKD	APP.

COMPANY:

Abu Dhabi Gas Development Co. Ltd.



CONTRACTOR:

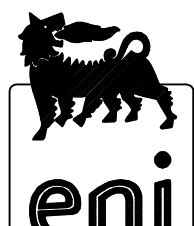

JOB No. 032090

PROJECT:

SHAH GAS DEVELOPMENT (SGD) PROJECT

AGREEMENT No. 13525001




DRAWING TITLE: PIPING & INSTRUMENT DIAGRAM UNIT 0751
SULPHUR RECOVERY AND TAIL GAS TREATING UNIT

EQUIPMENT DESCRIPTION	CONTACT CONDENSER PUMPS
TAGITEM No.	0751-P-201A / B

CONTRACTOR DRG. No.	751-GD-B-303342	REV.
COMPANY DRG. No.	SR03-0751-00-303342-002	Z1
SCALE:	SIZE: A1	DOC. CLASS: 1

TABLE 1 (NOTE 3)					
MOTOR PUMP	TE	TI	TAH	TAHH	TE (SPARE)
0751-PM-201A	TE-4649AA	TI-4649A	TAH-4649A	TAHH-4649A	TE-4649AB
	TE-4650AA	TI-4650A	TAH-4650A	TAHH-4650A	TE-4650AB
	TE-4651AA	TI-4651A	TAH-4651A	TAHH-4651A	TE-4651AB
0751-PM-201B	TE-4649BA	TI-4649B	TAH-4649B	TAHH-4649B	TE-4649BB
	TE-4650BA	TI-4650B	TAH-4650B	TAHH-4650B	TE-4650BB
	TE-4651BA	TI-4651B	TAH-4651B	TAHH-4651B	TE-4651BB

DETAIL "A"
(NOTE 3)

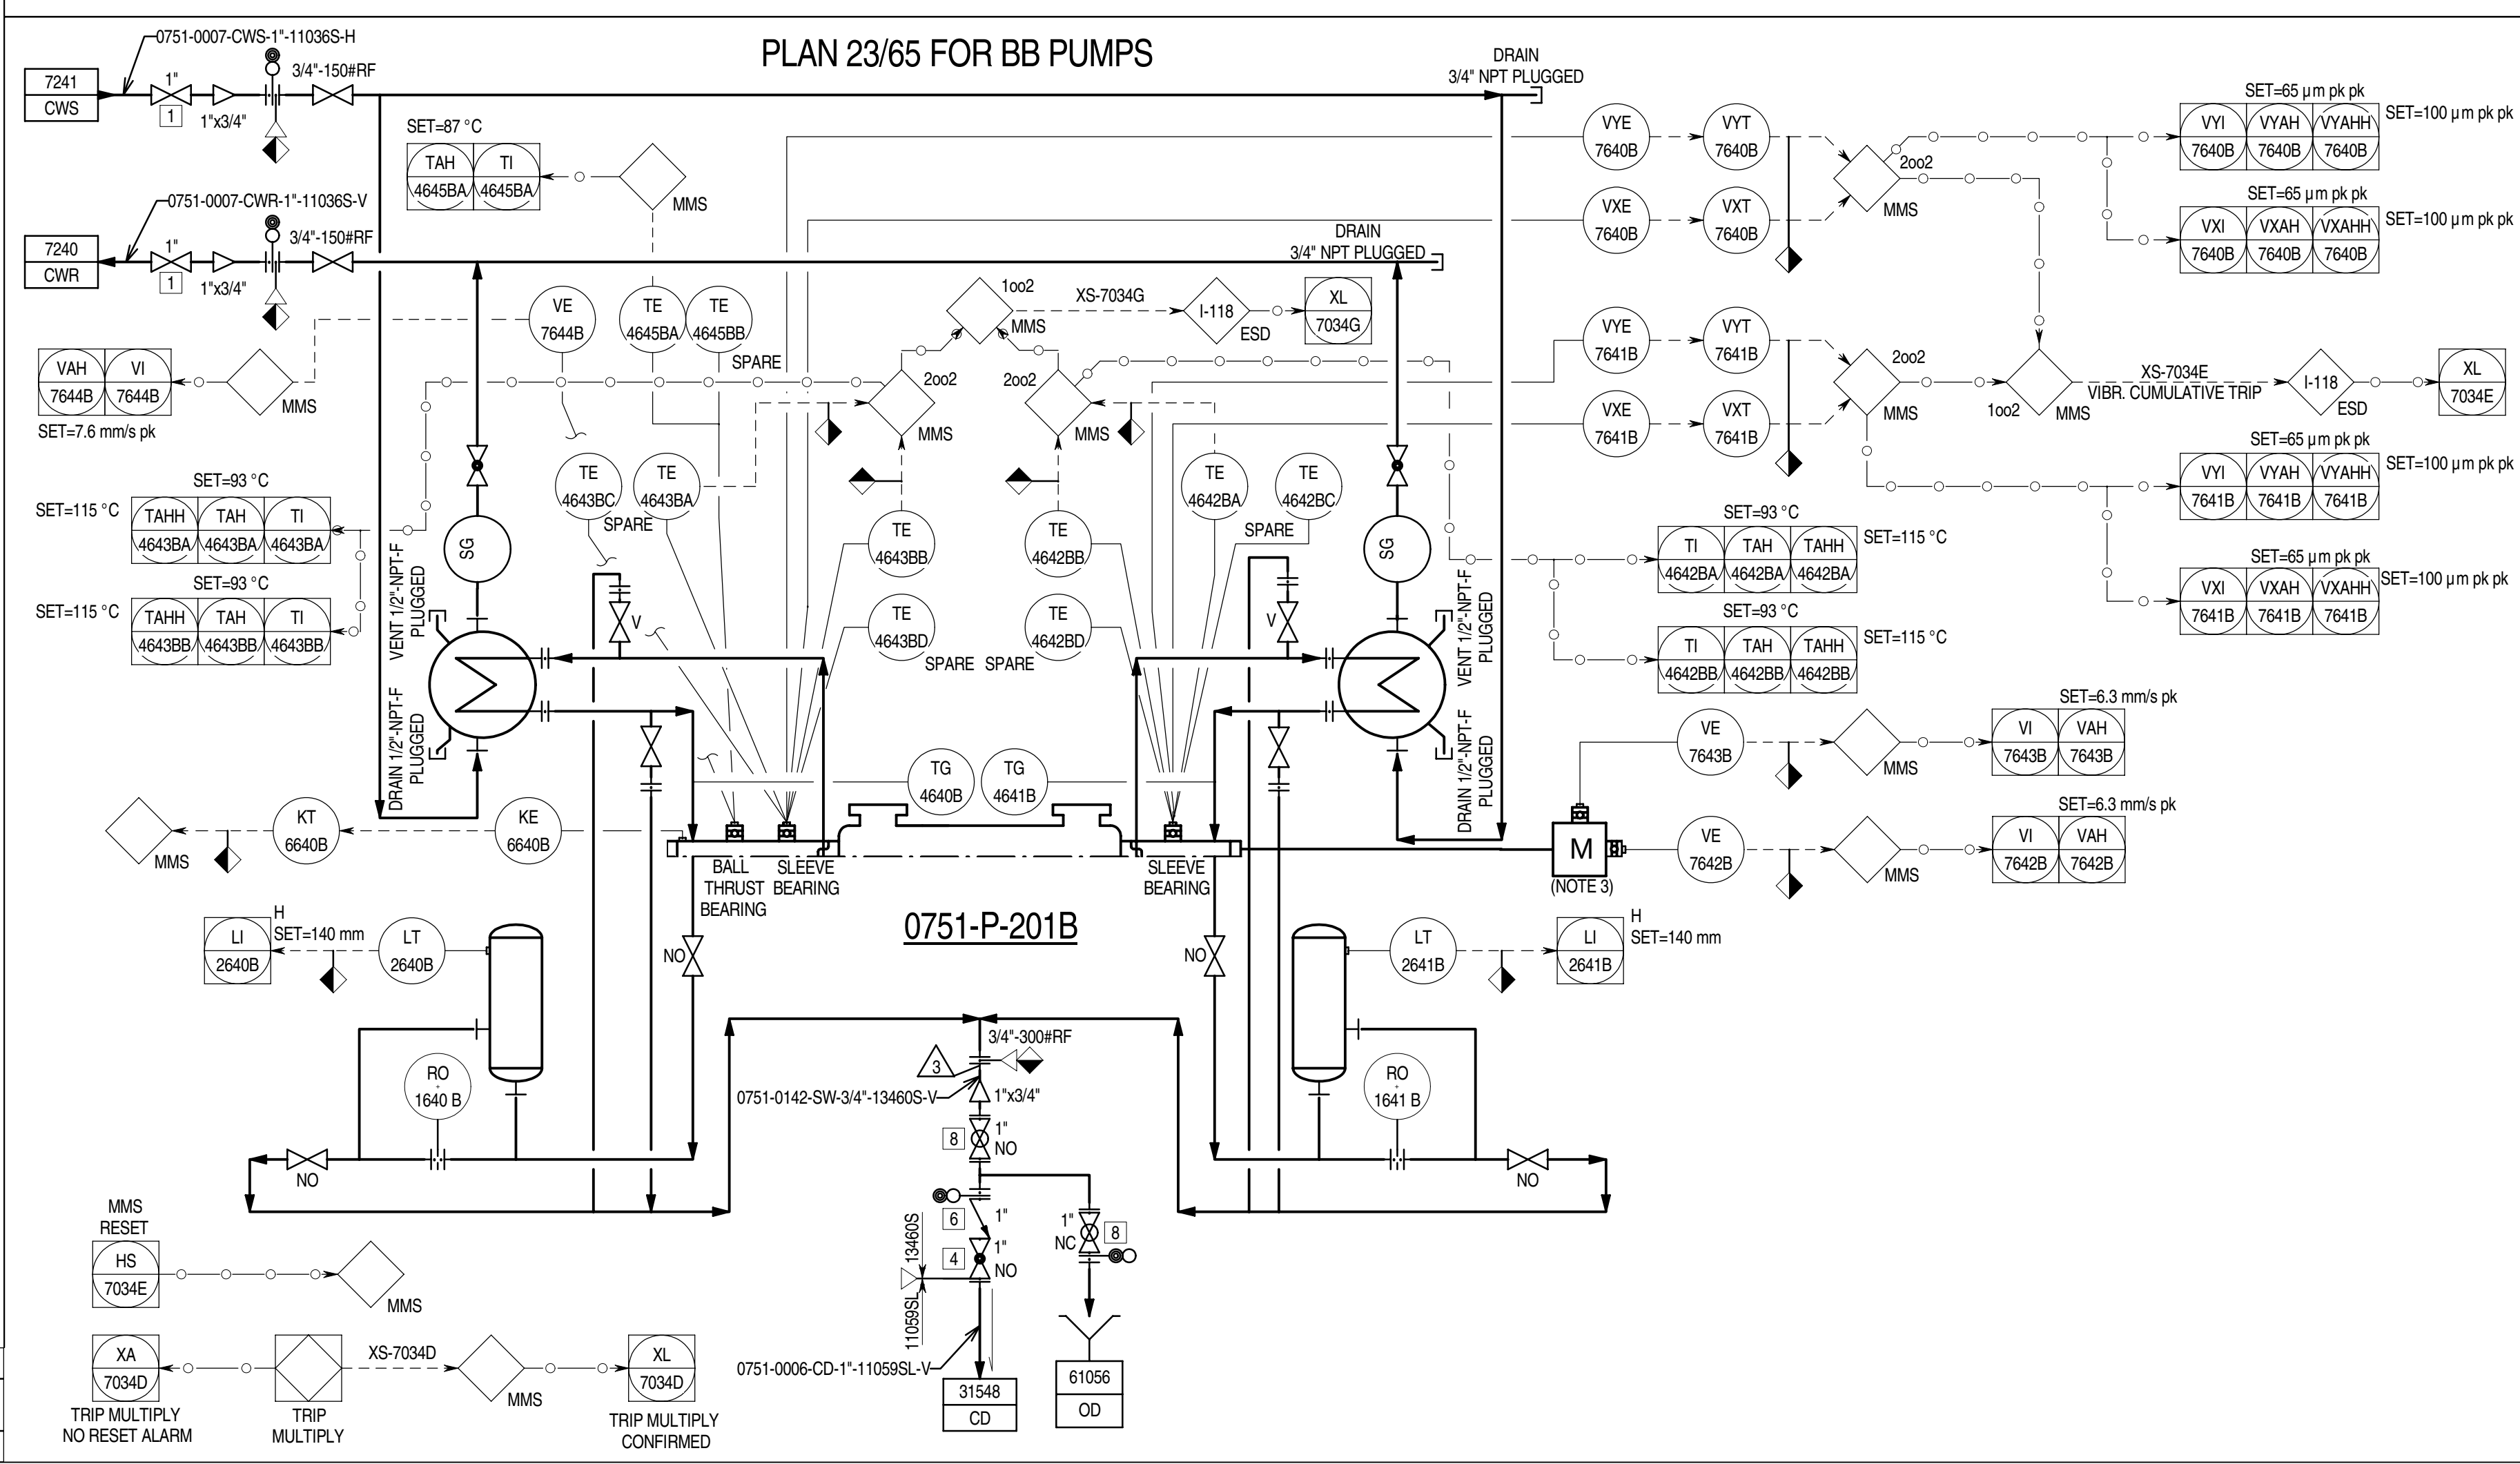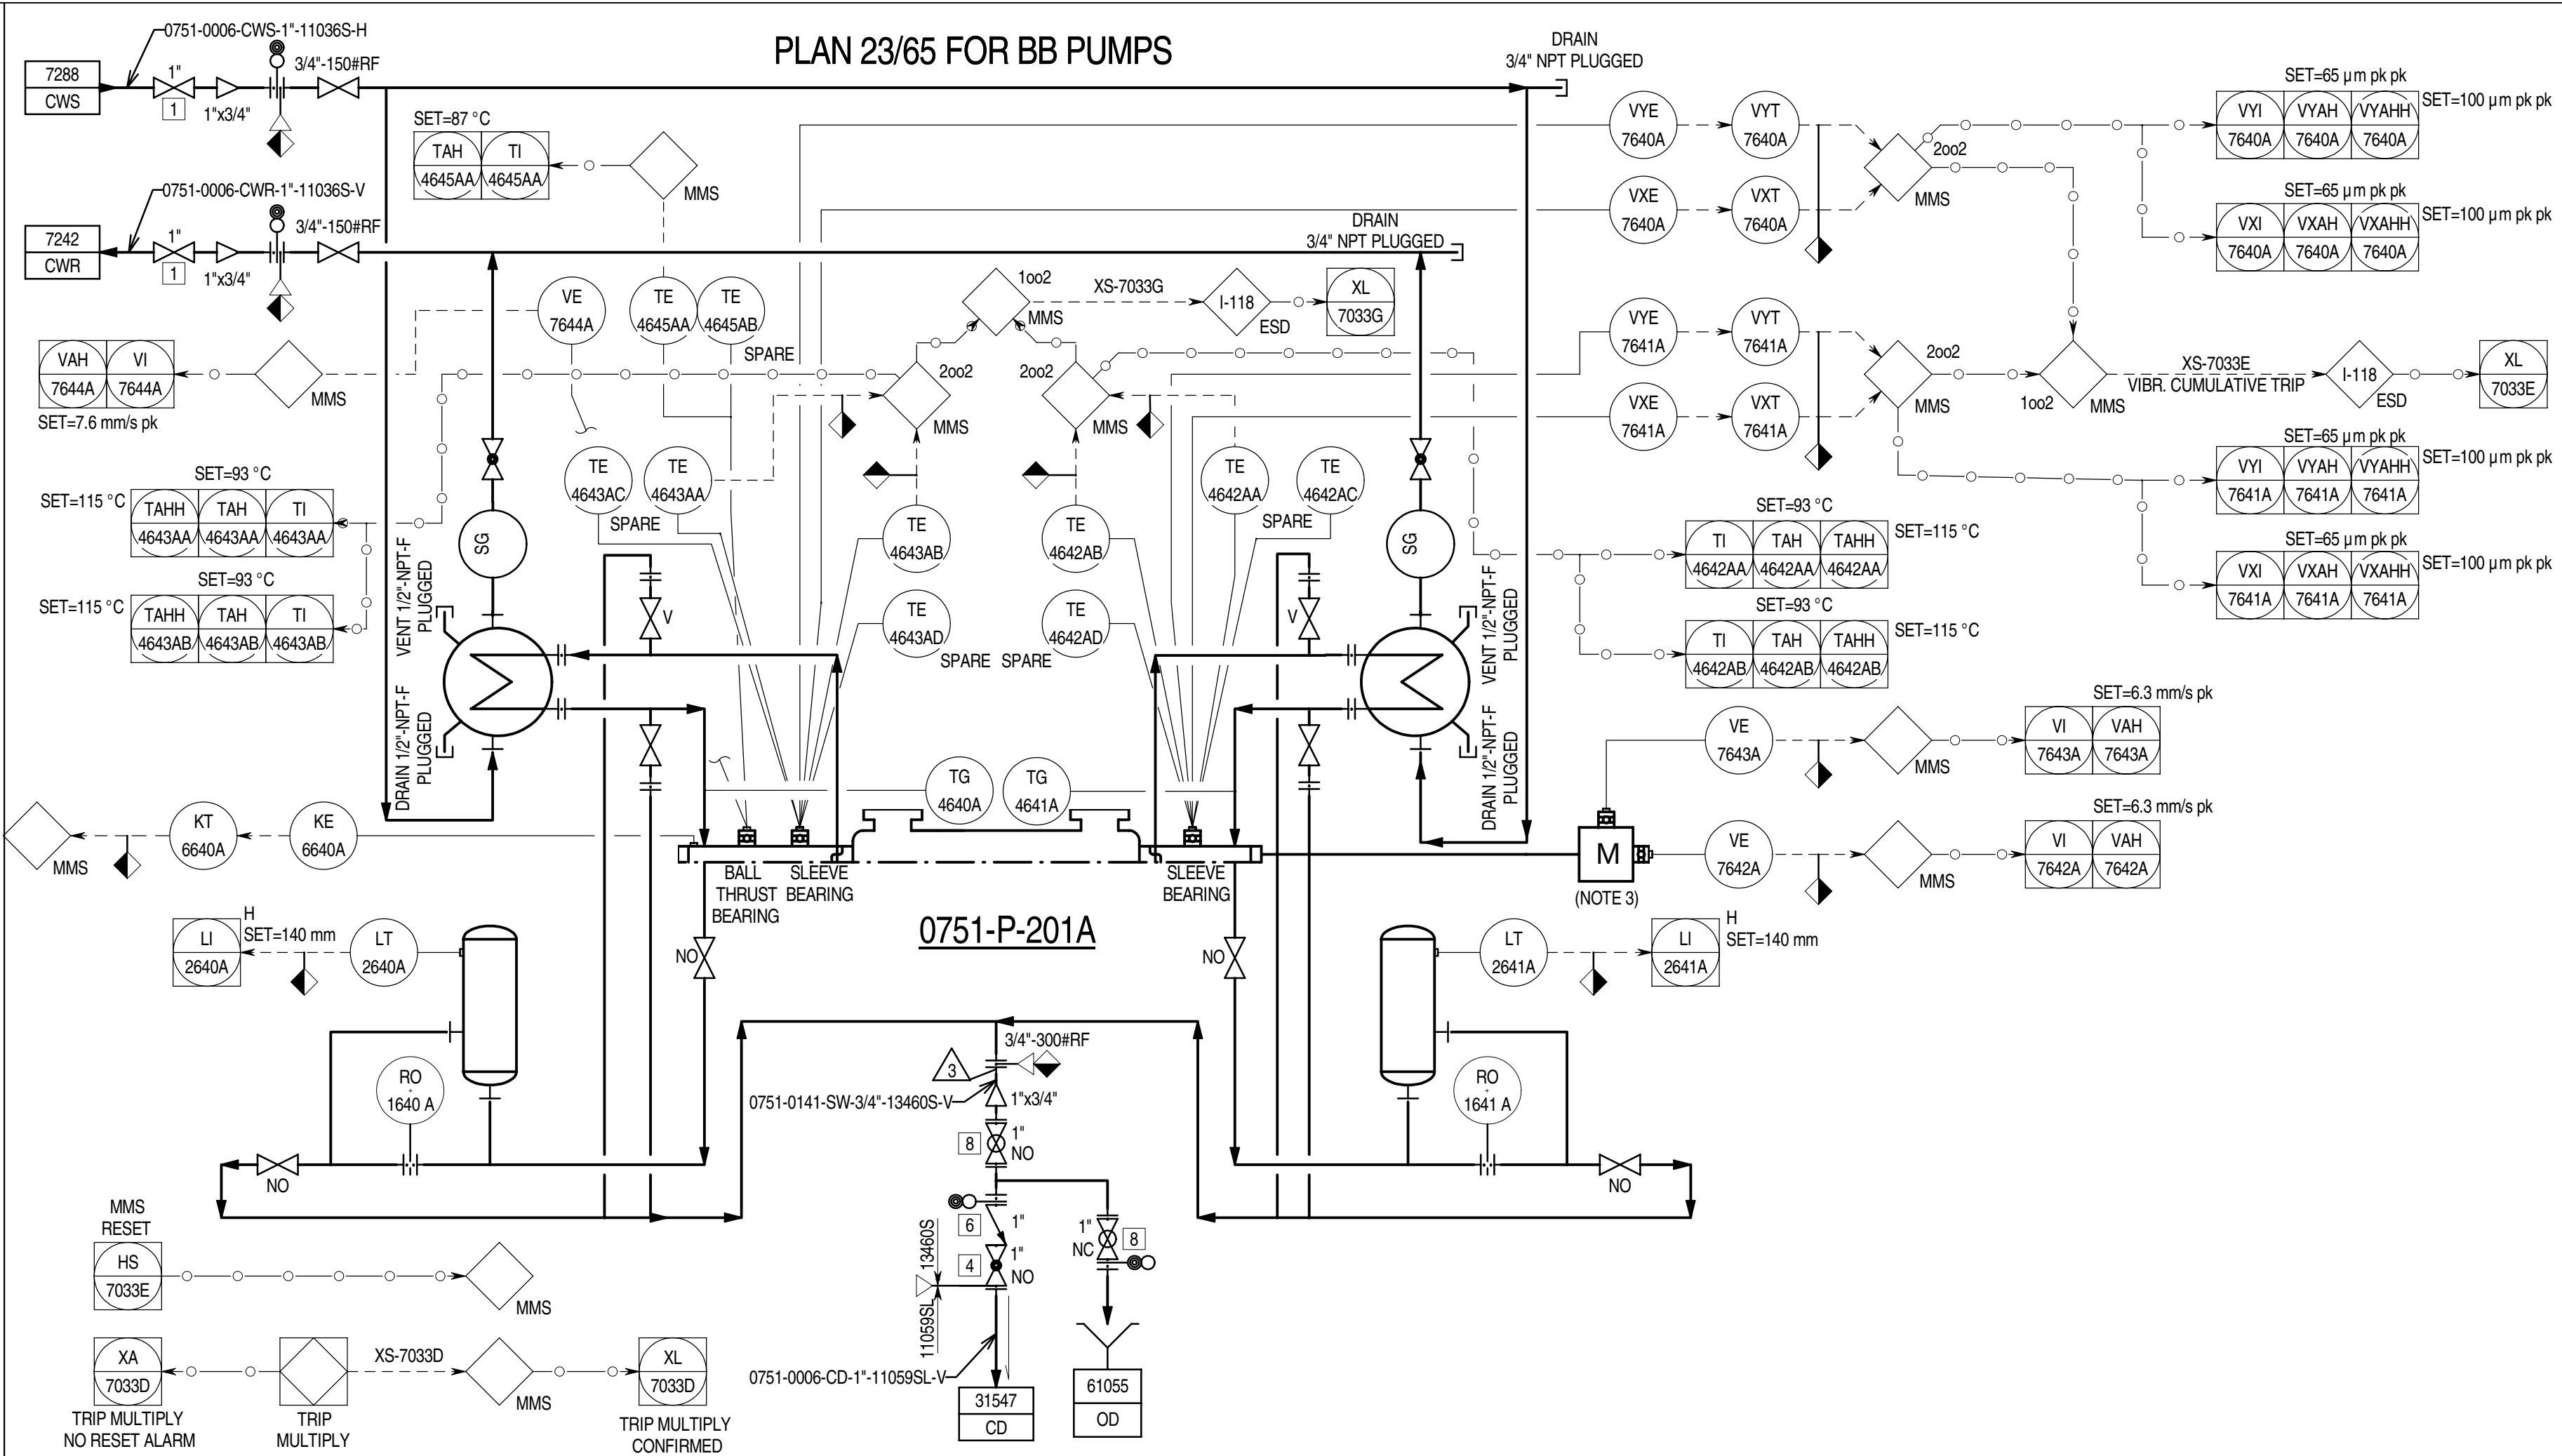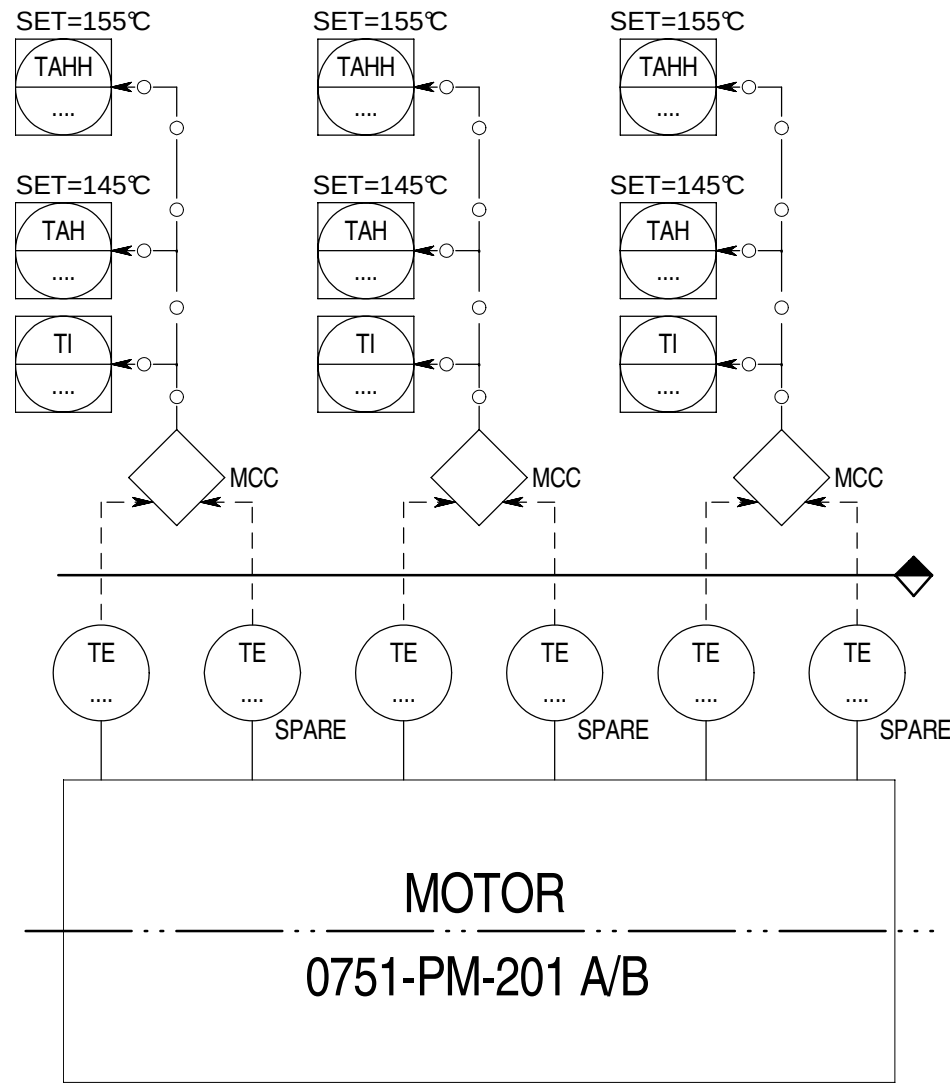

- GENERAL NOTES:**
- FOR STANDARD SYMBOLS, DETAILS, ABBREVIATIONS, SAMPLE CONNECTION TYPE, GENERAL NOTES & LEGEND SHEETS REFER TO DRAWING NO. MP02-0230-00-004000 TO 004015.
 - ALL INSTRUMENT TAG NUMBERS ON THIS P&ID INCLUDING PACKAGE UNITS ARE PREFIXED WITH UNIT NUMBER 0751 UNLESS OTHERWISE NOTED.
 - DELETED.
- NOTES:**
- INTERLOCK TABLE IS FOR REFERENCE ONLY. CAUSE AND EFFECT CHART SR03-0751-00-CCC-303155 SHALL GOVERN.
 - REFER TO CAUSE AND EFFECT CHART FOR FULL REPRESENTATION OF INTERLOCK INITIATORS AND ACTIONS.
 - FOR DETAIL OF TEMPERATURE MEASUREMENTS ON ELECTRICAL MOTOR REFER TO DETAIL "A" AND TABLE 1.

UTILITY REFERENCE TABLE	
CWR/CWS	DRW. N°. SR03-0751-00-PID-362308
OD	DRW. N°. SR03-0751-00-PID-362307

Z1	04-11-14	IAB	ISSUED FOR AS BUILT	PCA	MAR	ASP
2.1F	18-04-14	IFC	ISSUED FOR CONSTRUCTION	PCA	MAR	ASP
2.1E	28-02-14	IFC	ISSUED FOR CONSTRUCTION	PCA	MAR	ASP
2.1D	01-05-13	IFC	ISSUED FOR CONSTRUCTION	RL	CN	MZ
2.1C	31-10-12	IFC	ISSUED FOR CONSTRUCTION	RL	MF	MZ
2.1B	06-08-12	IFC	ISSUED FOR CONSTRUCTION	DSC	CBR	SIN
2	29-12-11	IFC	ISSUED FOR CONSTRUCTION	DSC	CBR	SIN
1	12-08-11	IFCH	ISSUED FOR CONSTRUCTION WITH HOLDS	DSC	CBR	SIN
REV	DATE	STATUS	STATUS DESCRIPTION	BY	CKD	APP.

COMPANY:

Abu Dhabi Gas Development Co. Ltd.

CONTRACTOR:

PROJECT: SHAH GAS DEVELOPMENT (SGD) PROJECT


AGREEMENT No. 13525001

DRAWING TITLE: PIPING & INSTRUMENT DIAGRAM UNIT 0751 SULPHUR RECOVERY AND TAIL GAS TREATING UNIT

EQUIPMENT DESCRIPTION	API PLAN 0751-P-201A/B AND VIBRATION MONITORING
TAGITEM No.	

CONTRACTOR DRG. No.	751-GD-B-303342	REV. Z1
COMPANY DRG. No.	SR03-0751-00-303342-003	
SCALE:	SIZE: A1 DOC. CLASS: 1	

THIS DOCUMENT IS THE PROPERTY OF ABU DHABI GAS DEVELOPMENT COMPANY LIMITED AND CONTAINS INFORMATION WHICH IS PROPRIETARY. THIS INFORMATION IS TO BE HELD IN CONFIDENCE. NO DISCLOSURE OR OTHER USE OF THIS DOCUMENT IS TO BE MADE WITHOUT THE PRIOR WRITTEN CONSENT OF ABU DHABI GAS DEVELOPMENT COMPANY LIMITED.

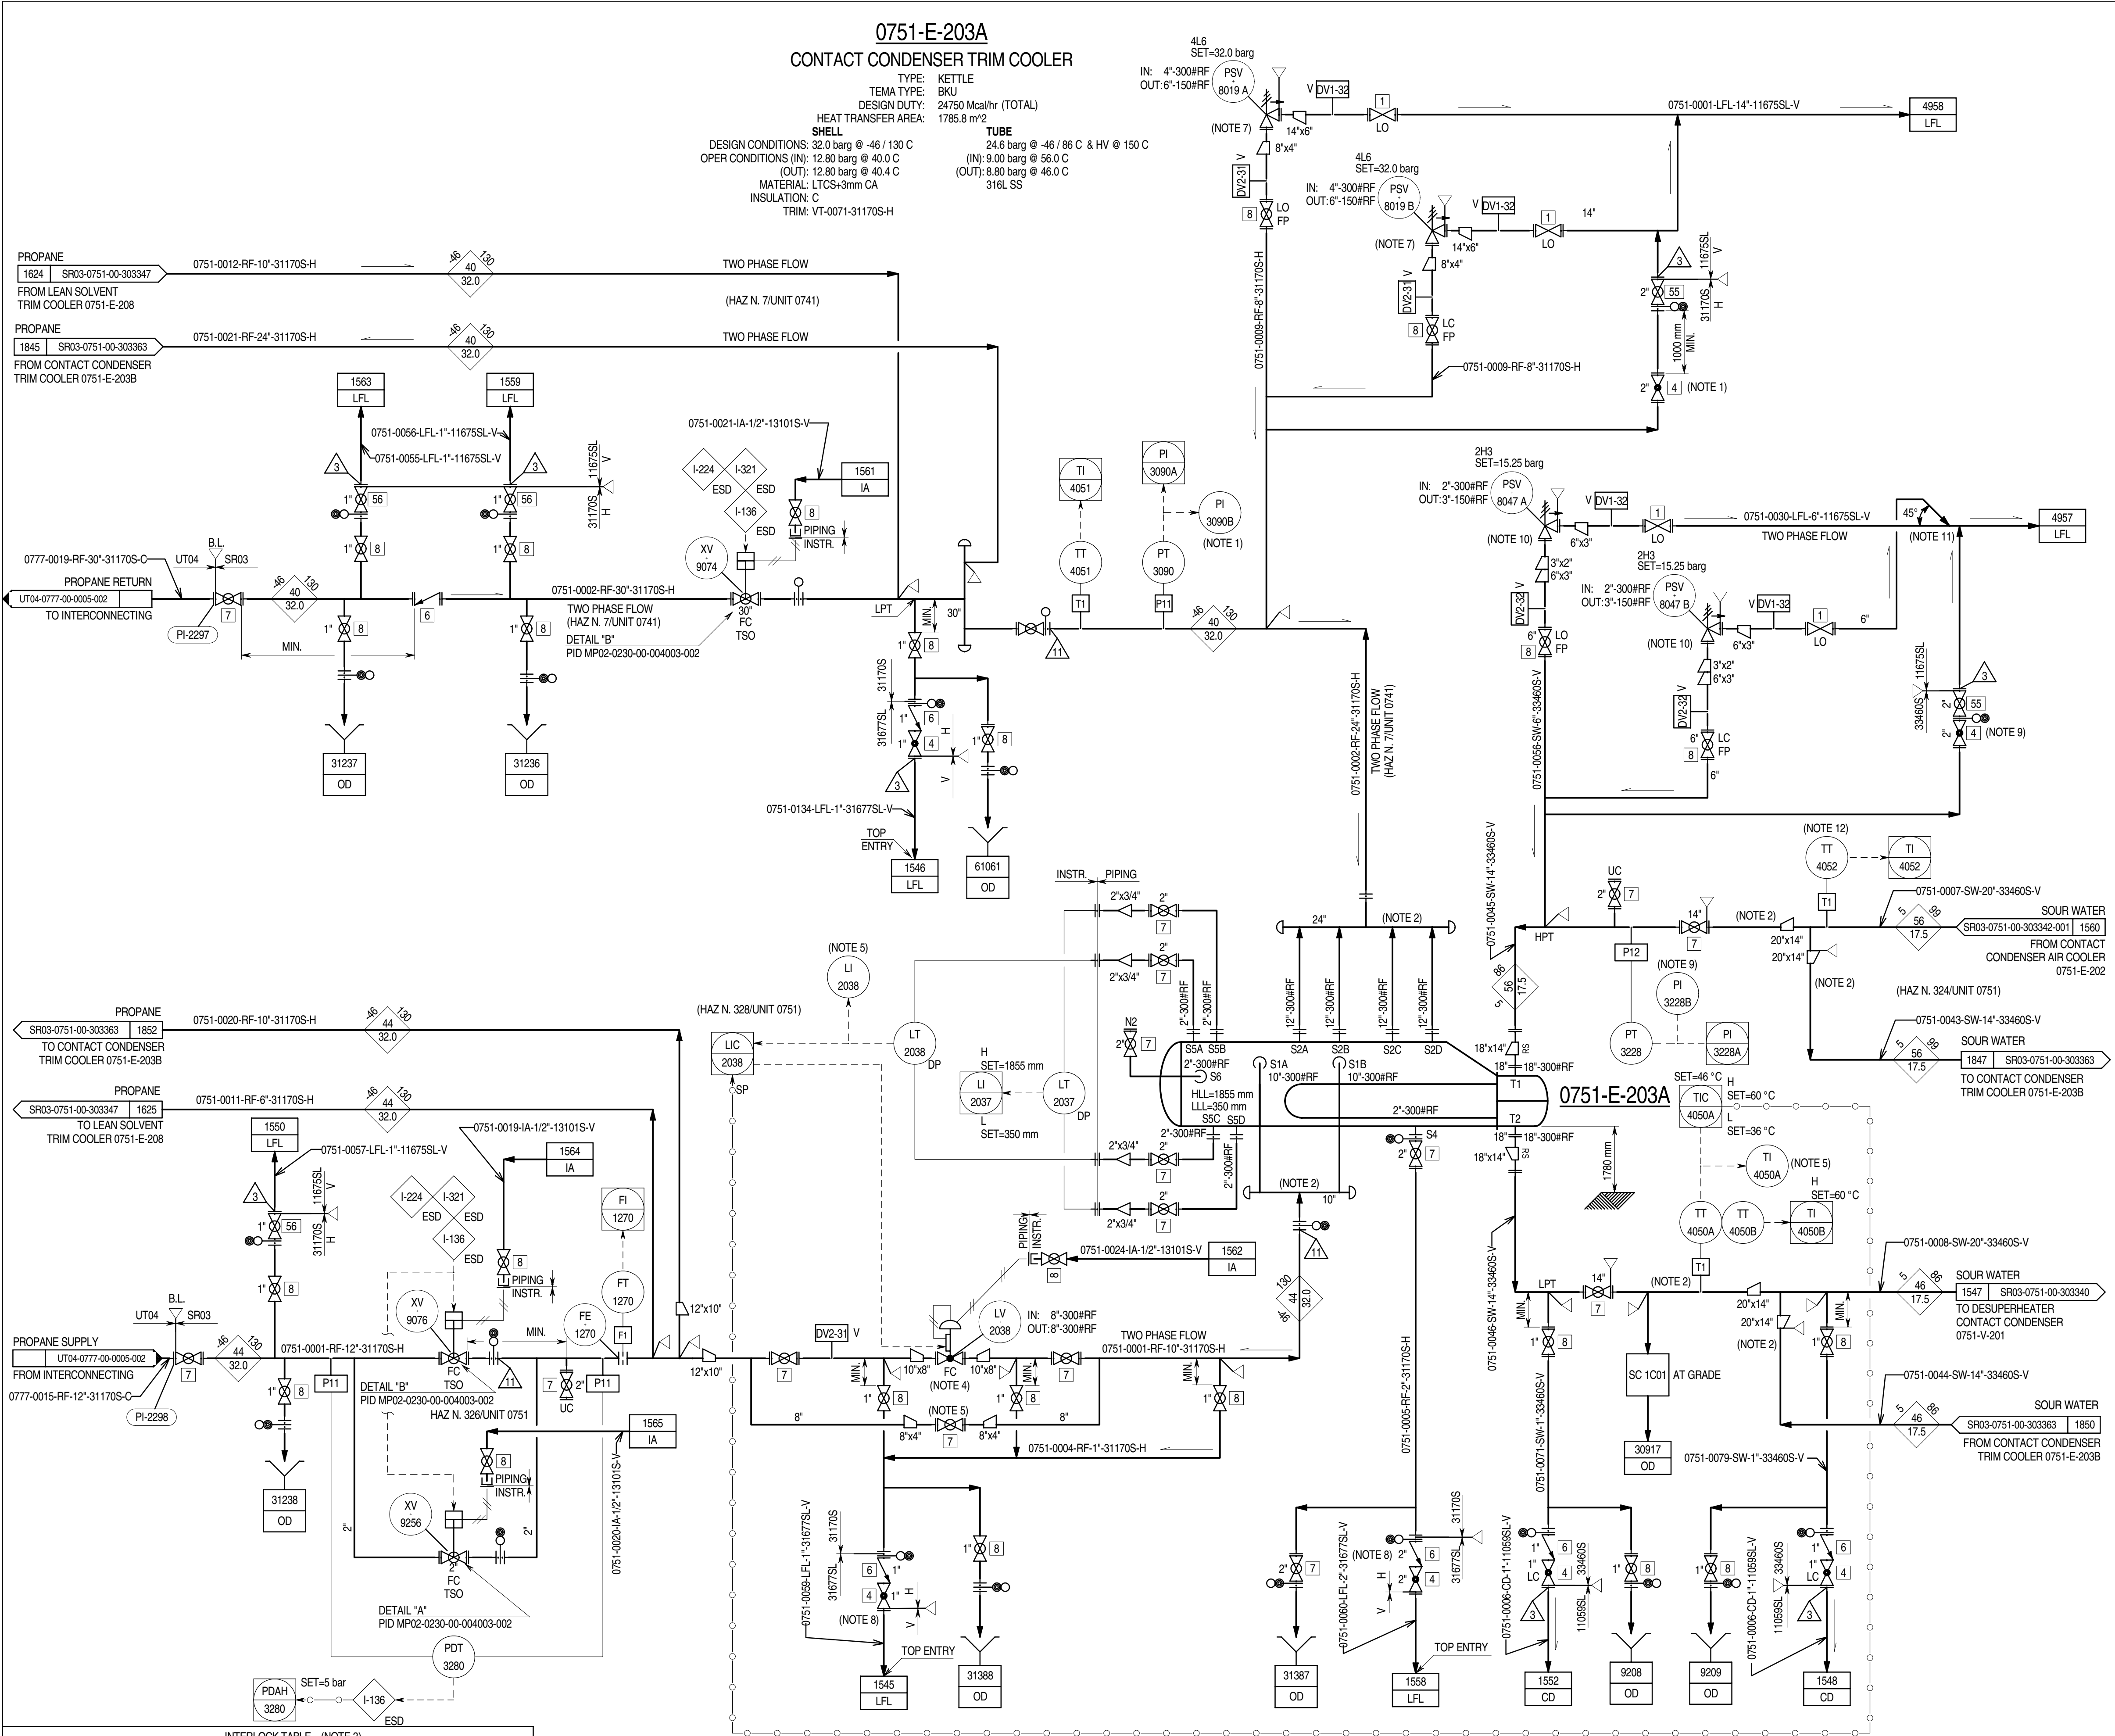

INTERLOCK TABLE (NOTE 3)		
INTERLOCK NUMBER	LOGIC DESCRIPTION (NOTE 6)	REFERENCE DOCUMENT N.
I-321	SULPHUR RECOVERY UNIT	SR03-0751-00-303375
I-224	INCINERATORS SECTION	SR03-0751-00-303375
I-136	PROPANE SUPPLY/RETURN	SR03-0751-00-303375

GENERAL NOTES:

- FOR STANDARD SYMBOLS, DETAILS, ABBREVIATIONS, SAMPLE CONNECTION TYPE, GENERAL NOTES & LEGEND SHEETS REFER TO DRAWING NO. MP02-0230-00-004000 TO 004015.
 - ALL INSTRUMENT TAG NUMBERS ON THIS P&ID INCLUDING PACKAGE UNITS ARE PREFIXED WITH UNIT NUMBER 0751 UNLESS OTHERWISE NOTED.
 - DELETED.
- NOTES:**
- PI-3050B TO BE READABLE FROM PSV-8019A/B MANUAL VENT VALVE.
 - SYMMETRICAL PIPING.
 - INTERLOCK TABLE IS FOR REFERENCE ONLY. CAUSE AND EFFECT CHART SR03-0751-00-CCC-303155 SHALL GOVERN.
 - LV-2038 TO BE AT GRADE AT MIN. DISTANCE FROM INLET NOZZLE OF 0751-E-203A.
 - LI-2038 AND TI-4050A TO BE READABLE FROM LV-2038 BYPASS VALVE.
 - REFER TO CAUSE AND EFFECT CHART FOR FULL REPRESENTATION OF INTERLOCK INITIATORS AND ACTIONS.
 - PSV-8019A/B SIZING CASE: FIRE.
 - DRAIN VALVES TO BE INSTALLED CLOSE TO THE LINE/EQUIPMENT TO BE DRAINED.
 - PI-3228B TO BE READABLE FROM PSV-8047A/B MANUAL VENT VALVE.
 - PSV-8047A/B SIZING CASE: TUBE RUPTURE.
 - USE 45°C TOP ENTRY CONNECTION.
 - PT-3159 AND TT-4049 (DWG. SR03-0751-00-303342-001) TO BE LOCATED AT THE SAME ELEVATION OF PT-3160 (DWG. SR03-0751-00-303342-001) AND TT-4052.

UTILITY REFERENCE TABLE	
IA	DRW. N°. SR03-0751-00-PID-362305
CD	DRW. N°. SR03-0751-00-PID-362306
OD	DRW. N°. SR03-0751-00-PID-362307
LFL	DRW. N°. SR03-0751-00-PID-362313

Z1	04-11-14	IAB	ISSUED FOR AS BUILT	PCA	MAR	ASP
2.1B	06-08-12	IFC	ISSUED FOR CONSTRUCTION	DSC	CBR	SIN
2	29-12-11	IFC	ISSUED FOR CONSTRUCTION	DSC	CBR	SIN
1	12-08-11	IFCH	ISSUED FOR CONSTRUCTION WITH HOLDS	DSC	CBR	SIN
0	01-03-11	IFD	ISSUED CLIENT COMMENTS INCORPORATED	BSC	LMA	SIN
B1	30-09-10	ICR	ISSUED FOR CLIENT REVIEW	BSC	LMA	SIN
REV	DATE	STATUS	STATUS DESCRIPTION	BY	CKD	APP.

COMPANY:

Abu Dhabi Gas Development Co. Ltd.

الحصن للغاز
Al Hosn Gas

CONTRACTOR:



JOB No. 032090

PROJECT: **SHAH GAS DEVELOPMENT (SGD) PROJECT**

AGREEMENT No. **13525001**

DRAWING TITLE: **PIPING & INSTRUMENT DIAGRAM UNIT 0751 SULPHUR RECOVERY AND TAIL GAS TREATING UNIT**


EQUIPMENT DESCRIPTION	CONTACT CONDENSER TRIM COOLER A	
TAGITEM No.	0751-E-203A	

CONTRACTOR DRG. No.	751-GD-B-303343		REV. Z1
COMPANY DRG. No.	SR03-0751-00-303343		
SCALE:	SIZE: A1	DOC. CLASS: 1	

THIS DOCUMENT IS THE PROPERTY OF ABU DHABI GAS DEVELOPMENT COMPANY LIMITED. NO DISCLOSURE OR OTHER USE OF THIS DOCUMENT IS TO BE MADE WITHOUT THE PRIOR WRITTEN CONSENT OF ABU DHABI GAS DEVELOPMENT COMPANY LIMITED.

0751-V-202 TGTU ABSORBER

TYPE: VERTICAL
SIZE: 7010 mm ID x 22840 mm T/T
CAPACITY: 973.0 m³
DESIGN CONDITIONS: 5.5 barg @ 0 / 87 C
OPER CONDITIONS: 0.1 barg @ 49 C (TOP) & HV @ 150 C
0.7 barg @ 57 C (BOTTOM)
MATERIAL: CS-3mm 316L SS CLADDING
INSULATION: TRIM:
VT-0030-11059SL-V
VT-0080-31059SL-V
LETHAL SERVICE
VT-0172-31059SL-V FOR
LT-2039/2040

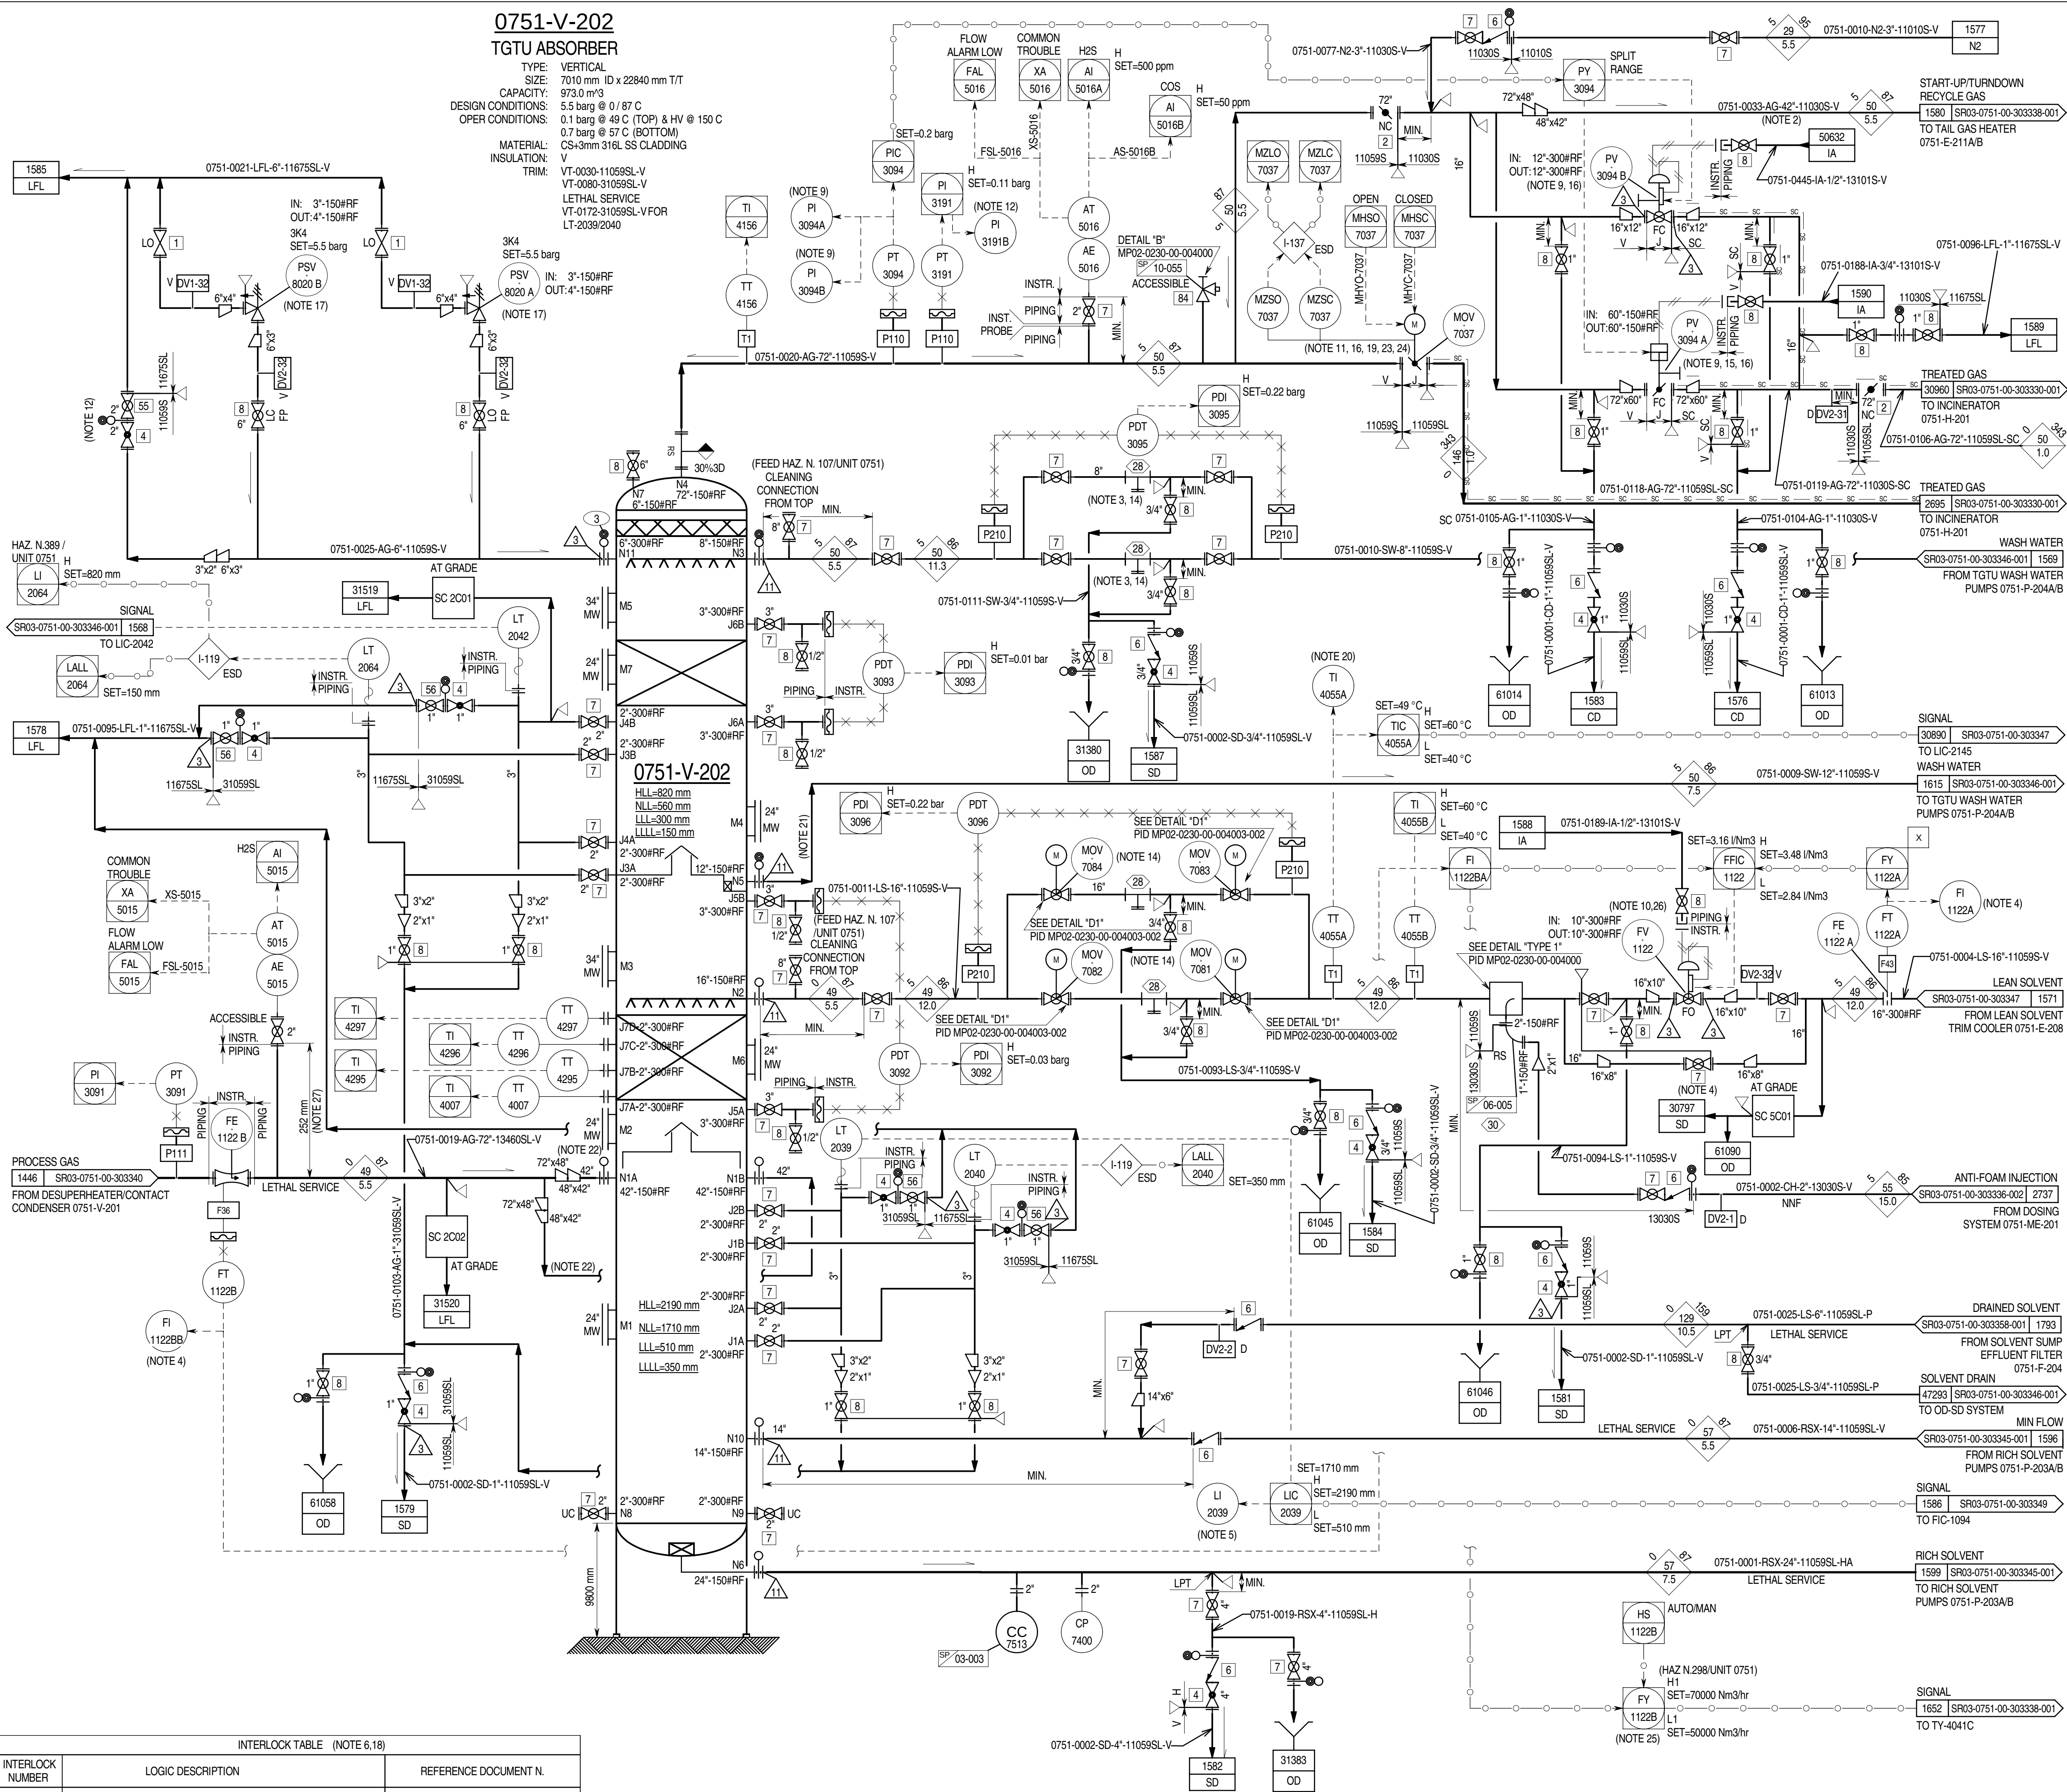

INTERLOCK TABLE (NOTE 6.18)		
INTERLOCK NUMBER	LOGIC DESCRIPTION	REFERENCE DOCUMENT N.
I-119	TGTU ABSORBER	SR03-0751-00-303375

GENERAL NOTES:

- FOR STANDARD SYMBOLS, DETAILS, ABBREVIATIONS, SAMPLE CONNECTION TYPE, GENERAL NOTES & LEGEND SHEETS REFER TO DRAWING NO. MP02-0230-00-004000 TO 004015.
 - ALL INSTRUMENT TAG NUMBERS ON THIS P&ID INCLUDING PACKAGE UNITS ARE PREFIXED WITH UNIT NUMBERS 0751 UNLESS OTHERWISE NOTED.
 - DELETED.
- NOTES:
- DELETED.
 - RECYCLE GAS LINE SHALL BE PURGED WITH NITROGEN AFTER CATALYST PRESULPHIDING OPERATION AND BEFORE START-UP.
 - LOCATE AT GRADE MINIMUM DISTANCE FROM TOWER.
 - FI-1122A AND FI-1122B TO BE READABLE FROM FV-1122 BYPASS VALVE.
 - LI-2039 TO BE READABLE FROM OF FV-1094 (ON DRW. SR03-0751-00-303349) BYPASS VALVE. REFER TO C & E MATRIX SR03-0751-00-CLC-303155. (HAZ N. 391/UNIT 0751)
 - INTERLOCK TABLE IS FOR REFERENCE ONLY. CAUSE AND EFFECT MATRIX SR03-0751-00-CCC-303155 SHALL GOVERN.
 - DELETED.
 - DELETED.
 - PI-3094A/B TO BE READABLE FROM VALVES PV-3094A/B.
 - VALVE FV-1122 IS EQUIPPED WITH MECHANICAL STOP.
 - MOV-7037 CAN BE CLOSED ONLY IF XV-9107 (ON DRW. SR03-0751-00-303322) IS CLOSED REFER TO C & E MATRIX SR03-0751-00-CLC-303155. (HAZ N. 391/UNIT 0751)
 - PI-3191B TO BE READABLE FROM MANUAL VENT VALVE.
 - DELETED.
 - STRAINER WITH SCREEN 12 MESH.
 - PV-3094 PROVIDED WITH AIR VOLUME TANK FOR STROKE FAIL POSITION.
 - STEAM JACKETED VALVE.
 - PSV SIZING CASE: FIRE.
 - REFER TO CAUSE AND EFFECT CHART FOR FULL REPRESENTATION INTERLOCK INITIATORS AND ACTIONS.
 - LOCAL OPEN/CLOSED/STOP CONTROLS TO BE INHIBITED. (HAZ N. 386/UNIT 0751)
 - TI-4055A TO BE READABLE FROM LV-2145 BYPASS VALVE ON DRW. SR03-0751-00-303347.
 - PROVIDE 3000 mm STRAIGHT PIPE (60% SD).
 - SYMMETRICAL PIPING.
 - LOCAL OPEN/CLOSED/STOP CONTROL TO BE INHIBITED. (HAZ N. 383/UNIT 0751)
 - DISCREPANCY ALARM SHALL BE PROVIDED.
 - SET POINTS TO BE ADJUSTED DURING COMMISSIONING.
 - FV-1122 TO BE PROVIDED WITH LOCAL SIGN: "WARNING TRIM SIZE AFFECT THE RELIEF VALVE CAPACITY"
 - FROM PIPE OD.

UTILITY REFERENCE TABLE		
CD	DRW. N°.	SR03-0751-00-PID-362306
IA	DRW. N°.	SR03-0751-00-PID-362305
OD	DRW. N°.	SR03-0751-00-PID-362307
N2	DRW. N°.	SR03-0751-00-PID-362310
SD	DRW. N°.	SR03-0751-00-PID-362311
LFL	DRW. N°.	SR03-0751-00-PID-362313

Z1	04-11-14	IAB	ISSUED FOR AS BUILT	PCA	MAR	ASP
2.1F	18-04-14	IFC	ISSUED FOR CONSTRUCTION	PCA	MAR	ASP
2.1E	28-02-14	IFC	ISSUED FOR CONSTRUCTION	PCA	MAR	ASP
2.1D	09-03-13	IFC	ISSUED FOR CONSTRUCTION	RL	CN	MZ
2.1C	31-10-12	IFC	ISSUED FOR CONSTRUCTION	RL	MF	MZ
2.1B	06-08-12	IFC	ISSUED FOR CONSTRUCTION	DSC	CBR	SIN
2	29-12-11	IFC	ISSUED FOR CONSTRUCTION	DSC	CBR	SIN
1	12-08-11	IFCH	ISSUED FOR CONSTRUCTION WITH HOLDS	DSC	CBR	SIN
0	01-03-11	IFD	ISSUED CLIENT COMMENTS INCORPORATED	BSC	LMA	SIN
B1	30-09-10	ICR	ISSUED FOR CLIENT REVIEW	BSC	LMA	SIN

COMPANY:


Abu Dhabi Gas Development Co. Ltd.

CONTRACTOR:

PROJECT: SHAH GAS DEVELOPMENT (SGD) PROJECT

AGREEMENT No. 13525001

DRAWING TITLE: PIPING & INSTRUMENT DIAGRAM UNIT 0751 SULPHUR RECOVERY AND TAIL GAS TREATING UNIT		
EQUIPMENT DESCRIPTION	TGTU ABSORBER	
TAGITEM No.	0751-V-202	
CONTRACTOR DRG. No.	751-GD-B-303344	REV.
COMPANY DRG. No.	SR03-0751-00-303344	Z1
SCALE:	SIZE: A1	DOC. CLASS: 1

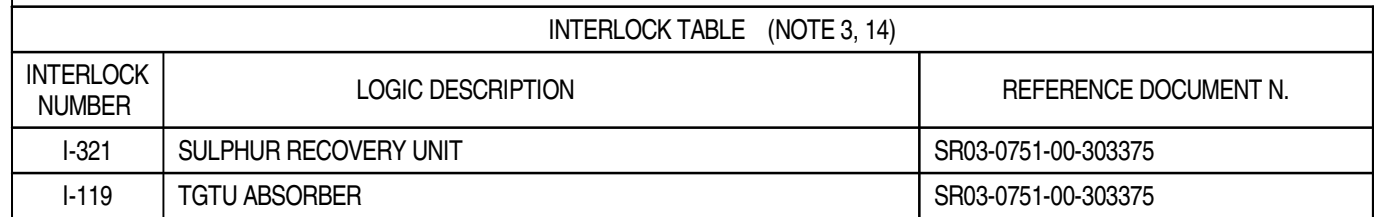

UTILITY REFERENCE TABLE		
IA	DRW. N°.	SR03-0751-00-PID-362305
LFL	DRW. N°.	SR03-0751-00-PID-362313
SD	DRW. N°.	SR03-0751-00-PID-362311
OD	DRW. N°.	SR03-0751-00-PID-362307

Z1	04-11-14	Z1	ISSUED FOR AS BUILT	PCA	MAR	SAT
2.1D	18-04-14	IFC	ISSUED FOR CONSTRUCTION	PCA	MAR	AS
2.1C	09-03-13	IFC	ISSUED FOR CONSTRUCTION	RL	CN	MZ
2.1B	06-08-12	IFC	ISSUED FOR CONSTRUCTION	DSC	CBR	SIN
2	29-12-11	IFC	ISSUED FOR CONSTRUCTION	DSC	CBR	SIN
1	12-08-11	IFCH	ISSUED FOR CONSTRUCTION WITH HOLDS	DSC	CBR	SIN
0	01-03-11	IFD	ISSUED CLIENT COMMENTS INCORPORATED	BSC	LMA	SIN
B1	30-09-10	ICR	ISSUED FOR CLIENT REVIEW	BSC	LMA	SIN
REV	DATE	STATUS	STATUS DESCRIPTION	BY	CKD	APP

COMPANY:

Abu Dhabi Gas Development Co. Ltd.



CONTRACTOR:

 **saipem**

JOB No. 032090

PROJECT: SHAH GAS DEVELOPMENT (SGD) PROJECT

AGREEMENT No. 13525001

<u>DRAWING TITLE:</u> PIPING & INSTRUMENT DIAGRAM UNIT 0751 SULPHUR RECOVERY AND TAIL GAS TREATING UNIT	
EQUIPMENT DESCRIPTION	RICH SOLVENT PUMPS
TAG/ITEM No.	0751-P-203A / B

CONTRACTOR DRG.No.	751-GD-B-303345		REV. Z1
COMPANY DRG.No.	SR03-0751-00-303345-001		
SCALE:	SIZE: A1	DOC. CLASS: 1	

THIS DOCUMENT IS THE PROPERTY OF ABU DHABI GAS DEVELOPMENT COMPANY LIMITED AND CONTAINS INFORMATION WHICH IS PROPRIETARY. THIS INFORMATION IS TO BE HELD IN CONFIDENCE. NO DISCLOSURE OR OTHER USE OF THIS DOCUMENT IS TO BE MADE WITHOUT THE PRIOR WRITTEN CONSENT OF ABU DHABI GAS DEVELOPMENT COMPANY LIMITED.

PLAN 11/53B FOR BB PUMPS


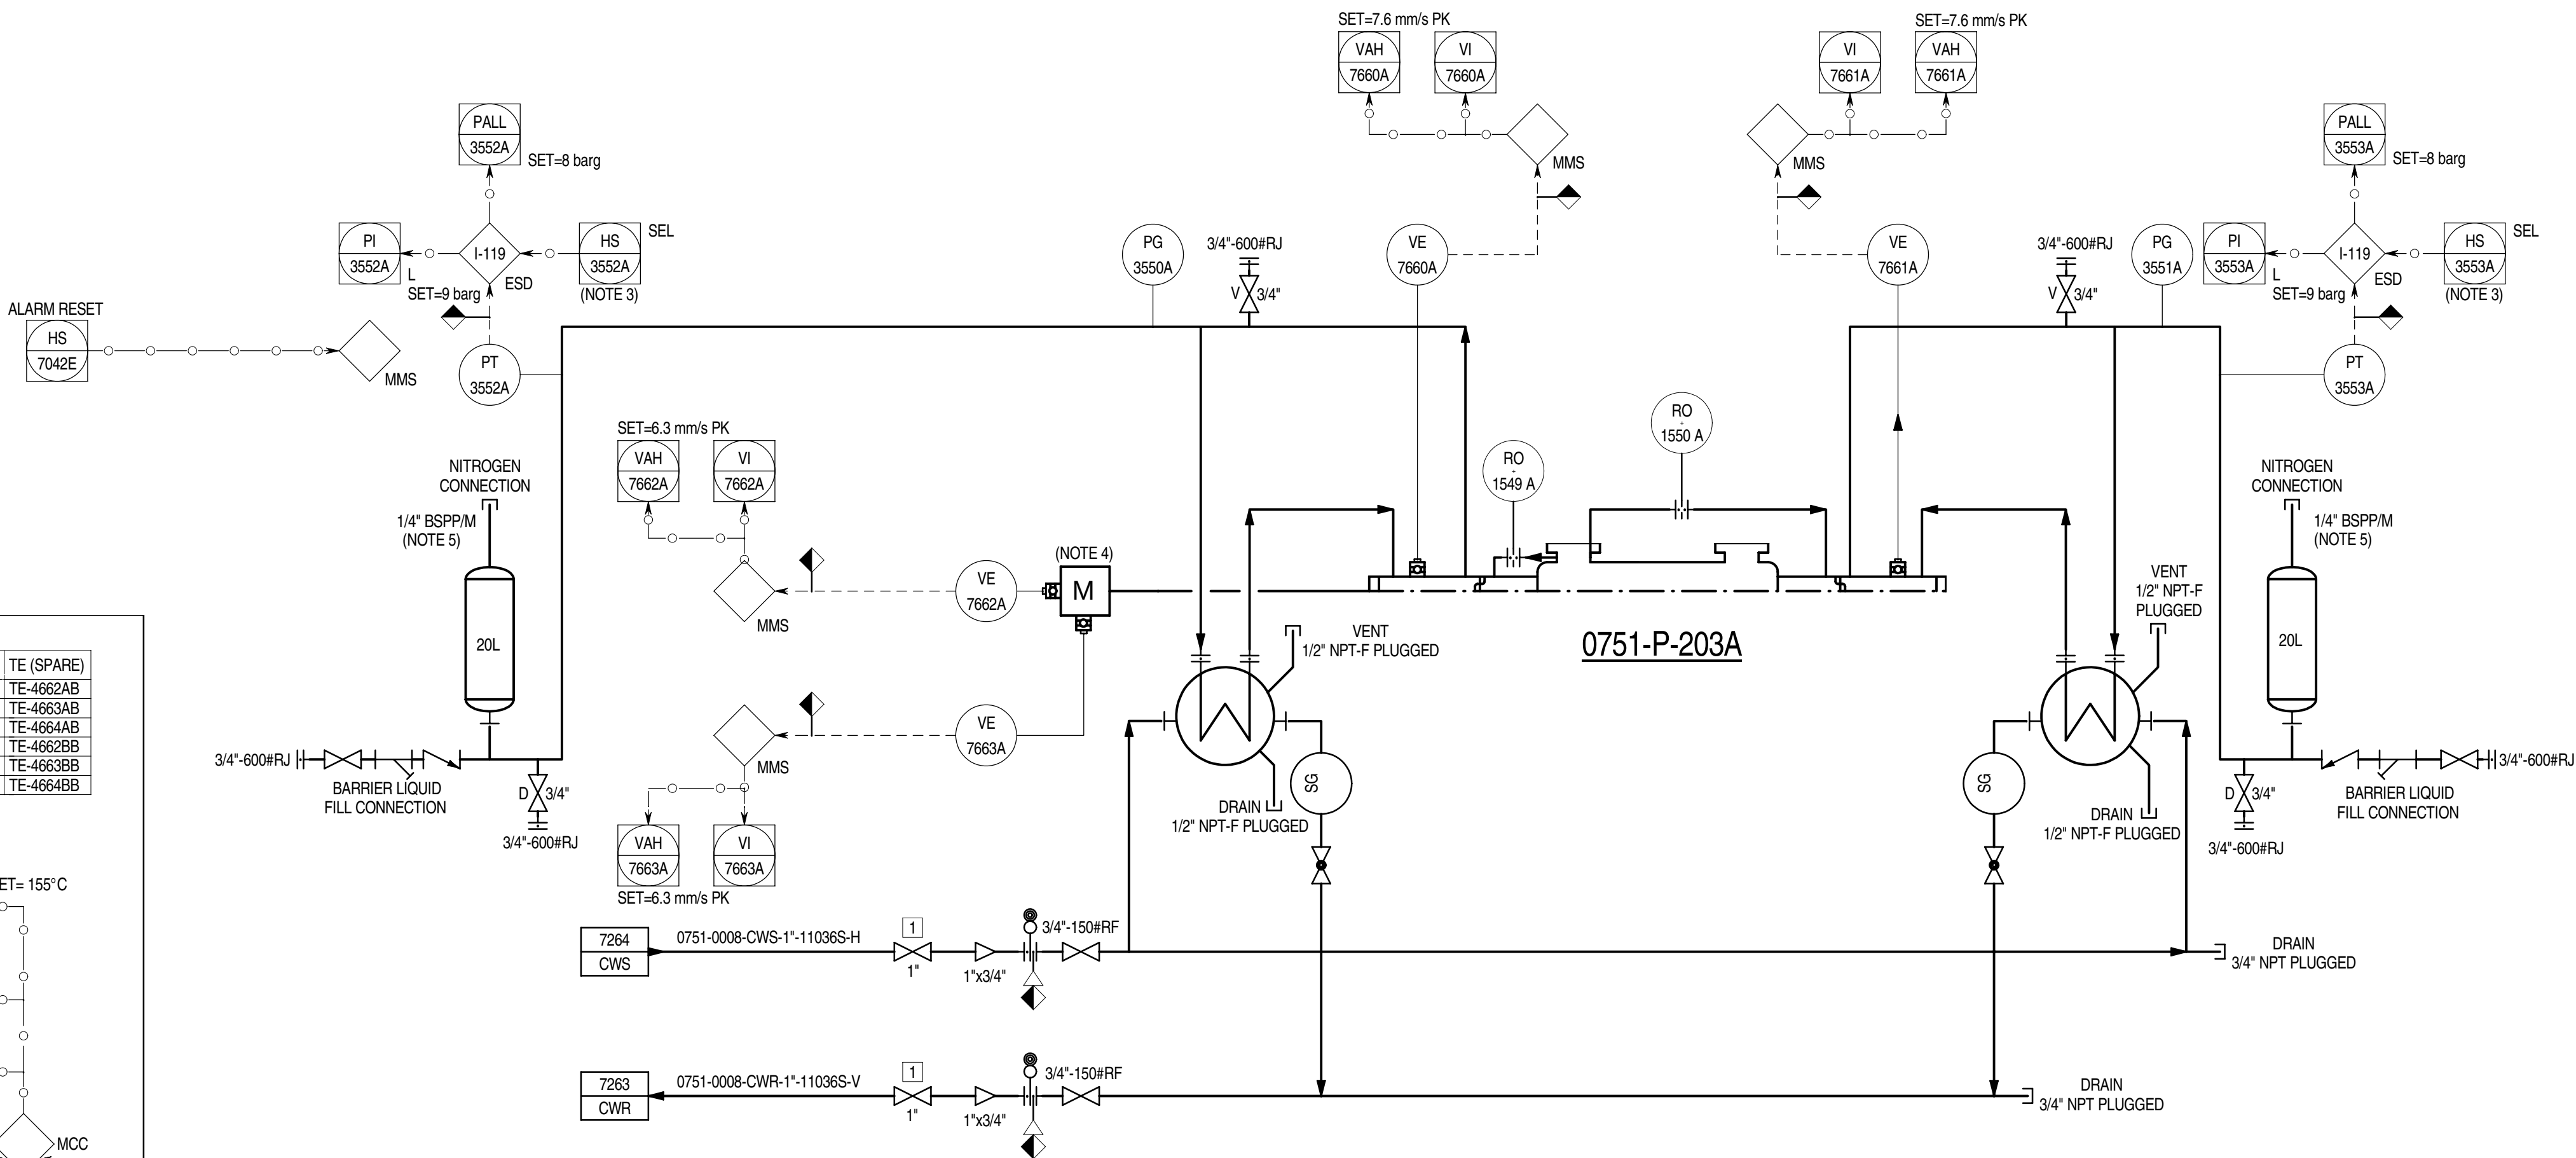



TABLE 1 (NOTE 4)

MOTOR PUMP	TE	TI	TAH	TAHH	TE (SPARE)
0751-PM-203A	TE-4662AA	TI-4662A	TAH-4662A	TAHH-4662A	TE-4662AB
	TE-4663AA	TI-4663A	TAH-4663A	TAHH-4663A	TE-4663AB
	TE-4664AA	TI-4664A	TAH-4664A	TAHH-4664A	TE-4664AB
0751-PM-203B	TE-4662BA	TI-4662B	TAH-4662B	TAHH-4662B	TE-4662BB
	TE-4663BA	TI-4663B	TAH-4663B	TAHH-4663B	TE-4663BB
	TE-4664BA	TI-4664B	TAH-4664B	TAHH-4664B	TE-4664BB

DETAIL "A"

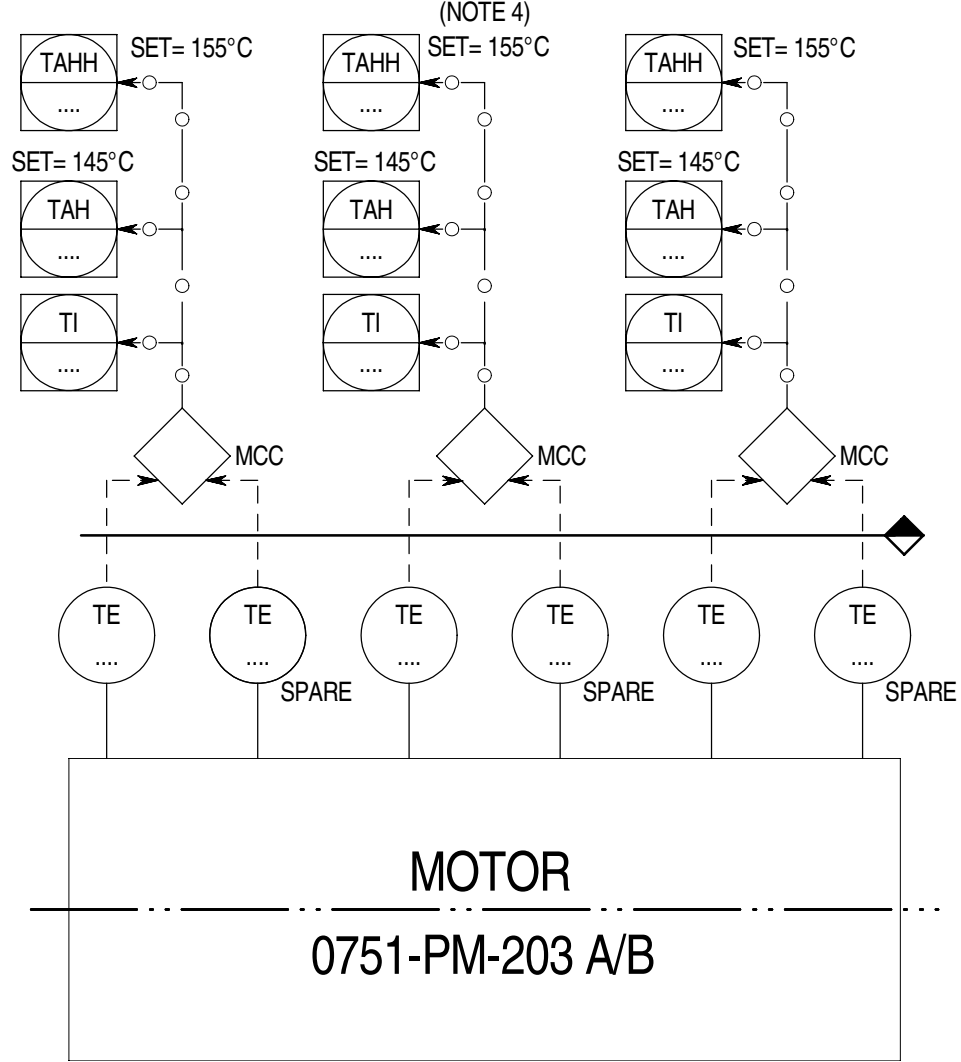

PLAN 11/53B FOR BB PUMPS

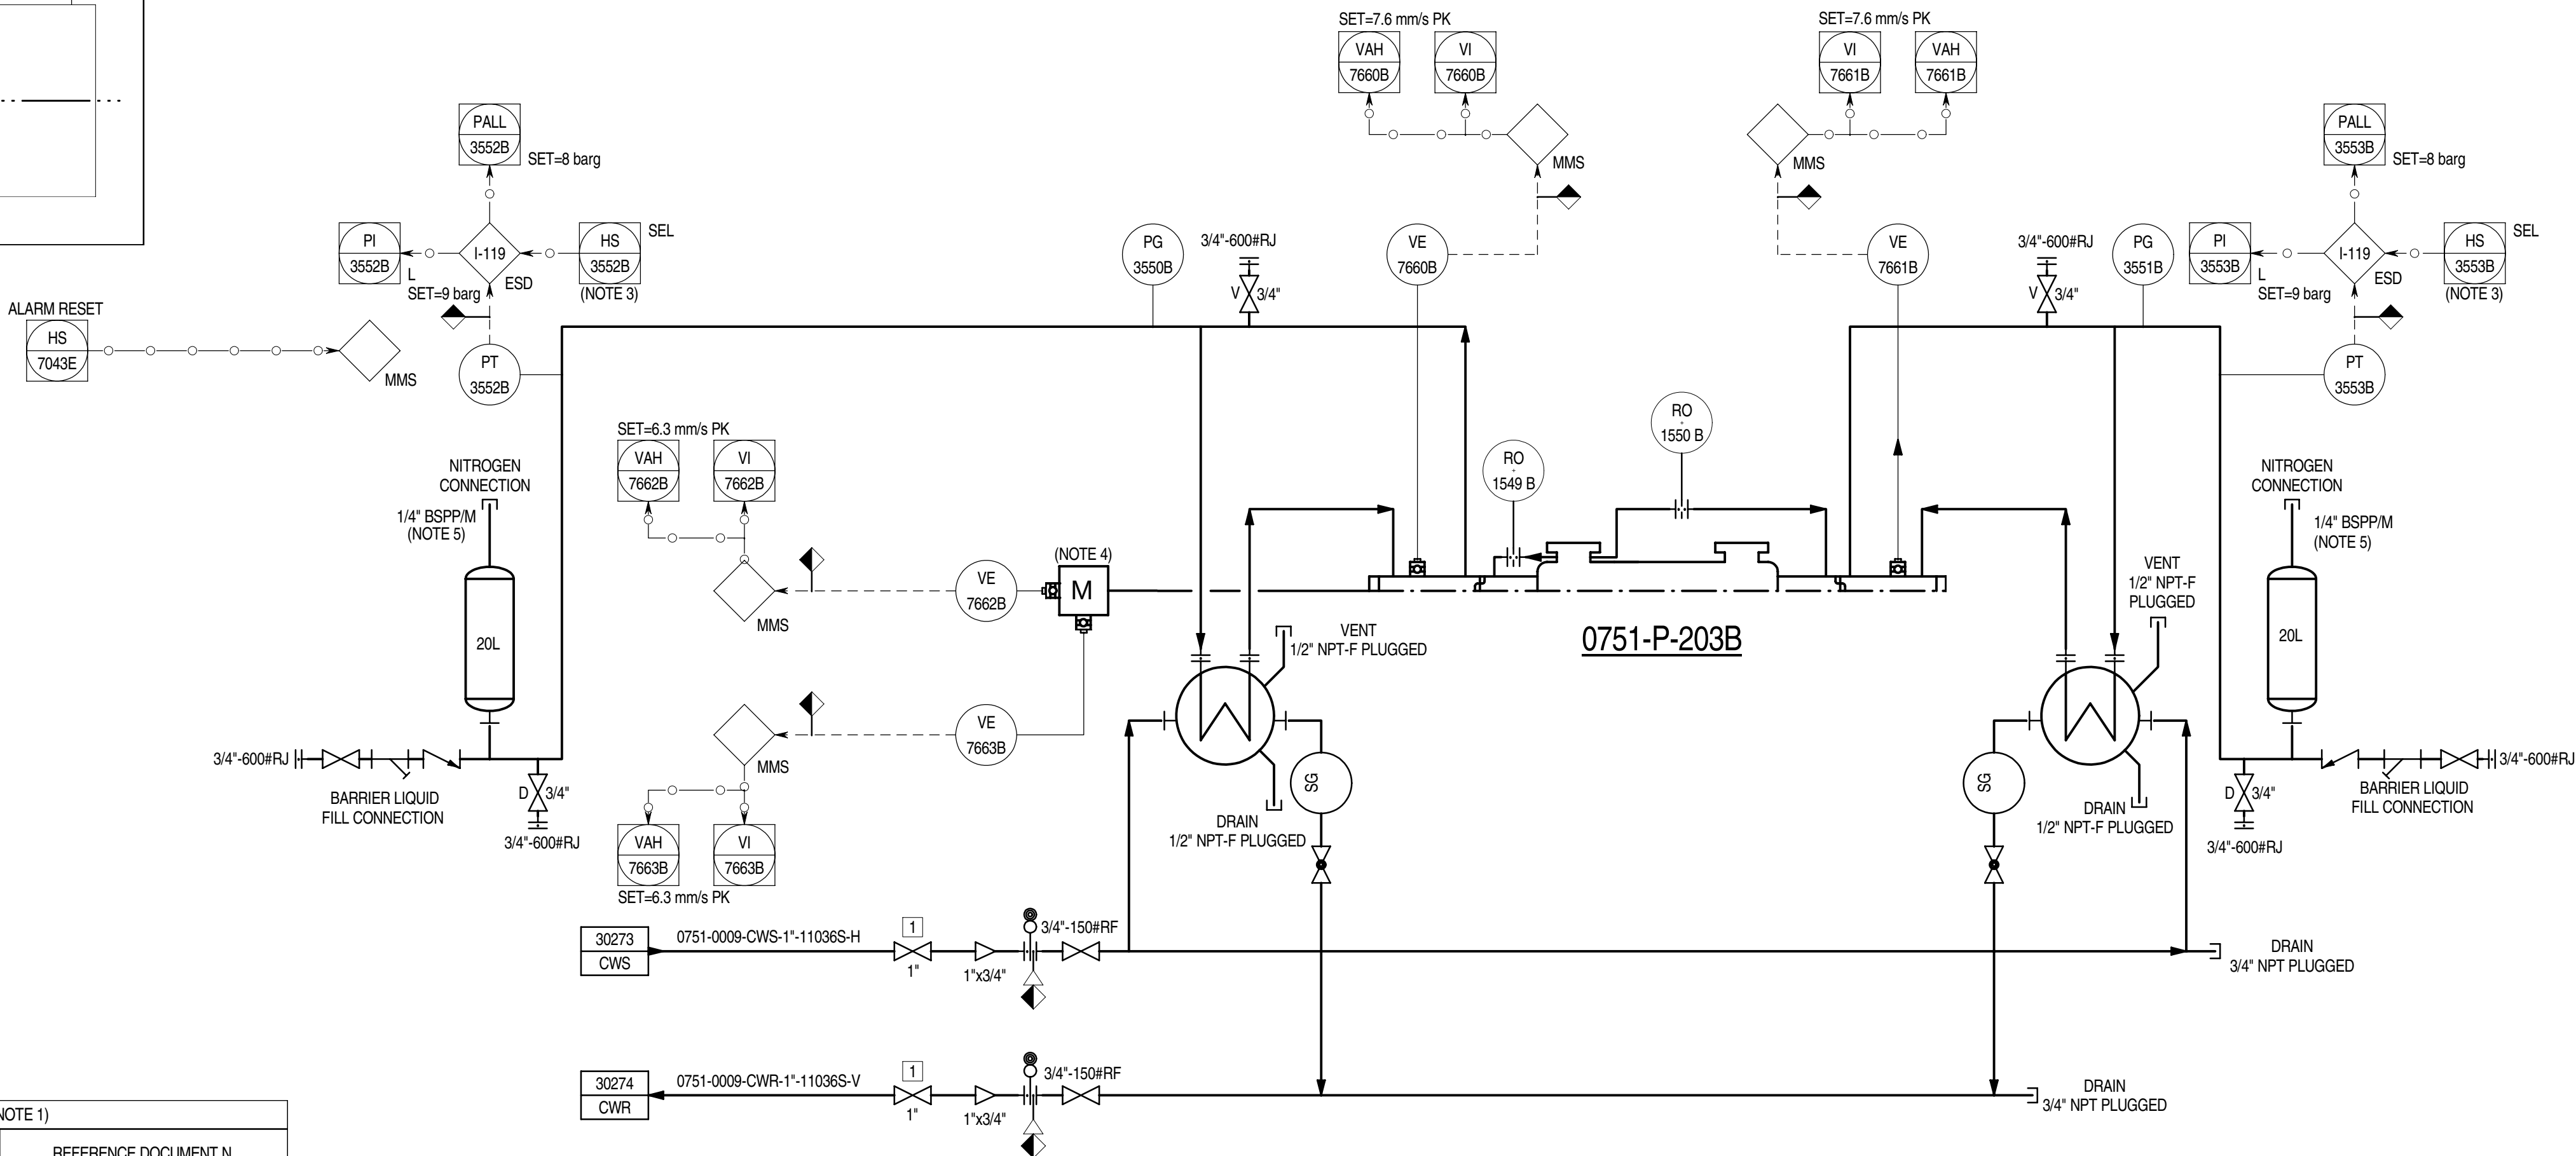

INTERLOCK TABLE (NOTE 1)

INTERLOCK NUMBER	LOGIC DESCRIPTION (NOTE 2)	REFERENCE DOCUMENT N.
I-119	TGTU ABSORBER	SR03-0751-00-303375

GENERAL NOTES:

- FOR STANDARD SYMBOLS, DETAILS, ABBREVIATIONS, SAMPLE CONNECTION TYPE, GENERAL NOTES & LEGEND SHEETS REFER TO DRAWING NO. MP02-0230-00-004000 TO 004015.
- ALL INSTRUMENT TAG NUMBERS ON THIS P&ID INCLUDING PACKAGE UNITS ARE PREFIXED WITH UNIT NUMBER 0751 UNLESS OTHERWISE NOTED.
- DELETED.

NOTES:

- INTERLOCK TABLE IS FOR REFERENCE ONLY. CAUSE AND EFFECT CHART SR03-0751-00-CCC-303155 SHALL GOVERN.
- REFER TO CAUSE AND EFFECT CHART FOR FULL REPRESENTATION OF INTERLOCK INITIATORS AND ACTIONS.
- SELECTOR TO ACTIVATE EITHER ALARM ONLY OR ALARM AND TRIP.
- FOR DETAIL OF TEMPERATURE MEASUREMENT ON ELECTRICAL MOTOR REFER TO DETAIL "A" AND TABLE 1.
- BSPP/M= BRITISH STANDARD PARALLEL PIPE/ MALE.

UTILITY REFERENCE TABLE	
CWR/CWS	DRW. N°. SR03-0751-00-PID-362308

Z1	04-11-14	IAB	ISSUED FOR AS BUILT	PCA	MAR	ASP
2.1D	18-04-14	IFC	ISSUED FOR CONSTRUCTION	PCA	MAR	ASP
2.1C	01-05-13	IFC	ISSUED FOR CONSTRUCTION	RL	CN	MZ
2.1B	06-08-12	IFC	ISSUED FOR CONSTRUCTION	DSC	CBR	SIN
2	29-12-11	IFC	ISSUED FOR CONSTRUCTION	DSC	CBR	SIN
1	12-08-11	IFCH	ISSUED FOR CONSTRUCTION WITH HOLDS	DSC	CBR	SIN
REV	DATE	STATUS	STATUS DESCRIPTION	BY	CKD	APP.

COMPANY: Abu Dhabi Gas Development Co. Ltd.



CONTRACTOR: 

JOB No. 032090

PROJECT: SHAH GAS DEVELOPMENT (SGD) PROJECT


AGREEMENT No. 13525001

DRAWING TITLE: PIPING & INSTRUMENT DIAGRAM UNIT 0751 SULPHUR RECOVERY AND TAIL GAS TREATING UNIT

EQUIPMENT DESCRIPTION	API PLAN 0751-P-203 A/B AND VIBRATION MONITORING	
TAGITEM No.		

CONTRACTOR DRG. No.	751-GD-B-303345	REV. Z1
COMPANY DRG. No.	SR03-0751-00-303345-002	
SCALE:	SIZE: A1	DOC. CLASS: 1

THIS DOCUMENT IS THE PROPERTY OF ABU DHABI GAS DEVELOPMENT COMPANY LIMITED AND CONTAINS INFORMATION WHICH IS PROPRIETARY. THIS INFORMATION IS TO BE HELD IN CONFIDENCE. NO DISCLOSURE OR OTHER USE OF THIS DOCUMENT IS TO BE MADE WITHOUT THE PRIOR WRITTEN CONSENT OF ABU DHABI GAS DEVELOPMENT COMPANY LIMITED.

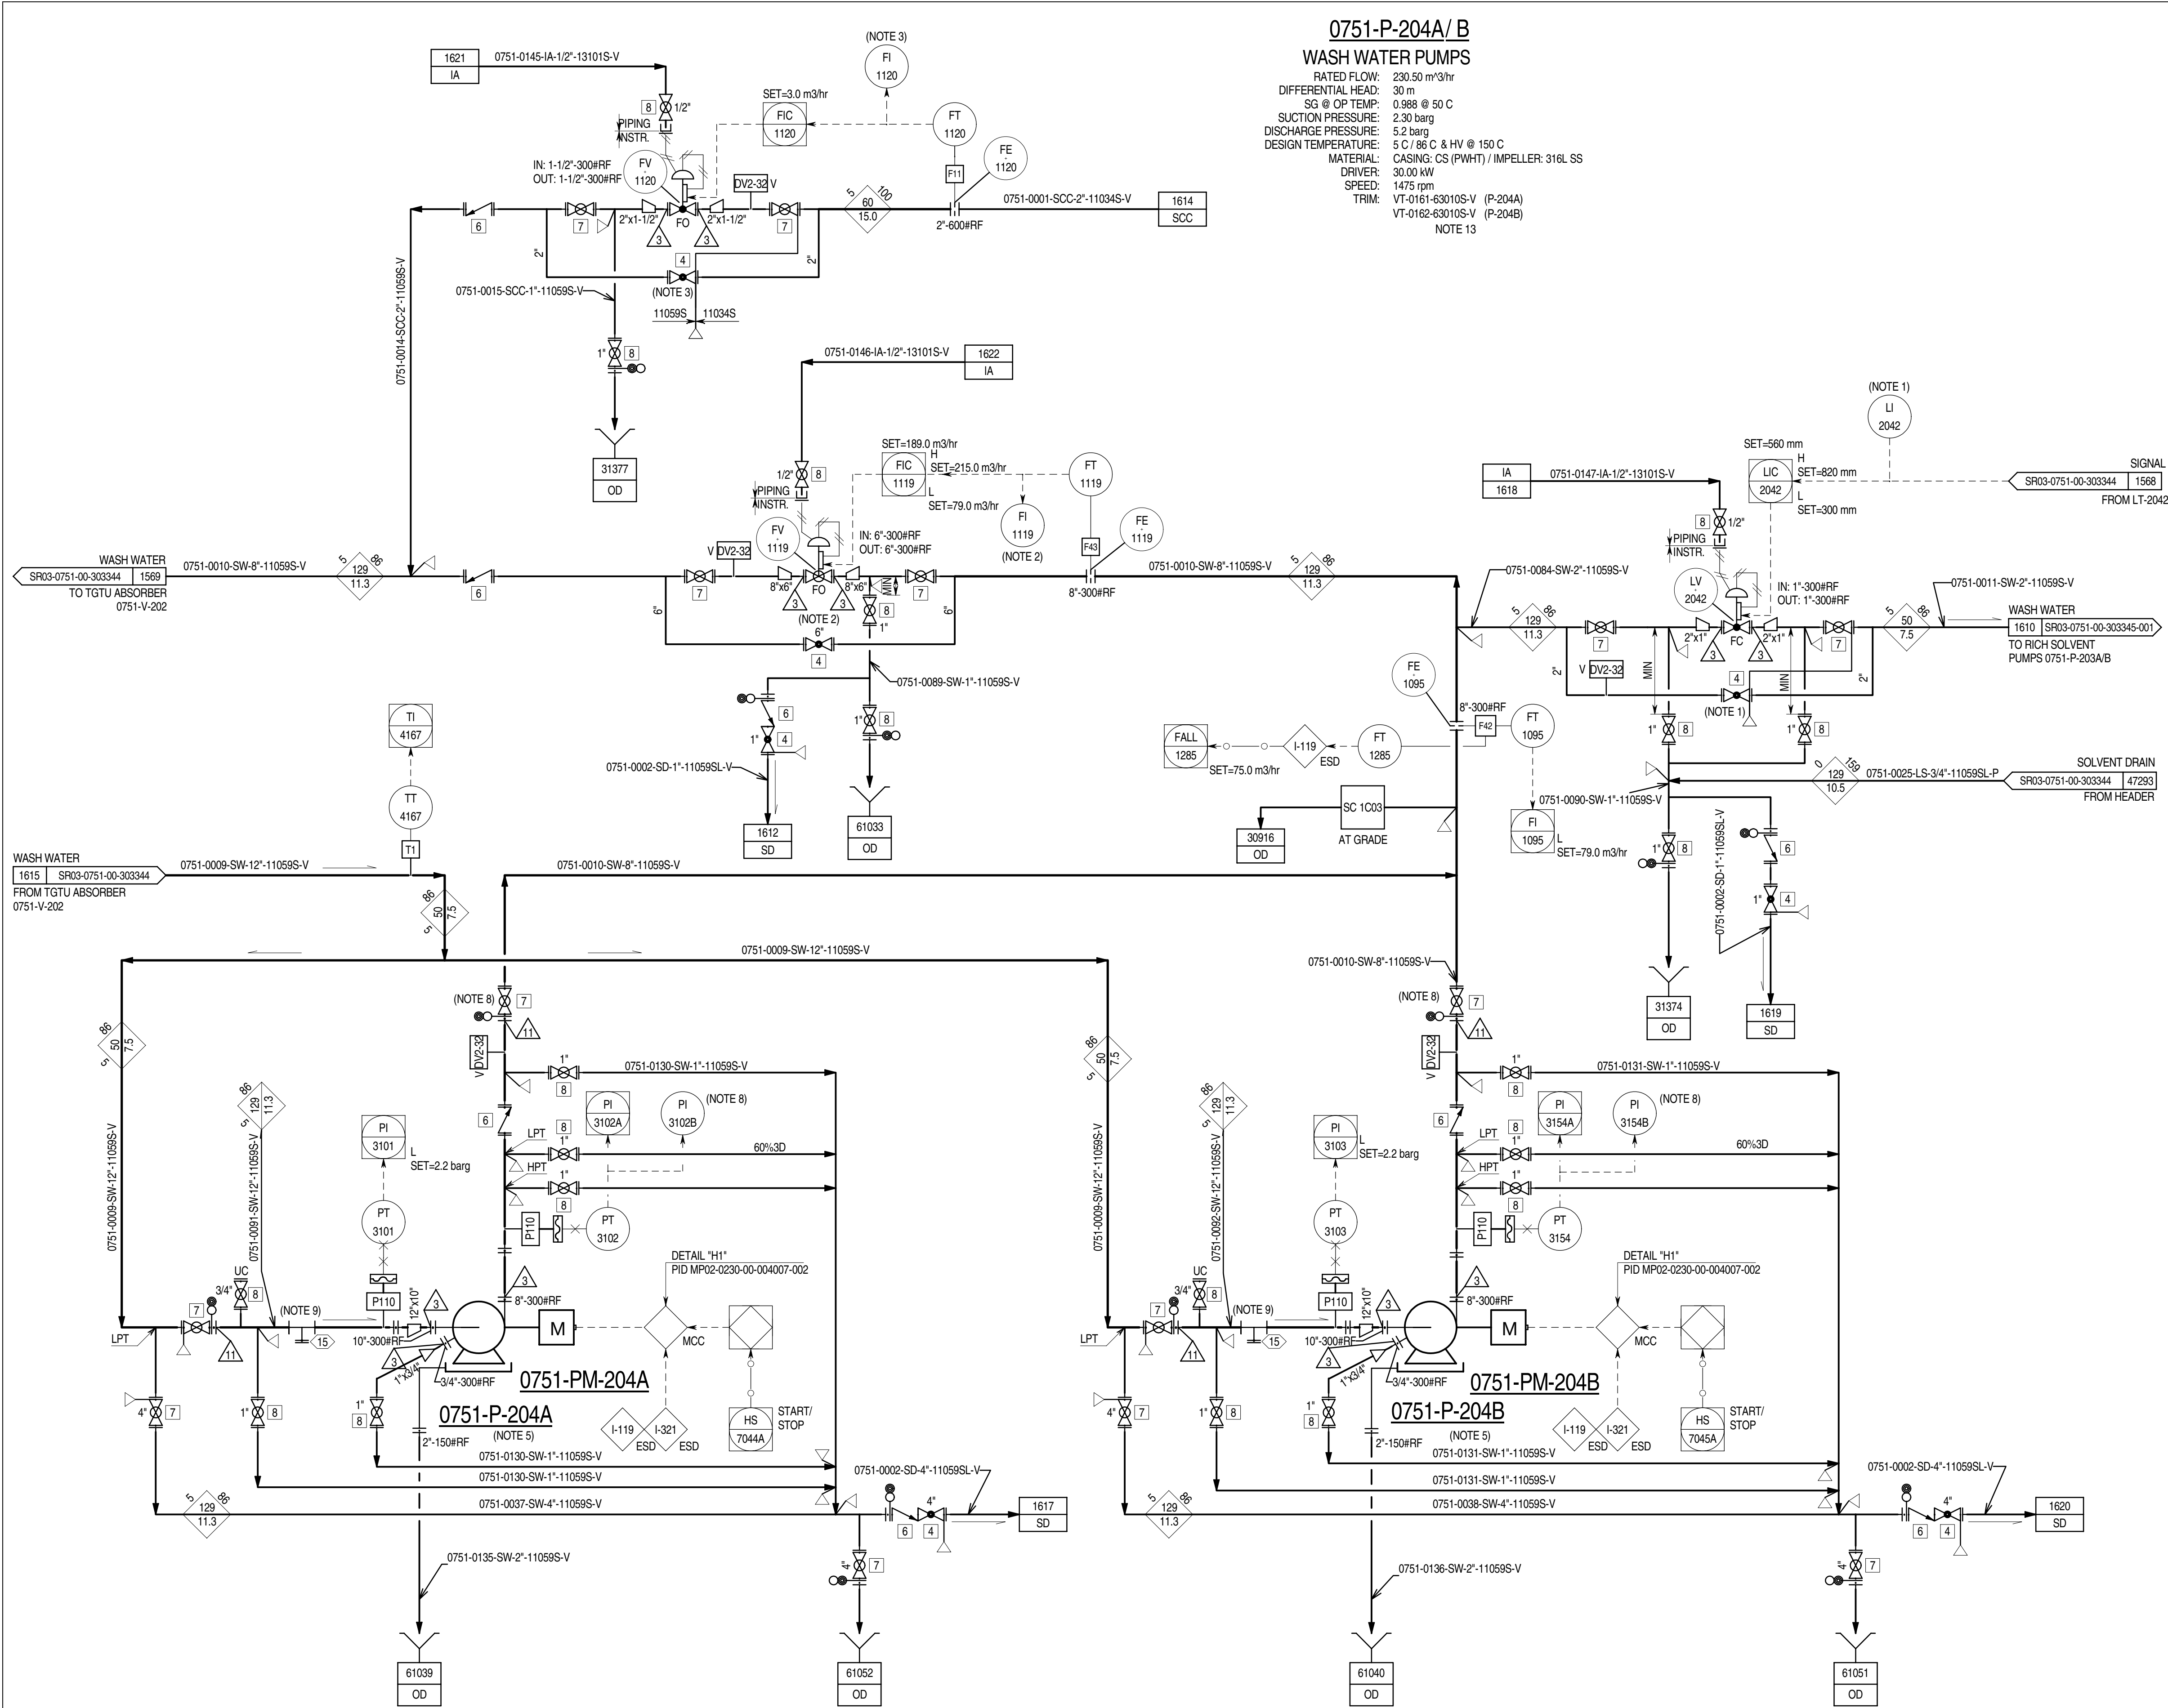

- GENERAL NOTES:**
- FOR STANDARD SYMBOLS, DETAILS, ABBREVIATIONS, SAMPLE CONNECTION TYPE, GENERAL NOTES & LEGEND SHEETS REFER TO DRAWING NO. MP02-0230-00-004000 TO 004015.
 - ALL INSTRUMENT TAG NUMBERS ON THIS P&ID INCLUDING PACKAGE UNITS ARE PREFIXED WITH UNIT NUMBERS 0751 UNLESS OTHERWISE NOTED.
 - DELETED.
- NOTES:**
- LI-2042 TO BE READABLE FROM LV-2042 BYPASS VALVE.
 - FI-1119 TO BE READABLE FROM FV-1119 BYPASS VALVE.
 - FI-1120 TO BE READABLE FROM FV-1120 BYPASS VALVE.
 - INTERLOCK TABLE IS FOR REFERENCE ONLY CAUSE AND EFFECT MATRIX SR03-0751-00-CCC-303155 SHALL GOVERN.
 - PUMPS ARE 2x100%: ONE PUMP RUNNING, ONE STAND-BY.
 - DELETED.
 - DELETED. (TDR)
 - PI-3102B AND PI-3154B TO BE READABLE FROM CORRESPONDING DISCHARGE ISOLATION VALVES.
 - PERMANENT & TEMPORARY STRAINER WITH SCREEN 48 MESH.
 - DELETED. (HAZ N. 388/UNIT 0751)
 - DELETED.
 - REFER TO CAUSE AND EFFECT CHART FOR FULL REPRESENTATION OF INTERLOCK INITIATORS AND ACTIONS.
 - TRIM LINE USED FOR 0751-P-204A/B SEAL PLAN (ON DWG N. SR03-0751-00-303346-002).

UTILITY REFERENCE TABLE	
IA	DRW. N°. SR03-0751-00-PID-362305
OD	DRW. N°. SR03-0751-00-PID-362307
SCC	DRW. N°. SR03-0751-00-PID-362308
SD	DRW. N°. SR03-0751-00-PID-362311

Z1	04-11-14	IAB	ISSUED FOR AS BUILT	PCA	MAR	ASP
2.1D	18-04-14	IFC	ISSUED FOR CONSTRUCTION	PCA	MAR	ASP
2.1C	09-03-13	IFC	ISSUED FOR CONSTRUCTION	RL	CN	MZ
2.1B	06-08-12	IFC	ISSUED FOR CONSTRUCTION	DSC	CBR	SIN
2	29-12-11	IFC	ISSUED FOR CONSTRUCTION	DSC	CBR	SIN
1	12-08-11	IFCH	ISSUED FOR CONSTRUCTION WITH HOLDS	DSC	CBR	SIN
0	01-03-11	IFD	ISSUED CLIENT COMMENTS INCORPORATED	BSC	LMA	SIN
B1	30-09-10	ICR	ISSUED FOR CLIENT REVIEW	BSC	LMA	SIN
REV	DATE	STATUS	STATUS DESCRIPTION	BY	CKD	APP.

COMPANY:

Abu Dhabi Gas Development Co. Ltd.

CONTRACTOR:

eni **saipem**

JOB No. 032090

PROJECT: SHAH GAS DEVELOPMENT (SGD) PROJECT

AGREEMENT No. 13525001

DRAWING TITLE: PIPING & INSTRUMENT DIAGRAM UNIT 0751
SULPHUR RECOVERY AND TAIL GAS TREATING UNIT


EQUIPMENT DESCRIPTION	WASH WATER PUMPS
TAGITEM No.	0751-P-204A / B

CONTRACTOR DRG. No.	751-GD-B-303346	REV. Z1
COMPANY DRG. No.	SR03-0751-00-303346-001	
SCALE:	SIZE: A1	DOC. CLASS: 1


INTERLOCK TABLE (NOTE 4, 12)		
INTERLOCK NUMBER	LOGIC DESCRIPTION	REFERENCE DOCUMENT N.
I-321	SULPHUR RECOVERY UNIT	SR03-0751-00-303375
I-119	TGTU ABSORBER	SR03-0751-00-303375

THIS DOCUMENT IS THE PROPERTY OF ABU DHABI GAS DEVELOPMENT COMPANY LIMITED AND CONTAINS INFORMATION WHICH IS PROPRIETARY. THIS INFORMATION IS TO BE HELD IN CONFIDENCE. NO DISCLOSURE OR OTHER USE OF THIS DOCUMENT IS TO BE MADE WITHOUT THE PRIOR WRITTEN CONSENT OF ABU DHABI GAS DEVELOPMENT COMPANY LIMITED.

PLAN 11/65 FOR OH PUMPS

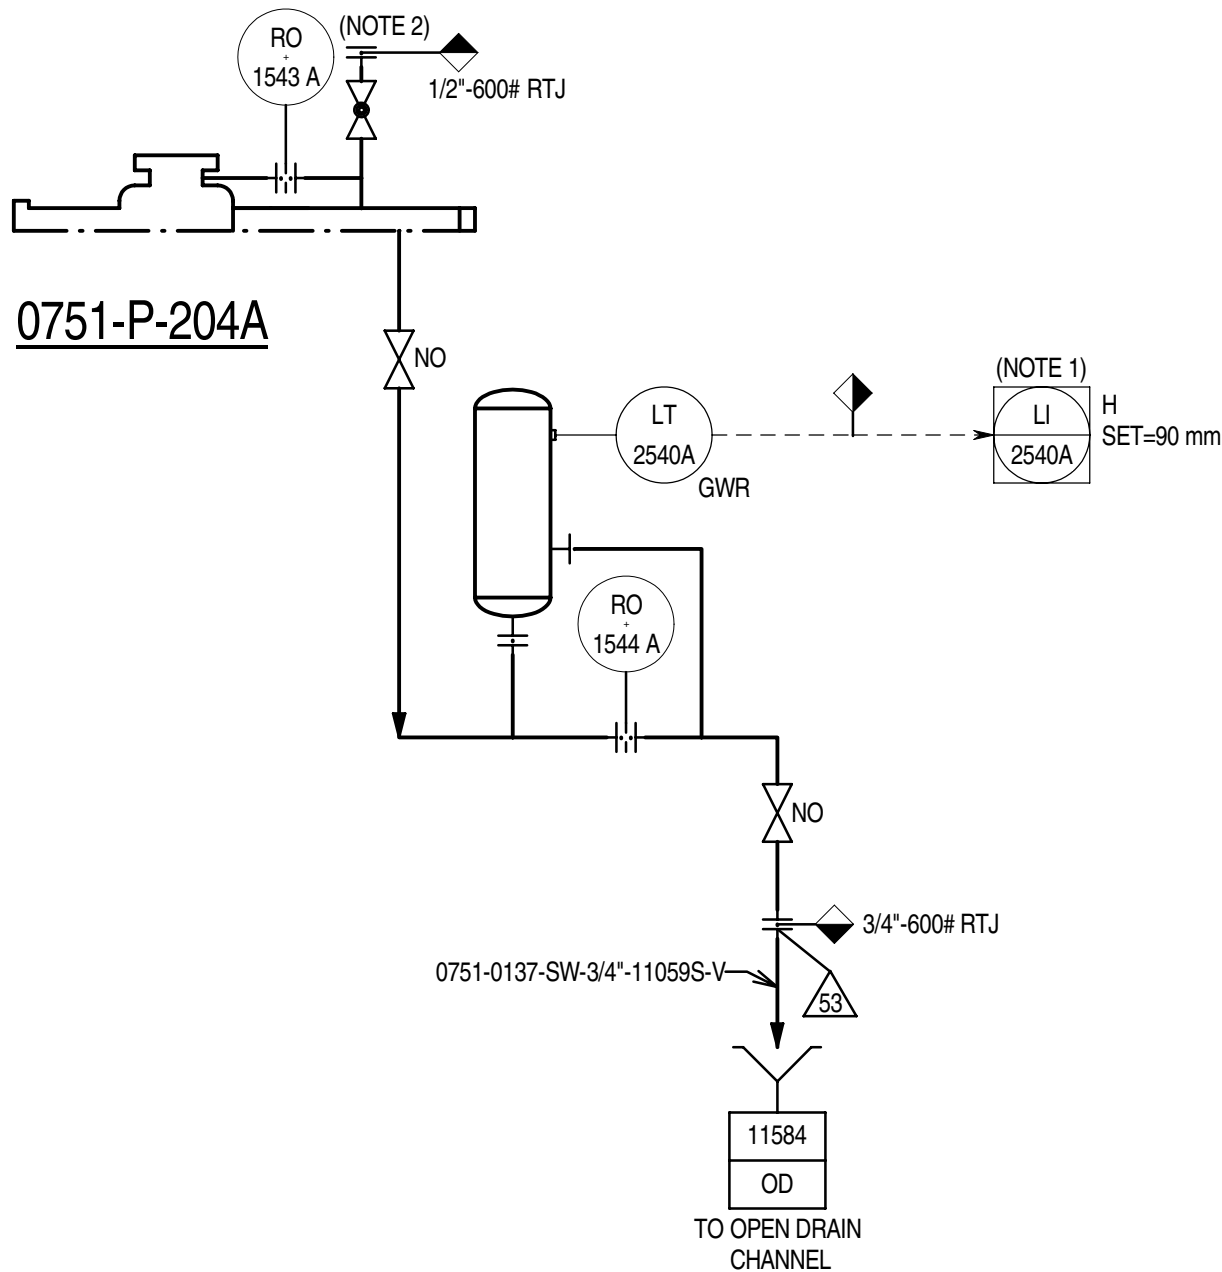

PLAN 11/65 FOR OH PUMPS

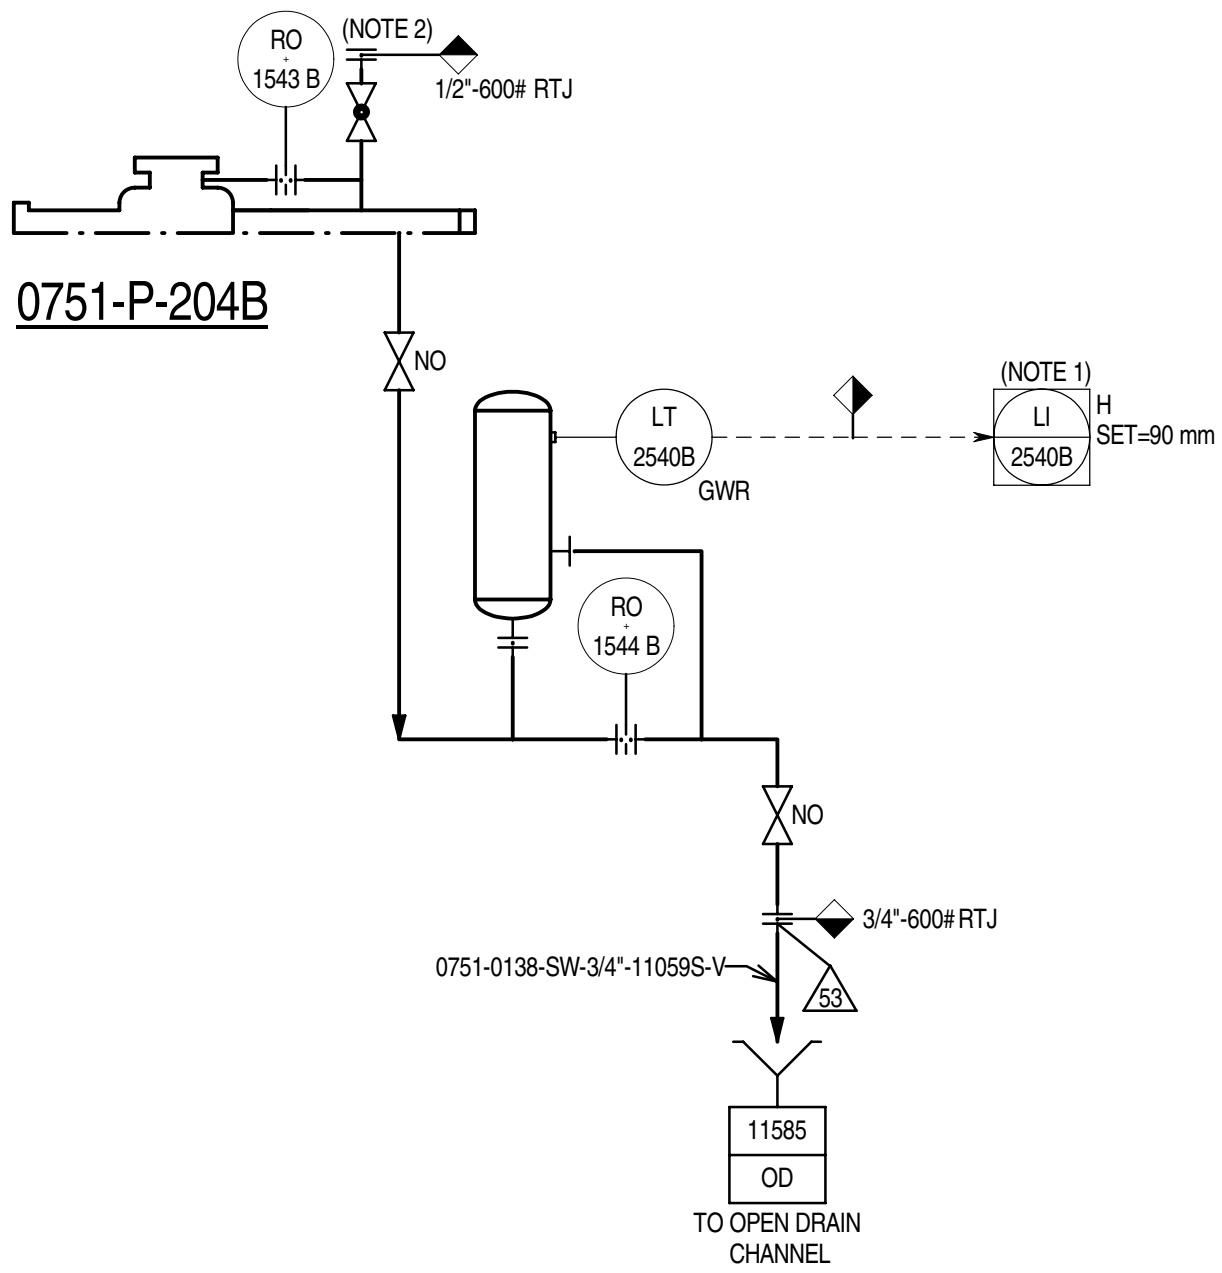

- GENERAL NOTES:**
- FOR STANDARD SYMBOLS, DETAILS, ABBREVIATIONS, SAMPLE CONNECTION TYPE, GENERAL NOTES & LEGEND SHEETS REFER TO DRAWING NO. MP02-0230-00-004000 TO 004015.
 - ALL INSTRUMENT TAG NUMBERS ON THIS P&ID INCLUDING PACKAGE UNITS ARE PREFIXED WITH UNIT NUMBER 0751 UNLESS OTHERWISE NOTED.
 - DELETED.
- NOTES:**
- SET VALUE BY PUMP VENDOR.
 - FOR BLIND FLANGE SPEC REFER TO 0751-P-204A/B TRIM LINE (ON DWG No. SR03-0751-00-303346-001)

UTILITY REFERENCE TABLE		
OD	DRW. N°.	SR03-0751-00-PID-362307

Z1	04-11-14	IAB	ISSUED FOR AS BUILT	PCA	MAR	ASP
2.1D	18-04-14	IFC	ISSUED FOR CONSTRUCTION	PCA	MAR	ASP
2.1C	01-05-13	IFC	ISSUED FOR CONSTRUCTION	RL	CN	MZ
2.1B	06-08-12	IFC	ISSUED FOR CONSTRUCTION	DSC	CBR	SIN
2	29-12-11	IFC	ISSUED FOR CONSTRUCTION	DSC	CBR	SIN
1	12-08-11	IFCH	ISSUED FOR CONSTRUCTION WITH HOLDS	DSC	CBR	SIN
REV	DATE	STATUS	STATUS DESCRIPTION	BY	CKD	APP.

COMPANY: Abu Dhabi Gas Development Co. Ltd.



CONTRACTOR:



JOB No. 032090

PROJECT:

SHAH GAS DEVELOPMENT (SGD) PROJECT


AGREEMENT No. 13525001

DRAWING TITLE: PIPING & INSTRUMENT DIAGRAM UNIT 0751
SULPHUR RECOVERY AND TAIL GAS TREATING UNIT

EQUIPMENT DESCRIPTION	API PLAN 0751-P-204A/B				
TAG/ITEM No.					

CONTRACTOR DRG.No.		751-GD-B-303346		REV. Z1
COMPANY DRG.No.		SR03-0751-00-303346-002		
SCALE:	SIZE: A1	DOC. CLASS: 1		

THIS DOCUMENT IS THE PROPERTY OF ABU DHABI GAS DEVELOPMENT COMPANY LIMITED. NO DISCLOSURE OR OTHER USE OF THIS DOCUMENT IS TO BE MADE WITHOUT THE PRIOR WRITTEN CONSENT OF ABU DHABI GAS DEVELOPMENT COMPANY LIMITED.

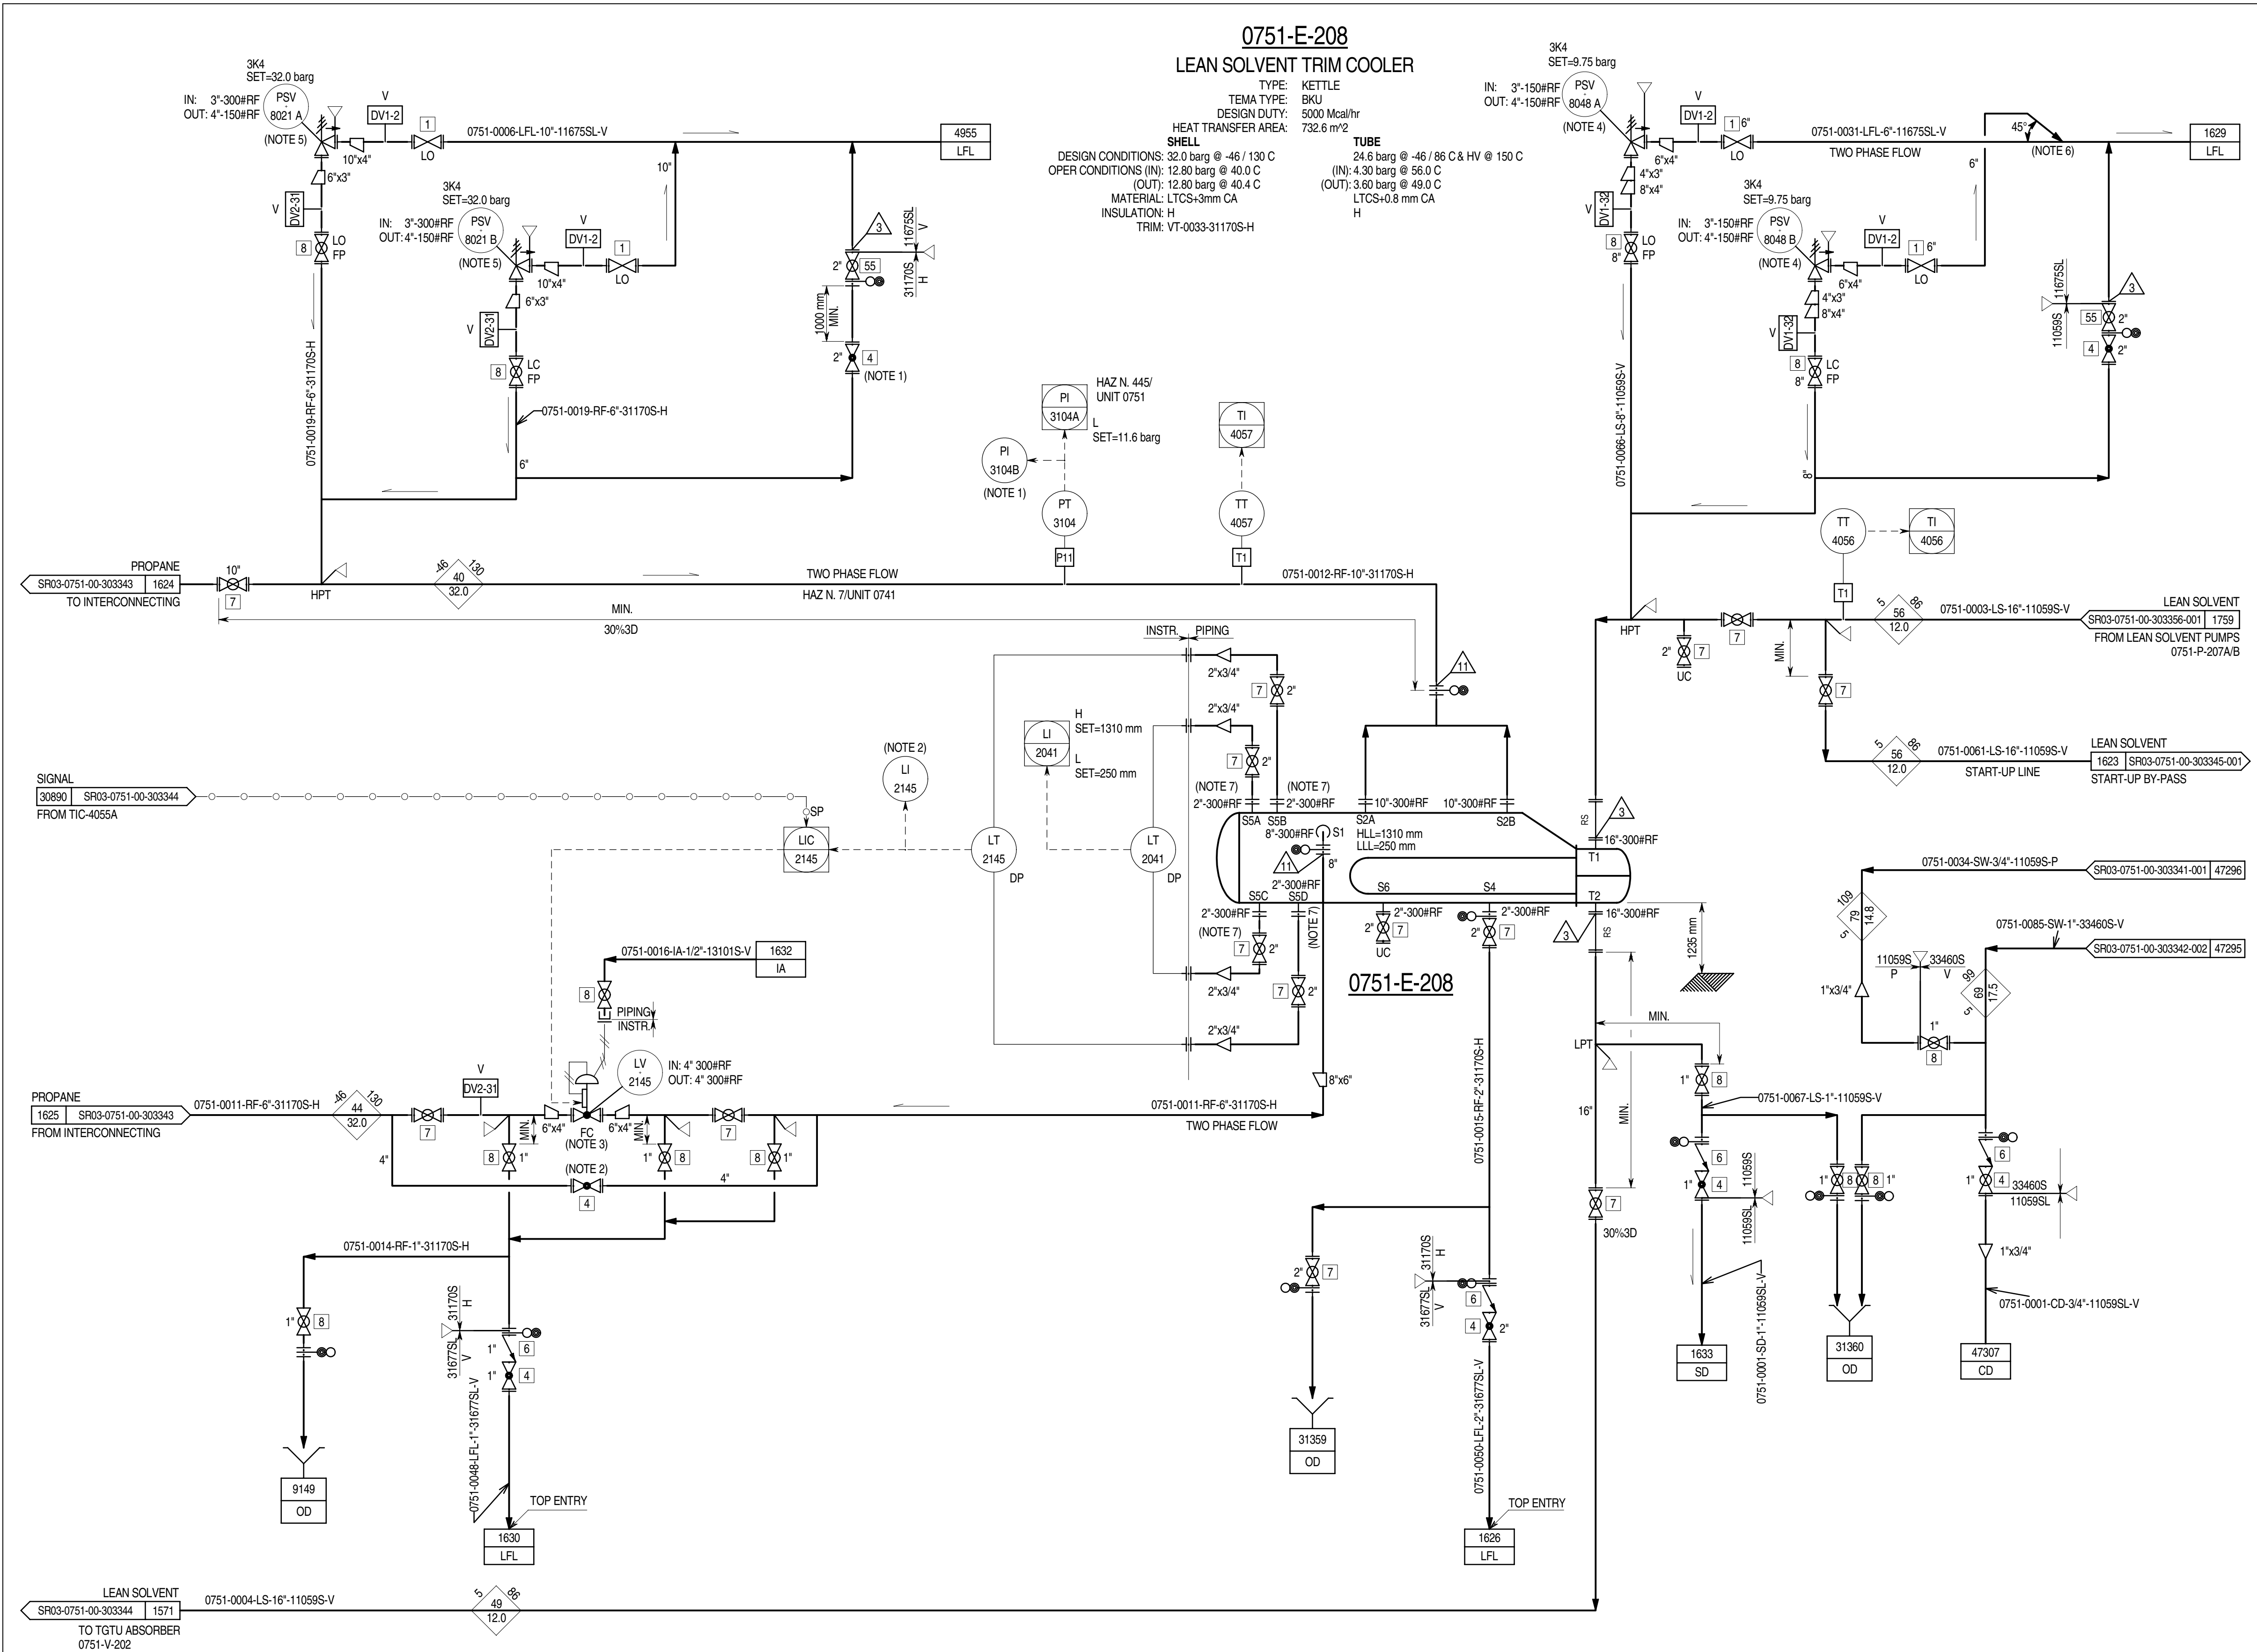

- GENERAL NOTES:**
- FOR STANDARD SYMBOLS, DETAILS, ABBREVIATIONS, SAMPLE CONNECTION TYPE, GENERAL NOTES & LEGEND SHEETS REFER TO DRAWING NO. MP02-0230-00-004000 TO 004015.
 - ALL INSTRUMENT TAG NUMBERS ON THIS P&ID INCLUDING PACKAGE UNITS ARE PREFIXED WITH UNIT NUMBER 0751 UNLESS OTHERWISE NOTED.
 - DELETED.
- NOTES:**
- PI-3104B TO BE READABLE FROM PSV-8021A/B MANUAL VENT.
 - LI-2145 TO BE READABLE FROM LV-2145 BYPASS VALVE.
 - LOCATE LV-2145 AT MIN. DISTANCE FROM INLET NOZZLE OF 0751-E-208.
 - PSV-8048 SIZING CASE: FIBRE RUPTURE.
 - PSV-8021 SIZING CASE: FIRE.
 - USE 45° TOP ENTRY CONNECTION.
 - NOZZLES SSA/B/C/D ARE IN SIDE-SIDE POSITION.

UTILITY REFERENCE TABLE		
IA	DRW. N°.	SR03-0751-00-PID-362305
OD	DRW. N°.	SR03-0751-00-PID-362307
SD	DRW. N°.	SR03-0751-00-PID-362311
LFL	DRW. N°.	SR03-0751-00-PID-362313

Z1	04-11-14	IAB	ISSUED FOR AS BUILT	PCA	MAR	ASP
2.1D	18-04-14	IFC	ISSUED FOR CONSTRUCTION	PCA	MAR	ASP
2.1C	09-03-13	IFC	ISSUED FOR CONSTRUCTION	RL	CN	MZ
2.1B	06-08-12	IFC	ISSUED FOR CONSTRUCTION	DSC	CBR	SIN
2	29-12-11	IFC	ISSUED FOR CONSTRUCTION	DSC	CBR	SIN
1	12-08-11	IFCH	ISSUED FOR CONSTRUCTION WITH HOLDS	DSC	CBR	SIN
0	01-03-11	IFD	ISSUED CLIENT COMMENTS INCORPORATED	BSC	LMA	SIN
B1	30-09-10	ICR	ISSUED FOR CLIENT REVIEW	BSC	LMA	SIN
REV	DATE	STATUS	STATUS DESCRIPTION	BY	CKD	APP.

COMPANY:

Abu Dhabi Gas Development Co. Ltd.

CONTRACTOR:

JOB No. 032090

PROJECT: SHAH GAS DEVELOPMENT (SGD) PROJECT

AGREEMENT No. 13525001

DRAWING TITLE: PIPING & INSTRUMENT DIAGRAM UNIT 0751
SULPHUR RECOVERY AND TAIL GAS TREATING UNIT

EQUIPMENT DESCRIPTION	LEAN SOLVENT TRIM COOLER
TAGITEM No.	0751-E-208

CONTRACTOR DRG. No.	751-GD-B-303347	REV. Z1
COMPANY DRG. No.	SR03-0751-00-303347	
SCALE:	SIZE: A1	DOC. CLASS: 1



	:
	:
A	:
B	:
C	:
D	:
E	:
F	:
G	:
H	:
I	:
J	:
K	:
L	:
M	:
N	:
O	:
P	:
Q	:
R	:
S	:
T	:
U	:
V	:
W	:
X	:
Y	:
Z	:

Z1	04-11-14	IAB	ISSUED FOR AS BUILT	PCA	MAR	ASP
2.1B	06-08-12	IFC	ISSUED FOR CONSTRUCTION	DSC	CBR	SIN
2	29-12-11	IFC	ISSUED FOR CONSTRUCTION	DSC	CBR	SIN
1	12-08-11	IFCH	ISSUED FOR CONSTRUCTION WITH HOLDS	DSC	CBR	SIN
0	01-03-11	IFD	ISSUED CLIENT COMMENTS INCORPORATED	BSC	LMA	SIN
B1	30-09-10	ICR	ISSUED FOR CLIENT REVIEW	BSC	LMA	SIN
REV	DATE	STATUS	STATUS DESCRIPTION	BY	CKD	APP.

CONTRACTOR:  **saipem**

JOB No. 032090

<u>DRAWING TITLE:</u> PIPING & INSTRUMENT DIAGRAM UNIT 0751 SULPHUR RECOVERY AND TAIL GAS TREATING UNIT	
EQUIPMENT DESCRIPTION	LEAN/RICH EXCHANGER
TAG/ITEM No.	0751-E-204A / B


CONTRACTOR DRG No.		751-GD-B-303348	REV. Z1
COMPANY DRG.No.		SR03-0751-00-303348	
SCALE:	SIZE: A1	DOC. CLASS: 1	

THIS DOCUMENT IS THE PROPERTY OF ABU DHABI GAS DEVELOPMENT COMPANY LIMITED AND CONTAINS INFORMATION WHICH IS PROPRIETARY. THIS INFORMATION IS TO BE HELD IN CONFIDENCE. NO DISCLOSURE OR OTHER USE OF THIS DOCUMENT IS TO BE MADE WITHOUT THE PRIOR WRITTEN CONSENT OF ABU DHABI GAS DEVELOPMENT COMPANY LIMITED.

0751-V-203 REGENERATOR

TYPE: VERTICAL
SIZE: TOP 2900 mm BOTTOM 4880.0 mm
CAPACITY: 648.6 m³/G
DESIGN CONDITIONS: 5.5 barg @ 0/159 C & FV @ 159 C
OPER CONDITIONS TOP: 1.2 barg @ 116 C
OPER CONDITIONS BOTTOM: 1.4 barg @ 129 C
MATERIAL: CS 316L SS CLAD / SS TRAYS
INSULATION: (NOTE 6)
TRIM: VT-0035-13460SL-P (TOP SECTION)

TRIM: VT-0075-33460SL-H
LETHAL SERVICE

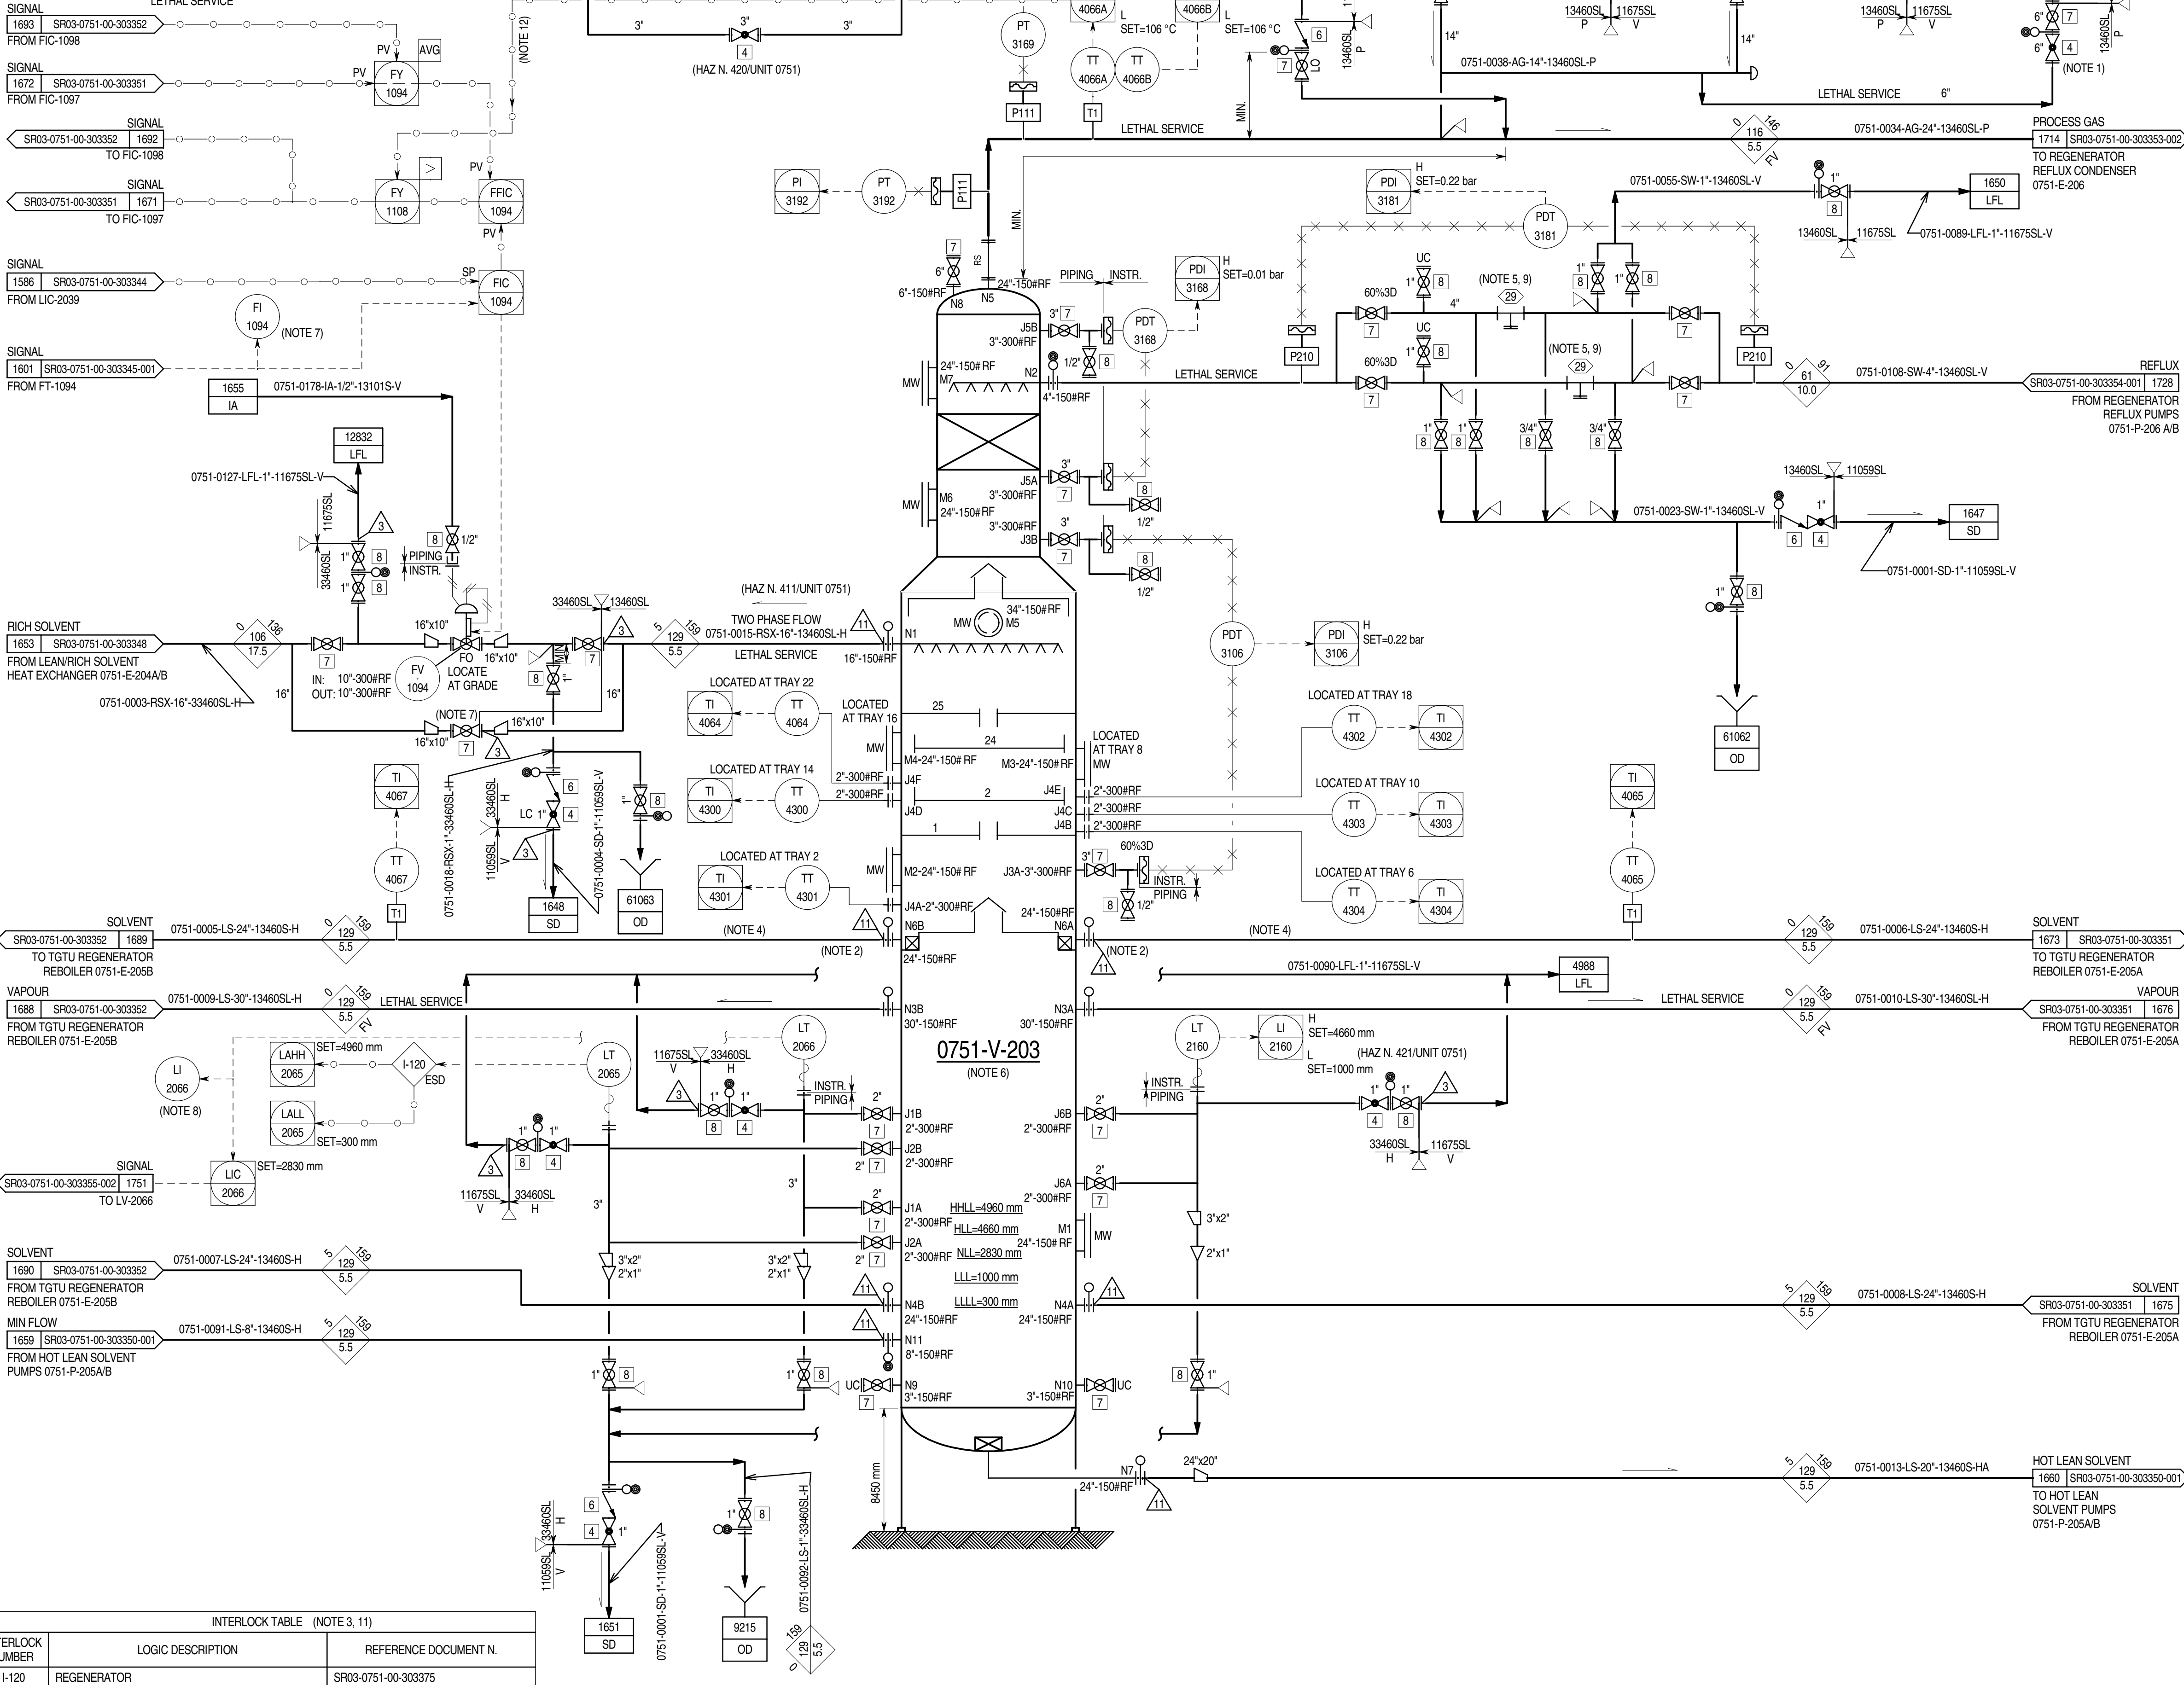

GENERAL NOTES:

- FOR STANDARD SYMBOLS, DETAILS, ABBREVIATIONS, SAMPLE CONNECTION TYPE, GENERAL NOTES & LEGEND SHEETS REFER TO DRAWING NO. MP02-0230-00-004000 TO 004015.
 - ALL INSTRUMENT TAG NUMBERS ON THIS P&ID INCLUDING PACKAGE UNITS ARE PREFIXED WITH UNIT NUMBER 0751 UNLESS OTHERWISE NOTED.
 - DELETED.
- NOTES:**
- PI-3169 TO BE READABLE FROM PSV-8025A/B MANUAL VENT.
 - REBOILER DRAFFOFF MUST HAVE 3m VERTICAL RUN FROM TOWER NOZZLES BEFORE ANY OTHER PIPING CHANGES.
 - INTERLOCK TABLE IS FOR REFERENCE ONLY. CAUSE AND EFFECT MATRIX SR03-0751-00-CCC-303155 SHALL GOVERN.
 - SYMMETRICAL PIPING.
 - LOCATE AT GRADE AT MINIMUM DISTANCE FROM TOWER.
 - INSULATE THE COLUMN FOR HEAT CONSERVATION EXCEPT FOR TOP 2 METERS WHICH WILL BE INSULATED FOR PERSONNEL PROTECTION.
 - FI-1094 TO BE READABLE FROM FV-1094 BYPASS VALVE.
 - LI-2066 TO BE READABLE FROM LV-2066 BYPASS VALVE ON DWG. SR03-0751-00-303355-002.
 - STRAINER MAXIMUM MESH SIZE IS 16.
 - PSV-8025 SIZING CASE: BLOCKED DISCHARGE.
 - REFER TO CAUSE AND EFFECT MATRIX FOR FULL REPRESENTATION OF INTERLOCK INITIATORS AND ACTIONS.
 - TIC-4066A IS PROVIDED AS TEMPERATURE CONSTRAINT CONTROLLER.

UTILITY REFERENCE TABLE		
IA	DRW. N°.	SR03-0751-00-PID-362305
OD	DRW. N°.	SR03-0751-00-PID-362307
N2	DRW. N°.	SR03-0751-00-PID-362310
SD	DRW. N°.	SR03-0751-00-PID-362311
LFL	DRW. N°.	SR03-0751-00-PID-362313

Z1	04-11-14	IAB	ISSUED FOR AS BUILT	PCA	MAR	ASP
2.1D	18-04-14	IFC	ISSUED FOR CONSTRUCTION	PCA	MAR	ASP
2.1C	28-02-14	IFC	ISSUED FOR CONSTRUCTION	PCA	MAR	ASP
2.1B	06-08-12	IFC	ISSUED FOR CONSTRUCTION	DSC	CBR	SIN
2	29-12-11	IFC	ISSUED FOR CONSTRUCTION	DSC	CBR	SIN
1	12-08-11	IFCH	ISSUED FOR CONSTRUCTION WITH HOLDS	DSC	CBR	SIN
0	01-03-11	IFD	ISSUED CLIENT COMMENTS INCORPORATED	BSC	LMA	SIN
B1	30-09-10	ICR	ISSUED FOR CLIENT REVIEW	BSC	LMA	SIN
REV	DATE	STATUS	STATUS DESCRIPTION	BY	CKD	APP.

COMPANY:

Abu Dhabi Gas Development Co. Ltd.



CONTRACTOR:



saipem

JOB No. 032090

PROJECT:

SHAH GAS DEVELOPMENT (SGD) PROJECT

AGREEMENT No. 13525001

DRAWING TITLE: PIPING & INSTRUMENT DIAGRAM UNIT 0751
SULPHUR RECOVERY AND TAIL GAS TREATING UNIT

EQUIPMENT DESCRIPTION REGENERATOR

TAGITEM No.

0751-V-203

CONTRACTOR DRG. No.

751-GD-B-303349

COMPANY DRG. No.

SR03-0751-00-303349

SCALE:


SIZE: A1

DOC. CLASS: 1

REV.

Z1

THIS DOCUMENT IS THE PROPERTY OF ABU DHABI GAS DEVELOPMENT COMPANY LIMITED AND CONTAINS INFORMATION WHICH IS PROPRIETARY. THIS INFORMATION IS TO BE HELD IN CONFIDENCE. NO DISCLOSURE OR OTHER USE OF THIS DOCUMENT IS TO BE MADE WITHOUT THE PRIOR WRITTEN CONSENT OF ABU DHABI GAS DEVELOPMENT COMPANY LIMITED.

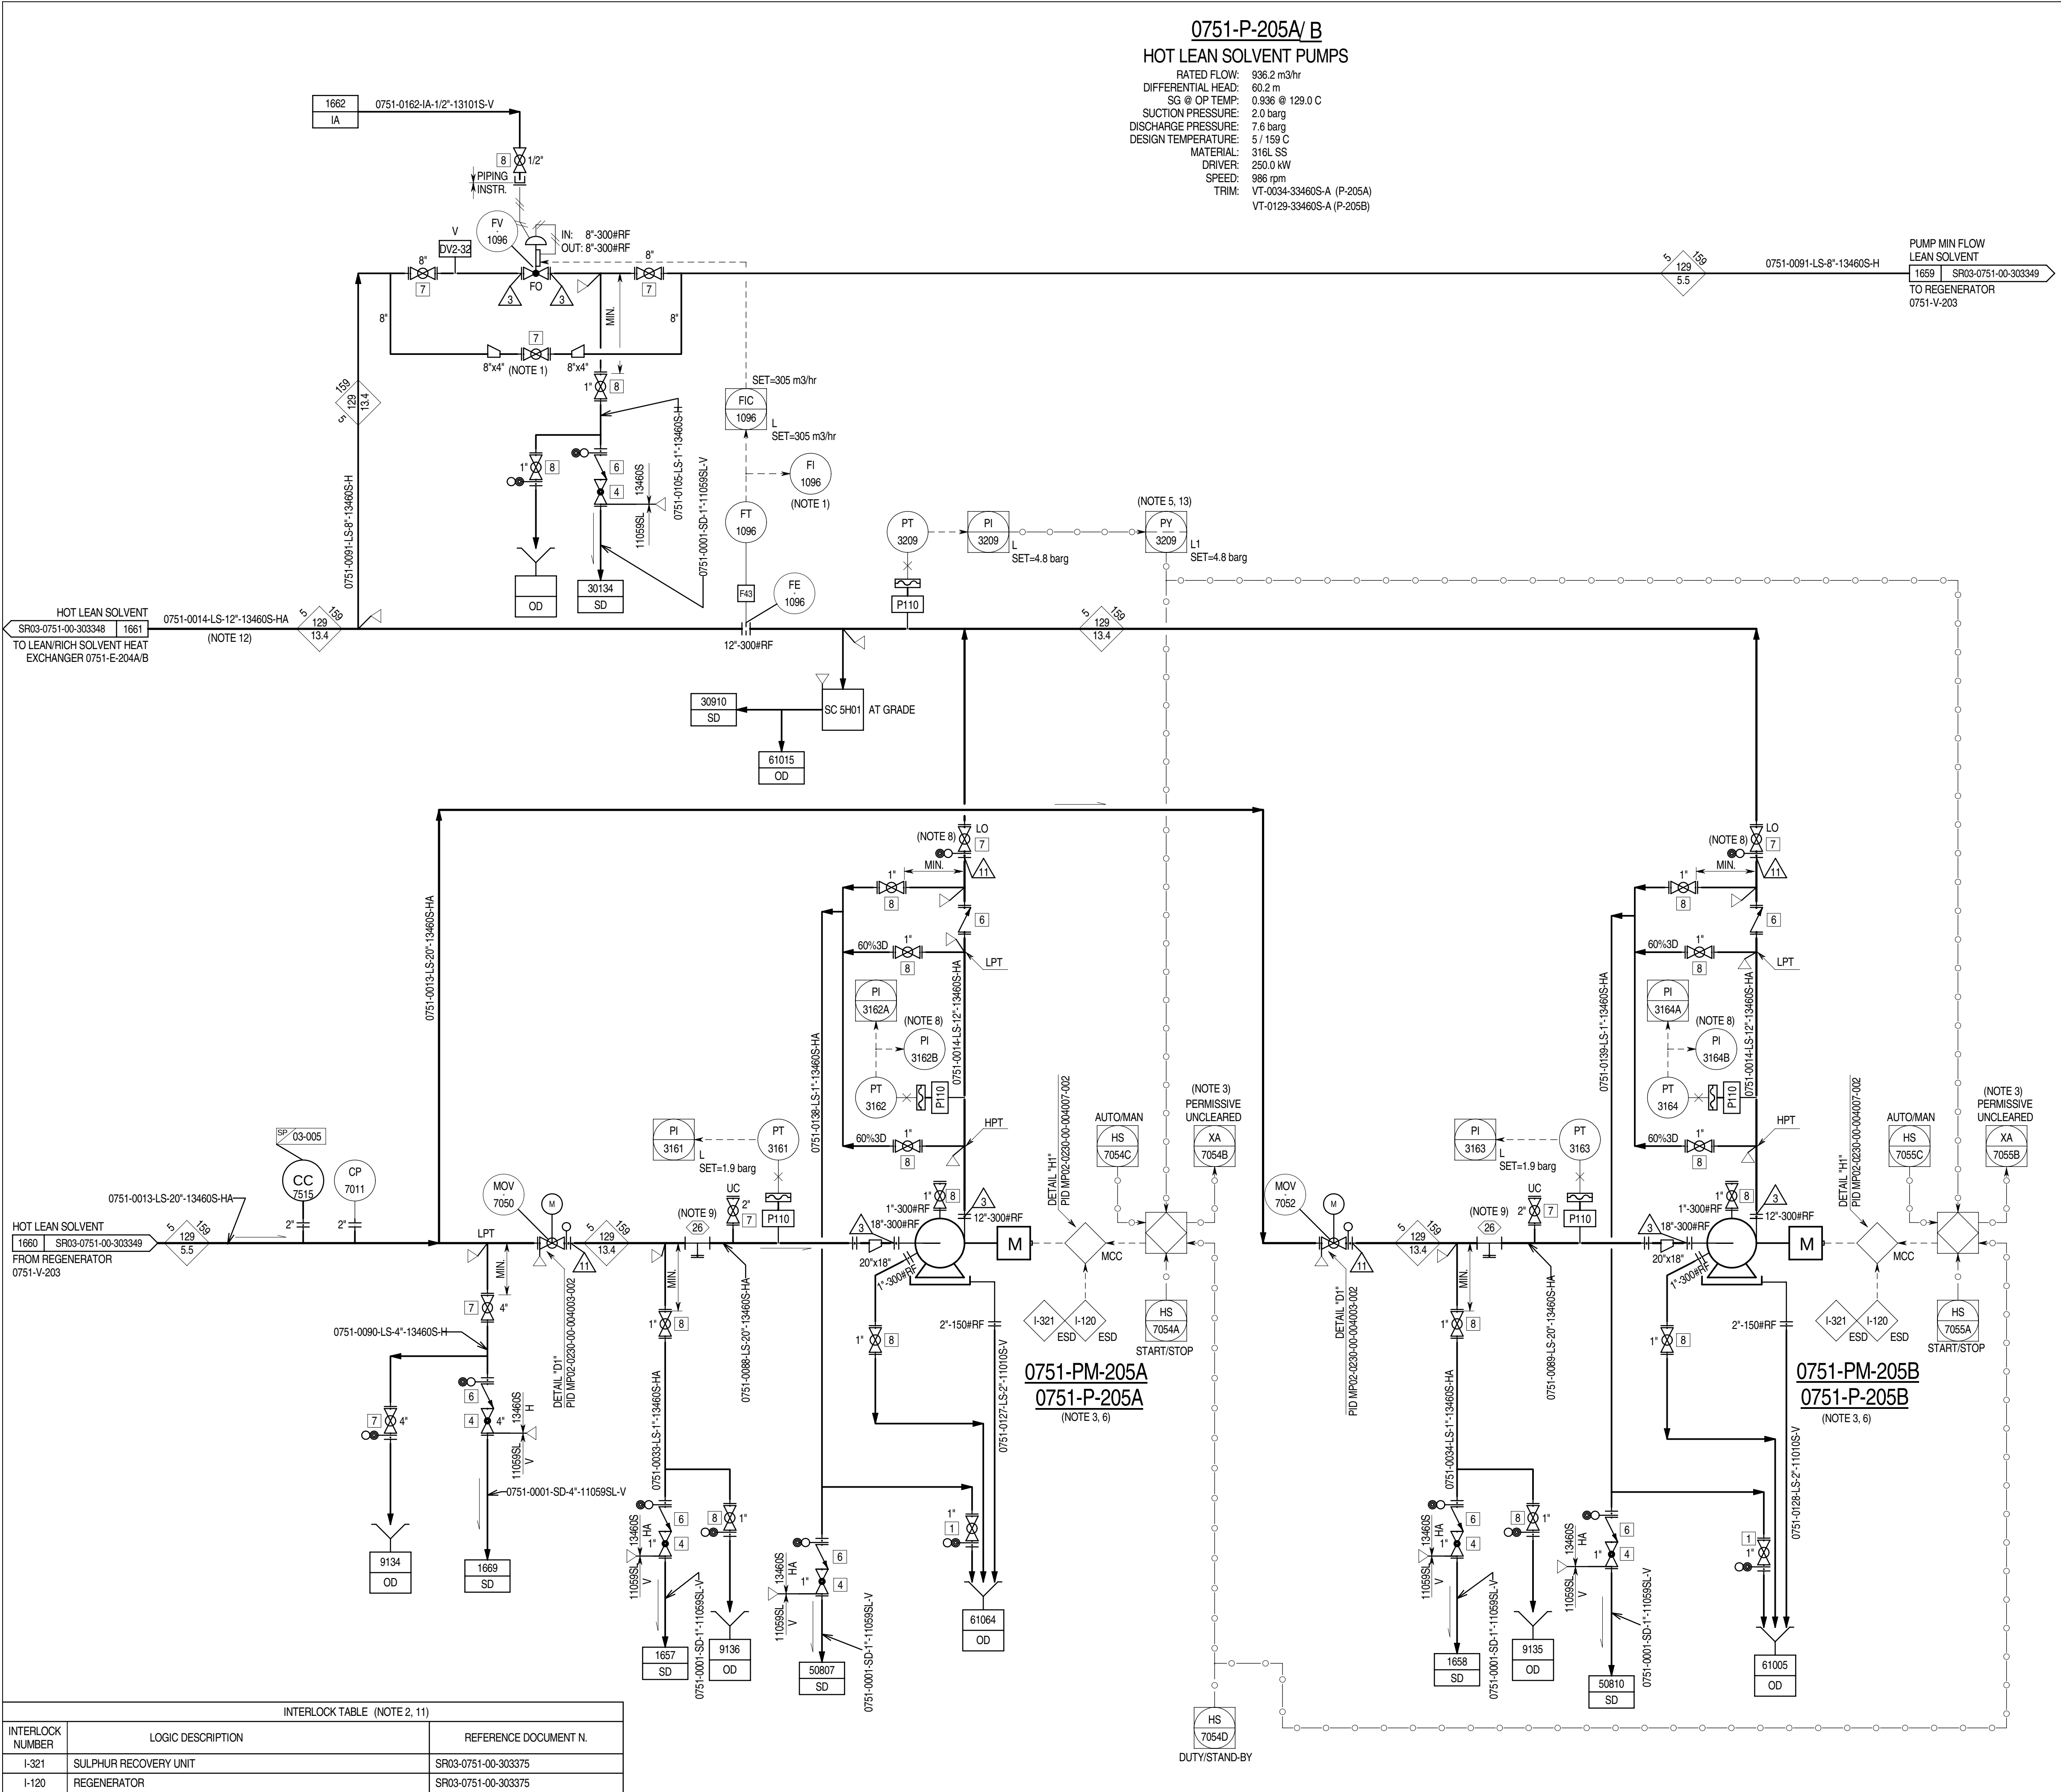

- GENERAL NOTES:**
- FOR STANDARD SYMBOLS, DETAILS, ABBREVIATIONS, SAMPLE CONNECTION TYPE, GENERAL NOTES & LEGEND SHEETS REFER TO DRAWING NO. MP02-0230-00-004000 TO 004015.
 - ALL INSTRUMENT TAG NUMBERS ON THIS P&ID INCLUDING PACKAGE UNITS ARE PREFIXED WITH UNIT NUMBERS 0751 UNLESS OTHERWISE NOTED.
 - DELETED.
- NOTES:**
- FI-1096 TO BE READABLE FROM FV-1096 BYPASS VALVE.
 - INTERLOCK TABLE IS FOR REFERENCE ONLY CAUSE AND EFFECT MATRIX SR03-0751-00-CCC-303155 SHALL GOVERN.
 - REFER TO PROCESS CONTROL NARRATIVE DOC. N. SR03-0751-15-SPE-303163 FOR PERMISSIVE TO START CONDITIONS.
 - DELETED.
 - AUTOSTART OF STAND BY PUMP FOR LOW PRESSURE.
 - PUMPS ARE 2X100%. 1 OPERATING AND 1 STAND BY.
 - DELETED.
 - PI-3162B AND PI-3164B TO BE READABLE FROM CORRESPONDING DISCHARGE ISOLATION VALVE.
 - PI-3162B AND PI-3164B TO BE READABLE FROM CORRESPONDING DISCHARGE ISOLATION VALVE.
 - TEMPORARY STRAINER WITH 60 MESH AND PERMANENT STRAINER WITH 4 MESH.
 - DELETED (TDR).
 - REFER TO CAUSE AND EFFECT CHART FOR FULL REPRESENTATION OF INTERLOCK INITIATORS AND ACTIONS.
 - ACOUSTIC INSULATION TO BE PROVIDED FOR 51 m MINIMUM FROM 0751-P-205A/B DISCHARGE NOZZLE.
 - IF THE PAL-3209 IS NOT CLEARED AFTER TIME DELAY (ADJUSTABLE) THE LOGIC SHALL STOP BOTH PUMPS.

Z1	04-11-14	IAB	ISSUED FOR AS BUILT	PCA	MAR	ASP
2.1B	06-08-12	IFC	ISSUED FOR CONSTRUCTION	DSC	CBR	SIN
2	9-12-11	IFC	ISSUED FOR CONSTRUCTION	DSC	CBR	SIN
1	12-08-11	IFCH	ISSUED FOR CONSTRUCTION WITH HOLDS	DSC	CBR	SIN
0	01-03-11	IFD	ISSUED CLIENT COMMENTS INCORPORATED	BSC	LMA	SIN
B1	30-09-10	ICR	ISSUED FOR CLIENT REVIEW	BSC	LMA	SIN
REV	DATE	STATUS	STATUS DESCRIPTION	BY	CKD	APP.

COMPANY:

Abu Dhabi Gas Development Co. Ltd.

CONTRACTOR:

JOB No. 032090

PROJECT:

SHAH GAS DEVELOPMENT (SGD) PROJECT

AGREEMENT No. 13525001

DRAWING TITLE: PIPING & INSTRUMENT DIAGRAM UNIT 0751
SULPHUR RECOVERY AND TAIL GAS TREATING UNIT

EQUIPMENT DESCRIPTION	HOT LEAN SOLVENT PUMPS
TAGITEM No.	0751-P-205A / B

CONTRACTOR DRG. No.	751-GD-B-303350	REV. Z1
COMPANY DRG. No.	SR03-0751-00-303350-001	
SCALE:	SIZE: A1	
	DOC. CLASS: 1	

THIS DOCUMENT IS THE PROPERTY OF ABU DHABI GAS DEVELOPMENT COMPANY LIMITED AND CONTAINS INFORMATION WHICH IS PROPRIETARY. THIS INFORMATION IS TO BE HELD IN CONFIDENCE. NO DISCLOSURE OR OTHER USE OF THIS DOCUMENT IS TO BE MADE WITHOUT THE PRIOR WRITTEN CONSENT OF ABU DHABI GAS DEVELOPMENT COMPANY LIMITED.

PLAN 11/53B FOR BB PUMPS



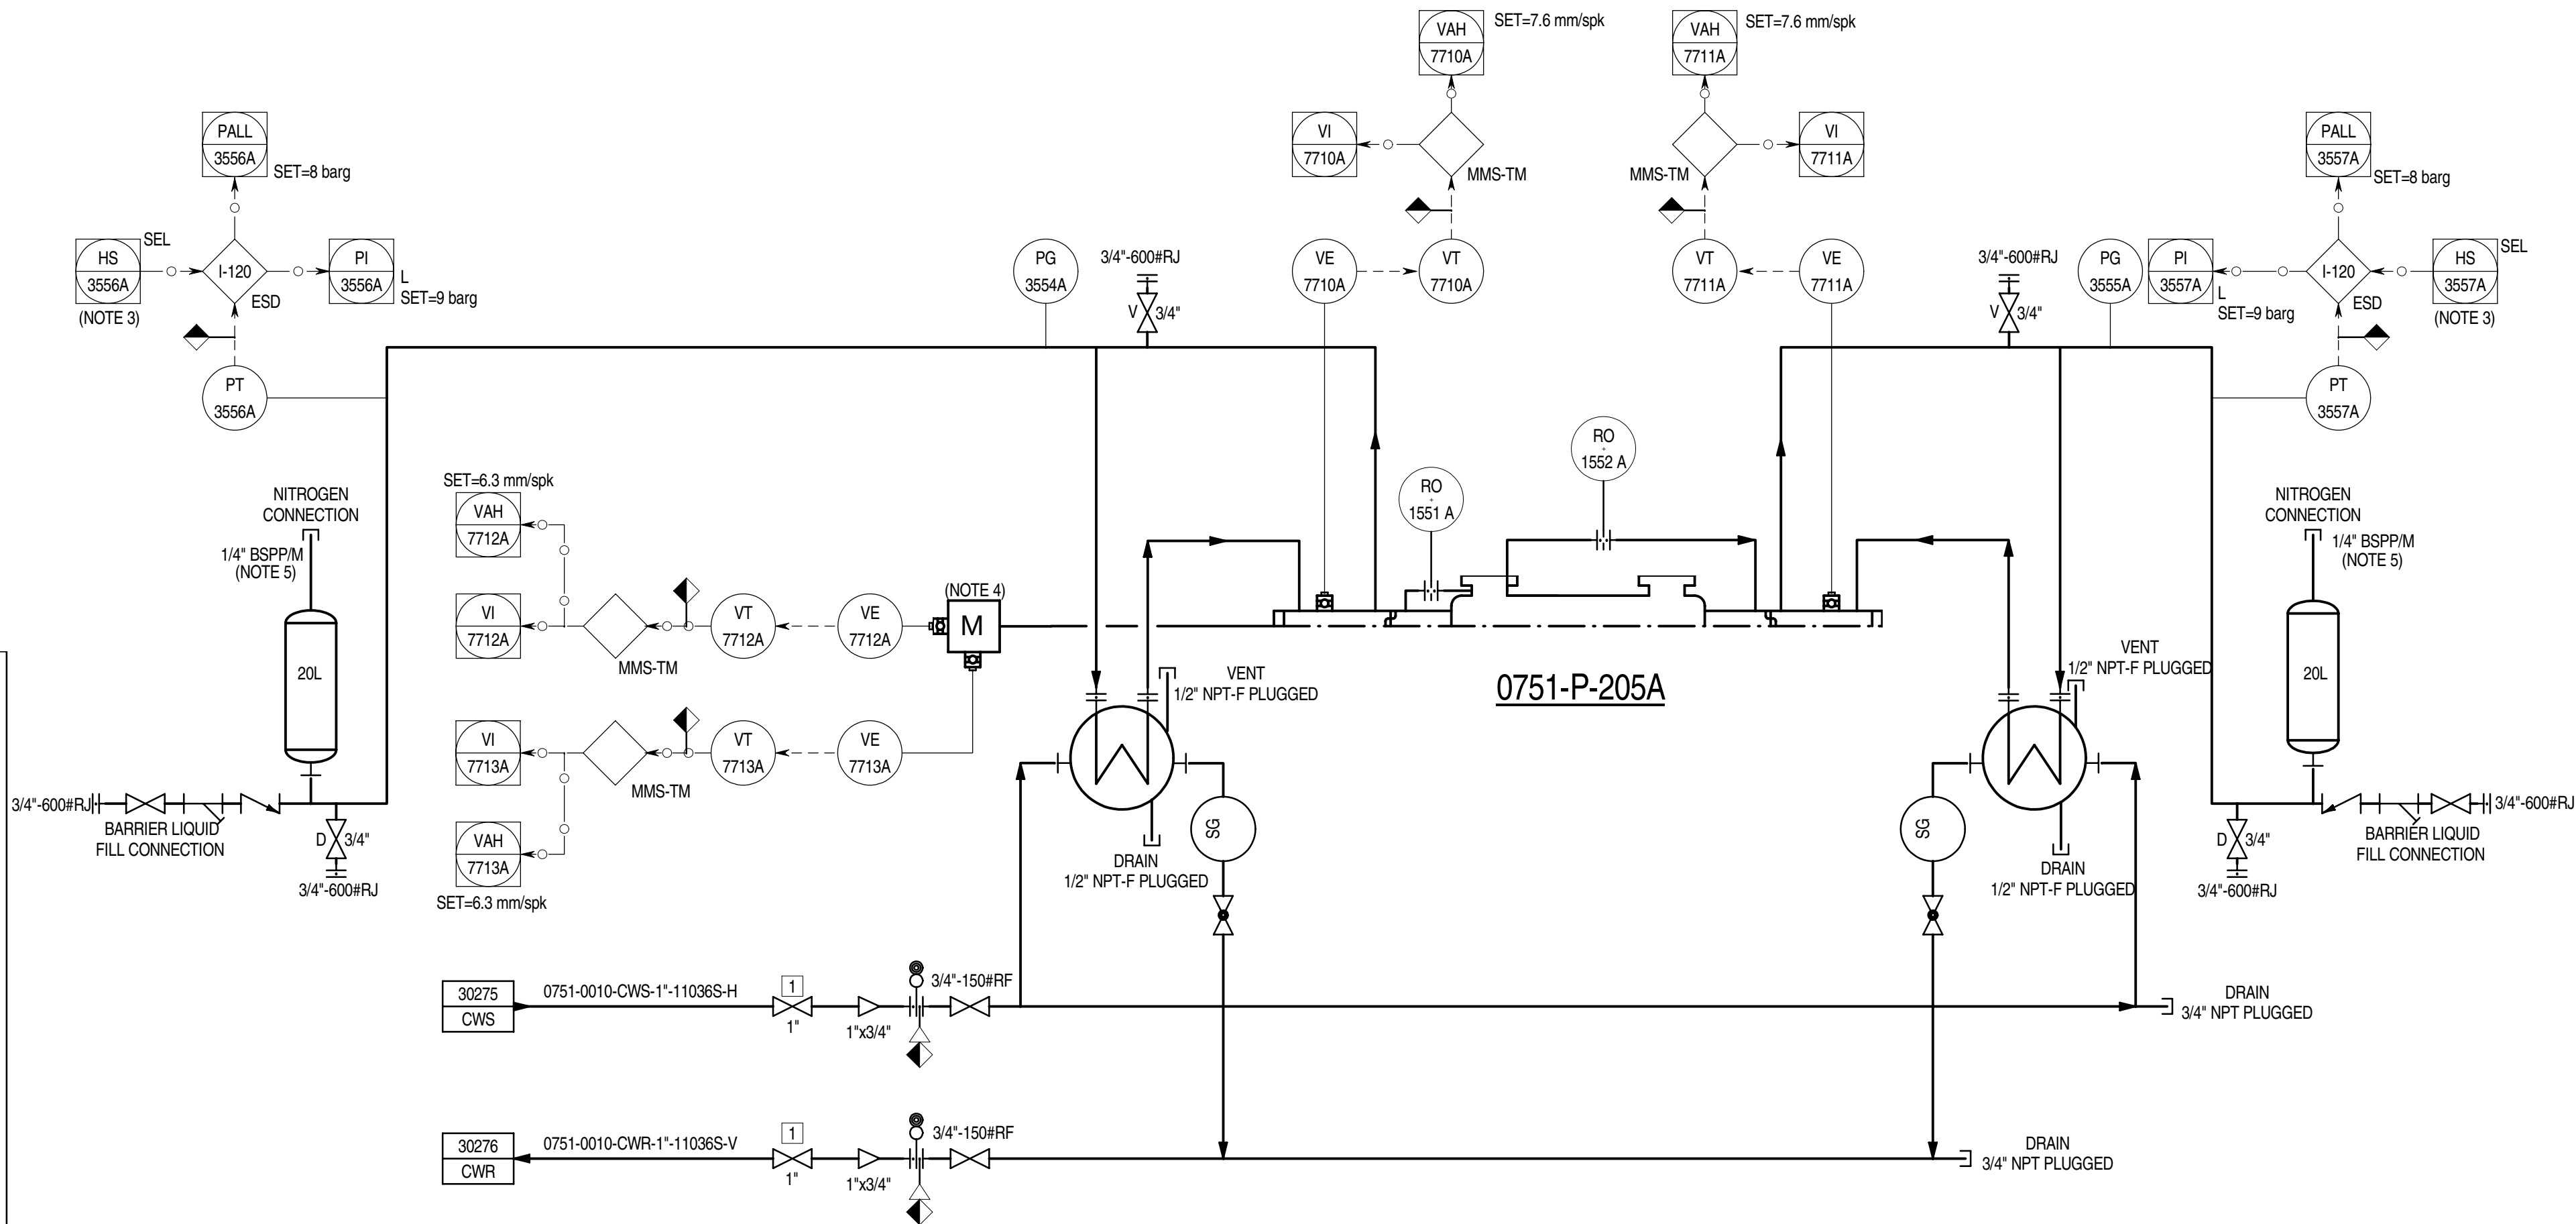


TABLE 1 (NOTE 4)					
MOTOR PUMP	TE	TI	TAH	TAHH	TE (SPARE)
0751-PM-205A	TE-4712AA	TI-4712A	TAH-4712A	TAHH-4712A	TE-4712AB
	TE-4713AA	TI-4713A	TAH-4713A	TAHH-4713A	TE-4713AB
	TE-4714AA	TI-4714A	TAH-4714A	TAHH-4714A	TE-4714AB
	TE-4712BA	TI-4712B	TAH-4712B	TAHH-4712B	TE-4712BB
0751-PM-205B	TE-4713BA	TI-4713B	TAH-4713B	TAHH-4713B	TE-4713BB
	TE-4714BA	TI-4714B	TAH-4714B	TAHH-4714B	TE-4714BB
	TE-4712CA	TI-4712C	TAH-4712C	TAHH-4712C	TE-4712CB
	TE-4713CA	TI-4713C	TAH-4713C	TAHH-4713C	TE-4713CB

DETAIL "A"

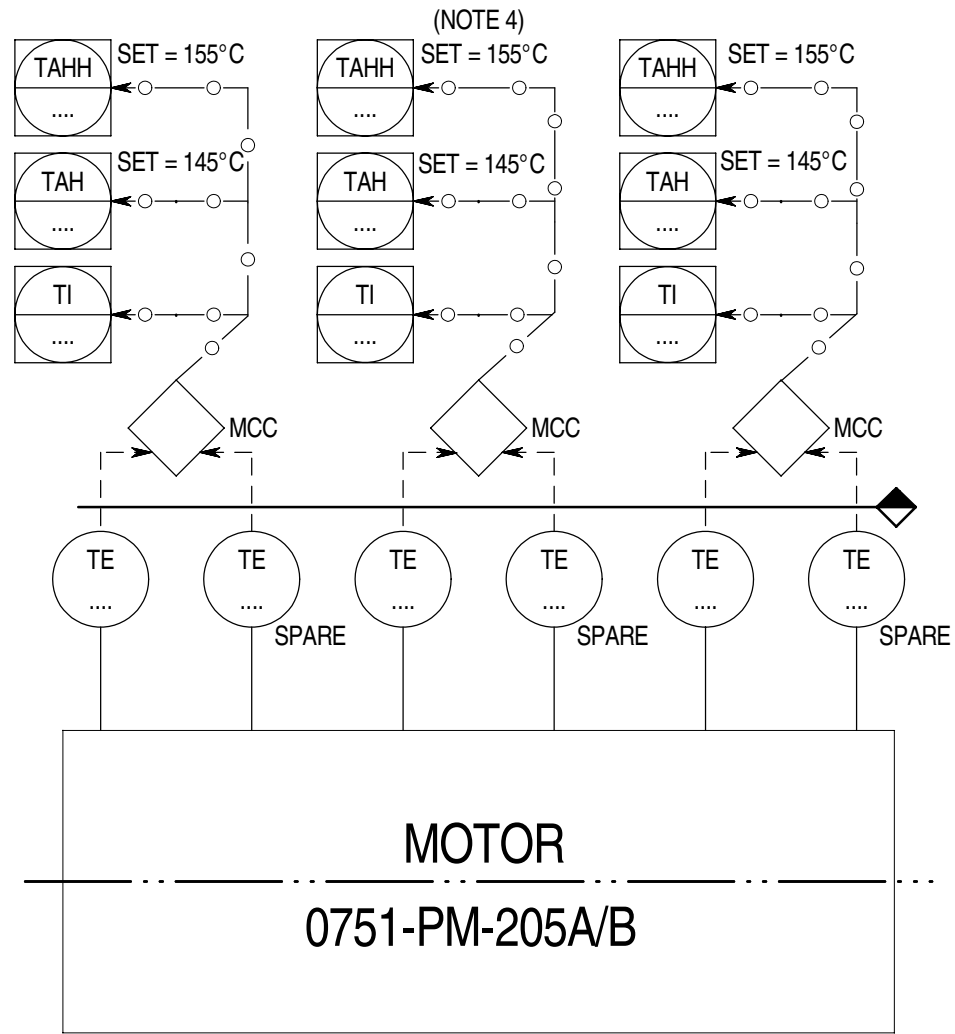

PLAN 11/53B FOR BB PUMPS

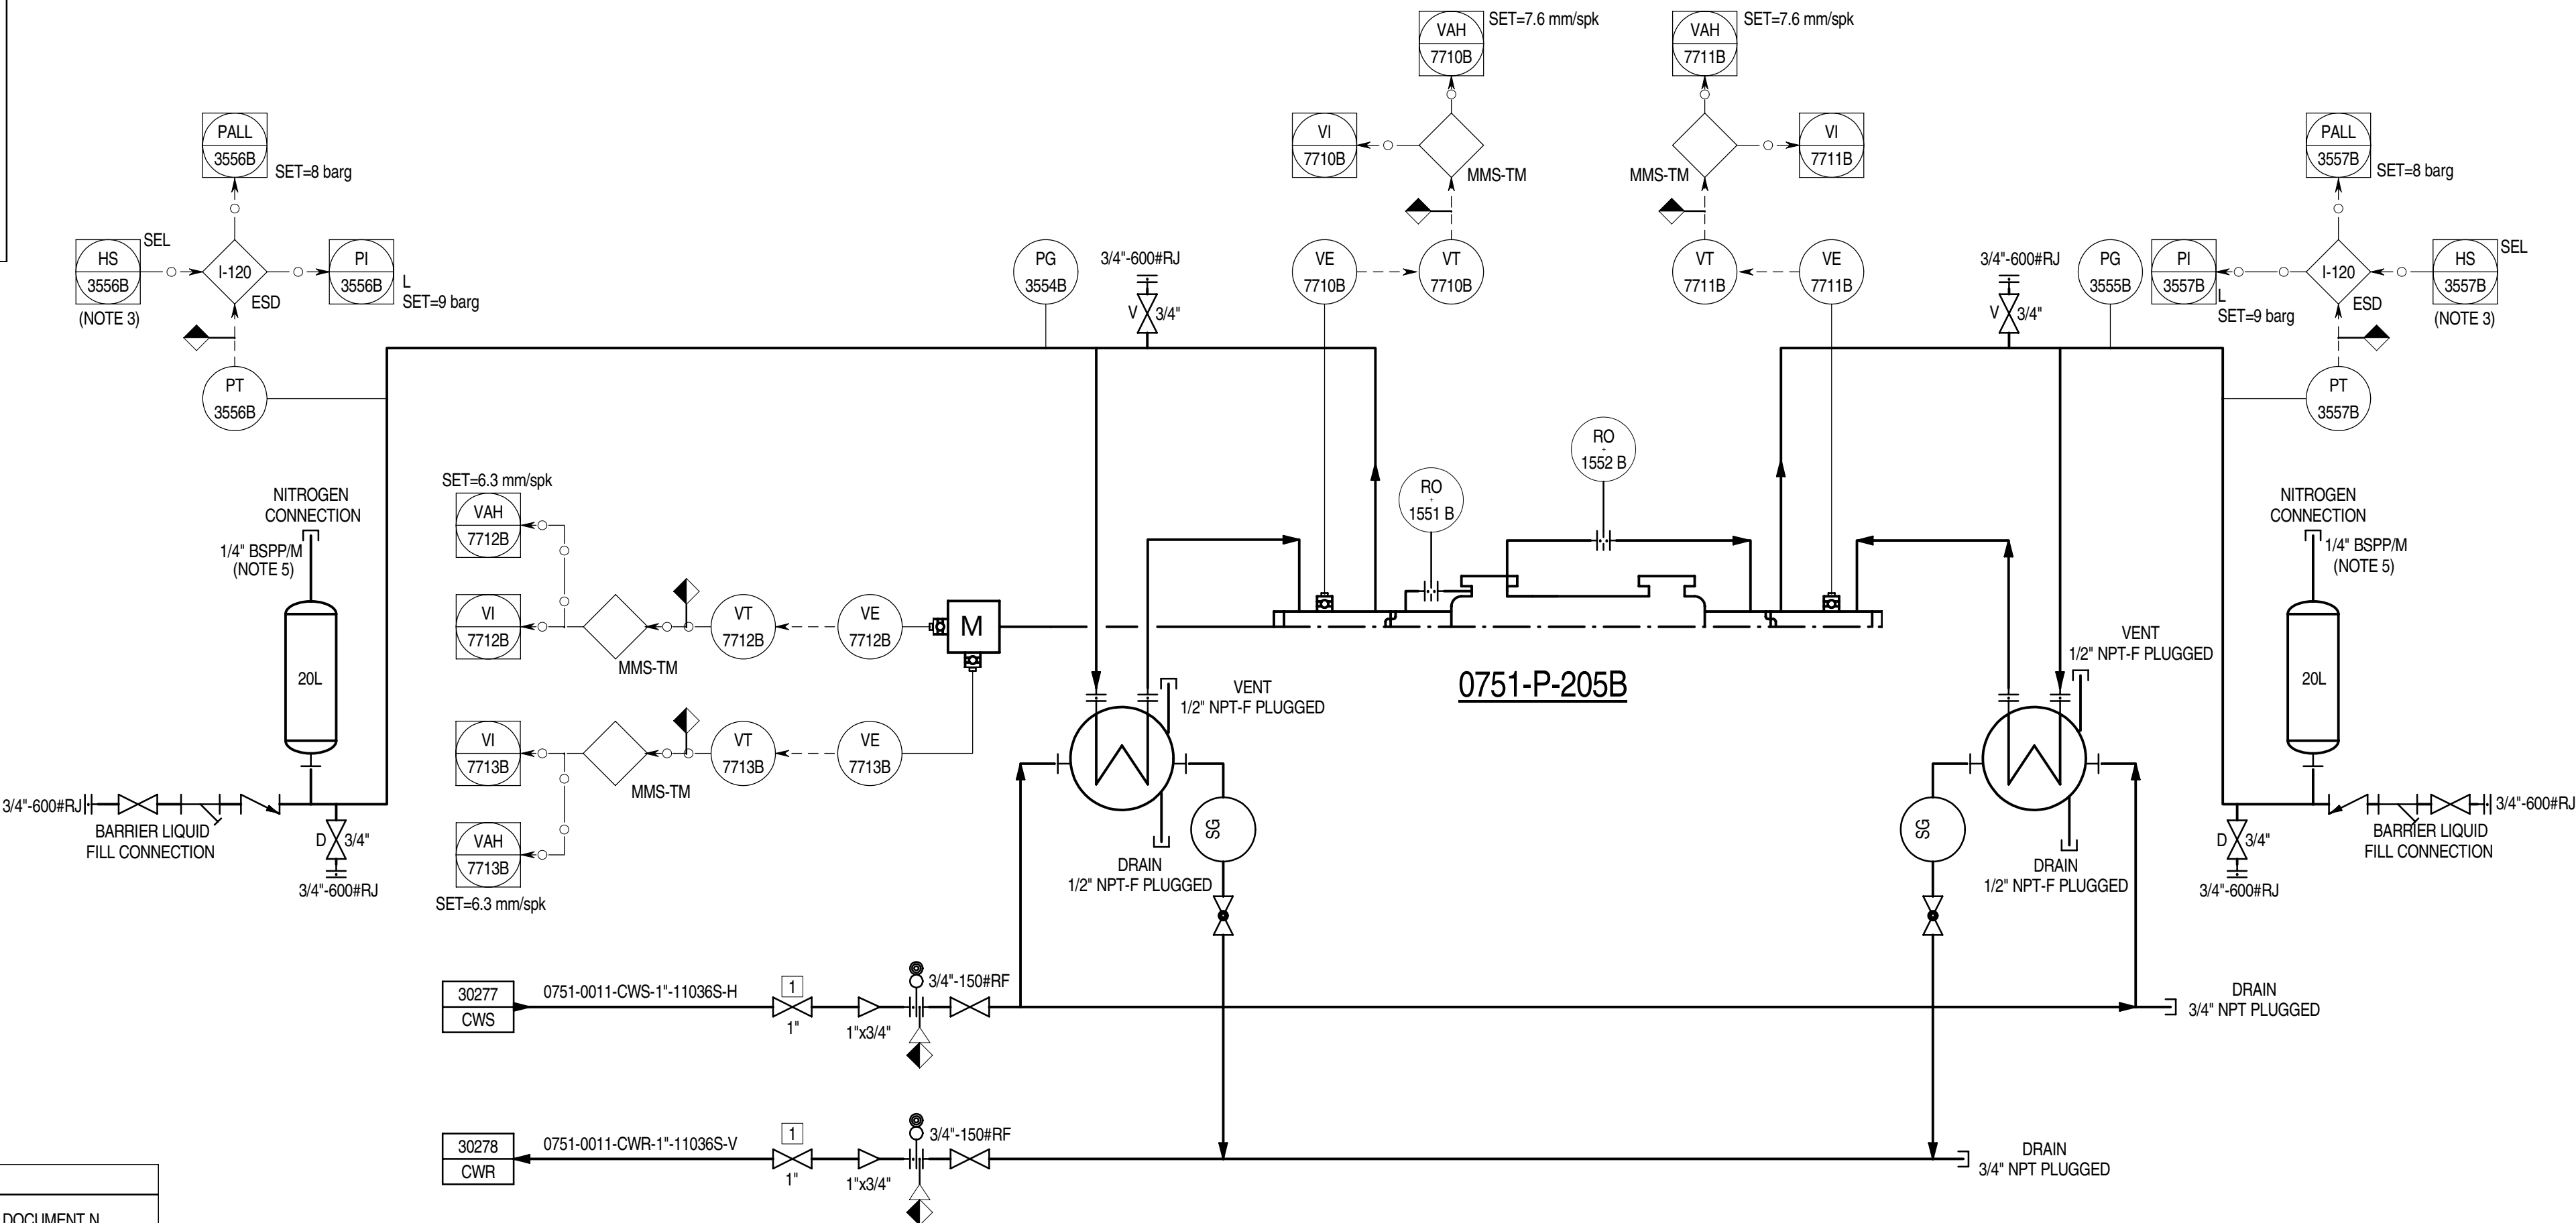

INTERLOCK TABLE (NOTE 1)		
INTERLOCK NUMBER	LOGIC DESCRIPTION (NOTE 2)	REFERENCE DOCUMENT N.
I-120	REGENERATOR	SR03-0751-00-303375

GENERAL NOTES:

- FOR STANDARD SYMBOLS, DETAILS, ABBREVIATIONS, SAMPLE CONNECTION TYPE, GENERAL NOTES & LEGEND SHEETS REFER TO DRAWING NO. MP02-0230-00-004000 TO 004015.
 - ALL INSTRUMENT TAG NUMBERS ON THIS P&ID INCLUDING PACKAGE UNITS ARE PREFIXED WITH UNIT NUMBER 0751 UNLESS OTHERWISE NOTED.
 - DELETED.
- NOTES:
- INTERLOCK TABLE IS FOR REFERENCE ONLY. CAUSE AND EFFECT CHART SR03-0751-00-CCC-303155 SHALL GOVERN.
 - REFER TO CAUSE AND EFFECT CHART FOR FULL REPRESENTATION OF INTERLOCK INITIATORS AND ACTIONS.
 - SELECTOR TO ACTIVATE EITHER ALARM ONLY OR ALARM AND TRIP.
 - FOR DETAIL OF TEMPERATURE MEASUREMENT ON ELECTRICAL MOTOR REFER TO DETAIL "A" AND TABLE 1.
 - BSPP/M = BRITISH STANDARD PARALLEL PIPE / MALE.

UTILITY REFERENCE TABLE		
CWR/CWS	DRW. N°.	SR03-0751-00-PID-362308

REV	DATE	STATUS	STATUS DESCRIPTION	BY	CKD	APP.
Z1	04-11-14	IAB	ISSUED FOR AS BUILT	PCA	MAR	ASP
2.1B	06-08-12	IFC	ISSUED FOR CONSTRUCTION	DSC	CBR	\$IN
2	29-12-11	IFC	ISSUED FOR CONSTRUCTION	DSC	CBR	SIN
1	12-08-11	IFCH	ISSUED FOR CONSTRUCTION WITH HOLDS	DSC	CBR	SIN

COMPANY:

Abu Dhabi Gas Development Co. Ltd.

CONTRACTOR:

JOB No. 032090

PROJECT:


SHAH GAS DEVELOPMENT (SGD) PROJECT

AGREEMENT No. 13525001

DRAWING TITLE: PIPING & INSTRUMENT DIAGRAM UNIT 0751 SULPHUR RECOVERY AND TAIL GAS TREATING UNIT

EQUIPMENT DESCRIPTION	API PLAN 0751-P-205A/B AND VIBRATION MONITORING
TAGITEM No.	

CONTRACTOR DRG. No.	751-GD-B-303350	REV. Z1
COMPANY DRG. No.	SR03-0751-00-303350-002	
SCALE:	SIZE: A1	
		DOC. CLASS: 1

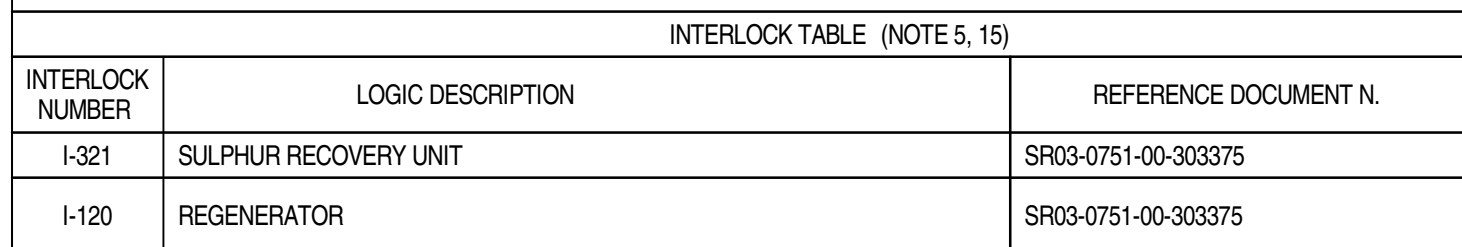


SIZE:	A1	DOC. CLASS:	1
-------	----	-------------	---

THIS DOCUMENT IS THE PROPERTY OF ABU DHABI GAS DEVELOPMENT COMPANY LIMITED. THIS DOCUMENT IS TO BE HELD IN CONFIDENCE. NO DISCLOSURE OR OTHER USE OF THIS DOCUMENT IS TO BE MADE WITHOUT THE PRIOR WRITTEN CONSENT OF ABU DHABI GAS DEVELOPMENT COMPANY LIMITED.

THIS DOCUMENT IS THE PROPERTY OF ABU DHABI GAS DEVELOPMENT COMPANY LIMITED AND CONTAINS INFORMATION WHICH IS PROPRIETARY. THIS INFORMATION IS TO BE HELD IN CONFIDENCE. NO DISCLOSURE OR OTHER USE OF THIS DOCUMENT IS TO BE MADE WITHOUT THE PRIOR WRITTEN CONSENT OF ABU DHABI GAS DEVELOPMENT COMPANY LIMITED.

0751-V-204 REGENERATOR REFLUX DRUM

TYPE: HORIZONTAL
SIZE: 1900 mm ID x 3800 mm T/T
CAPACITY: 12.6 m³
DESIGN CONDITIONS: 5.5 barg @ 0/116 C & FV @ 116 C & HV @ 150 C
OPER CONDITIONS: 1.1 barg @ 61 C
MATERIAL: 316L SS
INSULATION: V
TRIM: VT-0041-33460SL-V
LETHAL SERVICE

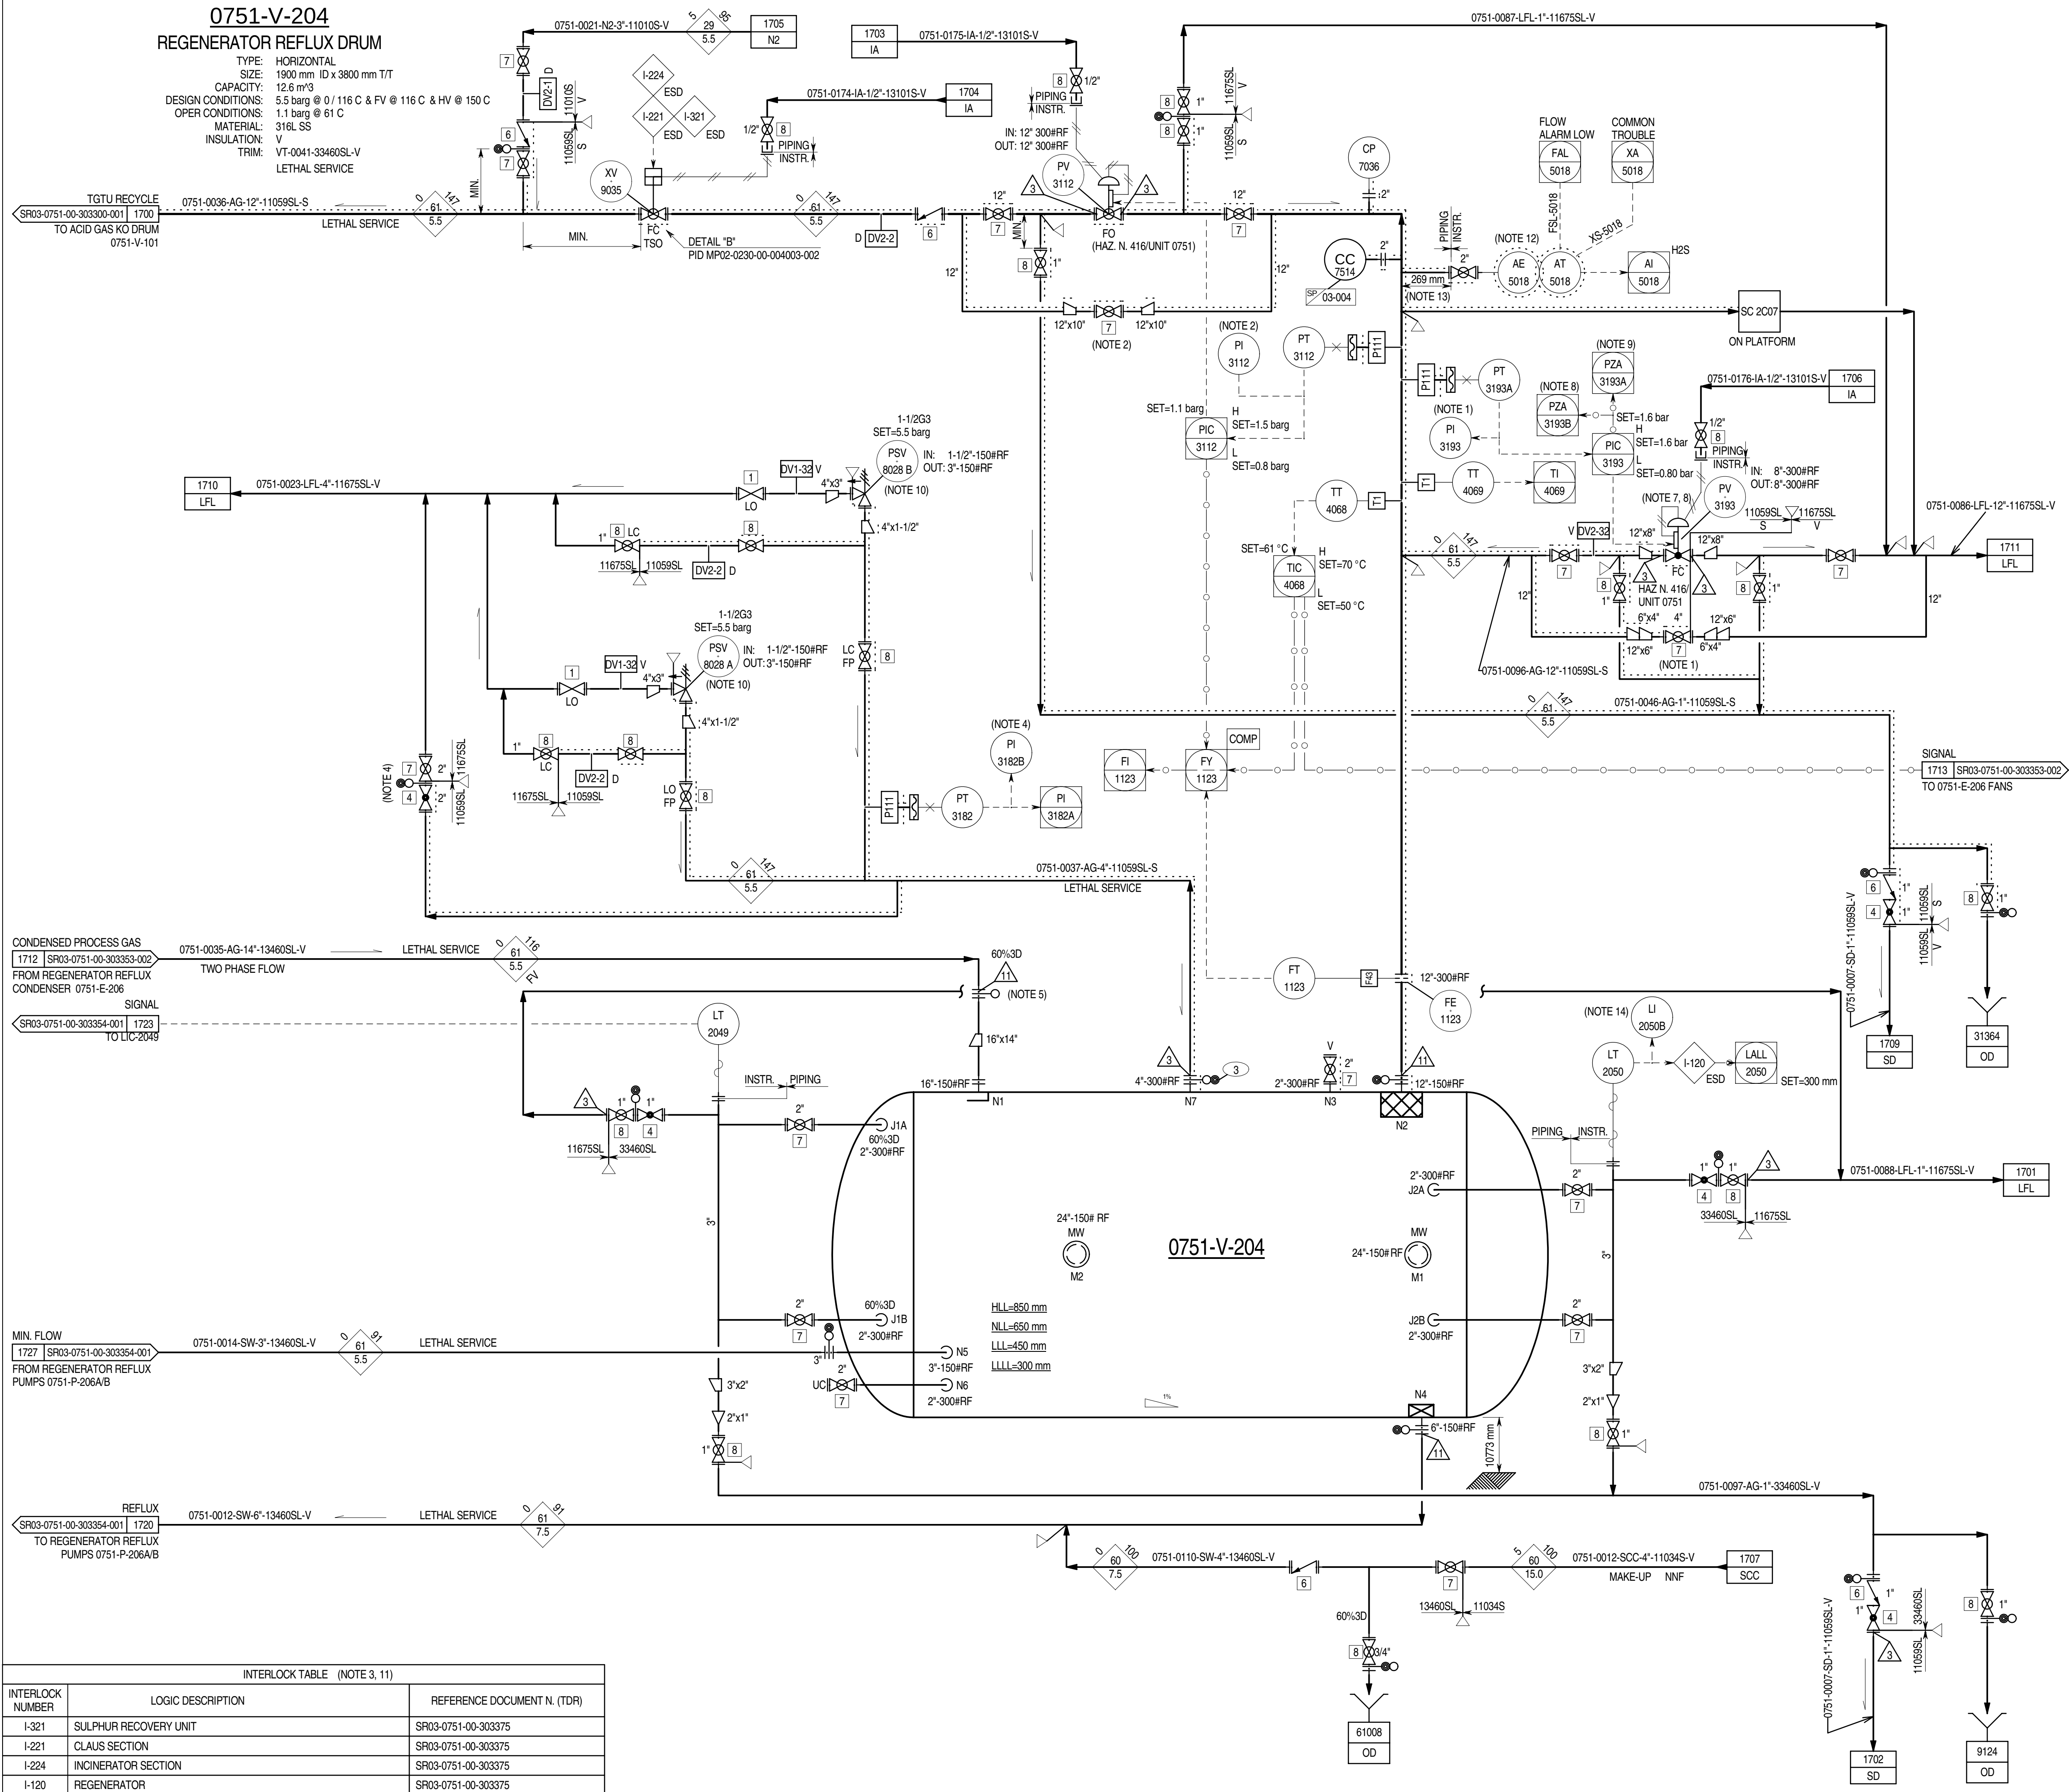

ZI	DATE	STATUS	ISSUED FOR AS BUILT	PCA	MAR	ASP
2.1D	18-04-14	IFC	ISSUED FOR CONSTRUCTION	PCA	MAR	ASP
2.1C	31-10-12	IFC	ISSUED FOR CONSTRUCTION	RL	MF	MZ
2.1B	06-08-12	IFC	ISSUED FOR CONSTRUCTION	DSC	CBR	SIN
2	29-12-11	IFC	ISSUED FOR CONSTRUCTION	DSC	CBR	SIN
1	12-08-11	IFCH	ISSUED FOR CONSTRUCTION WITH HOLDS	DSC	CBR	SIN
0	01-03-11	IFD	ISSUED CLIENT COMMENTS INCORPORATED	BSC	LMA	SIN
B1	30-09-10	ICR	ISSUED FOR CLIENT REVIEW	BSC	LMA	SIN
REV	DATE	STATUS	STATUS DESCRIPTION	BY	CKD	APP.

COMPANY:

Abu Dhabi Gas Development Co. Ltd.

CONTRACTOR:


Al Hosn Gas

CONTRACTOR:


eni saipem

JOB No.

032090

PROJECT:

SHAH GAS DEVELOPMENT (SGD) PROJECT

AGREEMENT No.

13525001

DRAWING TITLE:

PIPING & INSTRUMENT DIAGRAM UNIT 0751
SULPHUR RECOVERY AND TAIL GAS TREATING UNIT

EQUIPMENT DESCRIPTION

REGENERATOR REFLUX DRUM

TAGITEM No.

0751-V-204

CONTRACTOR DRG. No.

751-GD-B-303353

COMPANY DRG. No.

SR03-0751-00-303353-001

SCALE:

SIZE: A1



DOC. CLASS: 1

REV.

Z1

CONTRACTOR DRG.No.		751-GD-B-303353	REV. Z1
COMPANY DRG.No.		SR03-0751-00-303353-002	
SCALE:	SIZE: A1	DOC. CLASS: 1	

THIS DOCUMENT IS THE PROPERTY OF ABU DHABI GAS DEVELOPMENT COMPANY LIMITED AND CONTAINS INFORMATION WHICH IS PROPRIETARY. THIS INFORMATION IS TO BE HELD IN CONFIDENCE. NO DISCLOSURE OR OTHER USE OF THIS DOCUMENT IS TO BE MADE WITHOUT THE PRIOR WRITTEN CONSENT OF ABU DHABI GAS DEVELOPMENT COMPANY LIMITED.

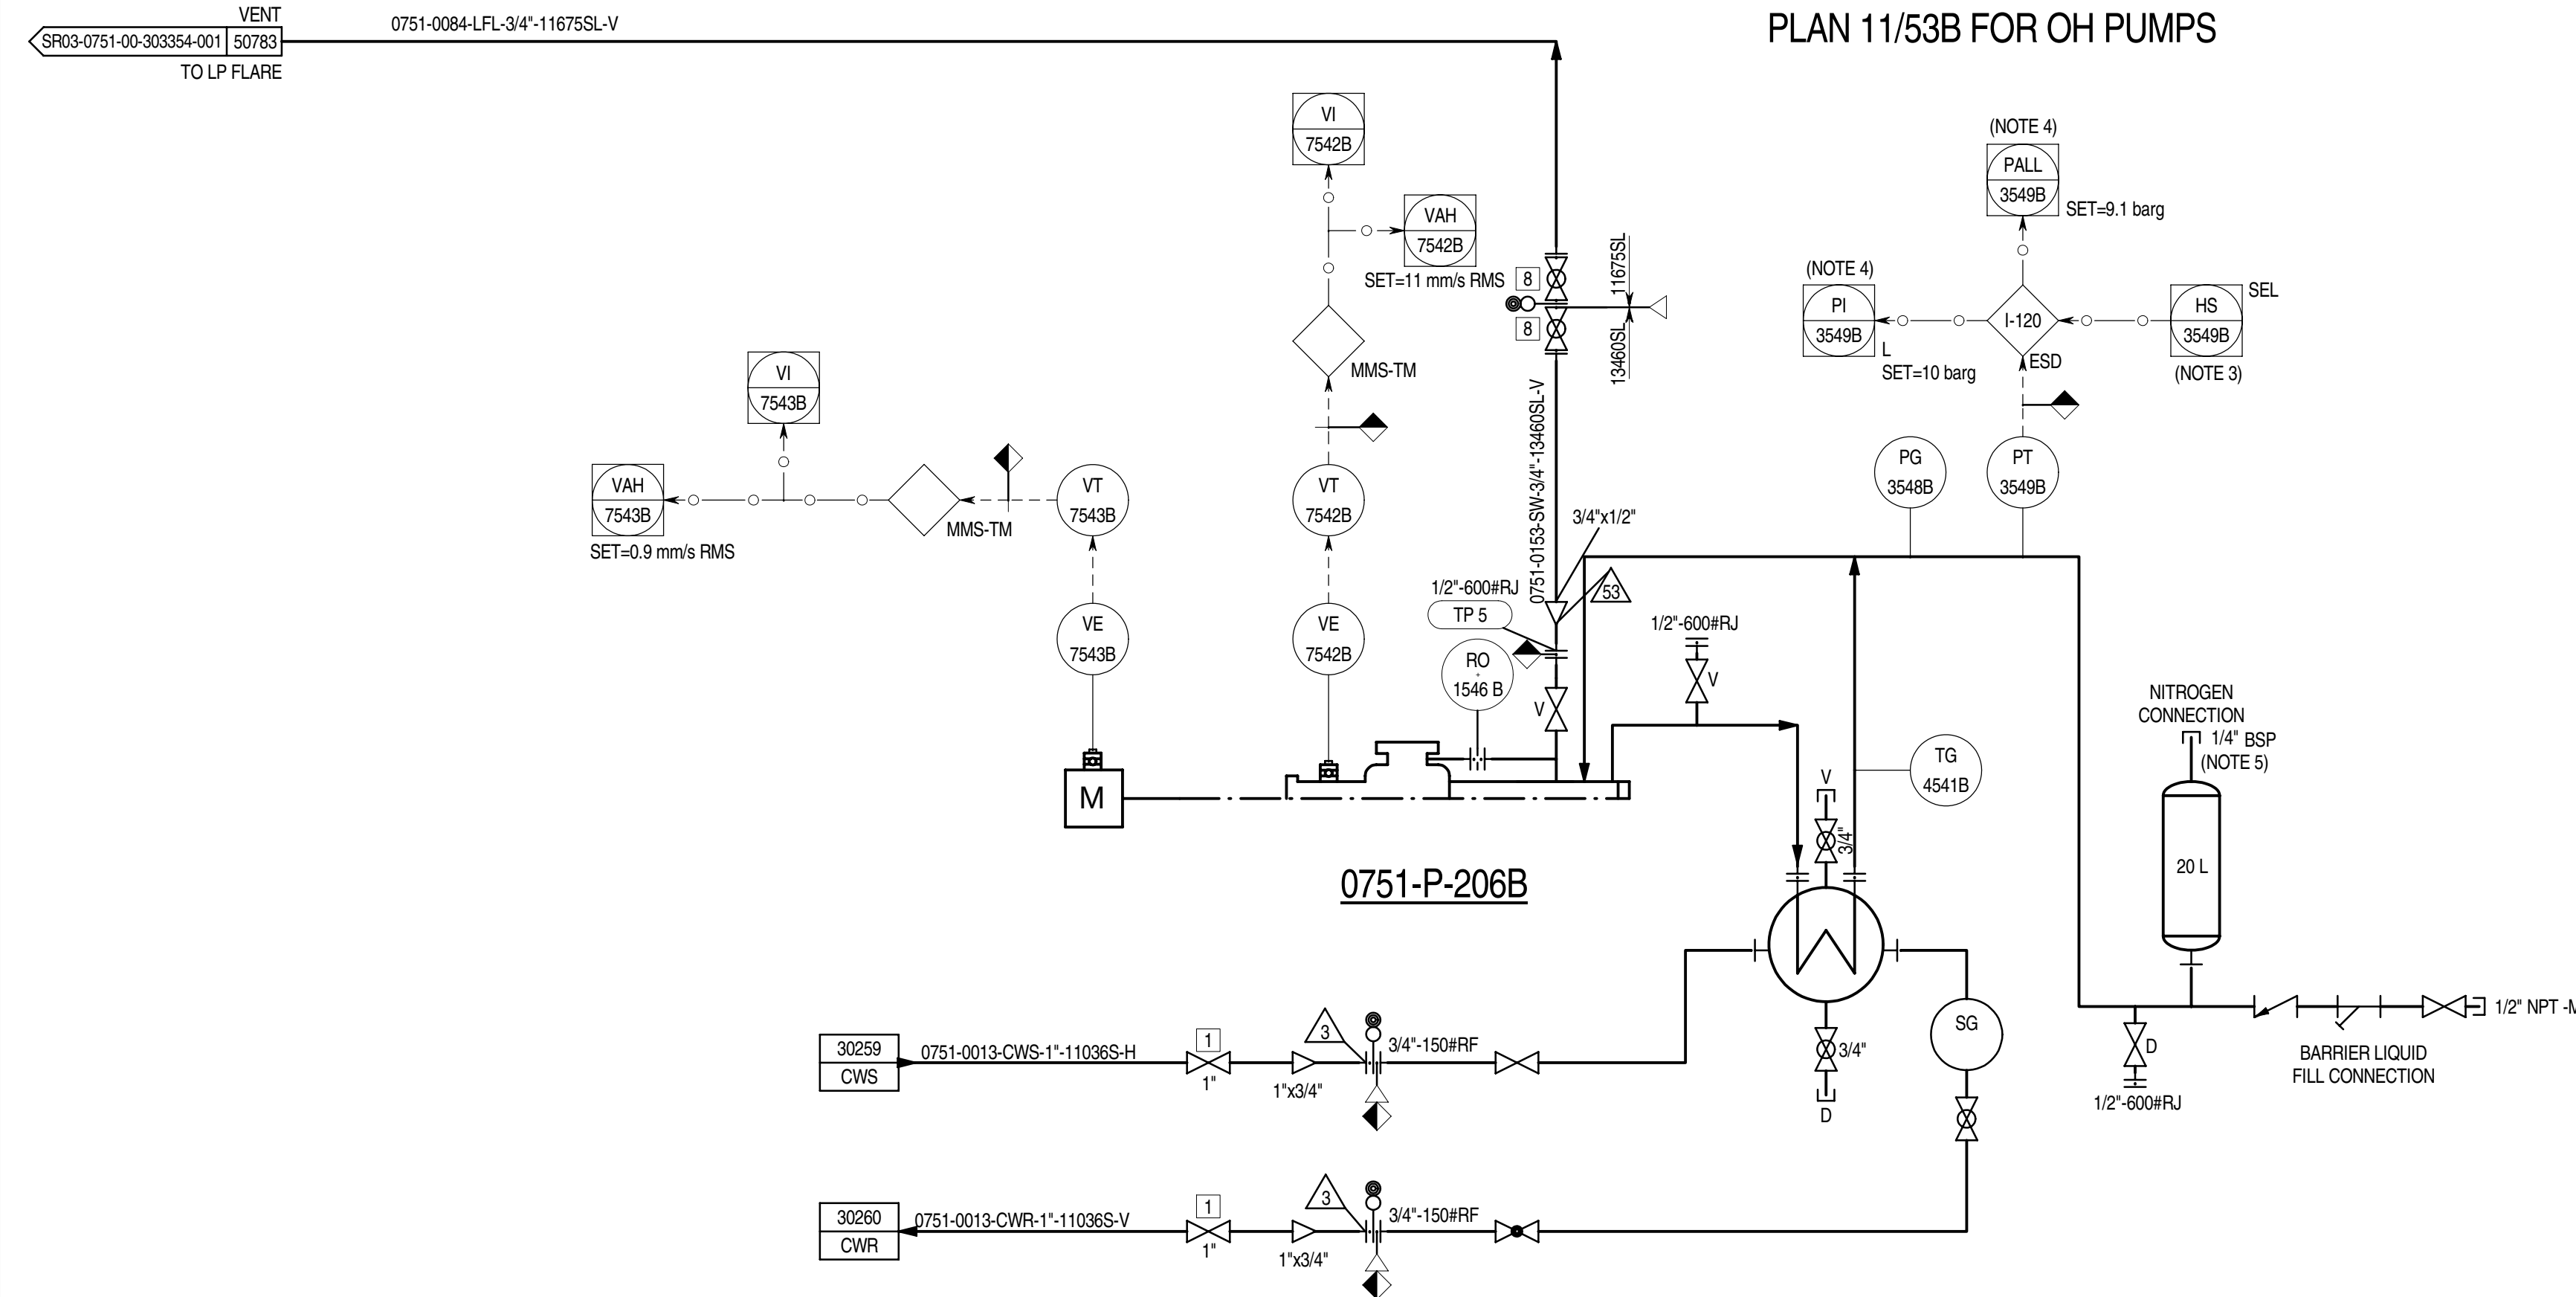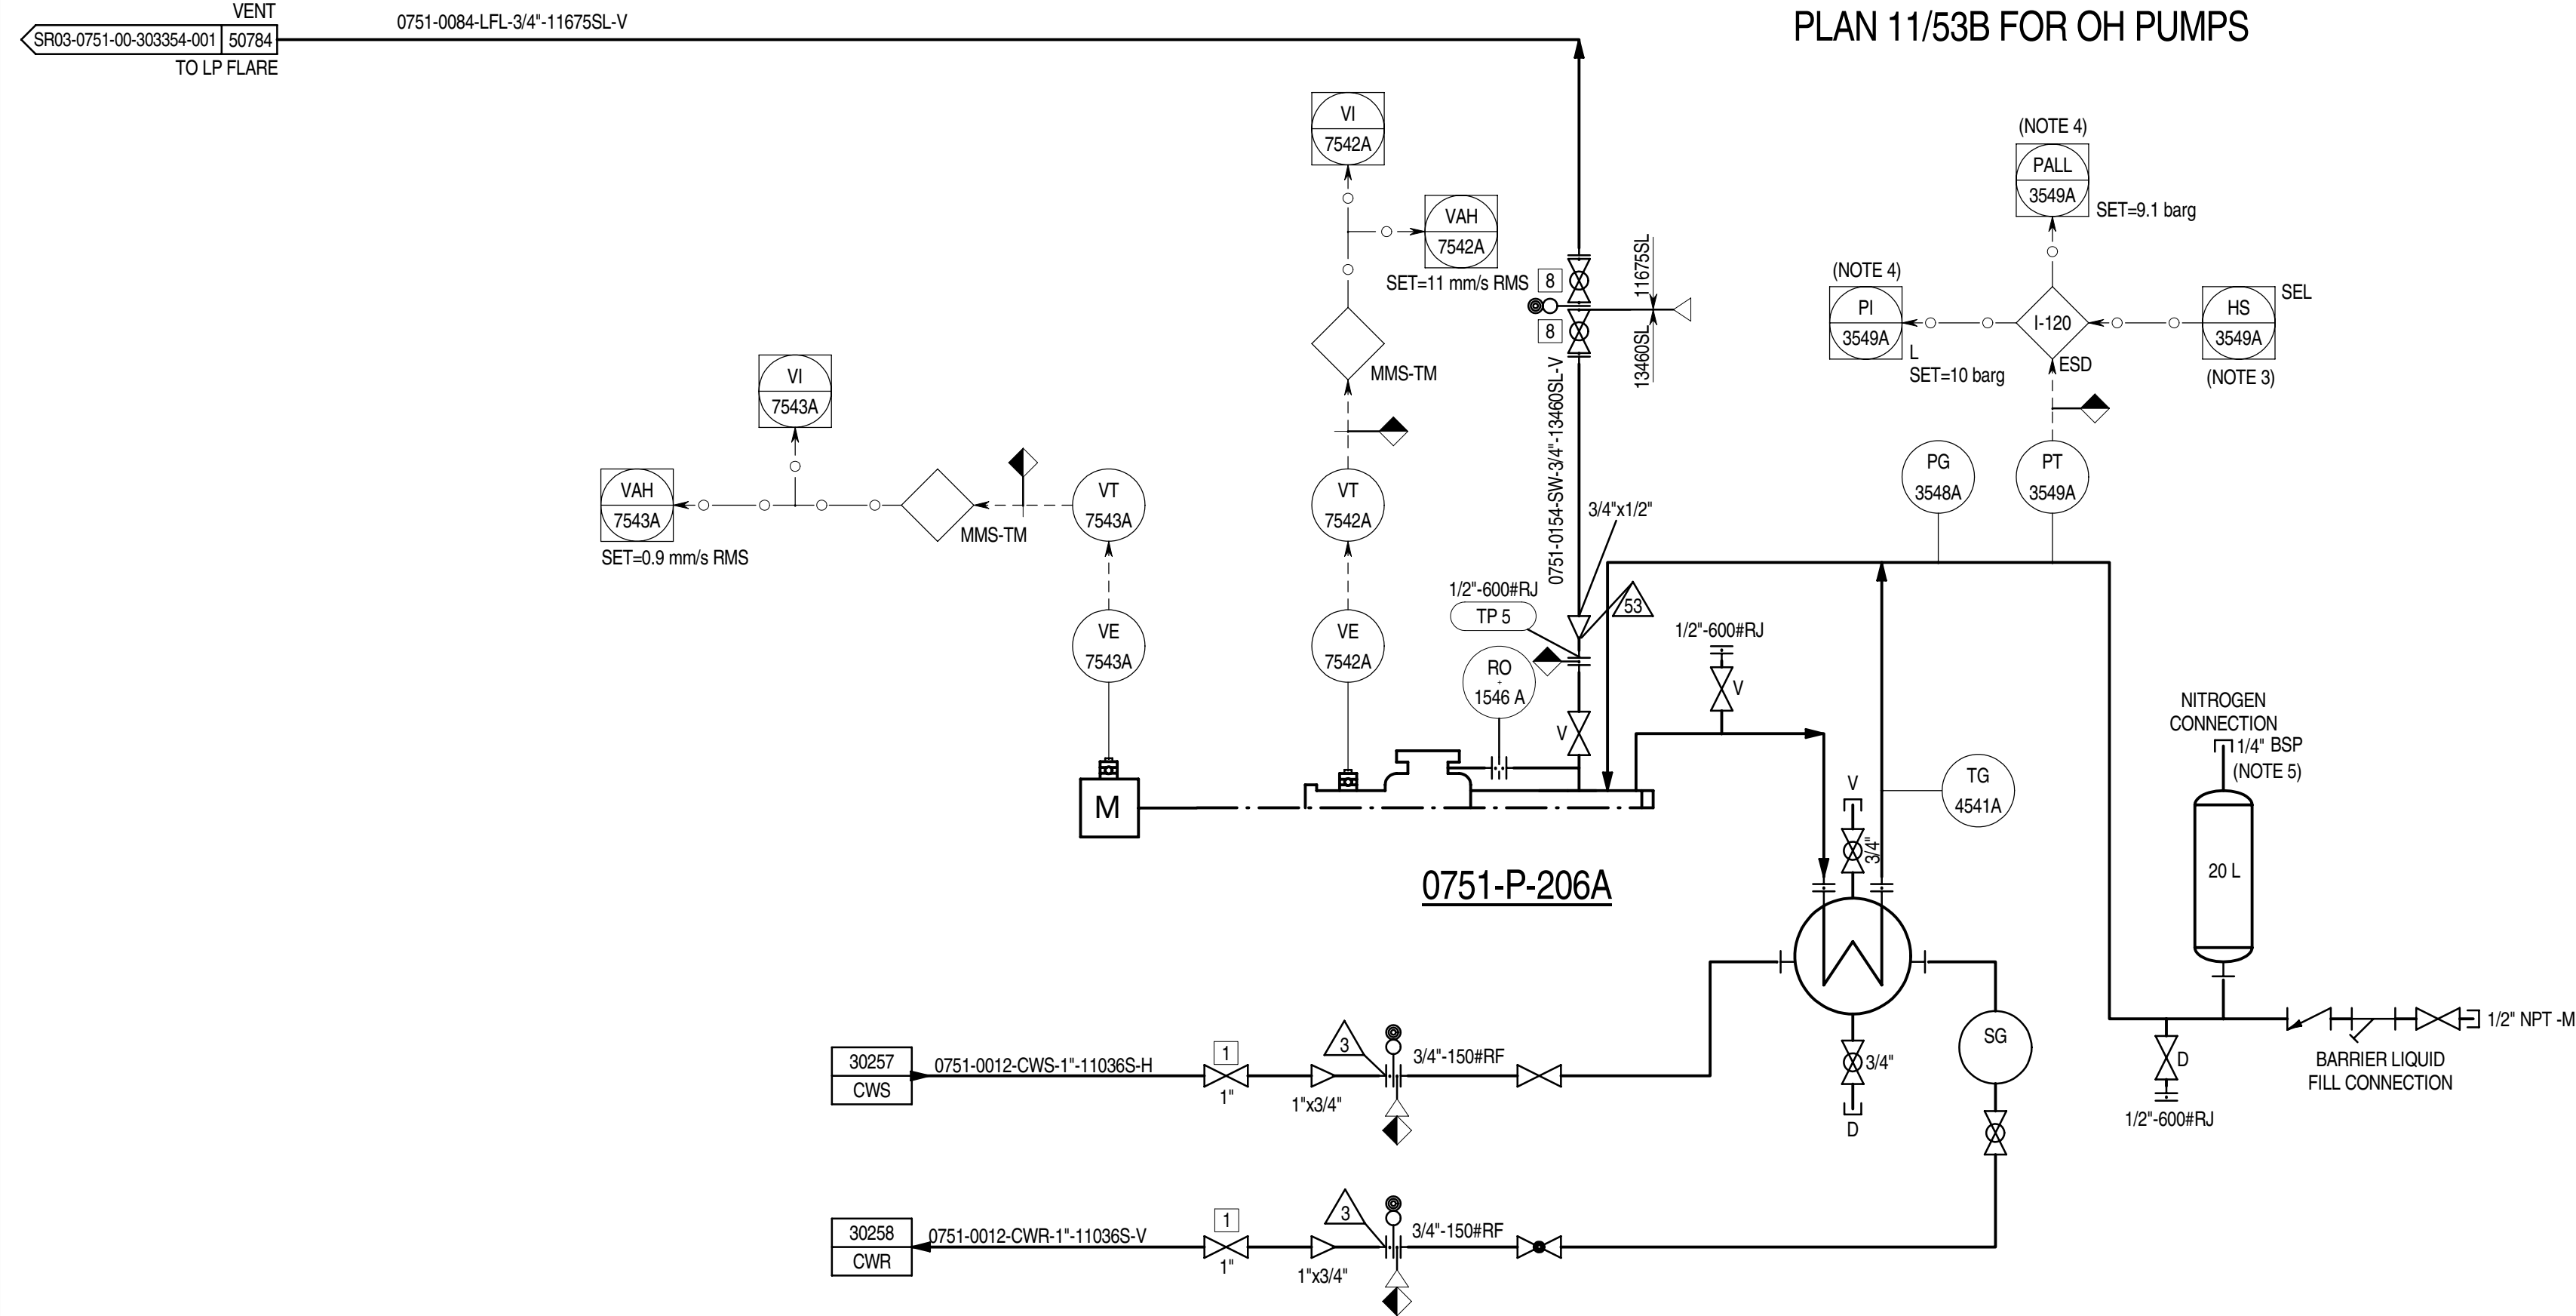

INTERLOCK TABLE (NOTE 1)		
INTERLOCK NUMBER	LOGIC DESCRIPTION (NOTE 2)	REFERENCE DOCUMENT N.
I-120	REGENERATOR	SR03-0751-00-303375

- GENERAL NOTES:**
- FOR STANDARD SYMBOLS, DETAILS, ABBREVIATIONS, SAMPLE CONNECTION TYPE, GENERAL NOTES & LEGEND SHEETS REFER TO DRAWING NO. MP02-0230-00-004000 TO 004015.
 - ALL INSTRUMENT TAG NUMBERS ON THIS P&ID INCLUDING PACKAGE UNITS ARE PREFIXED WITH UNIT NUMBER 0751 UNLESS OTHERWISE NOTED.
 - DELETED.
- NOTES:**
- INTERLOCK TABLE IS FOR REFERENCE ONLY. CAUSE AND EFFECT CHART M902-0751-00-CCC-303155.
 - REFER TO CAUSE AND EFFECT CHART FOR FULL REPRESENTATION OF INTERLOCK INITIATORS AND ACTIONS.
 - SELECTOR TO ACTIVATE EITHER ALARM ONLY OR ALARM AND TRIP.
 - ALARM AND TRIP VALUES BY PUMP VENDOR.
 - BSP= BRITISH STANDARD PIPE.

UTILITY REFERENCE TABLE		
CWR/CWS	DRW. N°.	SR03-0751-00-PID-362308

Z1	04-11-14	IAB	ISSUED FOR AS BUILT	PCA	MAR	ASP
2.1F	18-04-14	IFC	ISSUED FOR CONSTRUCTION	PCA	MAR	ASP
2.1E	28-02-14	IFC	ISSUED FOR CONSTRUCTION	PCA	MAR	ASP
2.1D	05-05-13	IFC	ISSUED FOR CONSTRUCTION	RL	MS	AS
2.1C	31-10-12	IFC	ISSUED FOR CONSTRUCTION	RL	MF	MZ
2.1B	06-08-12	IFC	ISSUED FOR CONSTRUCTION	DSC	CBR	SIN
2	29-12-11	IFC	ISSUED FOR CONSTRUCTION	DSC	CBR	SIN
1	12-08-11	IFCH	ISSUED FOR CONSTRUCTION WITH HOLDS	DSC	CBR	SIN
REV	DATE	STATUS	STATUS DESCRIPTION	BY	CKD	APP.

COMPANY:

Abu Dhabi Gas Development Co. Ltd.

CONTRACTOR:


JOB No. 032090

PROJECT: SHAH GAS DEVELOPMENT (SGD) PROJECT

AGREEMENT No. 13525001

DRAWING TITLE: PIPING & INSTRUMENT DIAGRAM UNIT 0751 SULPHUR RECOVERY AND TAIL GAS TREATING UNIT	
EQUIPMENT DESCRIPTION	API PLAN 0751-P-206A/B AND VIBRATION MONITORING
TAGITEM No.	


CONTRACTOR DRG.No.	751-GD-B-303354	REV. Z1
COMPANY DRG.No.	SR03-0751-00-303354-002	
SCALE:	SIZE: A1	
		DOC. CLASS: 1

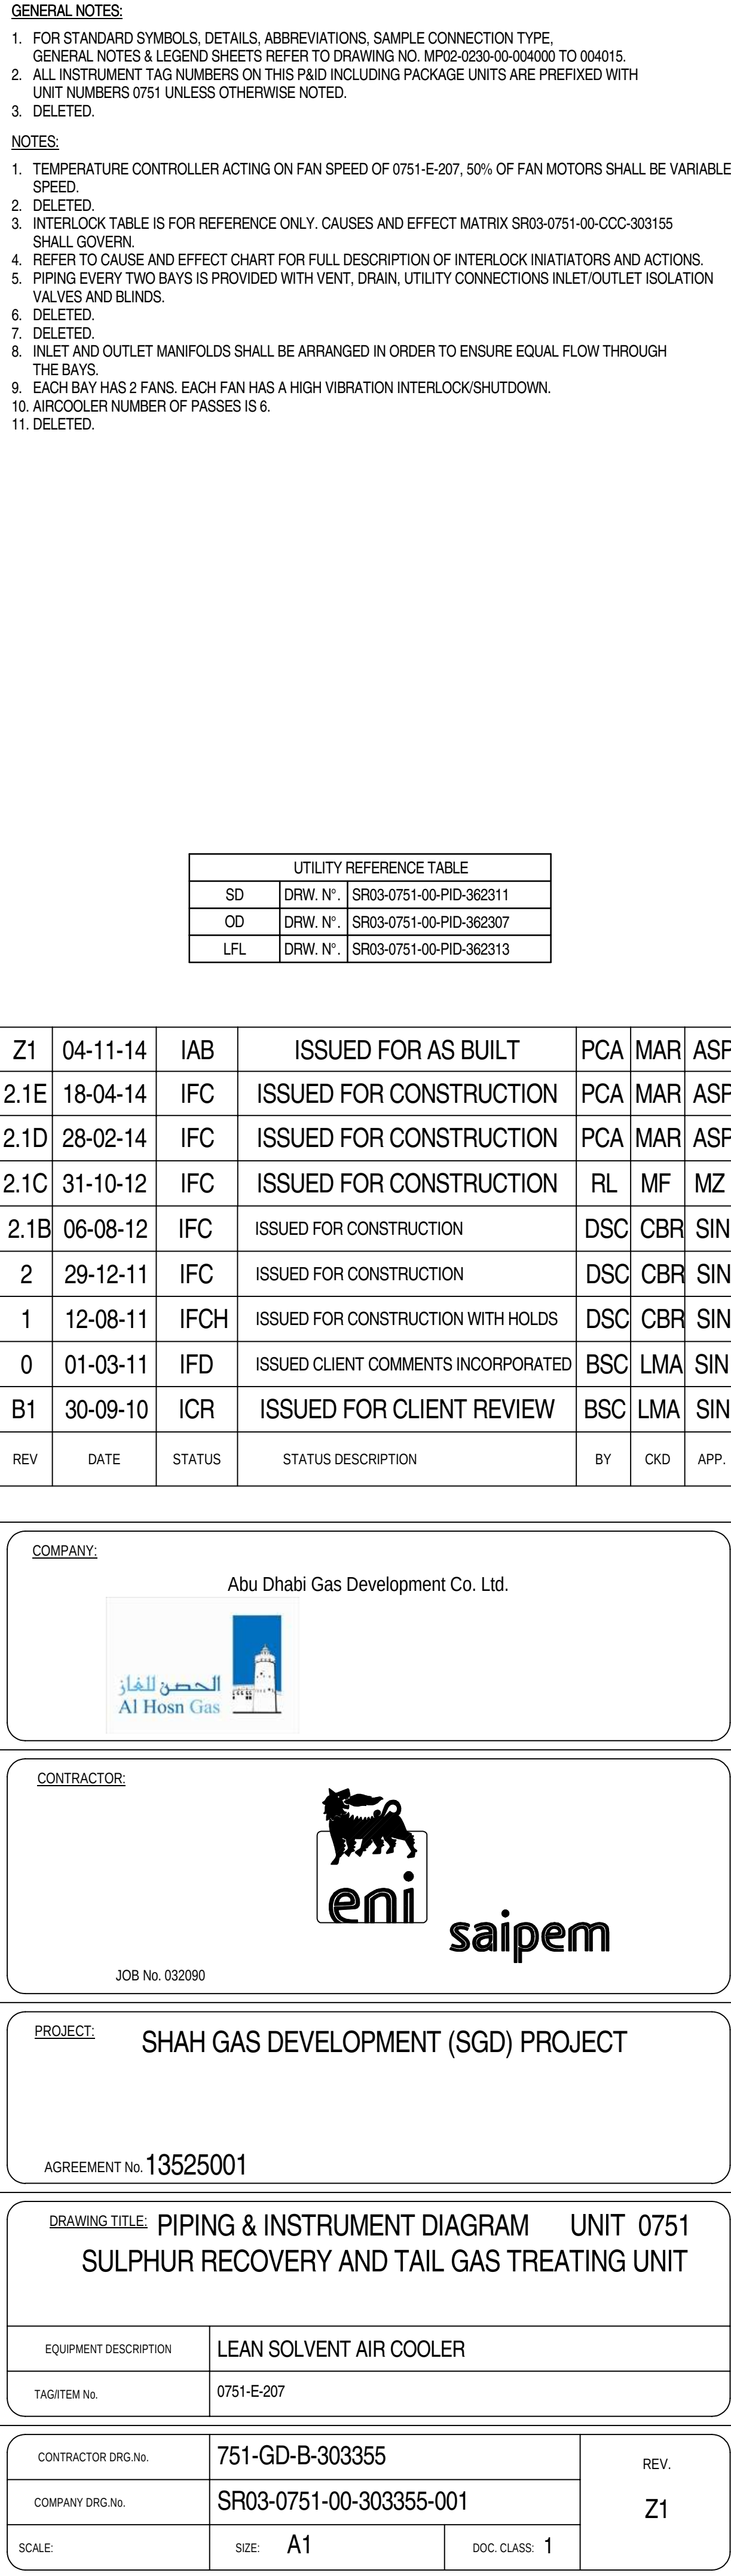

THIS DOCUMENT IS THE PROPERTY OF ABU DHABI GAS DEVELOPMENT COMPANY LIMITED AND CONTAINS INFORMATION WHICH IS PROPRIETARY. THIS INFORMATION IS TO BE HELD IN CONFIDENCE. NO DISCLOSURE OR OTHER USE OF THIS DOCUMENT IS TO BE MADE WITHOUT THE PRIOR WRITTEN CONSENT OF ABU DHABI GAS DEVELOPMENT COMPANY LIMITED.

0751-TK-201 LEAN SOLVENT TANK

TYPE: FIXED ROOF
DESIGN CONDITIONS: 0.015 barg @ 5 / 86 C & -0.006 barg
OPER CONDITIONS: ATM @ 56 C
ID: 12200 mm
HEIGHT: 10980 mm
CAPACITY: 776.9 m³ (WORKING)
MATERIAL: CS&6mm CA
TRIM: VT-0043-11059S-V
VT-0123-31059S-V

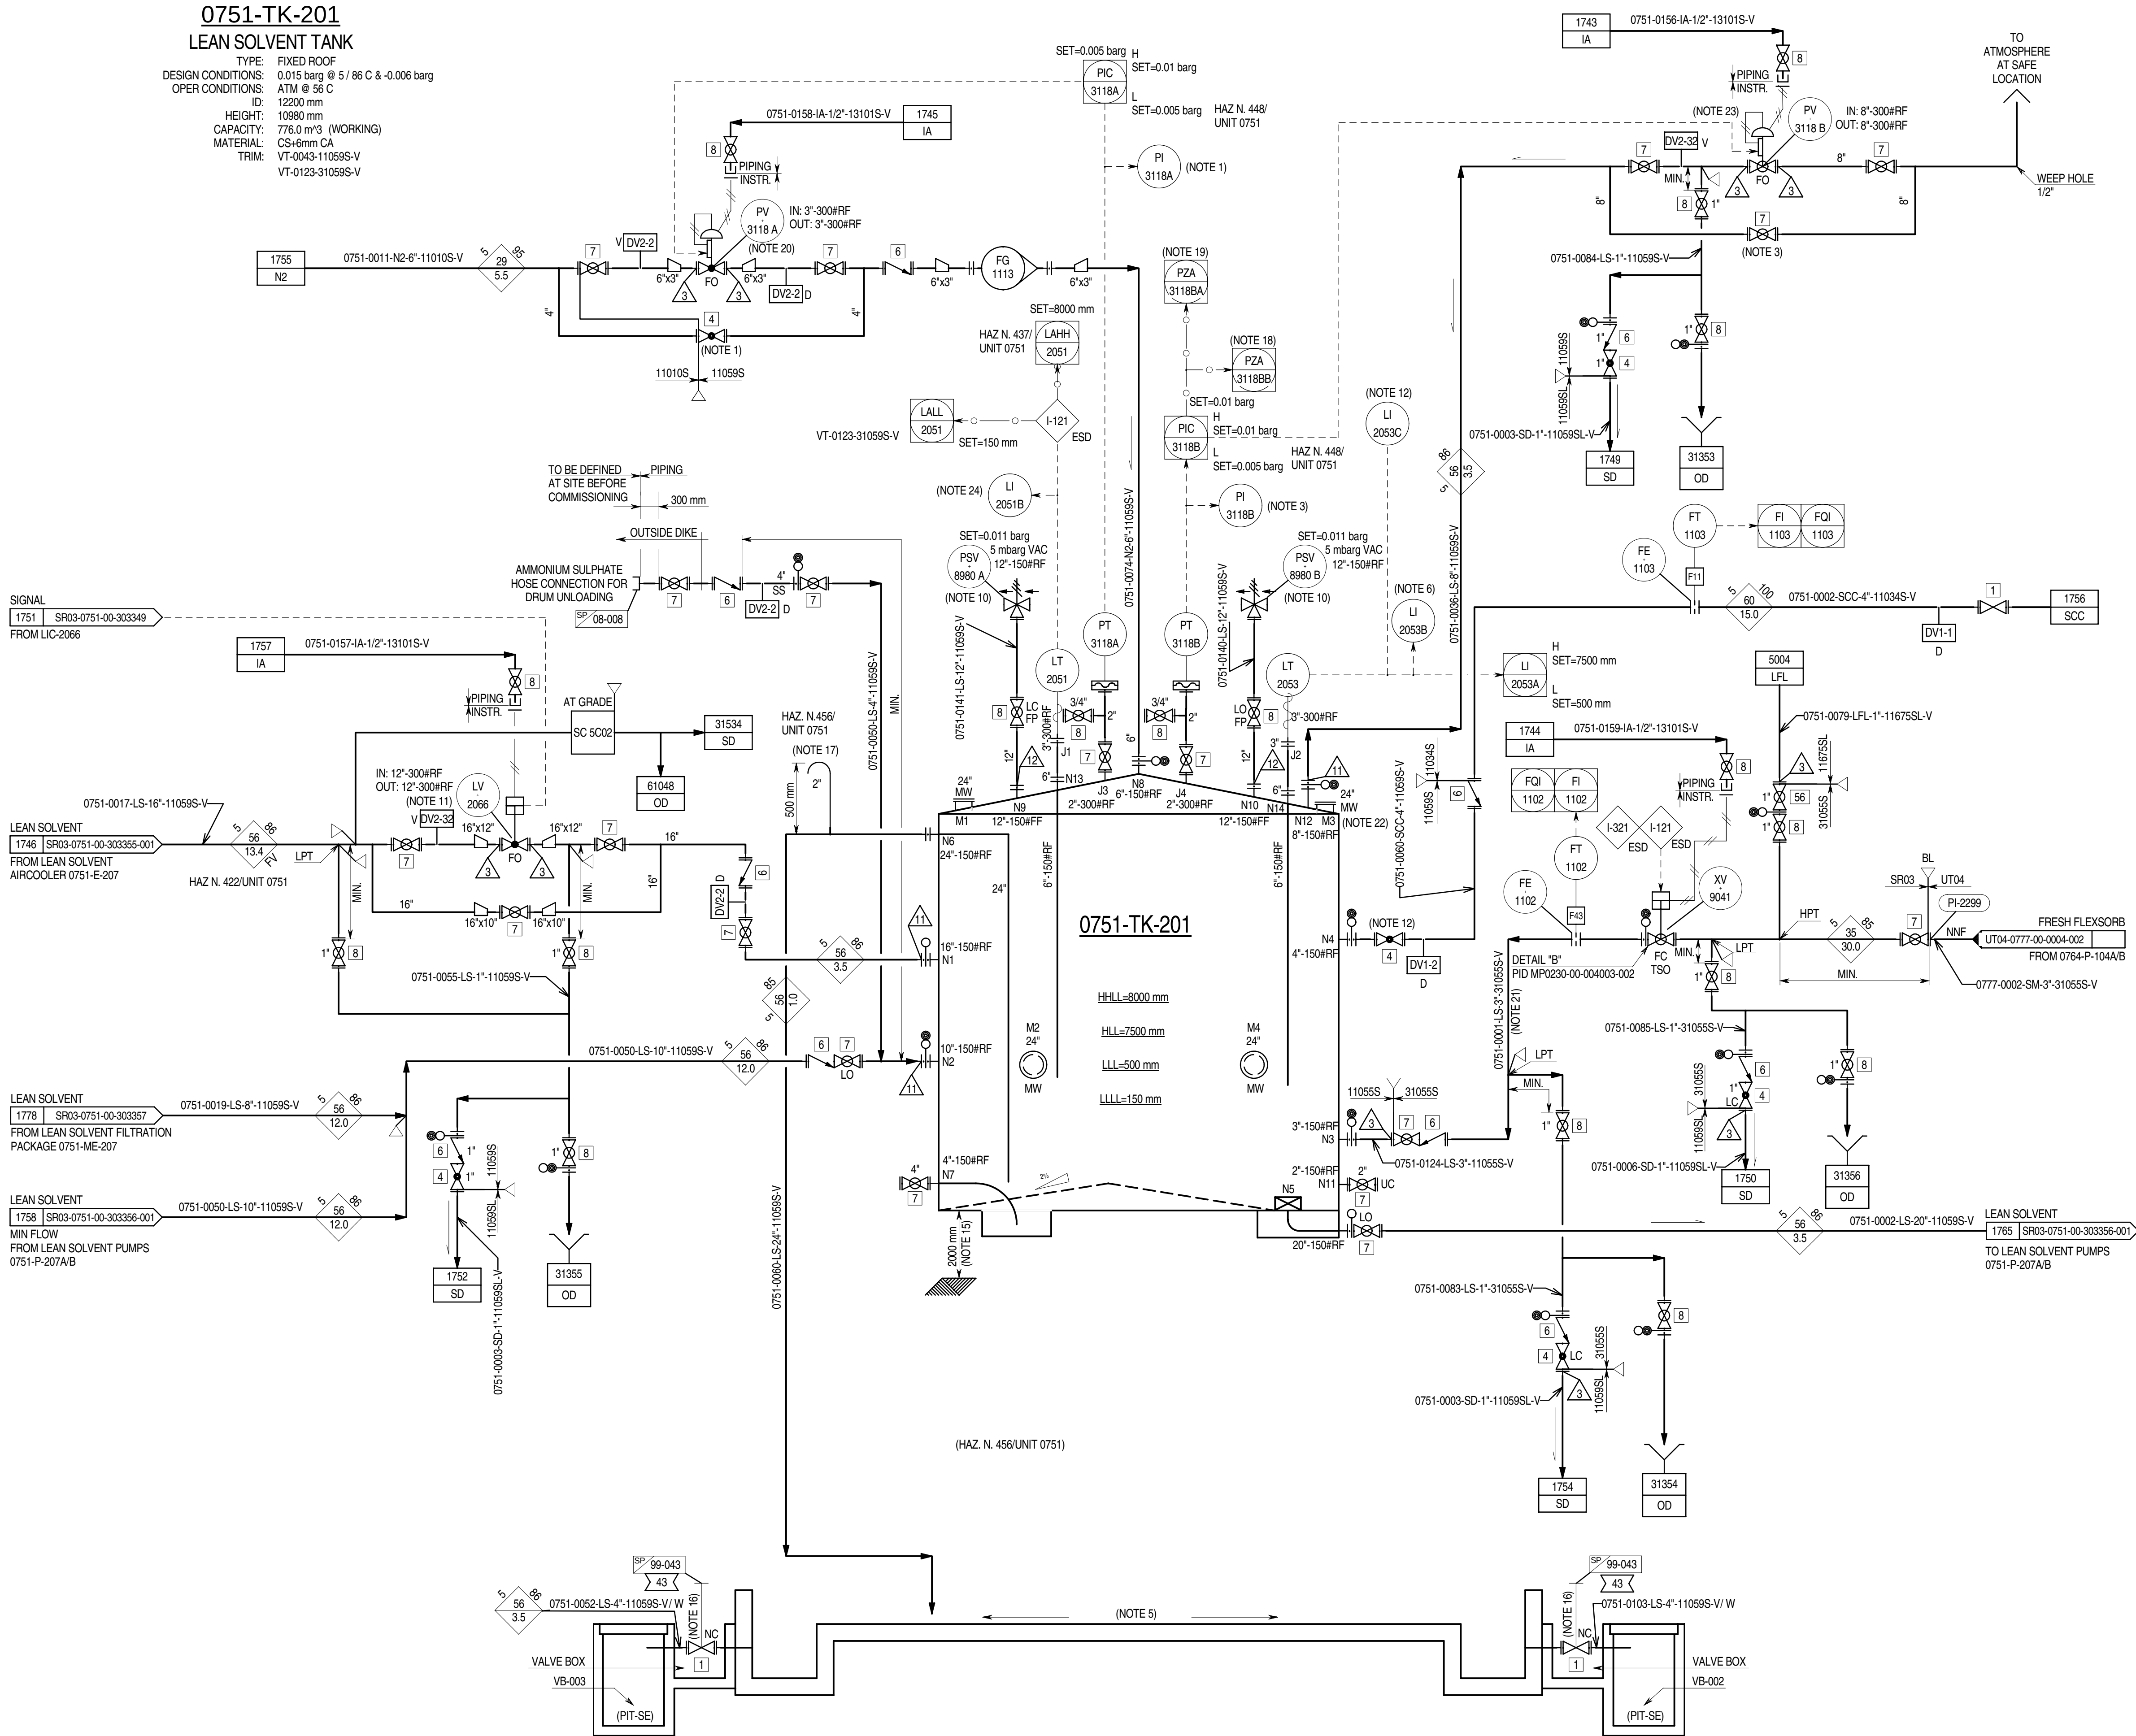

GENERAL NOTES:

- FOR STANDARD SYMBOLS, DETAILS, ABBREVIATIONS, SAMPLE CONNECTION TYPE, GENERAL NOTES & LEGEND SHEETS REFER TO DRAWING NO. MP02-0230-00-004000 TO 004015.
 - ALL INSTRUMENT TAG NUMBERS ON THIS P&ID INCLUDING PACKAGE UNITS ARE PREFIXED WITH UNIT NUMBERS 0751 UNLESS OTHERWISE NOTED.
 - DELETED.
- ### NOTES:
- PI-3118A TO BE READABLE FROM PV-3118A BYPASS VALVE.
 - DELETED.
 - PI-3118B TO BE READABLE FROM PV-3118B BYPASS VALVE.
 - DELETED.
 - TANK CONTAINMENT REQUIRED.
 - LI-2053B TO BE VISIBLE FROM 0751-P-207 PUMP LOCAL CONTROL STATION (ON DWG. SR03-0751-00-303356).
 - DELETED.
 - INTERLOCK TABLE IS FOR REFERENCE ONLY. CAUSE AND EFFECT MATRIX SR03-0751-00-CCC-303155 SHALL GOVERN.
 - DELETED.
 - PSV-8980A/B SUPPLIED BY TANK VENDOR.
 - LV-2066 PROVIDED WITH AIR VOLUME TANK ONLY FOR STROKE FAIL POSITION.
 - LI-2053C TO BE READABLE FROM GLOBE VALVE ON SCC LINE (HAZ N. 444/UNIT 0751).
 - DELETED.
 - REFER TO CAUSE AND EFFECT FOR FULL REPRESENTATION OF INTERLOCK INITIATORS AND ACTIONS.
 - VESSEL FOUNDATION SHALL PROVIDE 2000 mm ABOVE GROUND LEVEL.
 - VALVE TO BE OPERABLE FROM GRADE.
 - SIPHON BREAKER TO BE LOCATED ON THE ELBOW.
 - PROVIDE ALARM IN DCS WHEN VALVE POSITIONER INDICATES THAT PV-3118B IS NOT FULLY CLOSED.
 - PROVIDE ALARM IN DCS FOR NON ZERO OUTPUT FROM CONTROLLER.
 - VALVE PV-3118A TO BE PROVIDED WITH LOCAL SIGN: "WARNING: TRIM AFFECTS RELIEF VALVE CAPACITY".
 - FLANGE PROTECTORS SHALL BE PROVIDED ON FRESH FLEXSORB LINE FORM B.L. UP TO NOZZLE N3.
 - NOZZLE M3 PROVIDED WITH EMERGENCY RELIEF MANHOLE COVER. SET PRESSURE 12.5 mbarg.
 - VALVE PV-3118B IS EQUIPPED WITH MECHANICAL STOP.
 - LI-2051B TO BE READABLE FROM GRADE OR PLATFORM

UTILITY REFERENCE TABLE		
IA	DRW. N°:	SR03-0751-00-PID-362305
SD	DRW. N°:	SR03-0751-00-PID-362311
OD	DRW. N°:	SR03-0751-00-PID-362307
N2	DRW. N°:	SR03-0751-00-PID-362310
SCC	DRW. N°:	SR03-0751-00-PID-362308

Z1	04-11-14	IAB	ISSUED FOR AS BUILT	PCA	MAR	ASP
2.1E	18-04-14	IFC	ISSUED FOR CONSTRUCTION	PCA	MAR	ASP
2.1D	28-02-14	IFC	ISSUED FOR CONSTRUCTION	PCA	MAR	ASP
2.1C	31-10-12	IFC	ISSUED FOR CONSTRUCTION	RL	MF	MZ
2.1B	06-08-12	IFC	ISSUED FOR CONSTRUCTION	DSC	CBR	SIN
2	29-12-11	IFC	ISSUED FOR CONSTRUCTION	DSC	CBR	SIN
1	12-08-11	IFCH	ISSUED FOR CONSTRUCTION WITH HOLDS	DSC	CBR	SIN
0	01-03-11	IFD	ISSUED CLIENT COMMENTS INCORPORATED	BSC	LMA	SIN
B1	30-09-10	ICR	ISSUED FOR CLIENT REVIEW	BSC	LMA	SIN
REV	DATE	STATUS	STATUS DESCRIPTION	BY	CKD	APP.

COMPANY:

Abu Dhabi Gas Development Co. Ltd.

CONTRACTOR:

JOB No. 032090

PROJECT: SHAH GAS DEVELOPMENT (SGD) PROJECT

AGREEMENT No. 13525001


DRAWING TITLE: PIPING & INSTRUMENT DIAGRAM UNIT 0751
SULPHUR RECOVERY AND TAIL GAS TREATING UNIT

EQUIPMENT DESCRIPTION	LEAN SOLVENT TANK
TAGITEM No.	0751-TK-201

CONTRACTOR DRG. No.	751-GD-B-303355	REV. Z1
COMPANY DRG. No.	SR03-0751-00-303355-002	
SCALE:	SIZE: A1	DOC. CLASS: 1

INTERLOCK TABLE (NOTE 8, 14)		
INTERLOCK NUMBER	LOGIC DESCRIPTION	REFERENCE DOCUMENT N.
I-321	SULPHUR RECOVERY UNIT	SR03-0751-00-303375
I-121	LEAN SOLVENT TANK	SR03-0751-00-303375

THIS DOCUMENT IS THE PROPERTY OF ABU DHABI GAS DEVELOPMENT COMPANY LIMITED AND CONTAINS INFORMATION WHICH IS PROPRIETARY. THIS INFORMATION IS TO BE HELD IN CONFIDENCE. NO DISCLOSURE OR OTHER USE OF THIS DOCUMENT IS TO BE MADE WITHOUT THE PRIOR WRITTEN CONSENT OF ABU DHABI GAS DEVELOPMENT COMPANY LIMITED.

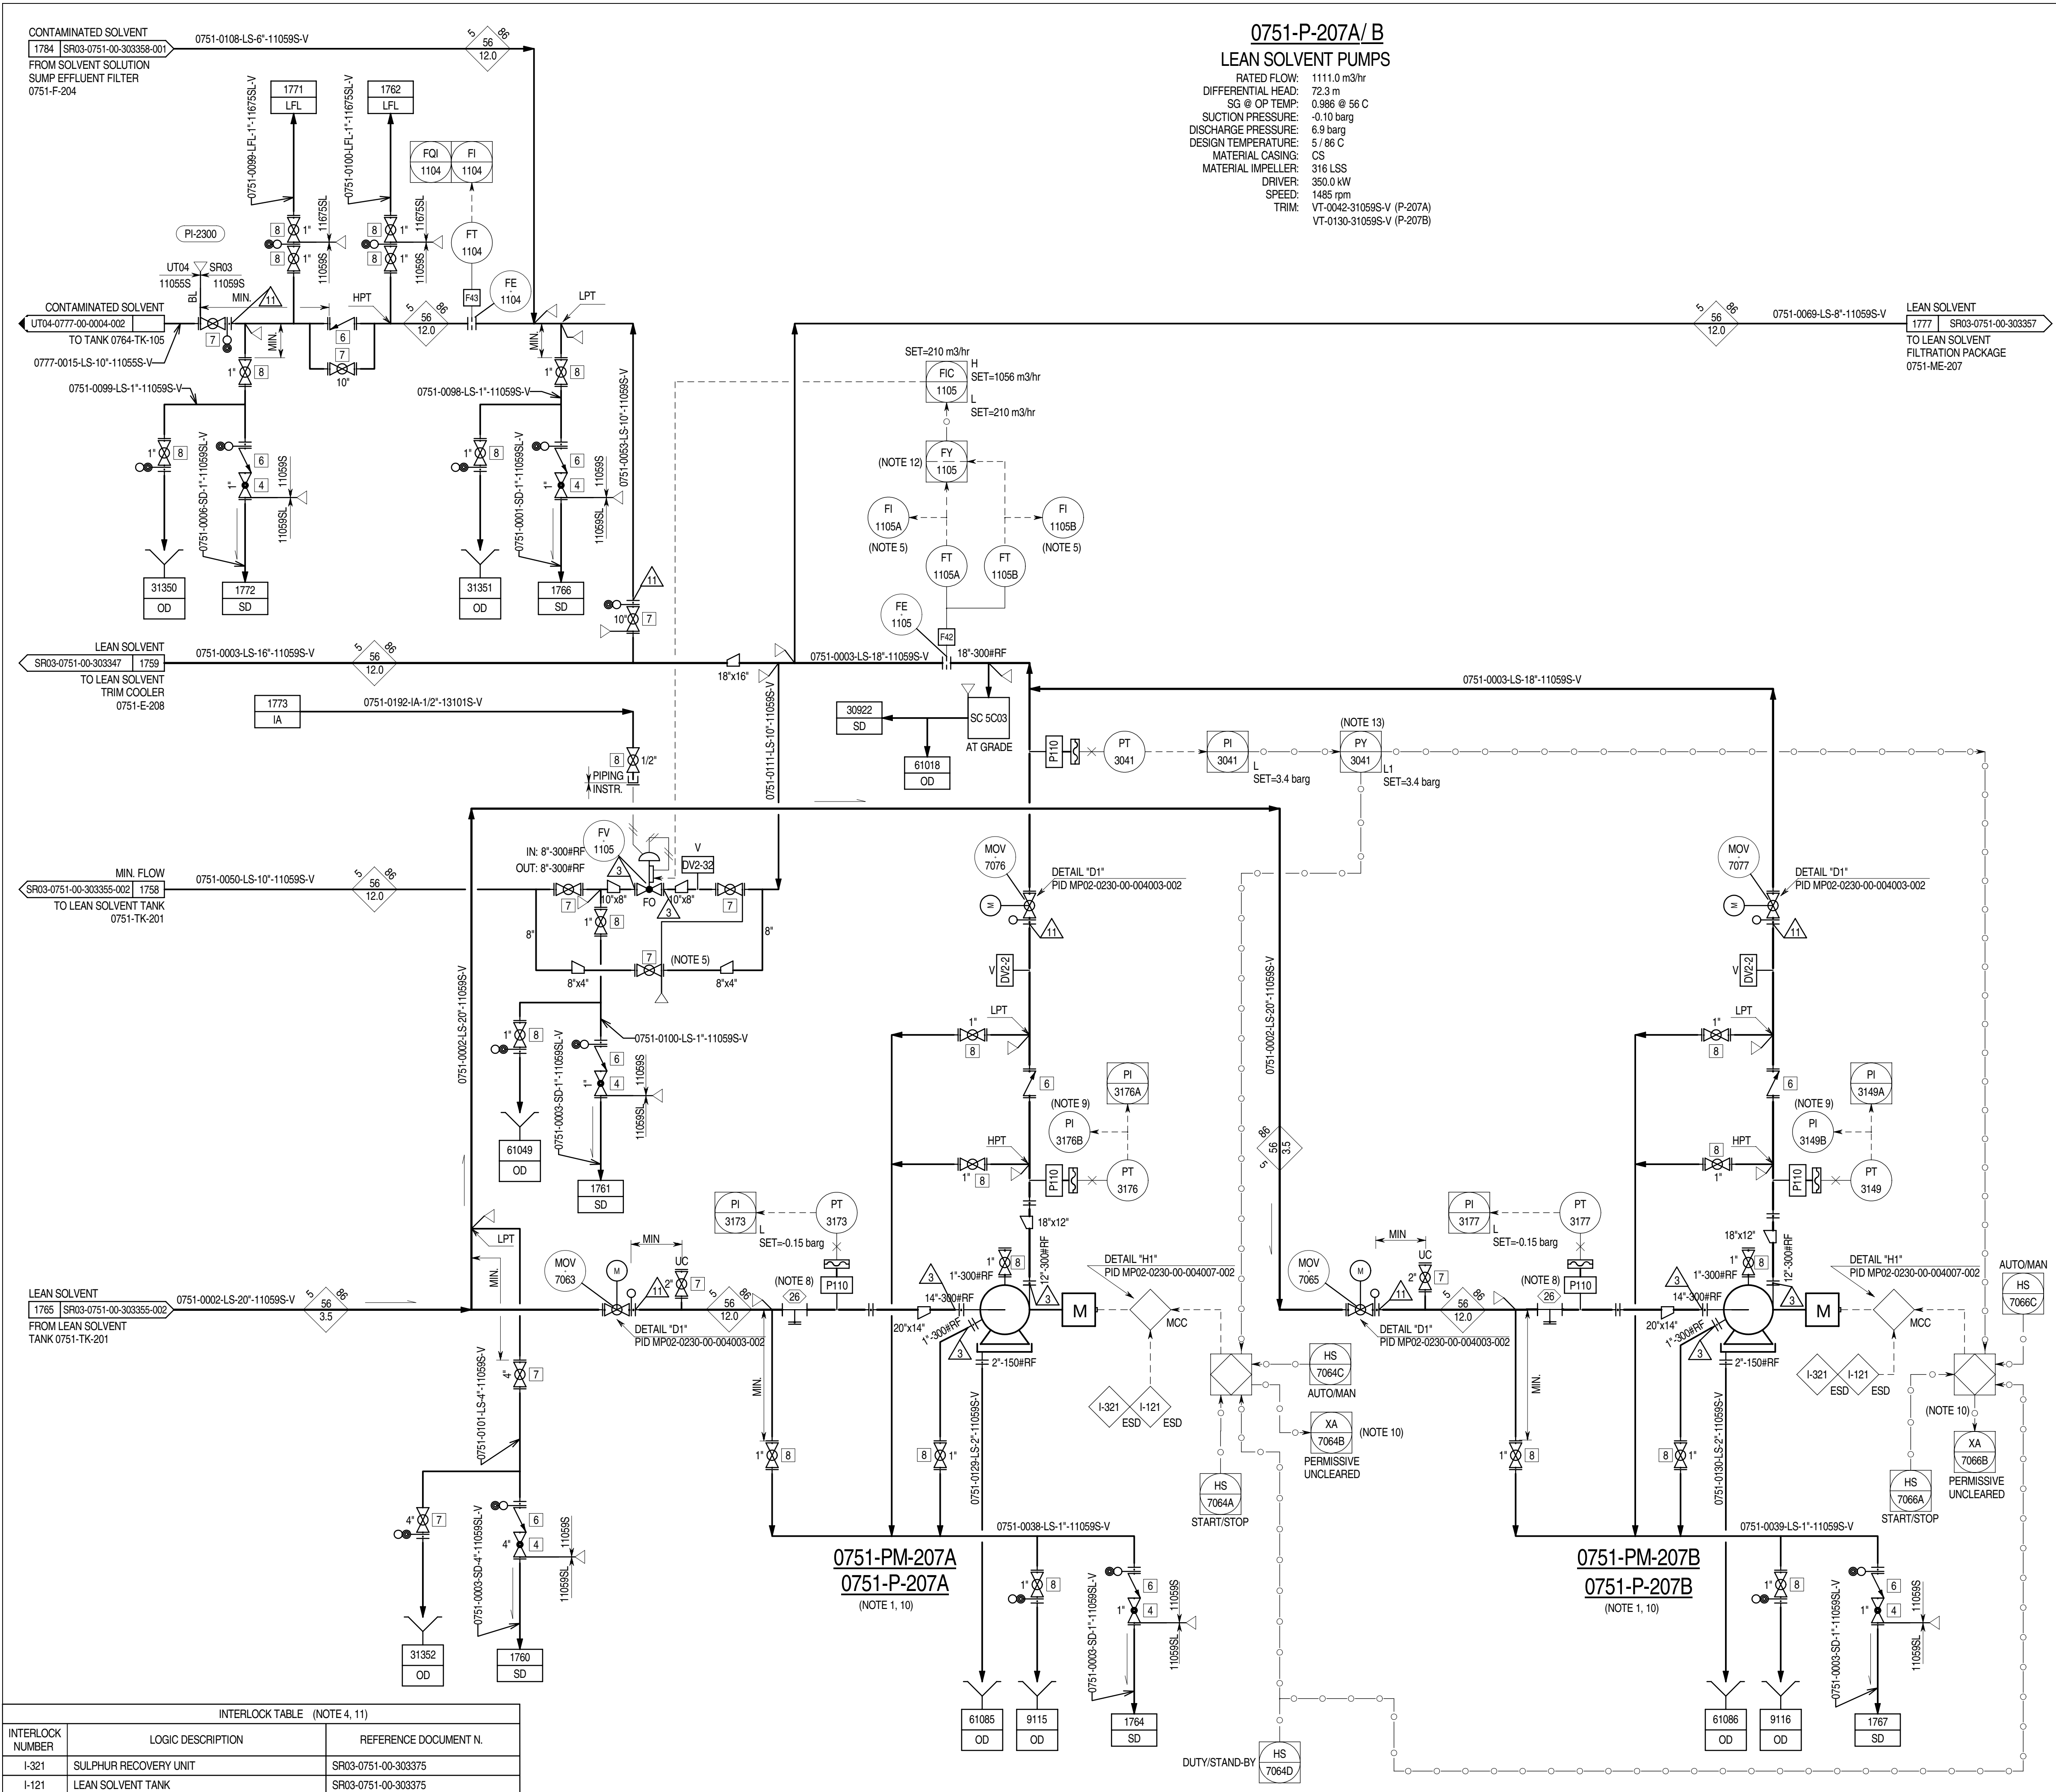

GENERAL NOTES:

1. FOR STANDARD SYMBOLS, DETAILS, ABBREVIATIONS, SAMPLE CONNECTION TYPE, GENERAL NOTES & LEGEND SHEETS REFER TO DRAWING NO. MP02-0230-00-004000 TO 004015.

2. ALL INSTRUMENT TAG NUMBERS ON THIS P&ID INCLUDING PACKAGE UNITS ARE PREFIXED WITH UNIT NUMBERS 0751 UNLESS OTHERWISE NOTED.

3. DELETED.

NOTES:

1. PUMPS ARE 2X100%: 1 OPERATING AND 1 STAND BY.

2. DELETED.

3. AUTOSTART OF STAND BY PUMP FOR LOW PRESSURE.

4. INTERLOCK THIS TABLE IS FOR REFERENCE ONLY. CAUSE AND EFFECT MATRIX SR03-0751-00-CCC-303155 SHALL GOVERN.

5. FI-1105A AND FI-1105B TO BE READABLE FROM FV-1105 BYPASS VALVE.

6. DELETED.

7. DELETED.

8. TEMPORARY STRAINER WITH SCREEN 60 MESH. PERMANENT STRAINER 4 MESH.

9. PI-3149B AND PI-3176B TO BE READABLE FROM CORRESPONDING DISCHARGE ISOLATION VALVE.

10. REFER TO PROCESS CONTROL NARRATIVE DOC. N. SR03-0751-15-SPE-303163 FOR PERMISSIVE TO START CONDITIONS.

11. REFER TO CAUSE AND EFFECT CHART FOR FULL REPRESENTATION OF INTERLOCK INITIATORS AND ACTION.

12. N 2 TRANSMITTERS SHALL BE PROVIDED TO COVER THE COMPLETE REQUEST INSTRUMENT RANGEABILITY: TRANSMITTER "A" ----> LOW RANGE
TRANSMITTER "B" ----> HIGH RANGE

13. IF THE PAL-3041 IS NOT CLEARED AFTER TIME DELAY THE LOGIC SHALL STOP BOTH P-207A/B (FEED HAZ.N°354/UNIT 0751).

UTILITY REFERENCE TABLE

IA

DRW. N°

SR03-0751-00-PID-362305

OD

DRW. N°

SR03-0751-00-PID-362307

SD

DRW. N°

SR03-0751-00-PID-362311

LFL

DRW. N°

SR03-0751-00-PID-362313

Z1

04-11-14

IAB

ISSUED FOR AS BUILT

PCA

MAR

AS

2.1E

18-04-14

IFC

ISSUED FOR CONSTRUCTION

PCA

MAR

AS

2.1D

28-02-14

IFC

ISSUED FOR CONSTRUCTION

PCA

MAR

AS

2.1C

31-10-12

IFC

ISSUED FOR CONSTRUCTION

RL

MF

MA

2.1B

06-08-12

IFC

ISSUED FOR CONSTRUCTION

DSC

CBR

SI

2

29-12-11

IFC

ISSUED FOR CONSTRUCTION

DSC

CBR

SI

1

12-08-11

IFCH

ISSUED FOR CONSTRUCTION WITH HOLDS

DSC

CBR

SI

0

01-03-11

IFD

ISSUED CLIENT COMMENTS INCORPORATED

BSC

LMA

SI

B1

30-09-10

ICR

ISSUED FOR CLIENT REVIEW

BSC

LMA

SI

REV

DATE

STATUS

STATUS DESCRIPTION

BY

CKD

AP

COMPANY:

Abu Dhabi Gas Development Co. Ltd.

الحصن للغاز

Al Hosn Gas

CONTRACTOR:

eni

saipem

JOB No. 032090

PROJECT:

SHAH GAS DEVELOPMENT (SGD) PROJECT

AGREEMENT No. 13525001

DRAWING TITLE:

PIPING & INSTRUMENT DIAGRAM UNIT 0751

SULPHUR RECOVERY AND TAIL GAS TREATING UNIT

EQUIPMENT DESCRIPTION

LEAN SOLVENT PUMPS

TAGITEM No.

0751-P-207A / B

CONTRACTOR DRG.No.

751-GD-B-303356

COMPANY DRG.No.

SR03-0751-00-303356-001

SCALE:

SIZE: A1


DOC. CLASS: 1

REV.


Z1

THIS DOCUMENT IS THE PROPERTY OF ABU DHABI GAS DEVELOPMENT COMPANY LIMITED AND CONTAINS INFORMATION WHICH IS PROPRIETARY. THIS INFORMATION IS TO BE HELD IN CONFIDENCE. NO DISCLOSURE OR OTHER USE OF THIS DOCUMENT IS TO BE MADE WITHOUT THE PRIOR WRITTEN CONSENT OF ABU DHABI GAS DEVELOPMENT COMPANY LIMITED.

PLAN 11/53B FOR BB PUMPS

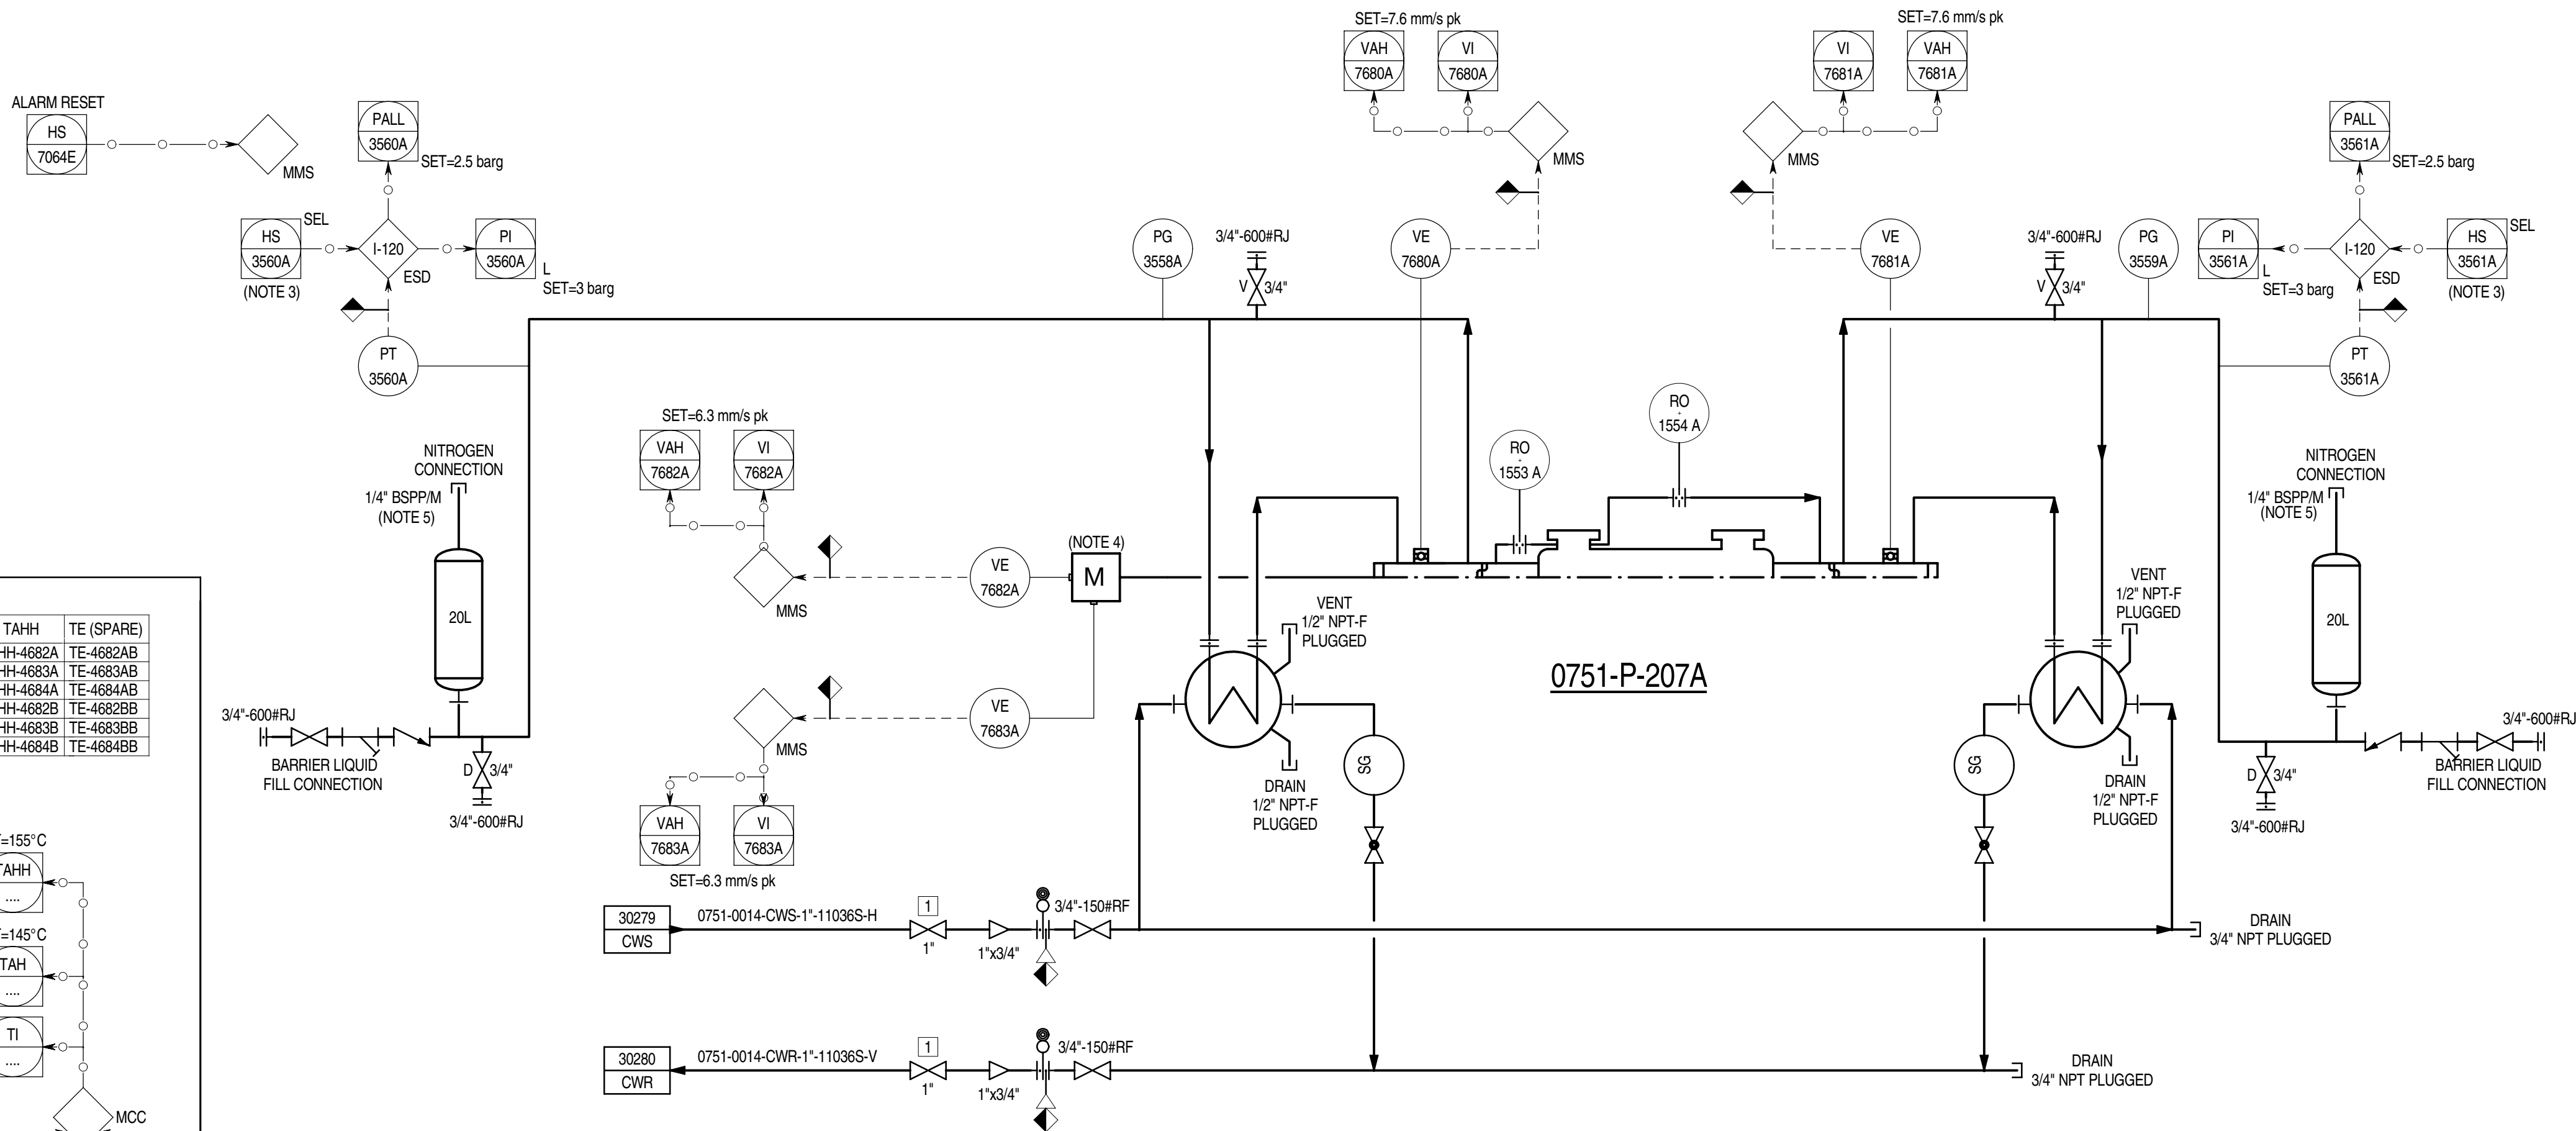

PLAN 11/53B FOR BB PUMPS

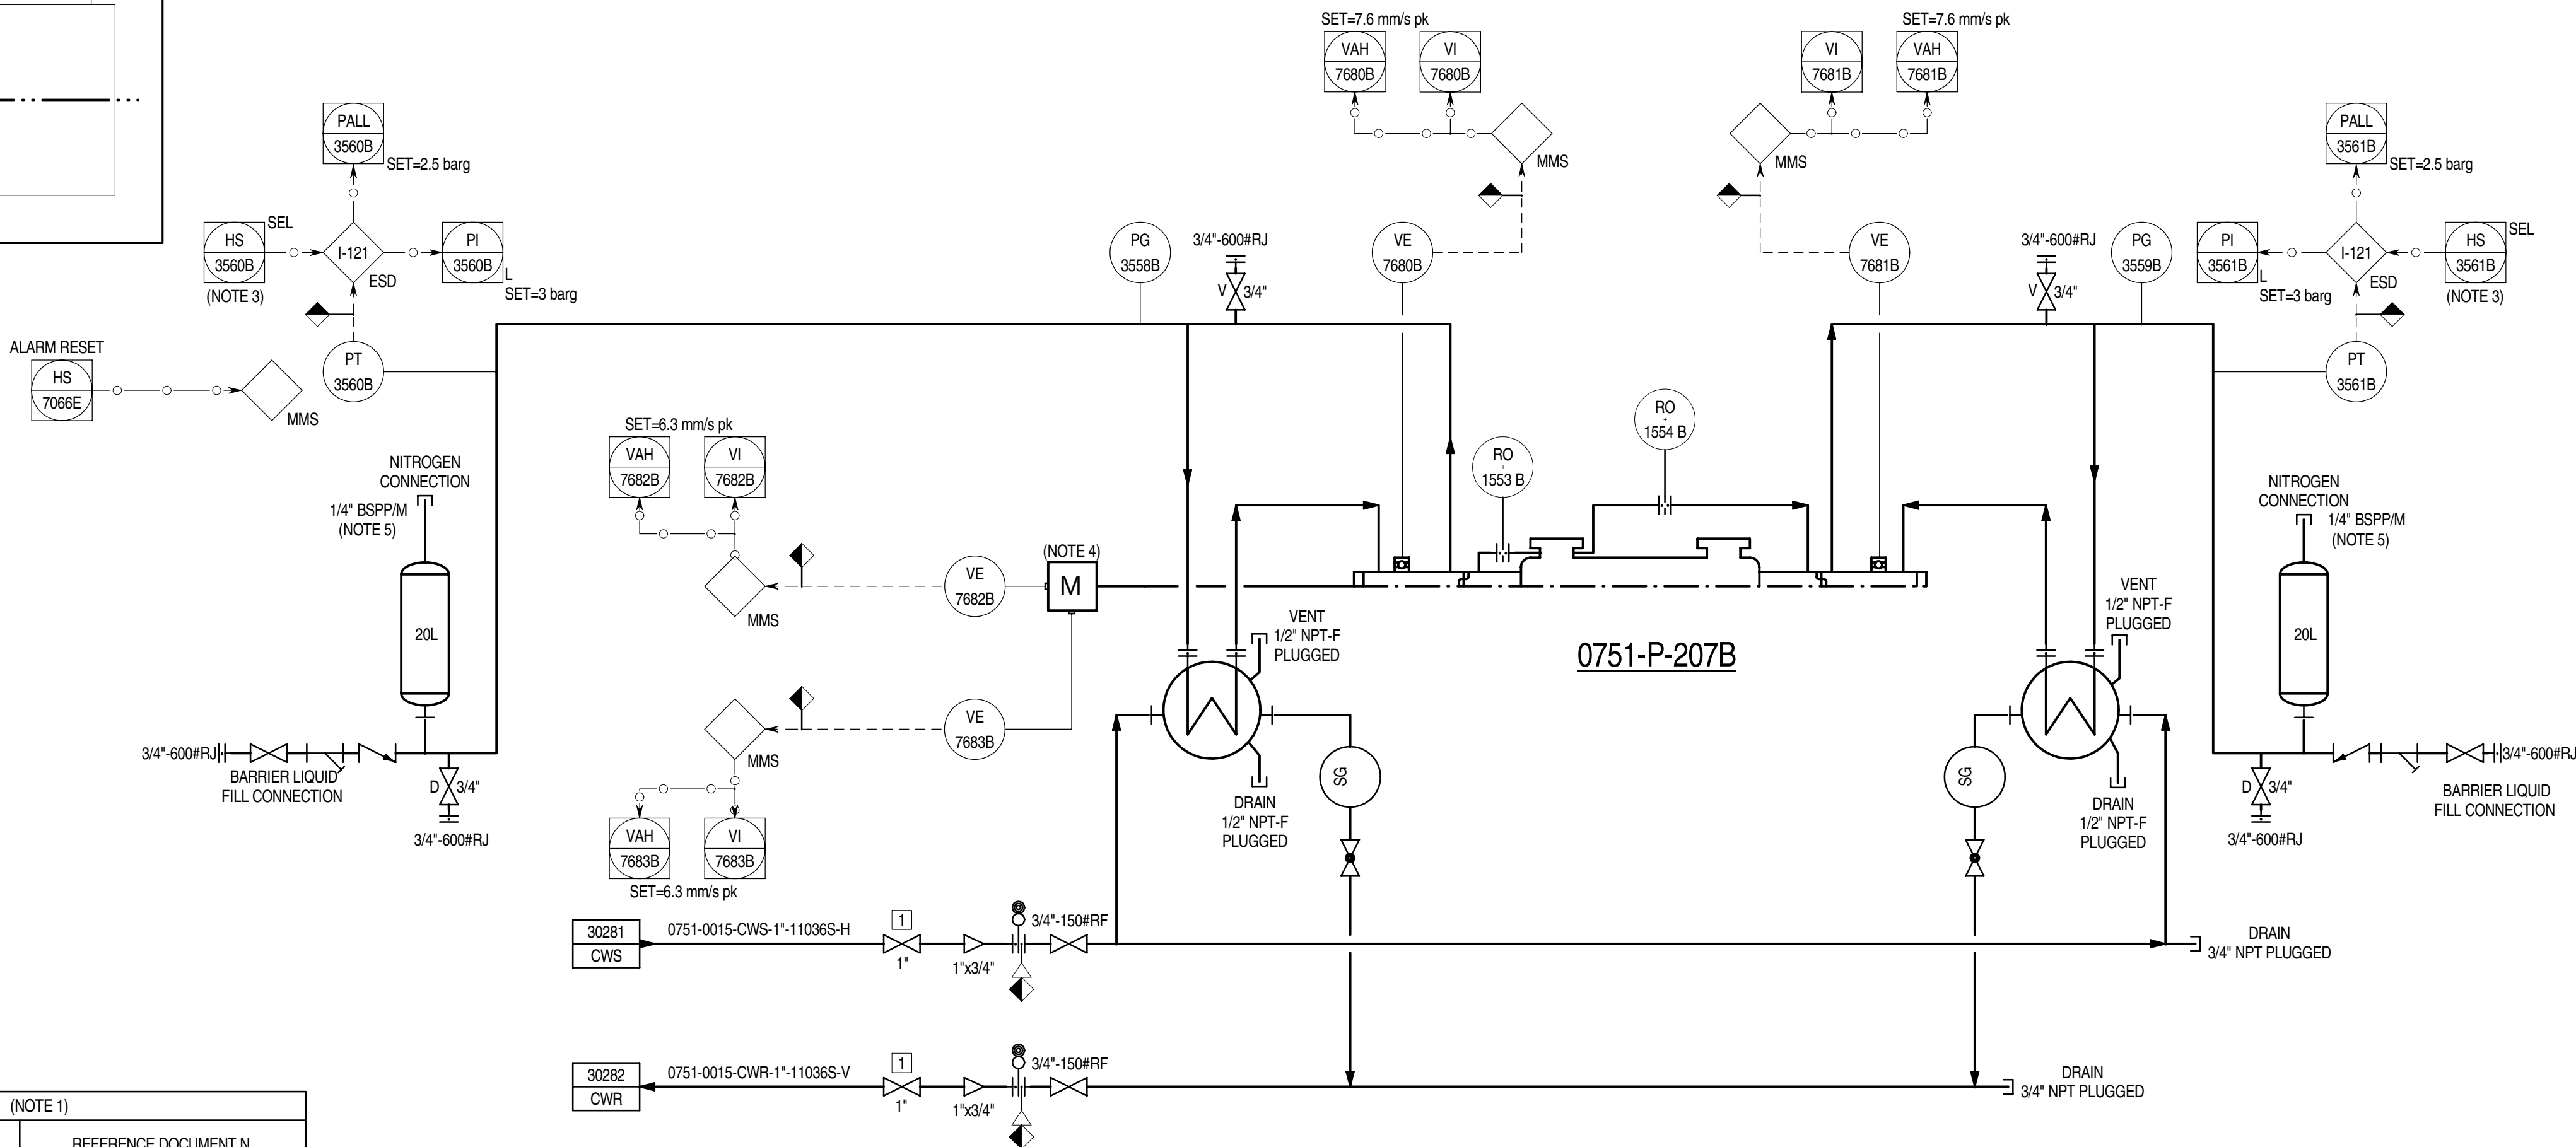

GENERAL NOTES:

- FOR STANDARD SYMBOLS, DETAILS, ABBREVIATIONS, SAMPLE CONNECTION TYPE, GENERAL NOTES & LEGEND SHEETS REFER TO DRAWING NO. MP02-0230-00-004000 TO 004015.
- ALL INSTRUMENT TAG NUMBERS ON THIS P&ID INCLUDING PACKAGE UNITS ARE PREFIXED WITH UNIT NUMBER 0751 UNLESS OTHERWISE NOTED.
- DELETED.

NOTES:

- INTERLOCK TABLE IS FOR REFERENCE ONLY. CAUSE AND EFFECT CHART MP02-0751-00-15-CCC-303155 SHALL GOVERN.
- REFER TO CAUSE AND EFFECT CHART FOR FULL REPRESENTATION OF INTERLOCK INITIATION AND ACTIONS.
- SELECTOR TO ACTIVATE EITHER ALARM ONLY OR ALARM AND TRIP.
- FOR DETAIL OF TEMPERATURE MEASUREMENTS ON ELECTRICAL MOTOR REFER TO DETAIL "A" AND TABLE 1.
- BSPPM = BRITISH STANDARD PARALLEL PIPE / MALE.

Z1	04-11-14	IAB	ISSUED FOR AS BUILT	PCA	MAR	ASP
2.1E	18-04-14	IFC	ISSUED FOR CONSTRUCTION	PCA	MAR	ASP
2.1D	28-02-14	IFC	ISSUED FOR CONSTRUCTION	PCA	MAR	ASP
2.1C	31-10-12	IFC	ISSUED FOR CONSTRUCTION	RL	MF	MZ
2.1B	06-08-12	IFC	ISSUED FOR CONSTRUCTION	DSC	CBR	SIN
2	29-12-11	IFC	ISSUED FOR CONSTRUCTION	DSC	CBR	SIN
1	08-08-11	IFCH	ISSUED FOR CONSTRUCTION WITH HOLDS	DSC	CBR	SIN
REV	DATE	STATUS	STATUS DESCRIPTION	BY	CKD	APP.

COMPANY:

Abu Dhabi Gas Development Co. Ltd.

الحصن للغاز
Al Hosn Gas

CONTRACTOR:

eni saipem

JOB No. 032090

PROJECT:


SHAH GAS DEVELOPMENT (SGD) PROJECT

AGREEMENT No. 13525001

DRAWING TITLE: PIPING & INSTRUMENT DIAGRAM UNIT 0751 SULPHUR RECOVERY AND TAIL GAS TREATING UNIT

EQUIPMENT DESCRIPTION	API PLAN 0751-P-207A/B AND VIBRATION MONITORING
TAGITEM No.	

CONTRACTOR DRG. No.	751-GD-B-303356	REV.
COMPANY DRG. No.	SR03-0751-00-303356-002	Z1
SCALE:	SIZE: A1	DOC. CLASS: 1

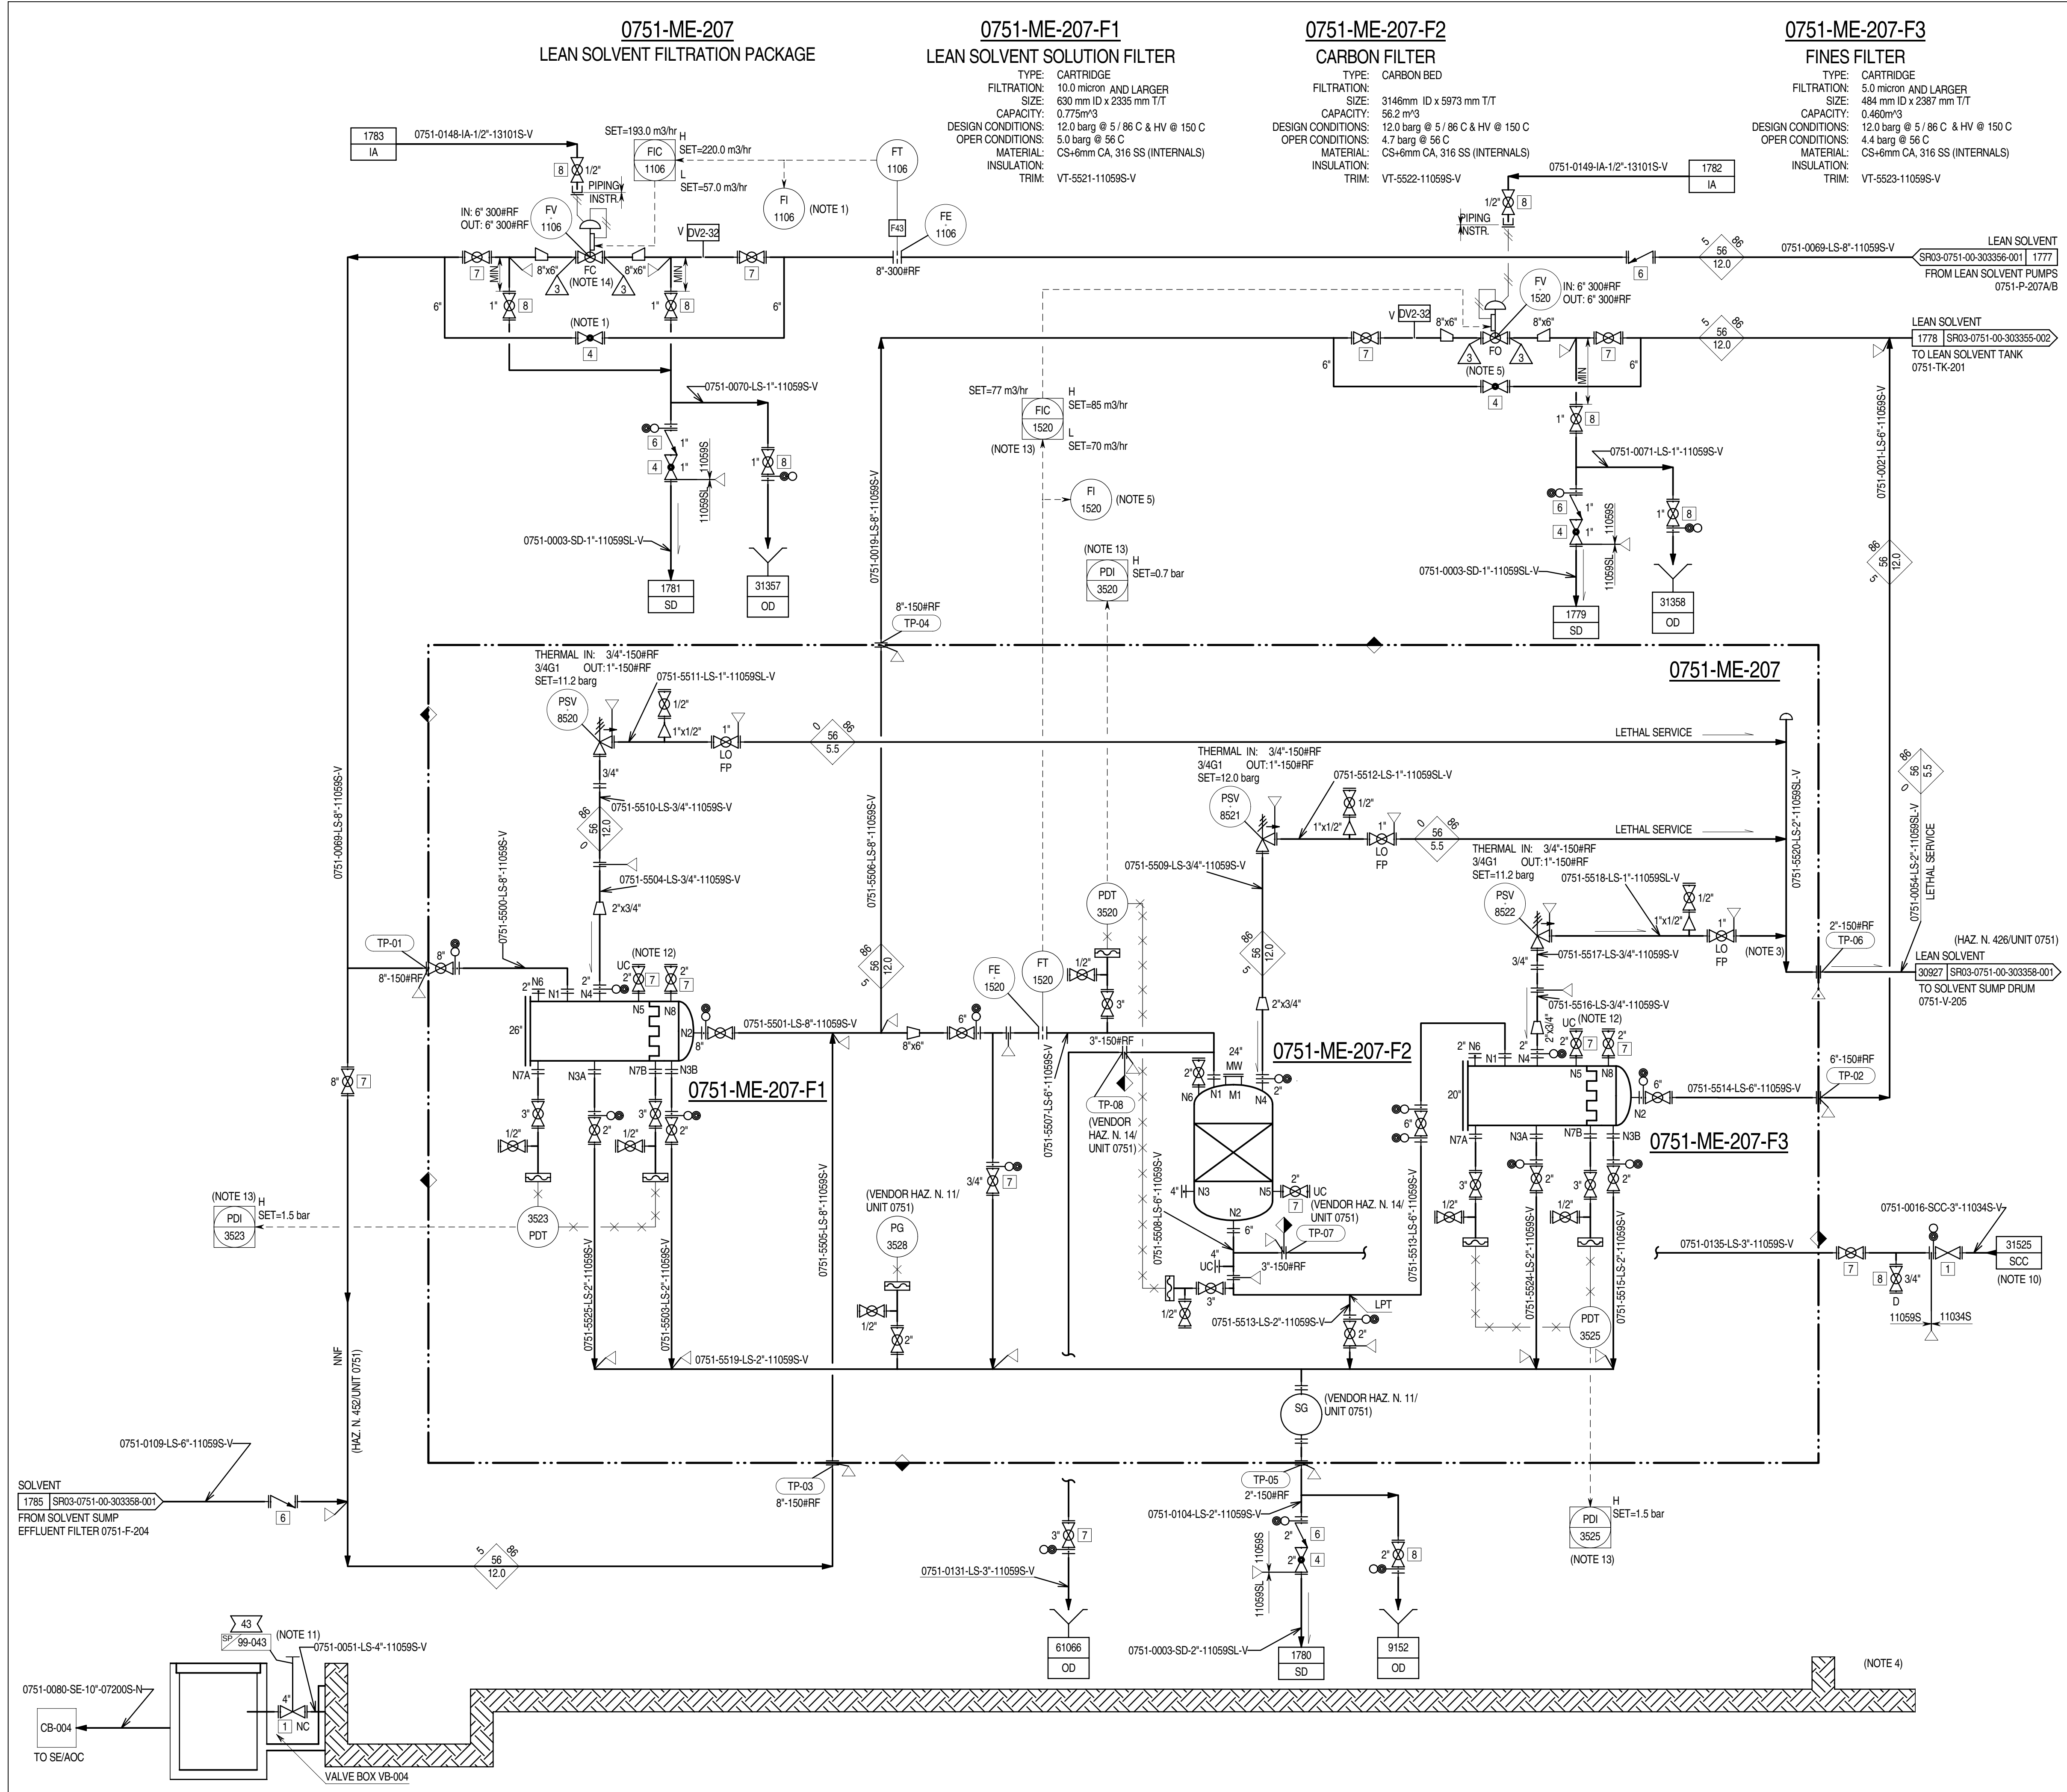

GENERAL NOTES:

- FOR STANDARD SYMBOLS, DETAILS, ABBREVIATIONS, SAMPLE CONNECTION TYPE, GENERAL NOTES & LEGEND SHEETS REFER TO DRAWING NO. MP02-0230-00-004000 TO 004015.
- ALL INSTRUMENT TAG NUMBERS ON THIS P&ID INCLUDING PACKAGE UNITS ARE PREFIXED WITH UNIT NUMBER 0751 UNLESS OTHERWISE NOTED.
- DELETED.

NOTES:

- FI-1106 TO BE READABLE FROM FV-1106 BYPASS VALVE.
- DELETED.
- USE 90° TOP ENTRY CONNECTION.
- CURBED AND PAVED AREA FOR FILTERS REQUIRED.
- FI-1520 TO BE READABLE FROM FV-1520 BYPASS VALVE.
- DELETED.
- DELETED.
- DELETED.
- DELETED.
- CLEAN WATER FLUSH CONNECTION PROVIDED FOR CARBON FILTER.
- VALVE TO BE OPERABLE FROM GRADE.
- SIDE ORIENTED.
- DELETED.
- VALVE FV-1106 IS EQUIPPED WITH MECHANICAL STOP. (VENDOR HAZ. N. 6/UNIT 0751)

UTILITY REFERENCE TABLE		
IA	DRW. N°.	SR03-0751-00-PID-362305
OD	DRW. N°.	SR03-0751-00-PID-362307
SD	DRW. N°.	SR03-0751-00-PID-362311
SCC	DRW. N°.	SR03-0751-00-PID-362308

ZI	DATE	IAB	ISSUED FOR AS BUILT	PCA	MAR	ASP
2.1D	18-04-14	IFC	ISSUED FOR CONSTRUCTION	PCA	MAR	ASP
2.1C	10-03-13	IFC	ISSUED FOR CONSTRUCTION	AN	CN	MZ
2.1B	06-08-12	IFC	ISSUED FOR CONSTRUCTION	DSC	CBR	SIN
2	29-12-11	IFC	ISSUED FOR CONSTRUCTION	DSC	CBR	SIN
1	12-08-11	IFCH	ISSUED FOR CONSTRUCTION WITH HOLDS	DSC	CBR	SIN
0	01-03-11	IFD	ISSUED CLIENT COMMENTS INCORPORATED	BSC	LMA	SIN
B1	30-09-10	ICR	ISSUED FOR CLIENT REVIEW	BSC	LMA	SIN
REV	DATE	STATUS	STATUS DESCRIPTION	BY	CKD	APP.

COMPANY:

Abu Dhabi Gas Development Co. Ltd.

CONTRACTOR:

JOB No. 032090

PROJECT:

SHAH GAS DEVELOPMENT (SGD) PROJECT


AGREEMENT No. 13525001

DRAWING TITLE: PIPING & INSTRUMENT DIAGRAM UNIT 0751
SULPHUR RECOVERY AND TAIL GAS TREATING UNIT

EQUIPMENT DESCRIPTION	SOLVENT FILTERS
TAGITEM No.	0751-ME-207-F1 0751-ME-207-F2 0751-ME-207-F3


CONTRACTOR DRG. No.	751-GD-B-303357	REV.
COMPANY DRG. No.	SR03-0751-00-303357	Z1
SCALE:	SIZE: A1	DOC. CLASS: 1

THIS DOCUMENT IS THE PROPERTY OF ABU DHABI GAS DEVELOPMENT COMPANY LIMITED AND CONTAINS INFORMATION WHICH IS PROPRIETARY. THIS INFORMATION IS TO BE HELD IN CONFIDENCE. NO DISCLOSURE OR OTHER USE OF THIS DOCUMENT IS TO BE MADE WITHOUT THE PRIOR WRITTEN CONSENT OF ABU DHABI GAS DEVELOPMENT COMPANY LIMITED.

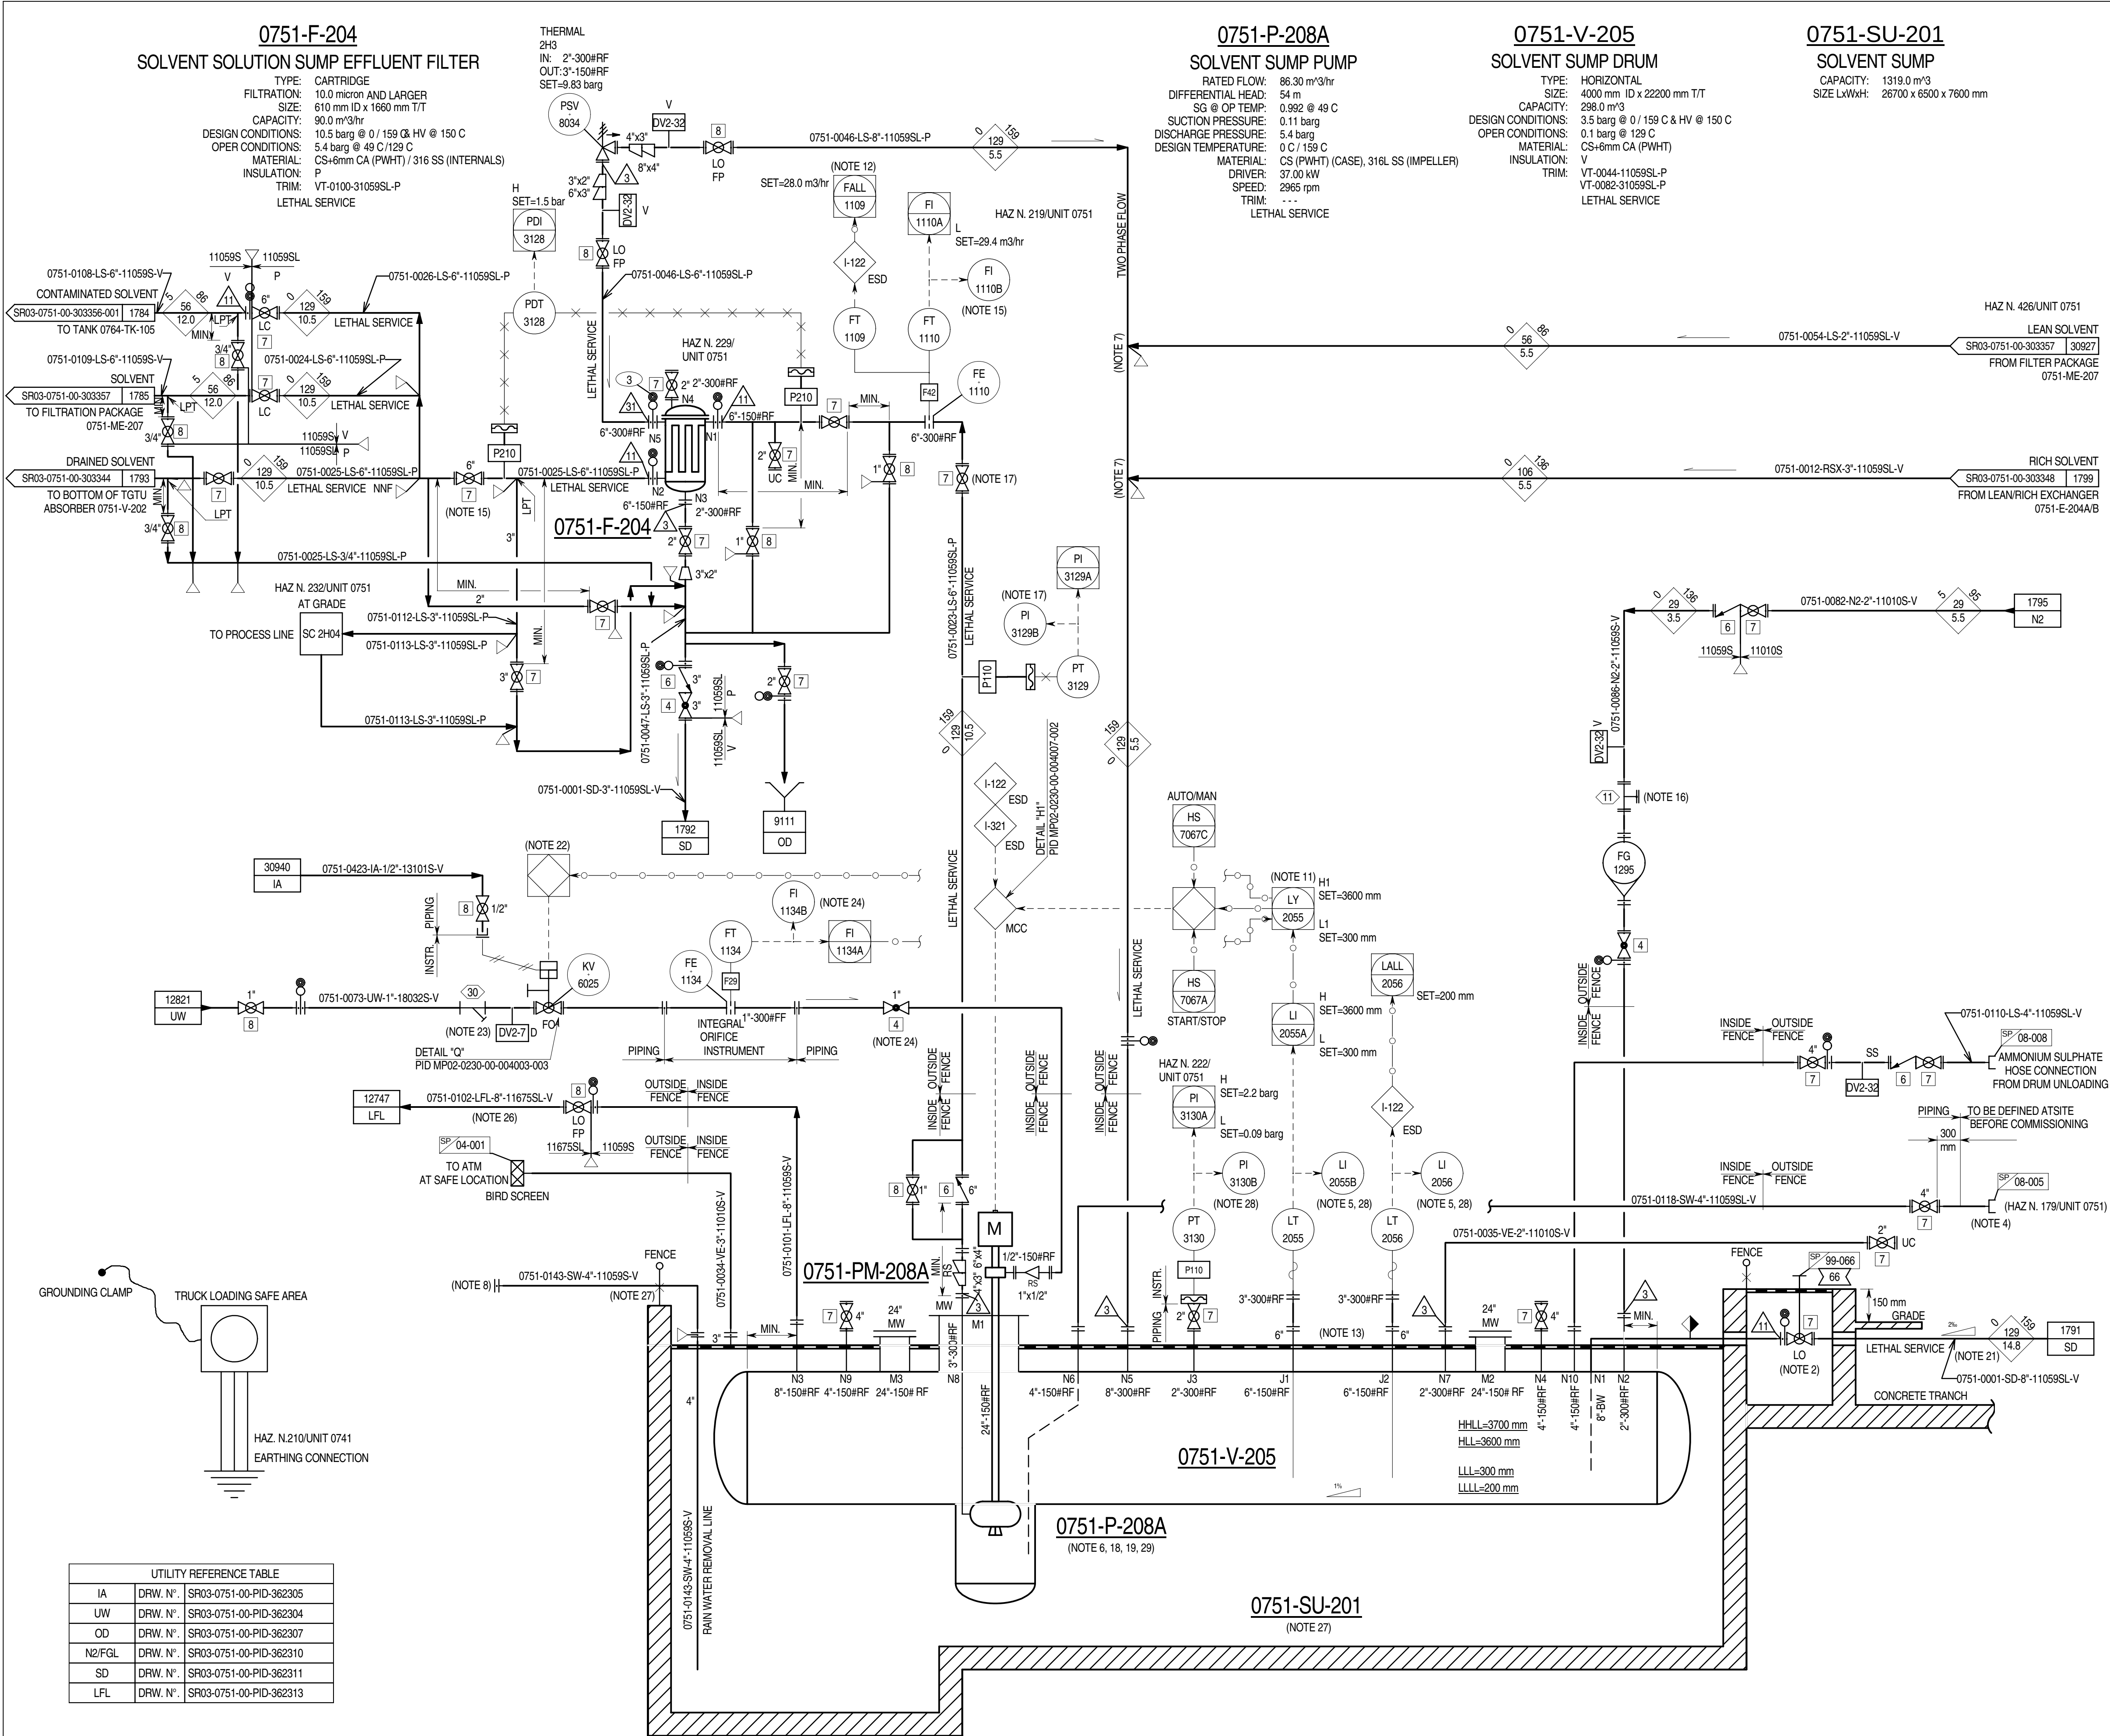

THIS DOCUMENT IS THE PROPERTY OF ABU DHABI GAS DEVELOPMENT COMPANY LIMITED AND CONTAINS INFORMATION WHICH IS PROPRIETARY. THIS INFORMATION IS TO BE HELD IN CONFIDENCE. NO DISCLOSURE OR OTHER USE OF THIS DOCUMENT IS TO BE MADE WITHOUT THE PRIOR WRITTEN CONSENT OF ABU DHABI GAS DEVELOPMENT COMPANY LIMITED.

PLAN 74 FOR VS4 PUMPS (WITHOUT GAS BOOSTER)

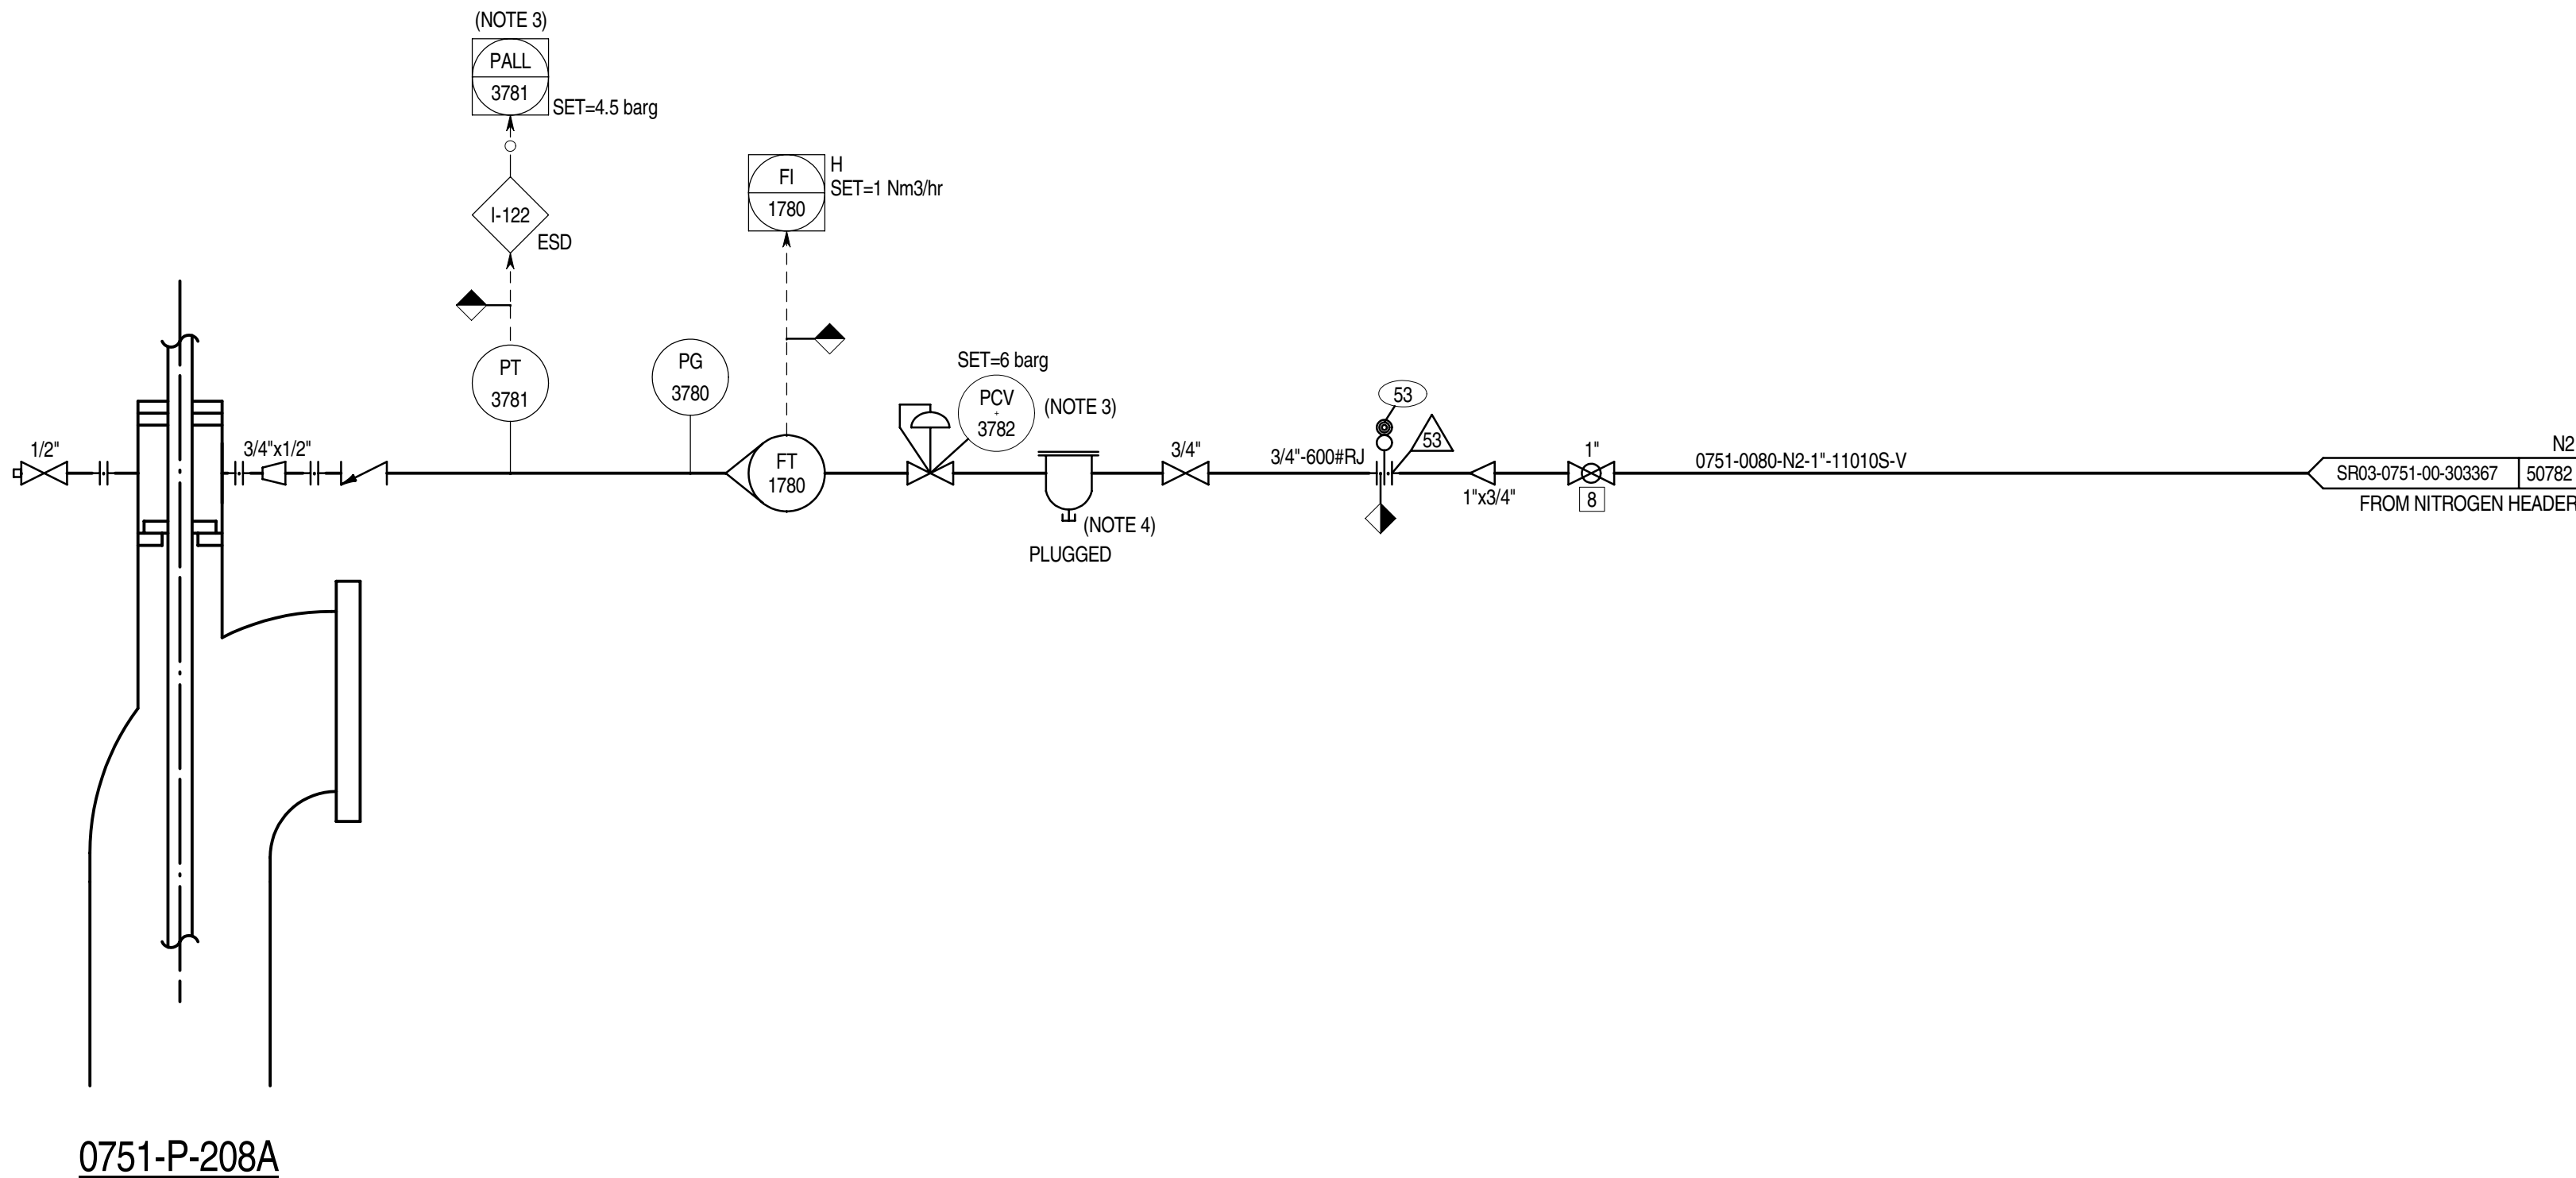

0751-P-208A

INTERLOCK TABLE (NOTE 1)		
INTERLOCK NUMBER	LOGIC DESCRIPTION (NOTE 2)	REFERENCE DOCUMENT N.
I-122	SOLVENT SUMP PUMP	SR03-0751-00-303375

- GENERAL NOTES:**
- FOR STANDARD SYMBOLS, DETAILS, ABBREVIATIONS, SAMPLE CONNECTION TYPE, GENERAL NOTES & LEGEND SHEETS REFER TO DRAWING NO. MP02-0230-00-004000 TO 004015.
 - ALL INSTRUMENT TAG NUMBERS ON THIS P&ID INCLUDING PACKAGE UNITS ARE PREFIXED WITH UNIT NUMBER 0751 UNLESS OTHERWISE NOTED.
 - DELETED.
- NOTES:**
- INTERLOCK TABLE IS FOR REFERENCE ONLY. CAUSE AND EFFECT CHART SR03-0751-00-CCC-303155 SHALL GOVERN.
 - REFER TO CAUSE AND EFFECT CHART FOR FULL REPRESENTATION OF INTERLOCK INITIATION AND ACTIONS.
 - SET POINT BY PUMP VENDOR.
 - COALESCING FILTER.

Z1	04-11-14	IAB	ISSUED FOR AS BUILT	PCA	MAR	ASP
2.1E	18-04-14	IFC	ISSUED FOR CONSTRUCTION	PCA	MAR	ASP
2.1D	28-02-14	IFC	ISSUED FOR CONSTRUCTION	PCA	MAR	ASP
2.1C	01-05-13	IFC	ISSUED FOR CONSTRUCTION	RL	CN	MZ
2.1B	06-08-12	IFC	ISSUED FOR CONSTRUCTION	DSC	CBR	SIN
2	29-12-11	IFC	ISSUED FOR CONSTRUCTION	DSC	CBR	SIN
1	12-08-11	IFCH	ISSUED FOR CONSTRUCTION WITH HOLDS	DSC	CBR	SIN
REV	DATE	STATUS	STATUS DESCRIPTION	BY	CKD	APP.

COMPANY:

Abu Dhabi Gas Development Co. Ltd.



CONTRACTOR:



JOB No. 032090

PROJECT: SHAH GAS DEVELOPMENT (SGD) PROJECT

AGREEMENT No. 13525001

DRAWING TITLE: PIPING & INSTRUMENT DIAGRAM UNIT 0751
SULPHUR RECOVERY AND TAIL GAS TREATING UNIT

EQUIPMENT DESCRIPTION	API PLAN 0751-P-208
TAGITEM No.	

CONTRACTOR DRG.No.	751-GD-B-303358	REV. Z1
COMPANY DRG.No.	SR03-0751-00-303358-002	
SCALE:	SIZE: A1	DOC. CLASS: 1

THIS DOCUMENT IS THE PROPERTY OF ABU DHABI GAS DEVELOPMENT COMPANY LIMITED AND CONTAINS INFORMATION WHICH IS PROPRIETARY. THIS INFORMATION IS TO BE HELD IN CONFIDENCE. NO DISCLOSURE OR OTHER USE OF THIS DOCUMENT IS TO BE MADE WITHOUT THE PRIOR WRITTEN CONSENT OF ABU DHABI GAS DEVELOPMENT COMPANY LIMITED.

0751-SU-202

CLOSED DRAIN SUMP

CAPACITY: 370.0 m³
SIZE LxWxH: 9650 x 4800 x 8000 mm

0751-V-213


CLOSED DRAIN DRUM

TYPE: HORIZONTAL
SIZE: 2300 mm ID x 6000 mm T/T
CAPACITY: 3.5 m³
DESIGN CONDITIONS: 3.5 barg @ 0 / 134 C & HV @ 150 C
OPER CONDITIONS: 0.1 barg @ 28 C
MATERIAL: CS-6mm CA (PWHT)
INSULATION: V
TRIM: VT-0084-31059SL-V
LETHAL SERVICE

0751-P-211A

CLOSED DRAIN PUMP

RATED FLOW: 15.0 m³/hr
DIFFERENTIAL HEAD: 80.8 m
SG @ OP TEMP: 0.972 @ 79.0 C
SUCTION PRESSURE: 0.1 barg
DISCHARGE PRESSURE: 7.8 barg
DESIGN TEMPERATURE: 0 / 134 C
MATERIAL: CS (PWHT)
DRIVER: 16.5 kW
SPEED: 2830 rpm
TRIM: ---

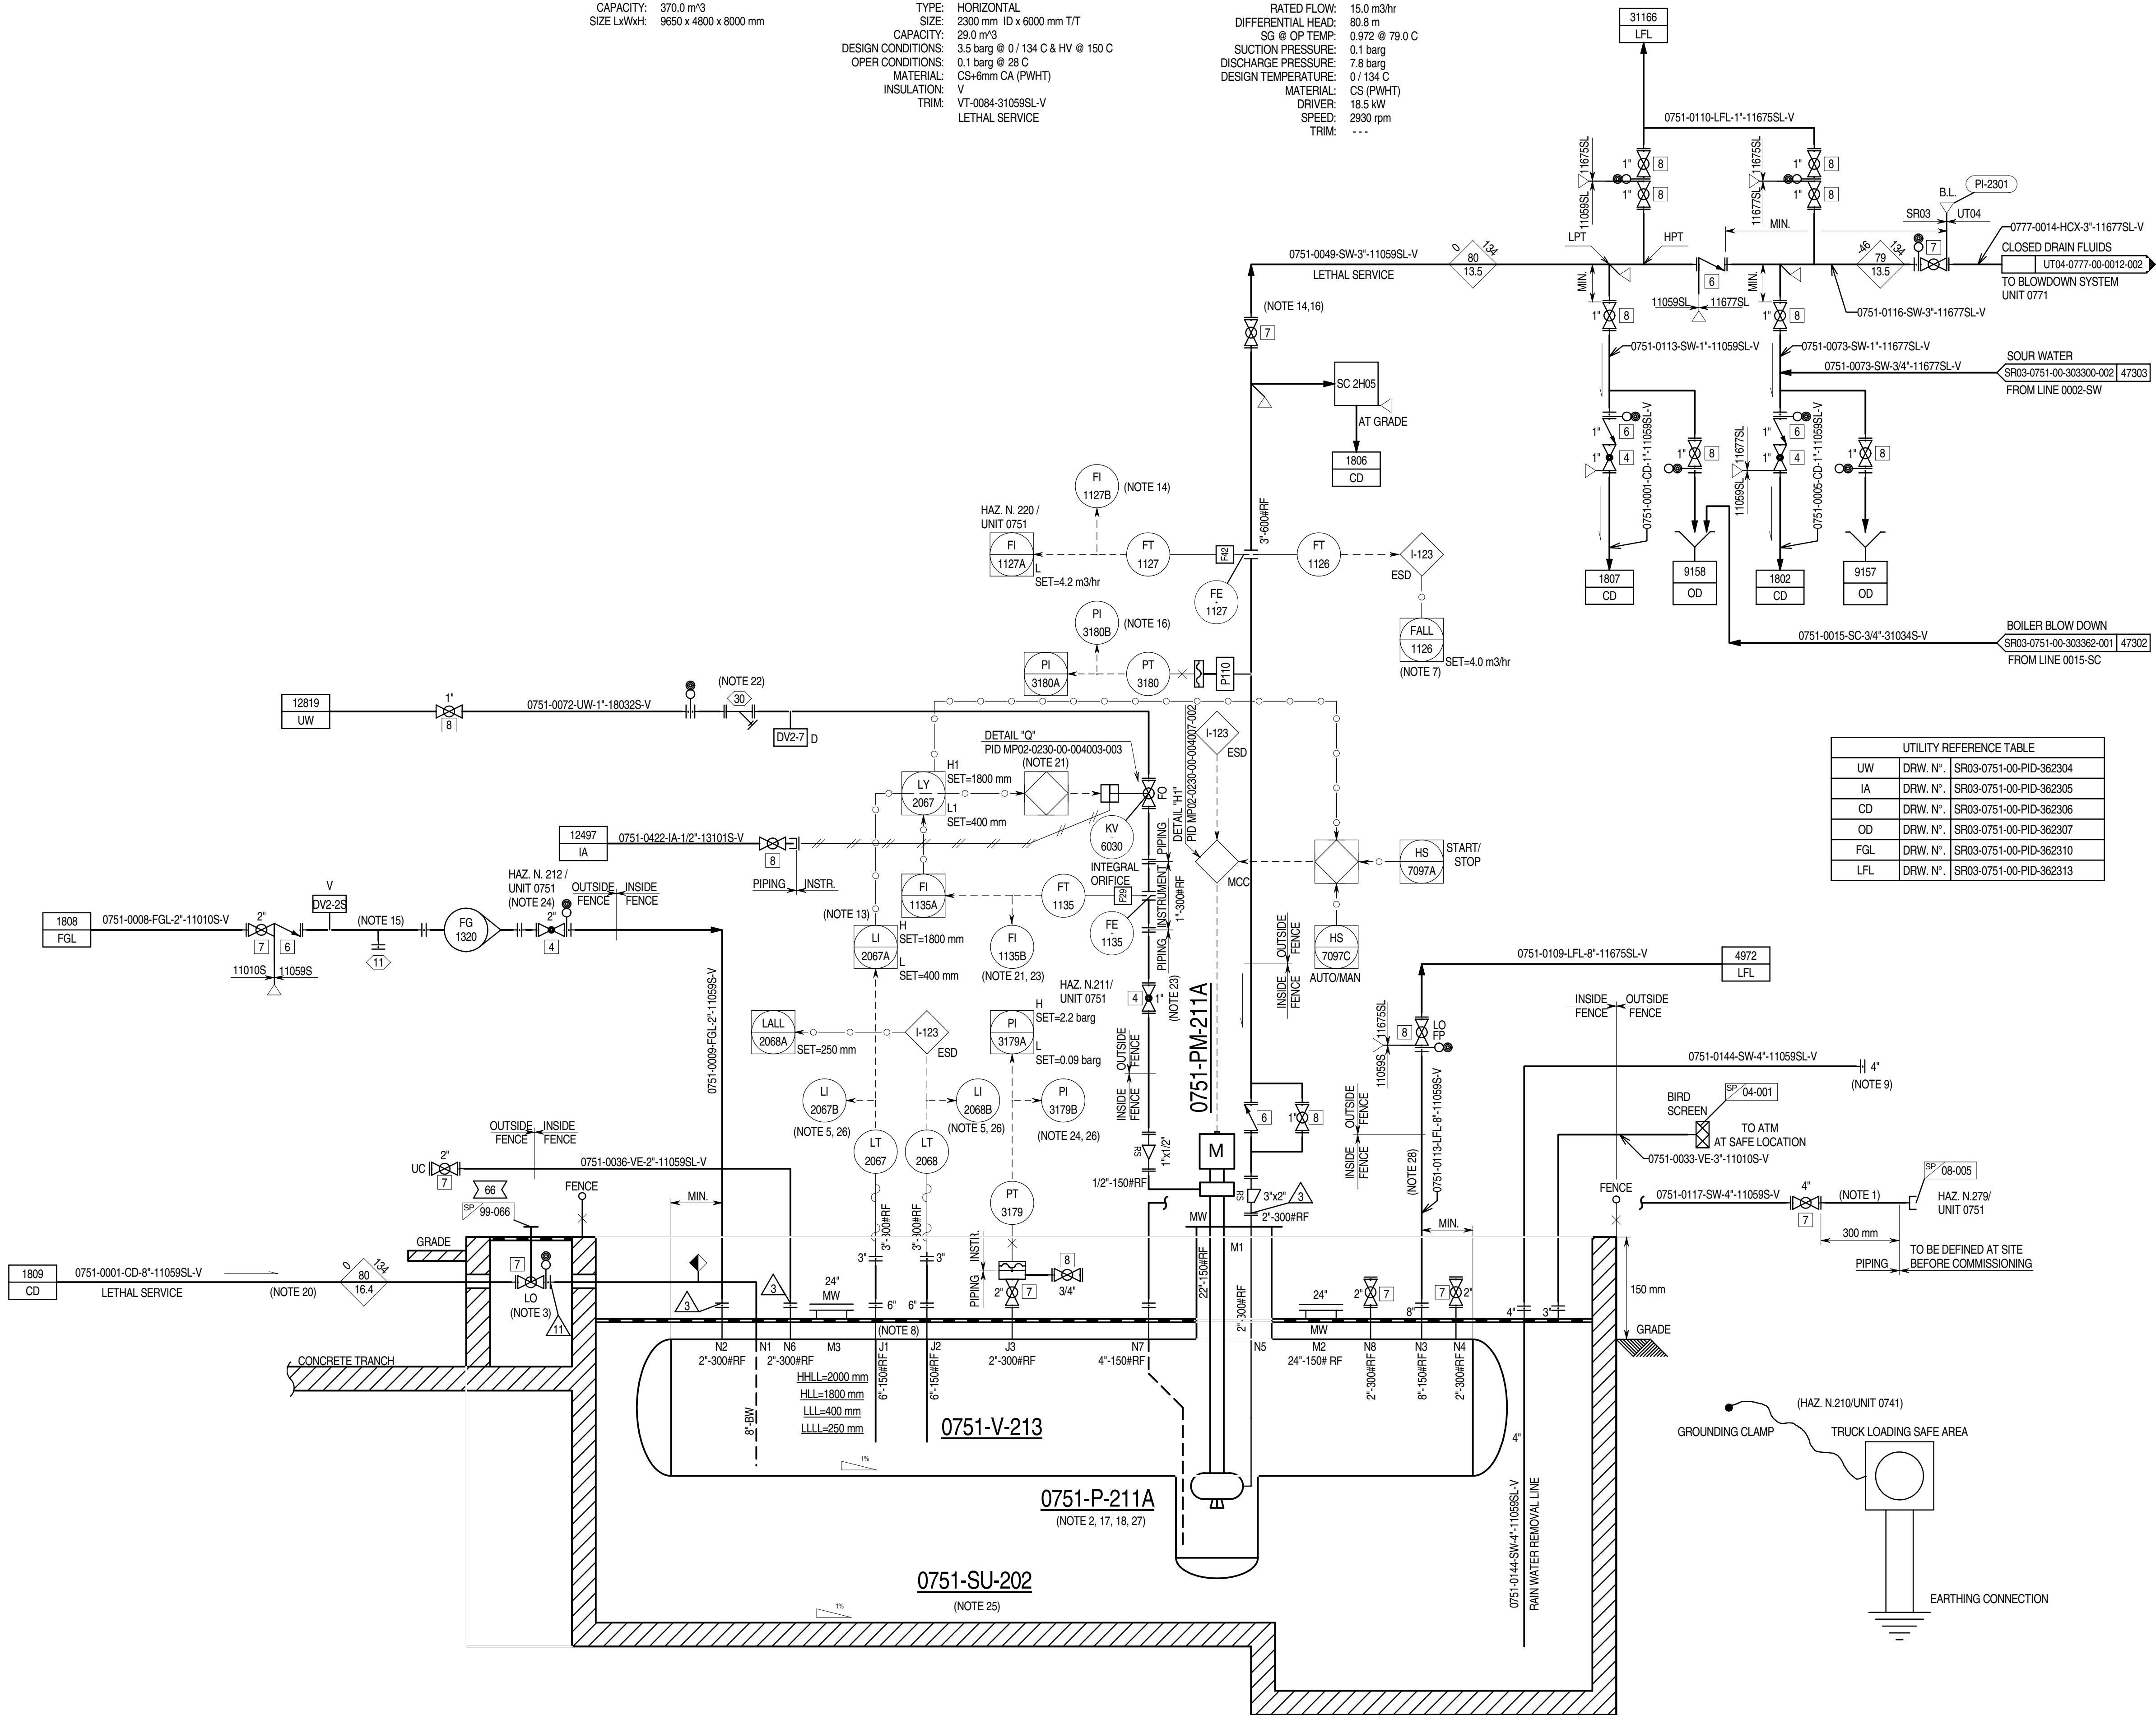

UTILITY REFERENCE TABLE		
UW	DRW. N°:	SR03-0751-00-PID-362304
IA	DRW. N°:	SR03-0751-00-PID-362305
CD	DRW. N°:	SR03-0751-00-PID-362306
OD	DRW. N°:	SR03-0751-00-PID-362307
FGL	DRW. N°:	SR03-0751-00-PID-362310
LFL	DRW. N°:	SR03-0751-00-PID-362313

INTERLOCK TABLE (NOTE 4)		
INTERLOCK NUMBER	LOGIC DESCRIPTION (NOTE 6)	REFERENCE DOCUMENT N.
I-123	CLOSED DRAIN PUMP	SR03-0751-00-303375

GENERAL NOTES:

- FOR STANDARD SYMBOLS, DETAILS, ABBREVIATIONS, SAMPLE CONNECTION TYPE, GENERAL NOTES & LEGEND SHEETS REFER TO DRAWING NO. MP02-0230-00-004000 TO 004015.
- ALL INSTRUMENT TAG NUMBERS ON THIS P&ID INCLUDING PACKAGE UNITS ARE PREFIXED WITH UNIT NUMBER 0751 UNLESS OTHERWISE NOTED.
- DELETED.

NOTES:

- VACUUM DRAIN CONNECTION.
- PUMP IS 1X100% COMMON WAREHOUSE SPARE 0751-P-211Z IS PROVIDED FOR UNITS 0751/0752/0753 AND 0754.
- VALVE TO BE OPERABLE FROM GRADE.
- INTERLOCK TABLE IS FOR REFERENCE ONLY CAUSE & EFFECT MATRIX SR03-0751-00-CCC-303155 SHALL GOVERN.
- LI-2067 AND LI-2068B TO BE READABLE FROM PUMP LOCAL CONTROL PANEL.
- REFER TO CAUSE AND EFFECT CHART FOR FULL REPRESENTATION OF INTERLOCK INITIATORS AND ACTIONS.
- LOW LOW FLOW PUMP TRIP.
- CHECKERED PLATE.
- VACUUM CONNECTION PROVIDED TO EMPTY RAIN WATER FROM SUMP.
- DELETED.
- DELETED.
- WHEN LIQUID LEVEL DETECTED BY LT-2067 REACHES H1 (LY-2067) THE PUMP WILL BE AUTOSTART.
- WHEN LIQUID LEVEL DETECTED BY LT-2067 REDUCES TO L1 (LY-2067) THE PUMP WILL AUTOSTOP.
- FI-1127B TO BE READABLE FROM DISCHARGE ISOLATION VALVE.
- STRAINER WITH SCREEN 20 MESH.
- PI-3180B TO BE READABLE FROM DISCHARGE ISOLATION VALVE.
- SUCTION STRAINER SUPPLIED WITH PUMP.
- REFER TO PROCESS CONTROL NARRATIVE SR03-0751-15-SPE-303163 FOR PERMISSIVE TO START CONDITIONS.
- DELETED.
- CLOSED DRAIN HEADER TO BE DESIGNED FOR FULL RATING.
- BEARING FLUSHING WATER VALVE KV-6030 SHALL OPEN BEFORE THE PUMP STARTS.
- TIME DELAY IS PROVIDED TO START THE PUMP AFTER A PERMISSIVE SIGNAL FROM FT-1135.
- PUMP WILL STOP IF THE PERMISSIVE SIGNAL IS LOST WHILE IT IS RUNNING.
- BEARING FLUSHING WATER VALVE KV-6030 SHALL CLOSE WHEN PUMP STOPS.
- REFER TO PROCESS CONTROL NARRATIVE SR03-0751-15-SPE-303163.
- FILTER STRAINER WITH SCREEN 270 MESH.
- FI-1135A TO BE REDEABLE FROM CORRESPONDING LOCAL GLOBE VALVE.
- PI-3179B TO BE READABLE FROM GLOBE VALVE ON FGL LINE. (HAZ N.212 / UNIT 0751)
- FENCE WILL BE PROVIDED AROUND THE SUMP.
- TO BE LOCATED OUTSIDE THE FENCE.
- PUMP MOTOR LOCAL CONTROL STATION TO BE LOCATED OUTSIDE THE FENCE.
- THIS WILL ALSO SERVE AS THE VESSEL'S RELIEF PROTECTION.

Z1	04-11-14	IAB	ISSUED FOR AS BUILT	PCA	MAR	ASP
2.1E	18-04-14	IFC	ISSUED FOR CONSTRUCTION	PCA	MAR	ASP
2.1D	28-02-14	IFC	ISSUED FOR CONSTRUCTION	PCA	MAR	ASP
2.1C	09-03-13	IFC	ISSUED FOR CONSTRUCTION	RL	CN	MZ
2.1B	06-08-12	IFC	ISSUED FOR CONSTRUCTION	DSC	CBR	SIN
2	29-12-11	IFC	ISSUED FOR CONSTRUCTION	DSC	CBR	SIN
1	12-08-11	IFCH	ISSUED FOR CONSTRUCTION WITH HOLDS	DSC	CBR	SIN
0	01-03-11	IFD	ISSUED CLIENT COMMENTS INCORPORATED	BSC	LMA	SIN
B1	30-09-10	ICR	ISSUED FOR CLIENT REVIEW	BSC	LMA	SIN
REV	DATE	STATUS	STATUS DESCRIPTION	BY	CKD	APP.

COMPANY:

Abu Dhabi Gas Development Co. Ltd.

CONTRACTOR:

JOB No. 032090

PROJECT: SHAH GAS DEVELOPMENT (SGD) PROJECT

AGREEMENT No. 13525001


DRAWING TITLE: PIPING & INSTRUMENT DIAGRAM UNIT 0751
SULPHUR RECOVERY AND TAIL GAS TREATING UNIT

EQUIPMENT DESCRIPTION	CLOSED DRAIN SUMP DRUM & PUMP		
TAGITEM No.	0751-P-211A	0751-SU-202	0751-V-213

CONTRACTOR DRG. No.		751-GD-B-303359		REV. Z1
COMPANY DRG. No.		SR03-0751-00-303359-001		
SCALE:	SIZE: A1	DOC. CLASS: 1		

THIS DOCUMENT IS THE PROPERTY OF ABU DHABI GAS DEVELOPMENT COMPANY LIMITED AND CONTAINS INFORMATION WHICH IS PROPRIETARY. THIS INFORMATION IS TO BE HELD IN CONFIDENCE. NO DISCLOSURE OR OTHER USE OF THIS DOCUMENT IS TO BE MADE WITHOUT THE PRIOR WRITTEN CONSENT OF ABU DHABI GAS DEVELOPMENT COMPANY LIMITED.

PLAN 74 FOR VS4 PUMPS (WITHOUT GAS BOOSTER)

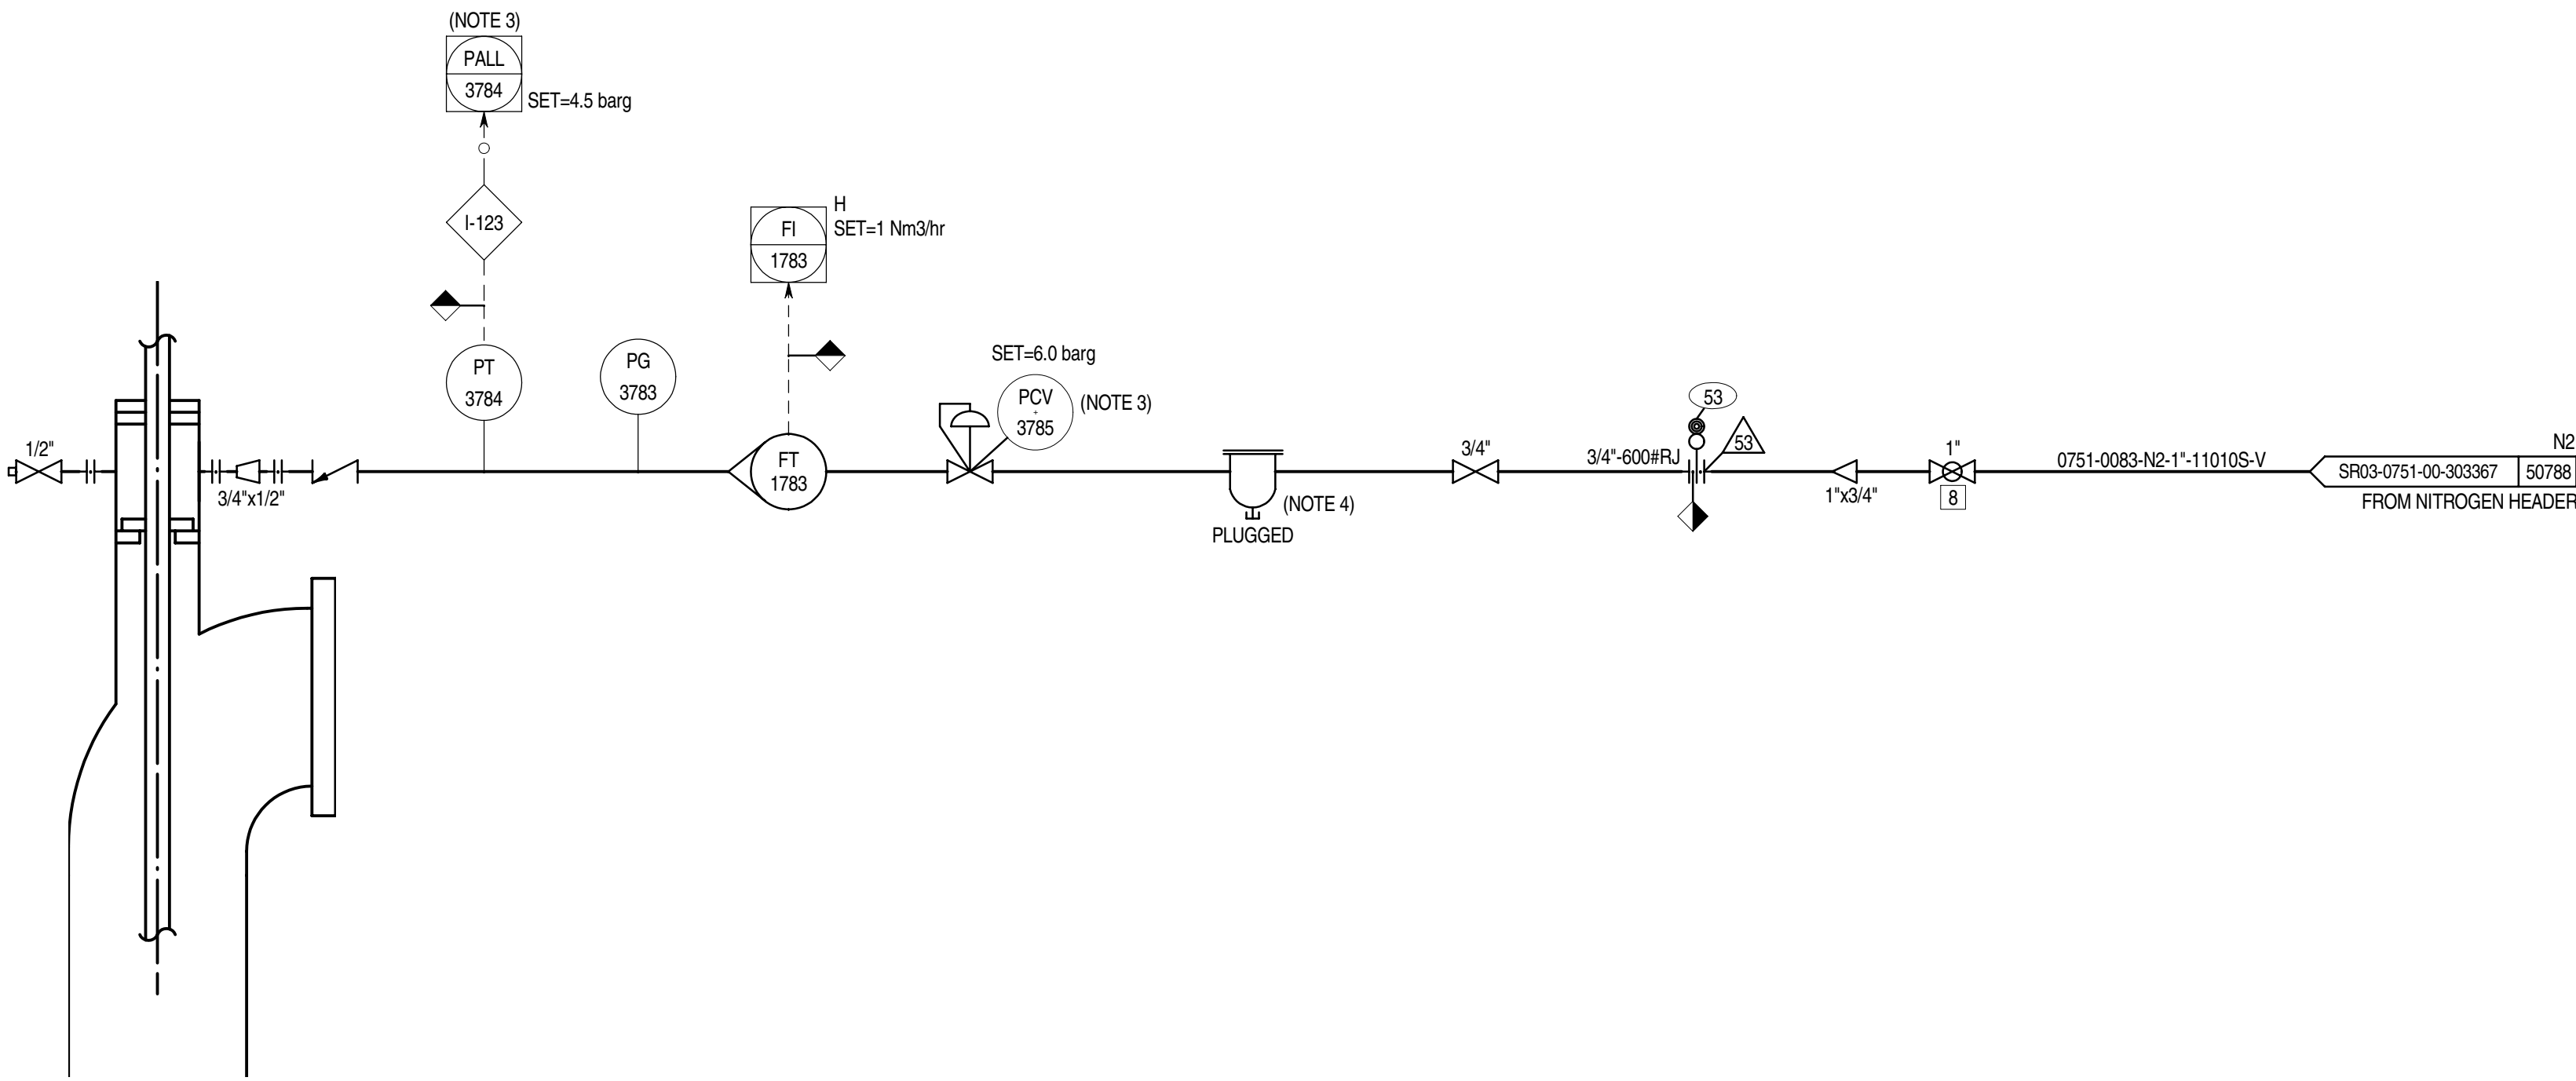

0751-P-211A

INTERLOCK TABLE (NOTE 1)		
INTERLOCK NUMBER	LOGIC DESCRIPTION (NOTE 2)	REFERENCE DOCUMENT N.
I-123	CLOSED DRAIN PUMP	SR03-0751-00-PID-303375

- GENERAL NOTES:**
- FOR STANDARD SYMBOLS, DETAILS, ABBREVIATIONS, SAMPLE CONNECTION TYPE, GENERAL NOTES & LEGEND SHEETS REFER TO DRAWING NO. MP02-0230-00-004000 TO 004015.
 - ALL INSTRUMENT TAG NUMBERS ON THIS P&ID INCLUDING PACKAGE UNITS ARE PREFIXED WITH UNIT NUMBER 0751 UNLESS OTHERWISE NOTED.
 - DELETED.
- NOTES:**
- INTERLOCK TABLE IS FOR REFERENCE ONLY. CAUSE & EFFECT MATRIX SR03-0751-00-CCC-303155 SHALL GOVERN.
 - REFER TO CAUSE AND EFFECT CHART FOR FULL REPRESENTATION OF INTERLOCK INITIATORS AND ACTIONS.
 - SET POINT BY PUMP VENDOR.
 - COALESCING FILTER.

Z1	04-11-14	IAB	ISSUED FOE AS BUILT	PCA	MAR	ASP
2.1E	18-04-14	IFC	ISSUED FOR CONSTRUCTION	PCA	MAR	ASP
2.1D	28-02-14	IFC	ISSUED FOR CONSTRUCTION	PCA	MAR	ASP
2.1C	01-05-13	IFC	ISSUED FOR CONSTRUCTION	RL	CN	MZ
2.1B	06-08-12	IFC	ISSUED FOR CONSTRUCTION	DSC	CBR	SIN
2	29-12-11	IFC	ISSUED FOR CONSTRUCTION	DSC	CBR	SIN
1	12-08-11	IFCH	ISSUED FOR CONSTRUCTION WITH HOLDS	DSC	CBR	SIN
REV	DATE	STATUS	STATUS DESCRIPTION	BY	CKD	APP.

COMPANY:

Abu Dhabi Gas Development Co. Ltd.



CONTRACTOR:



JOB No. 032090

PROJECT: SHAH GAS DEVELOPMENT (SGD) PROJECT

AGREEMENT No. 13525001


DRAWING TITLE: PIPING & INSTRUMENT DIAGRAM UNIT 0751
SULPHUR RECOVERY AND TAIL GAS TREATING UNIT

EQUIPMENT DESCRIPTION	API PLAN 0751-P-211
TAGITEM No.	

CONTRACTOR DRG.No.	751-GD-B-303359	REV. Z1
COMPANY DRG.No.	SR03-0751-00-303359-002	
SCALE:	SIZE: A1	DOC. CLASS: 1

Z1	04-11-14	IAB	ISSUED FOF AS BUILT	PCA	MAR	AS
2.1D	18-04-14	IFC	ISSUED FOR CONSTRUCTION	PCA	MAR	AS
2.1C	10-03-13	IFC	ISSUED FOR CONSTRUCTION	RL	CN	MZ
2.1B	06-08-12	IFC	ISSUED FOR CONSTRUCTION	DSC	CBR	SIN
2	29-12-11	IFC	ISSUED FOR CONSTRUCTION	DSC	CBR	SIN
1	12-08-11	IFCH	ISSUED FOR CONSTRUCTION WITH HOLDS	DSC	CBR	SIN
0	01-03-11	IFD	ISSUED CLIENT COMMENTS INCORPORATED	BSC	LMA	SIN
B1	30-09-10	ICR	ISSUED FOR CLIENT REVIEW	BSC	LMA	SIN
REV	DATE	STATUS	STATUS DESCRIPTION	BY	CKD	APP

REV.

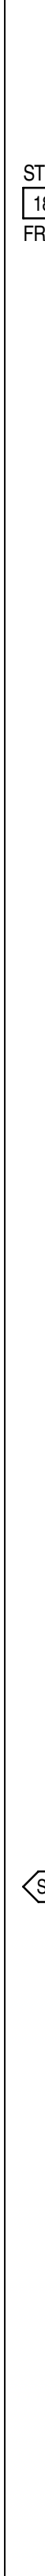

ST 11 FR

UTILITY REFERENCE TABLE		
IA	DRW. N°.	SR03-0751-00-PID-362305
OD	DRW. N°.	SR03-0751-00-PID-362307

UTILITY REFERENCE TABLE		
IA	DRW. N°.	SR03-0751-00-PID-362305
OD	DRW. N°.	SR03-0751-00-PID-362307

THIS DOCUMENT IS THE PROPERTY OF ABU DHABI GAS DEVELOPMENT COMPANY LIMITED AND CONTAINS INFORMATION WHICH IS PROPRIETARY. THIS INFORMATION IS TO BE HELD IN CONFIDENCE. NO DISCLOSURE OR OTHER USE OF THIS DOCUMENT IS TO BE MADE WITHOUT THE PRIOR WRITTEN CONSENT OF ABU DHABI GAS DEVELOPMENT COMPANY LIMITED.

PLAN 23/65 FOR OH PUMPS

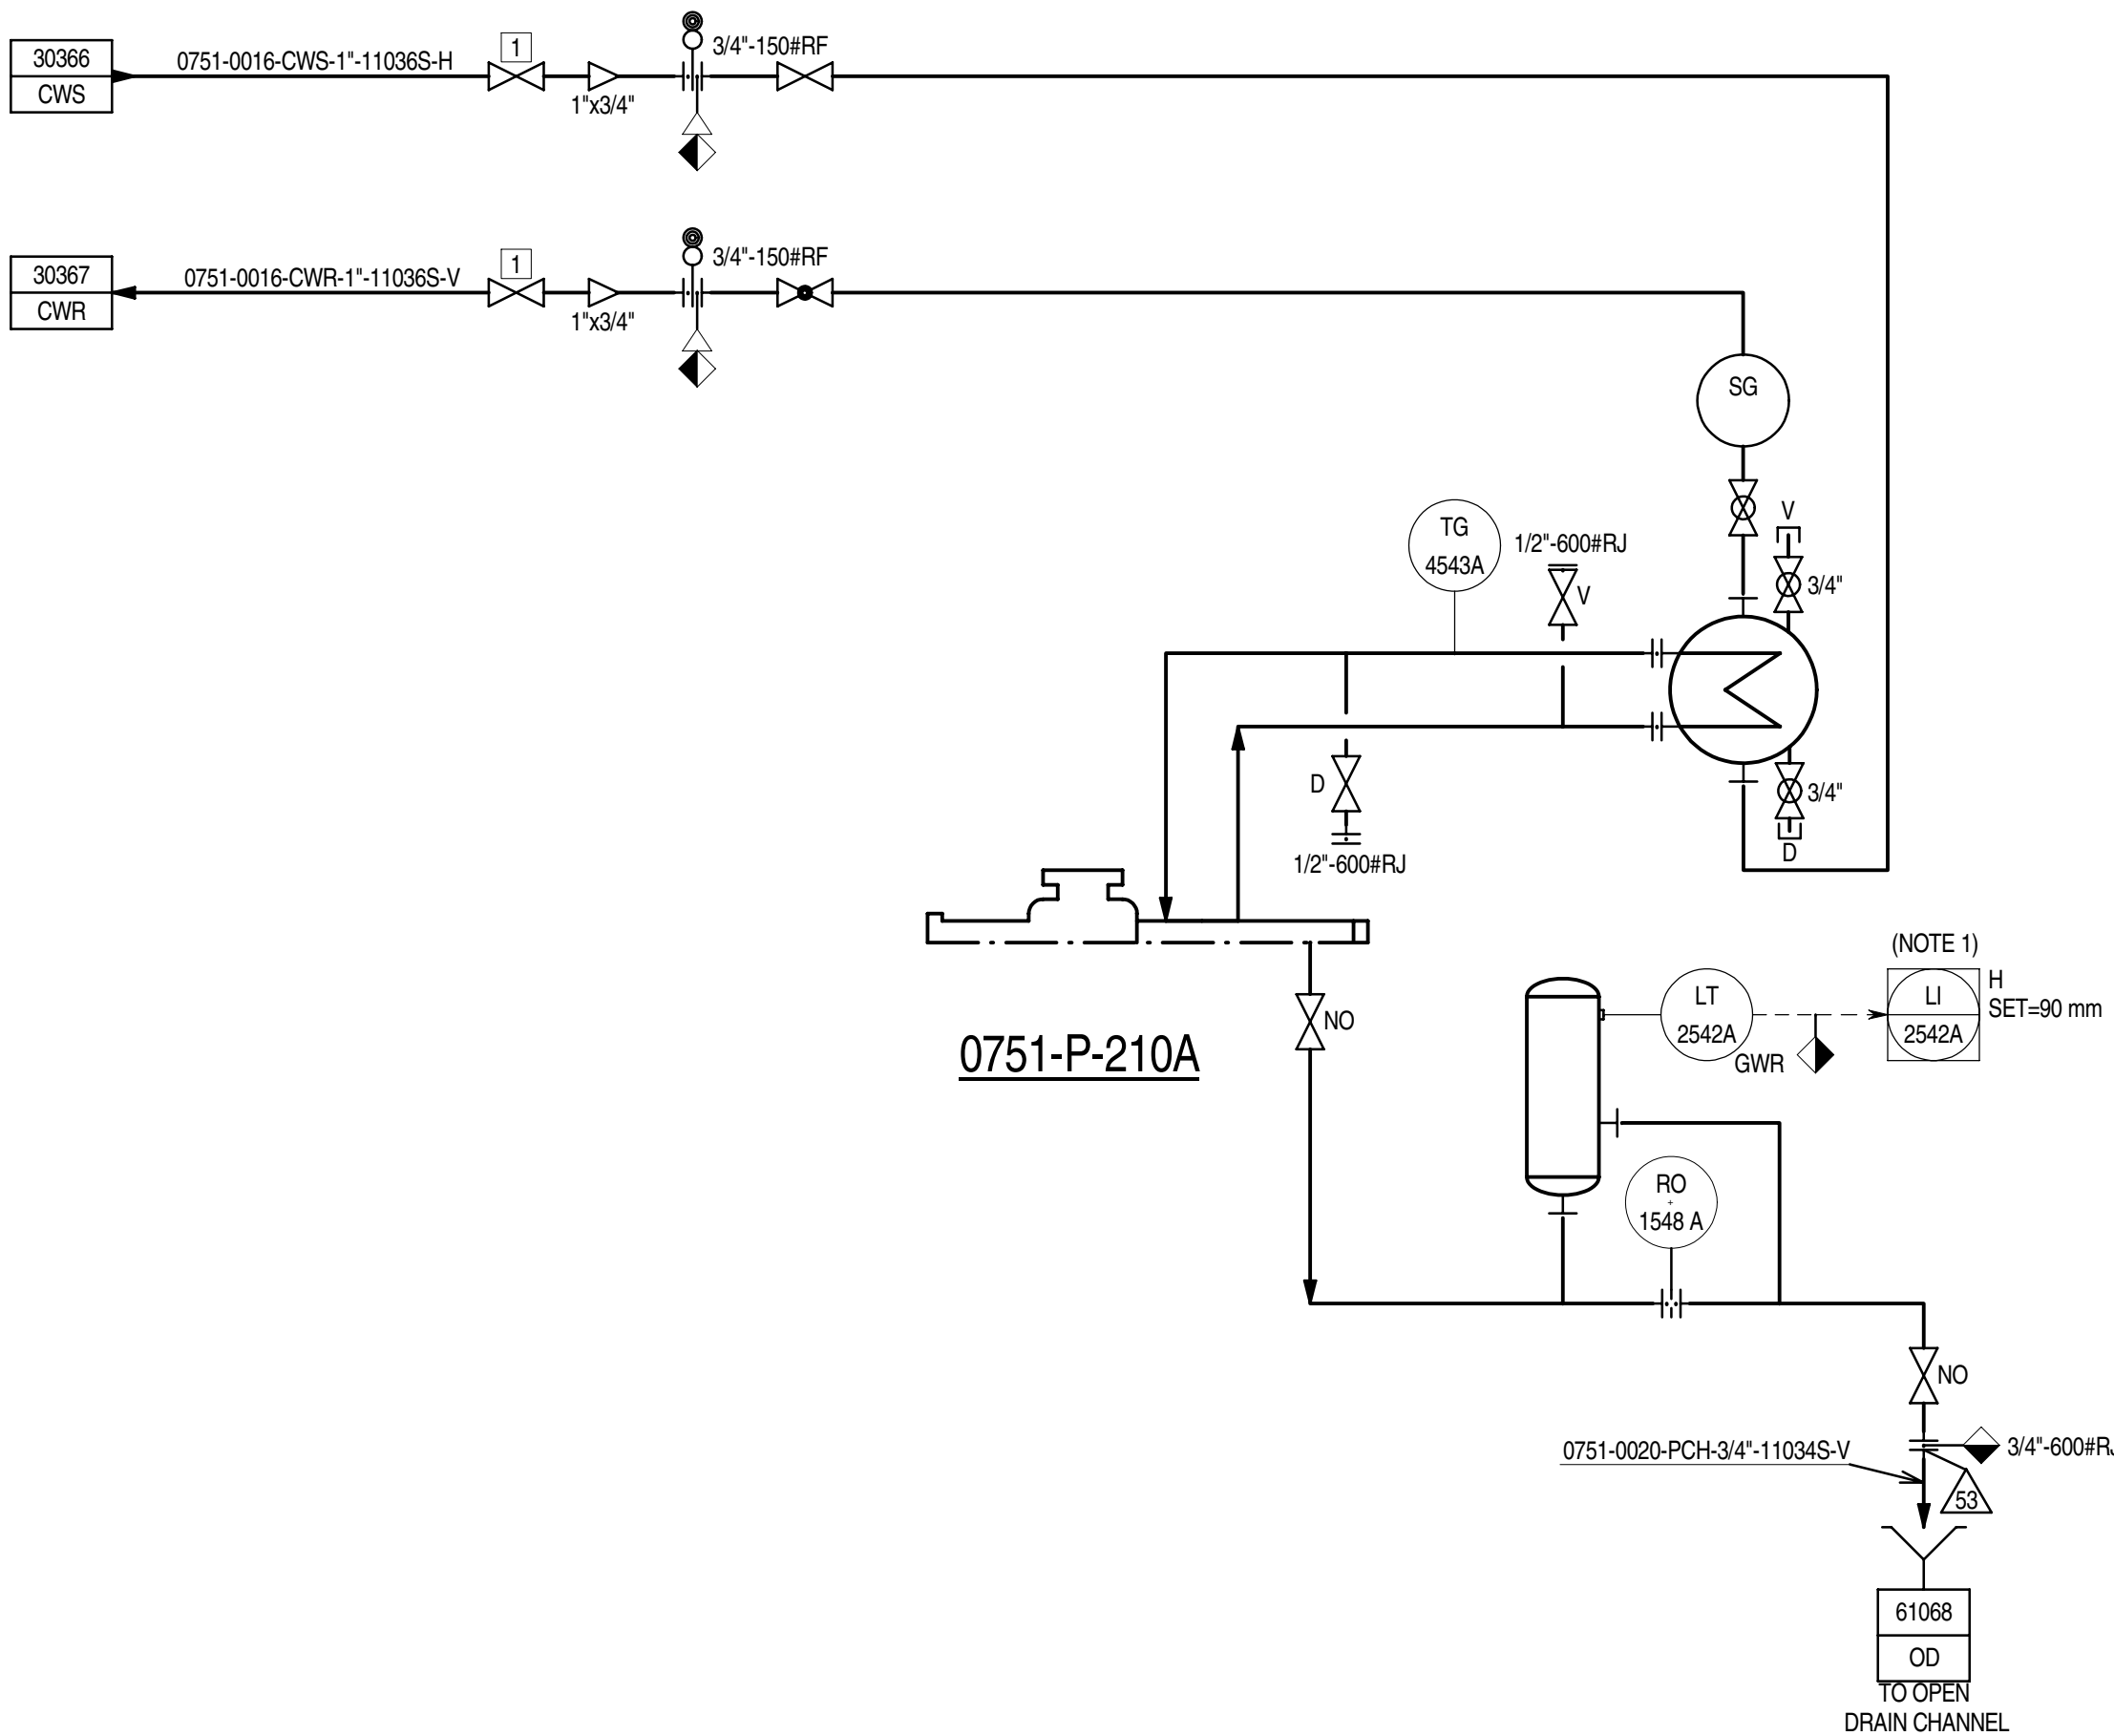

PLAN 23/65 FOR OH PUMPS

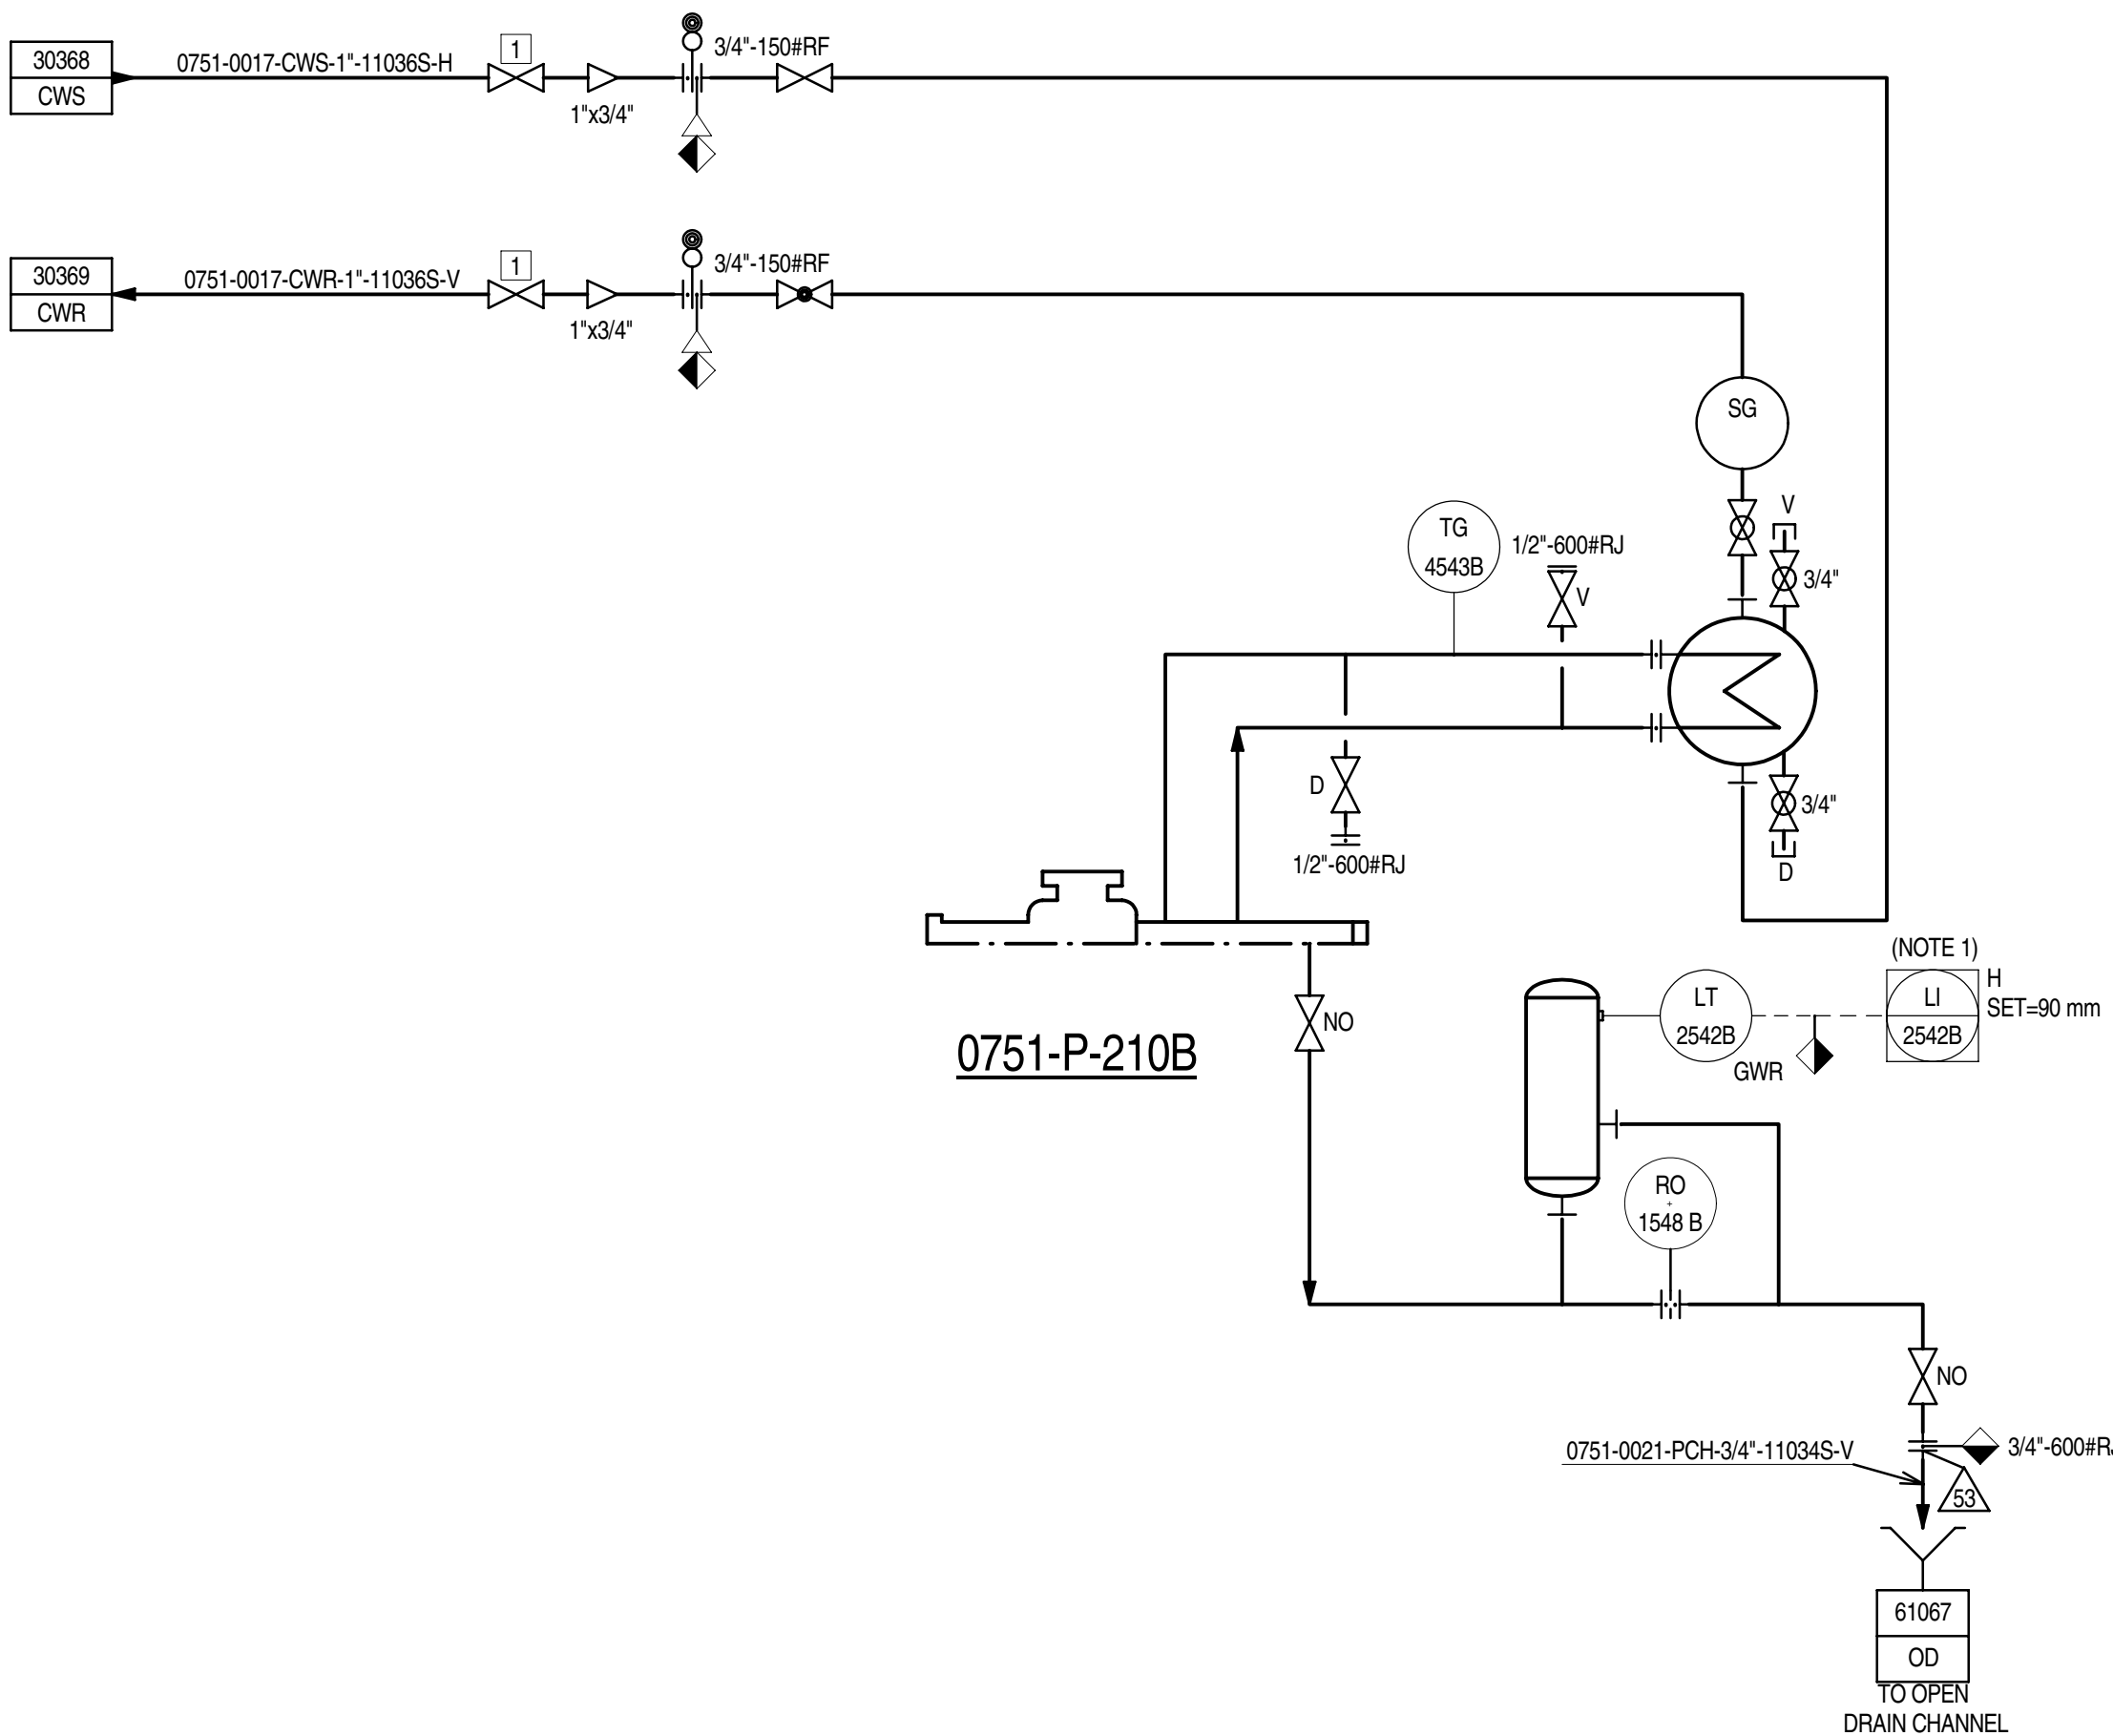

GENERAL NOTES:

- FOR STANDARD SYMBOLS, DETAILS, ABBREVIATIONS, SAMPLE CONNECTION TYPE, GENERAL NOTES & LEGEND SHEETS REFER TO DRAWING NO. MP02-0230-00-004000 TO 004015.
- ALL INSTRUMENT TAG NUMBERS ON THIS P&ID INCLUDING PACKAGE UNITS ARE PREFIXED WITH UNIT NUMBER 0751 UNLESS OTHERWISE NOTED.
- DELETED.

GENERAL NOTES:

- ALARM VALUE BY PUMP VENDOR.

UTILITY REFERENCE TABLE		
CWS/CWR	DRW. N°.	SR03-0751-00-PID-362308
OD	DRW. N°.	SR03-0751-00-PID-362307

Z1	04-11-14	IAB	ISSUED FOR AS BUILT	PCA	MAR	ASP
2.1D	18-04-14	IFC	ISSUED FOR CONSTRUCTION	PCA	MAR	ASP
2.1C	01-05-13	IFC	ISSUED FOR CONSTRUCTION	RL	CN	MZ
2.1B	06-08-12	IFC	ISSUED FOR CONSTRUCTION	DSC	CBR	SIN
2	29-12-11	IFC	ISSUED FOR CONSTRUCTION	DSC	CBR	SIN
1	12-08-11	IFCH	ISSUED FOR CONSTRUCTION WITH HOLDS	DSC	CBR	SIN
REV	DATE	STATUS	STATUS DESCRIPTION	BY	CKD	APP.

COMPANY:

Abu Dhabi Gas Development Co. Ltd.



CONTRACTOR:



JOB No. 032090

PROJECT:

SHAH GAS DEVELOPMENT (SGD) PROJECT

AGREEMENT No. 13525001

DRAWING TITLE: PIPING & INSTRUMENT DIAGRAM UNIT 0751
SULPHUR RECOVERY AND TAIL GAS TREATING UNIT


EQUIPMENT DESCRIPTION	API PLAN 0751-P-210A/B				
TAGITEM No.					

CONTRACTOR DRG. No.		751-GD-B-303360		REV. Z1
COMPANY DRG. No.		SR03-0751-00-303360-003		
SCALE:	SIZE: A1	DOC. CLASS: 1		

THIS DOCUMENT IS THE PROPERTY OF ABU DHABI GAS DEVELOPMENT COMPANY LIMITED. NO DISCLOSURE OR OTHER USE OF THIS DOCUMENT IS TO BE MADE WITHOUT THE PRIOR WRITTEN CONSENT OF ABU DHABI GAS DEVELOPMENT COMPANY LIMITED.

0751-V-206
LP BLOWDOWN DRUM

TYPE: VERTICAL
SIZE: 2400 mm ID x 5300 mm T/T
CAPACITY: 27.6 m³/S
DESIGN CONDITIONS: 3.5 barg @ 5 / 210 C & FV @ 100 C (NOTE 6)
OPER CONDITIONS: 0.0 barg @ 100 C
MATERIAL: CS+3mm CA
INSULATION: P
TRIM: VT-0054-31034S-P

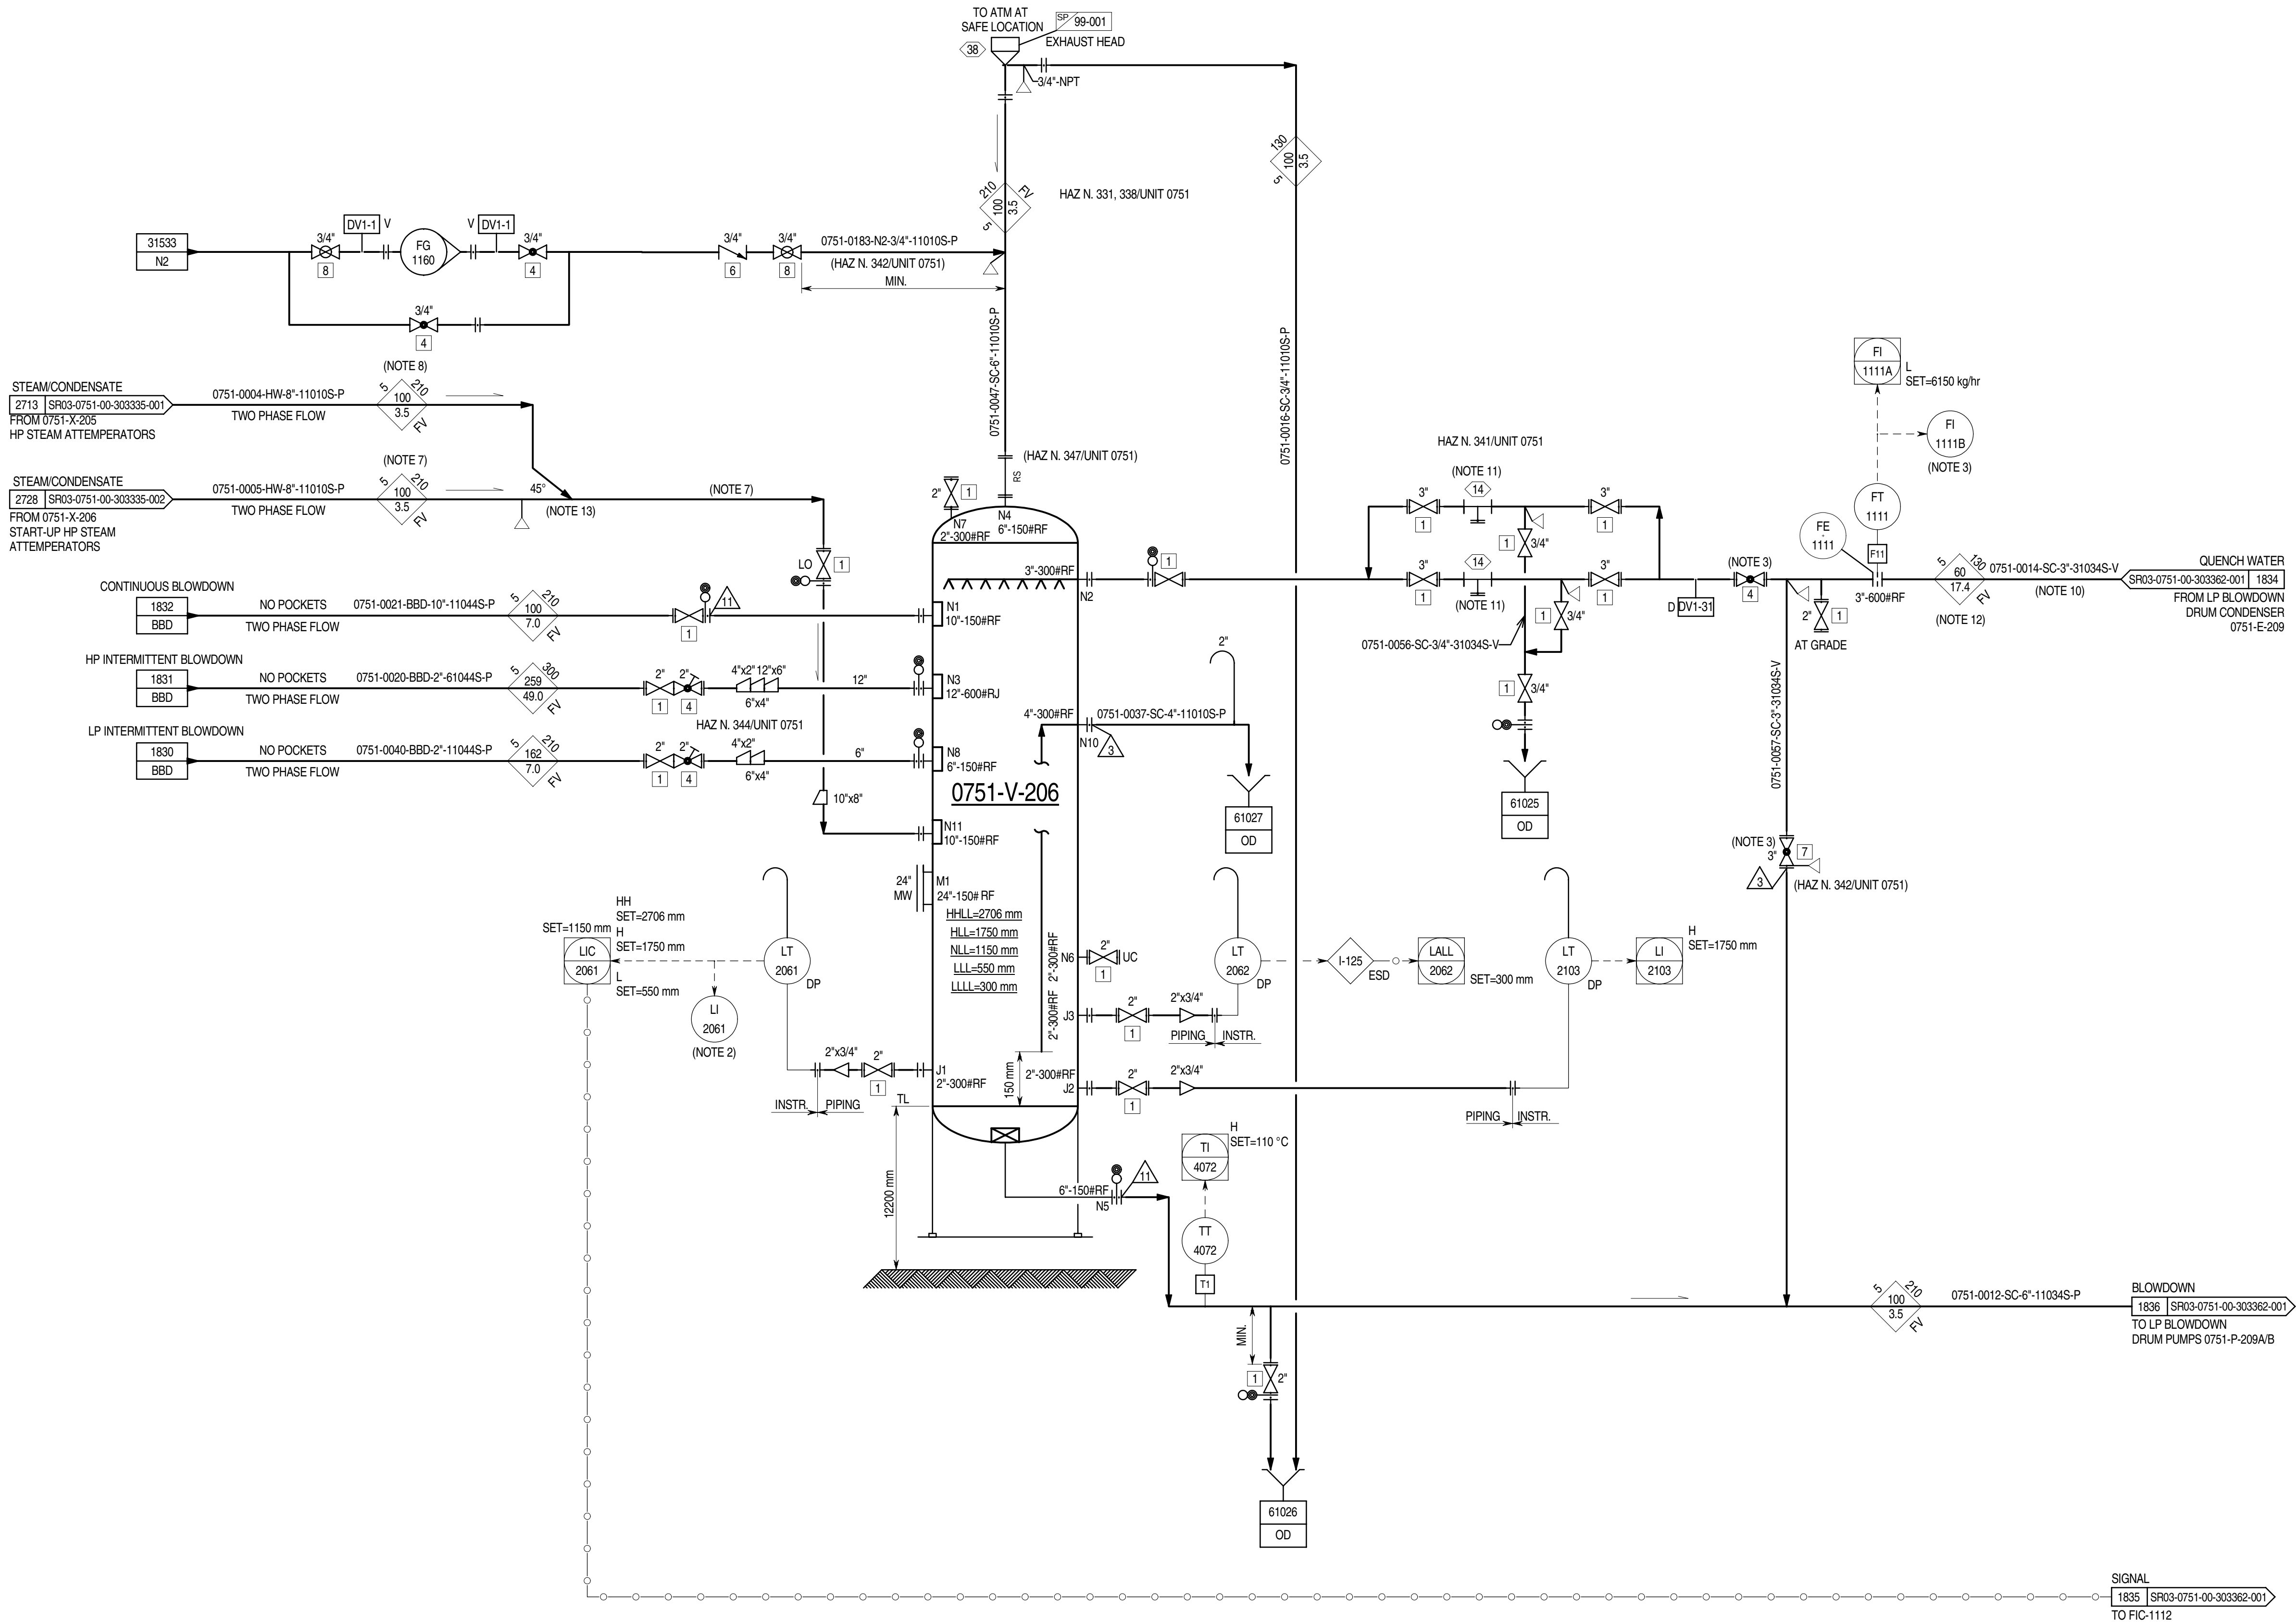

INTERLOCK TABLE (NOTE 4)		
INTERLOCK NUMBER	LOGIC DESCRIPTION (NOTE 9)	REFERENCE DOCUMENT N.
I-125	LP BLOWDOWN DRUM	SR03-0751-00-303375

- GENERAL NOTES:**
- FOR STANDARD SYMBOLS, DETAILS, ABBREVIATIONS, SAMPLE CONNECTION TYPE, GENERAL NOTES & LEGEND SHEETS REFER TO DRAWING NO. MP02-0230-00-004000 TO 004015.
 - ALL INSTRUMENT TAG NUMBERS ON THIS P&ID INCLUDING PACKAGE UNITS ARE PREFIXED WITH UNIT NUMBER 0751 UNLESS OTHERWISE NOTED.
 - DELETED.
- NOTES:**
- DELETED.
 - LI-2061 TO BE READABLE FROM OF FV-1112 BYPASS VALVE (ON DWG. SR03-0751-00-303362-001).
 - FI-1111B TO BE READABLE FROM GLOBE VALVE.
 - INTERLOCK TABLE IS FOR REFERENCE ONLY. CAUSE AND EFFECT MATRIX SR03-0751-00-CCC-303155 SHALL GOVERN.
 - DELETED.
 - ALTERNATIVE DESIGN CONDITION IS 0.1 BARG @ 400°C.
 - DURING UPSET CONDITION TEMPERATURE CAN REACH 257°C.
 - DURING UPSET CONDITION TEMPERATURE CAN REACH 400°C.
 - REFER TO CAUSE AND EFFECT CHART FOR FULL REPRESENTATION OF INTERLOCK INITIATORS AND ACTIONS.
 - QUENCH LINE IS SUFFICIENT TO PROVIDE MINIMUM FLOW PROTECTION FOR PUMPS 0751-P-209A/B (ON DWG. SR03-0751-00-303362-001).
 - STRAINER WITH SCREEN 60 MESH.
 - SYSTEM DESIGN PRESSURE IS 17.4 barg.
 - THE ACTUAL PUMP 0751-P-209A/B SHUTOFF PRESSURE IS 13.8 barg.
 - USE 45° TOP ENTRY CONNECTION.

UTILITY REFERENCE TABLE	
BBD	DRW. N°. SR03-0751-00-PID-362303
OD	DRW. N°. SR03-0751-00-PID-362307

Z1	04-11-14	IAB	ISSUED FOR AS BUILT	PCA	MAR	ASP
2.1D	18-04-14	IFC	ISSUED FOR CONSTRUCTION	PCA	MAR	ASP
2.1C	31-10-12	IFC	ISSUED FOR CONSTRUCTION	RL	MF	MZ
2.1B	31-10-12	IFC	ISSUED FOR CONSTRUCTION	DSC	CBR	SIN
2	29-12-11	IFC	ISSUED FOR CONSTRUCTION	DSC	CBR	SIN
1	12-08-11	IFCH	ISSUED FOR CONSTRUCTION WITH HOLDS	DSC	CBR	SIN
0	01-03-11	IFD	ISSUED CLIENT COMMENTS INCORPORATED	BSC	LMA	SIN
B1	30-09-10	ICR	ISSUED FOR CLIENT REVIEW	BSC	LMA	SIN
REV	DATE	STATUS	STATUS DESCRIPTION	BY	CKD	APP.

COMPANY:

Abu Dhabi Gas Development Co. Ltd.

CONTRACTOR:

JOB No. 032090

PROJECT:

SHAH GAS DEVELOPMENT (SGD) PROJECT

AGREEMENT No. 13525001

DRAWING TITLE: PIPING & INSTRUMENT DIAGRAM UNIT 0751
SULPHUR RECOVERY AND TAIL GAS TREATING UNIT

EQUIPMENT DESCRIPTION	LP BLOWDOWN DRUM
TAGITEM No.	0751-V-206

CONTRACTOR DRG. No.	751-GD-B-303361	REV. Z1
COMPANY DRG. No.	SR03-0751-00-303361	
SCALE:	SIZE: A1 DOC. CLASS: 1	

1. DELETED.
2. INTERLOCK TABLE IS FOR REFERENCE ONLY. CAUSE AND EFFECT MATRIX SR03-0751-00-CCC-303144 SHALL GOVERN.
3. DELETED.
4. DELETED.
5. PUMPS ARE 2x100%. ONE PUMP RUNNING, ONE STAND-BY.
6. DELETED.
7. FI-1112 TO BE READABLE FROM OF FI-1112 BYPASS VALVE.
8. DELETED.
9. QUENCH LINE IS SUFFICIENT TO PROVIDE MIN. FLOW PROTECTION FOR PUMPS 0751-P-209A/B.
10. AUTOSTART OF STANDBY PUMP FOR LOW PRESSURE.
11. DELETED.
12. TEMPORARY & PERMANENT STRAINER WITH SCREEN 48 MESH.
13. PI-3141B AND PI-3143B TO BE READABLE FROM CORRESPONDING DISCHARGE ISOLATION VALVES.
14. DELETED.
15. REFER TO CAUSE AND EFFECT CHART FOR FULL REPRESENTATION OF INTERLOCK INITIATORS AND ACTIONS
16. SYSTEM DESIGN PRESSURE IS 17.4 barg; THE ACTUAL PUMP 0751-P-209AB SHUT-OFF PRESSURE IS 13.8 barg.
17. AIRFLOW NUMBER OF PASSES IS 6.


Z1	04-11-14	IAB	ISSUED FOR AS BUILT	PCA	MAR	AS
2.1F	18-04-14	IFC	ISSUED FOR CONSTRUCTION	PCA	MAR	AS
2.1E	28-02-14	IFC	ISSUED FOR CONSTRUCTION	PCA	MAR	AS
2.1D	09-03-13	IFC	ISSUED FOR CONSTRUCTION	RL	CN	M2
2.1C	31-10-12	IFC	ISSUED FOR CONSTRUCTION	RL	MF	M2
2.1B	06-08-12	IFC	ISSUED FOR CONSTRUCTION	DSC	CBR	SIN
2	29-12-11	IFC	ISSUED FOR CONSTRUCTION	DSC	CBR	SIN
1	12-08-11	IFCH	ISSUED FOR CONSTRUCTION WITH HOLDS	DSC	CBR	SIN
0	01-03-11	IFD	ISSUED CLIENT COMMENTS INCORPORATED	BSC	LMA	SIN
B1	30-09-10	ICR	ISSUED FOR CLIENT REVIEW	BSC	LMA	SIN
REV	DATE	STATUS	STATUS DESCRIPTION	BY	CKD	APP

REV.


21

THIS DOCUMENT IS THE PROPERTY OF ABU DHABI GAS DEVELOPMENT COMPANY LIMITED AND CONTAINS INFORMATION WHICH IS PROPRIETARY. THIS INFORMATION IS TO BE HELD IN CONFIDENCE. NO DISCLOSURE OR OTHER USE OF THIS DOCUMENT IS TO BE MADE WITHOUT THE PRIOR WRITTEN CONSENT OF ABU DHABI GAS DEVELOPMENT COMPANY LIMITED.

PLAN 23/65 FOR OH PUMPS

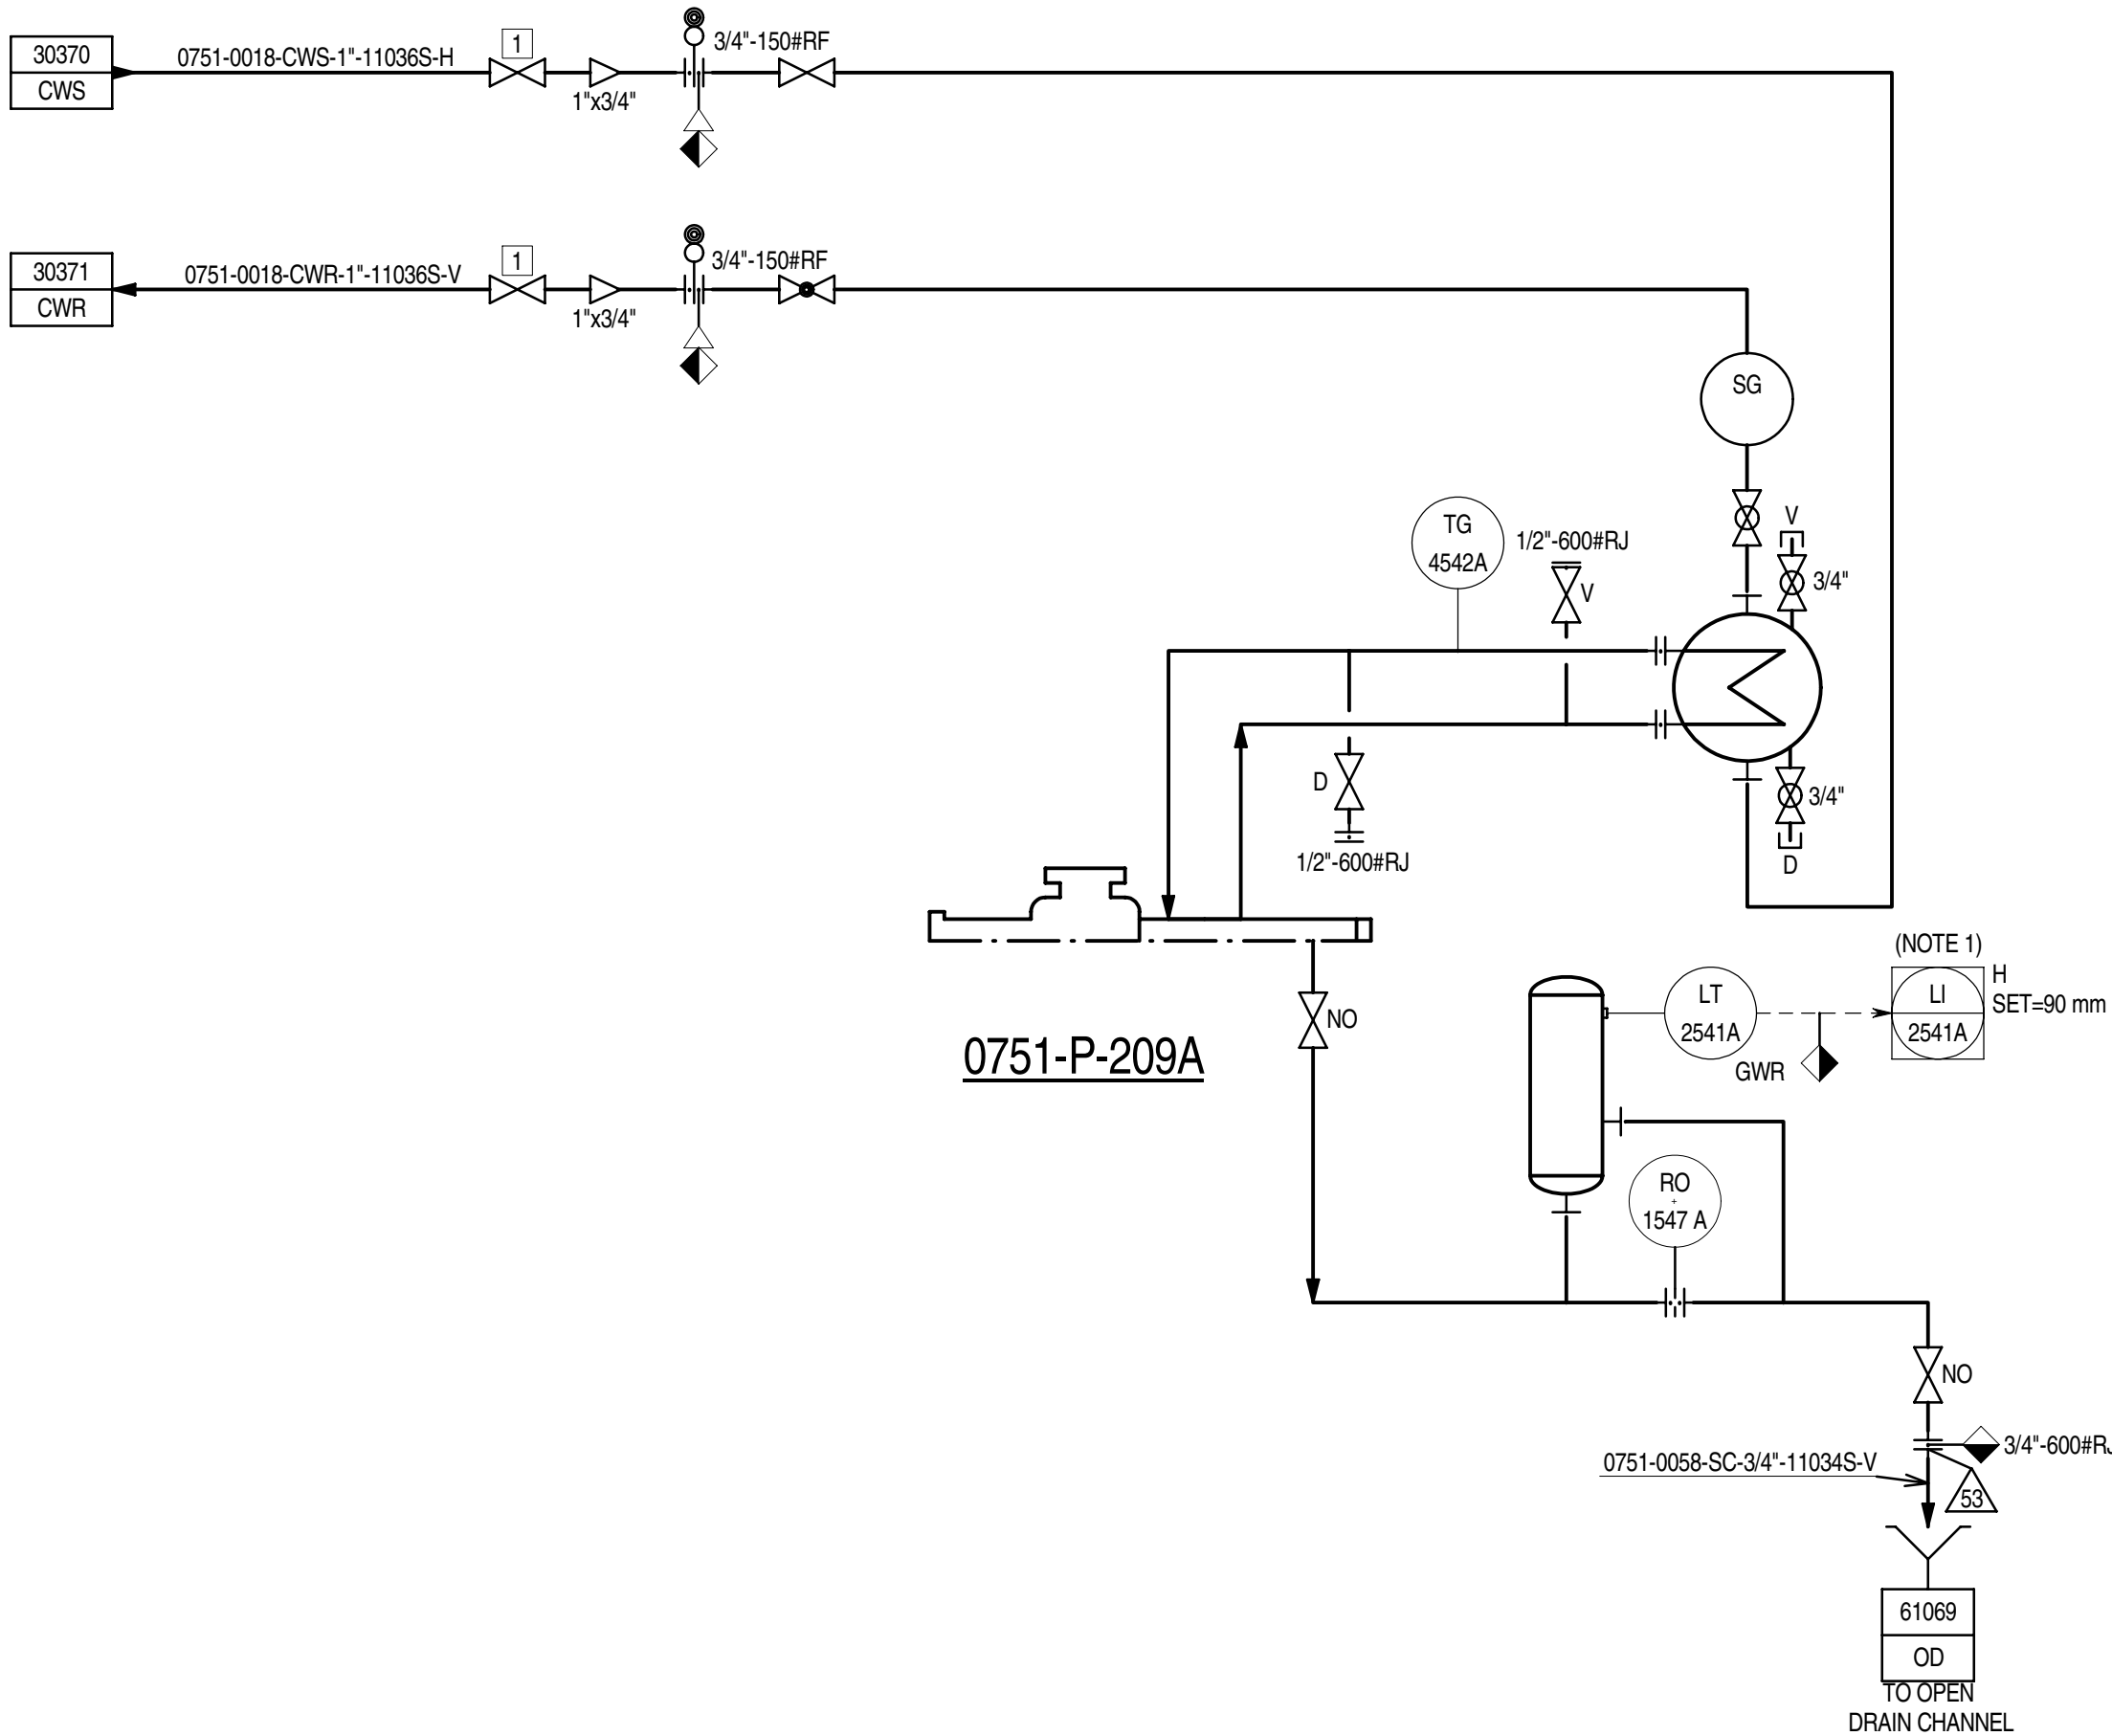

PLAN 23/65 FOR OH PUMPS

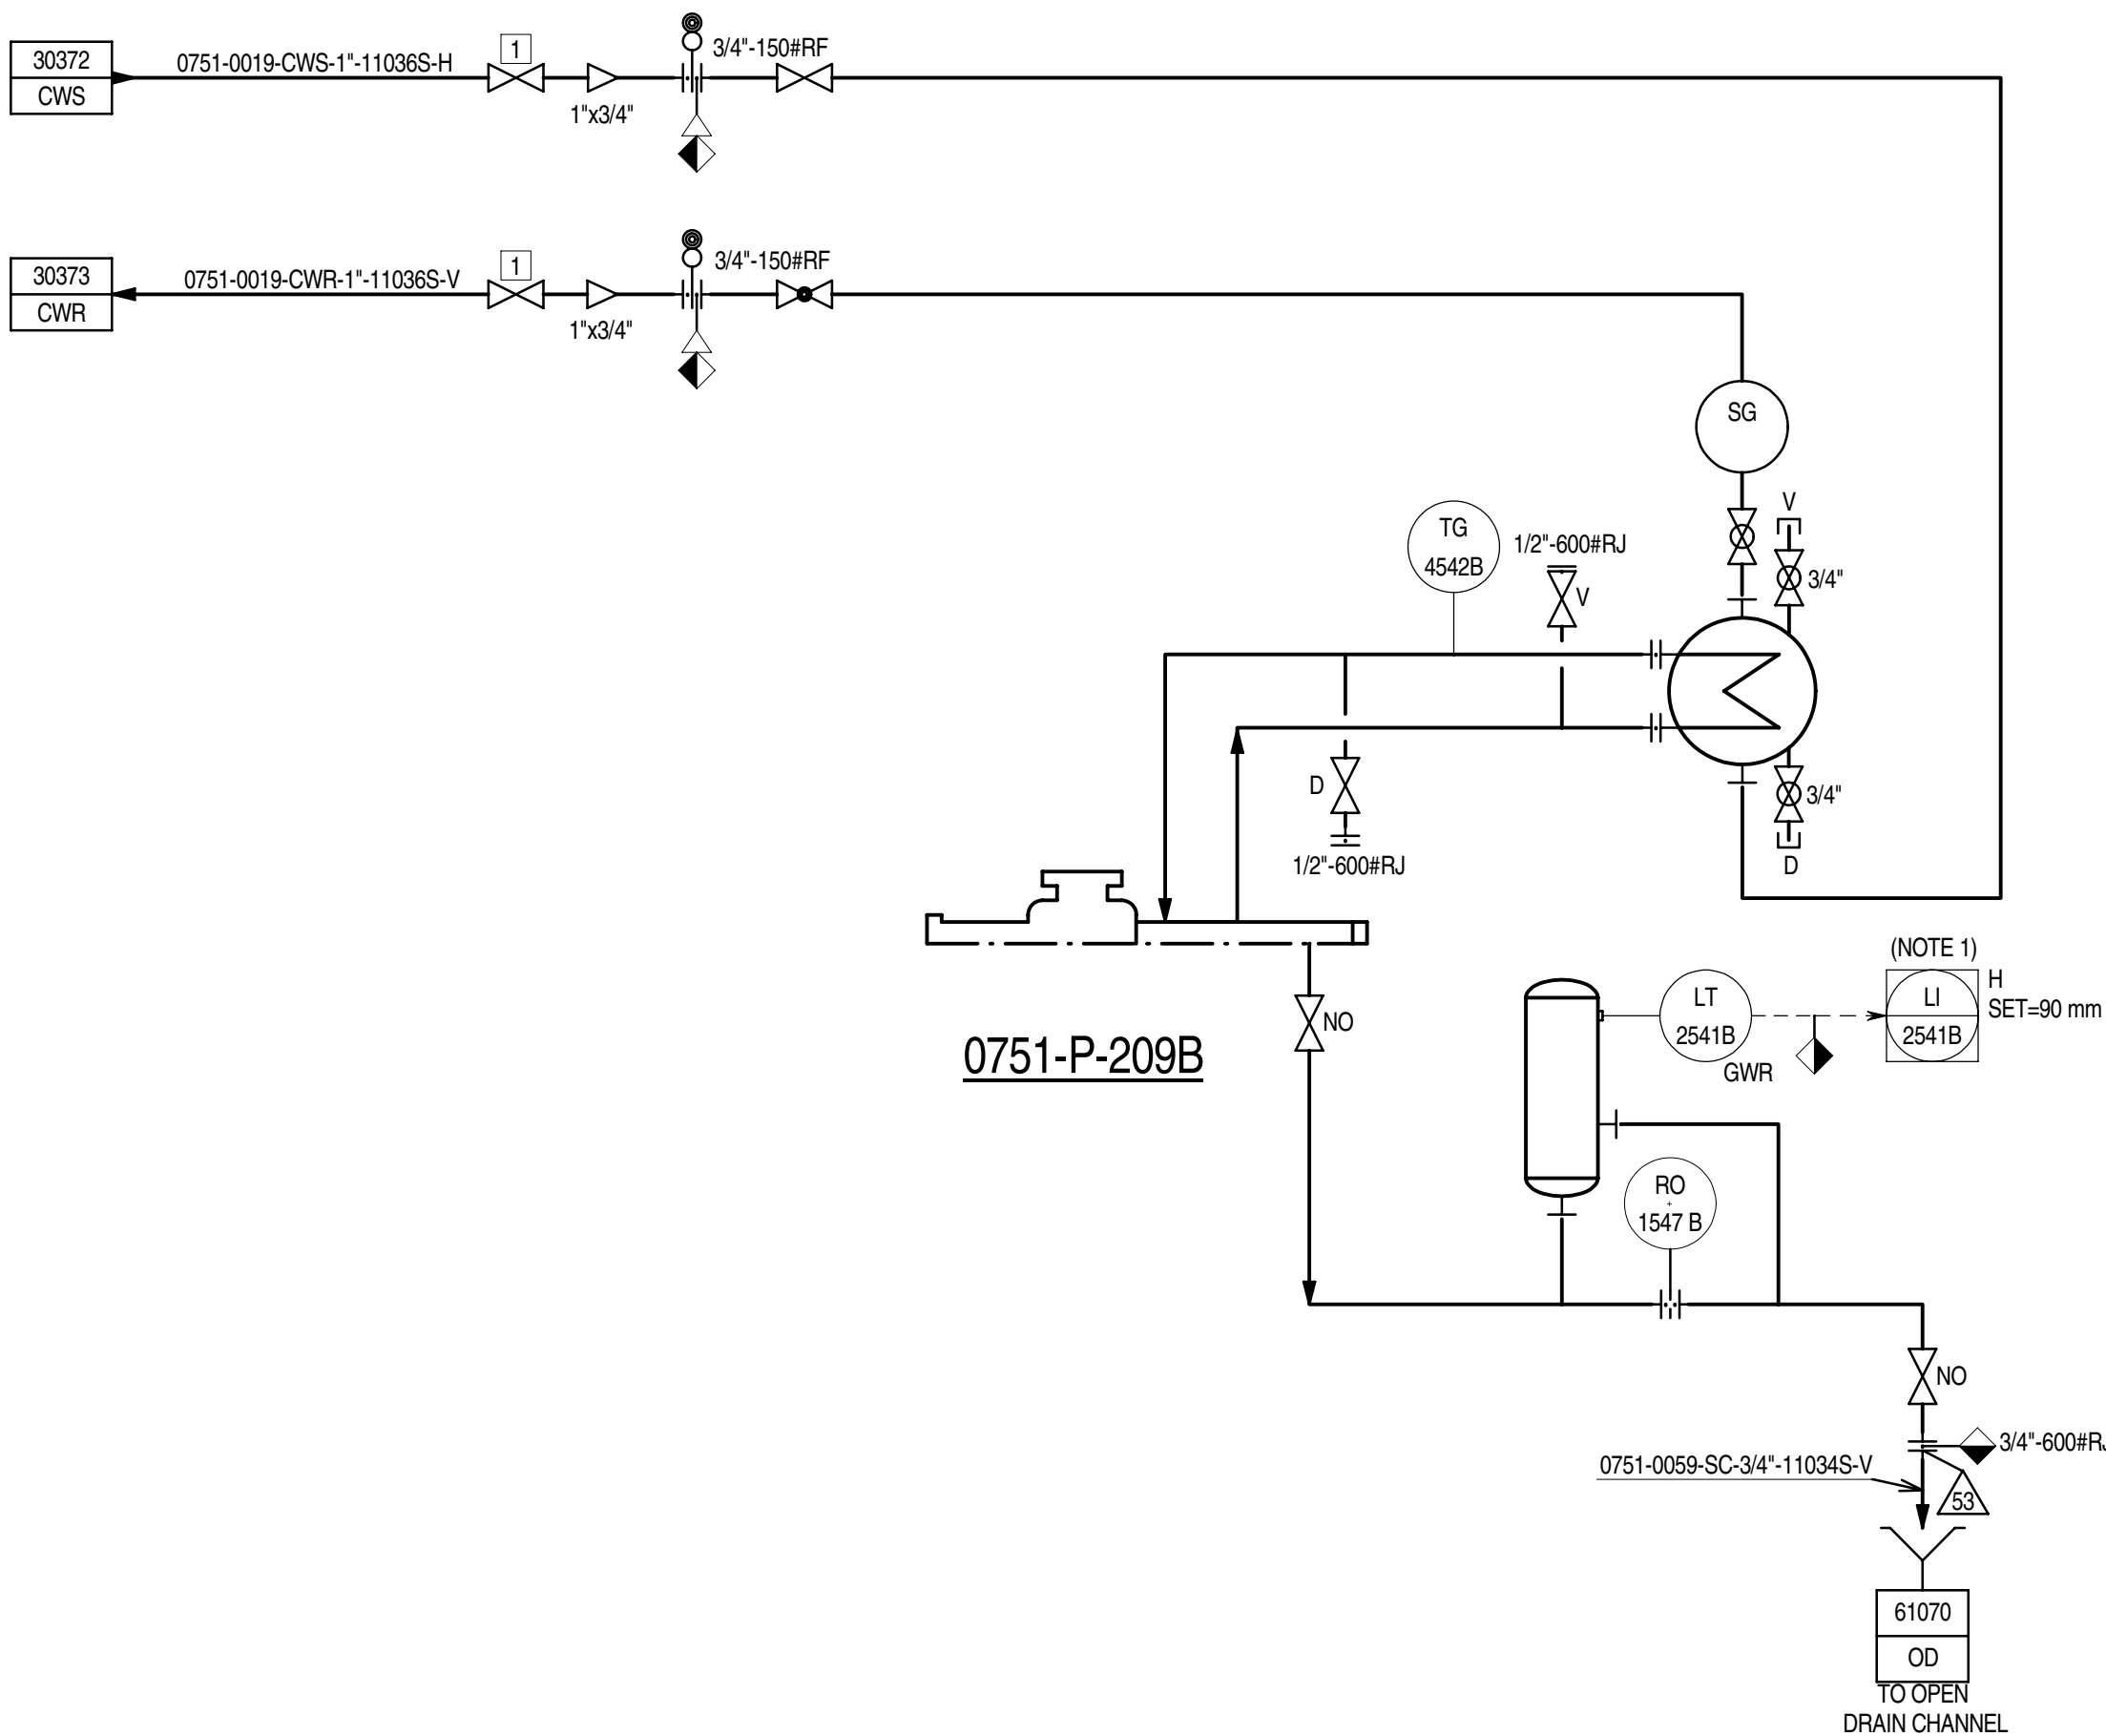

- GENERAL NOTES:**
- FOR STANDARD SYMBOLS, DETAILS, ABBREVIATIONS, SAMPLE CONNECTION TYPE, GENERAL NOTES & LEGEND SHEETS REFER TO DRAWING NO. MP02-0230-00-004000 TO 004015.
 - ALL INSTRUMENT TAG NUMBERS ON THIS P&ID INCLUDING PACKAGE UNITS ARE PREFIXED WITH UNIT NUMBER 0751 UNLESS OTHERWISE NOTED.
 - DELETED.

- NOTES:**
- ALARM VALUES BY PUMP VENDOR.

UTILITY REFERENCE TABLE		
CWS/CWR	DRW. N°.	SR03-0751-00-PID-362308
OD	DRW. N°.	SR03-0751-00-PID-362307

Z1	04-11-14	IAB	ISSUED FOR AS BUILT	PCA	MAR	ASP
2.1F	18-04-14	IFC	ISSUED FOR CONSTRUCTION	PCA	MAR	ASP
2.1E	28-02-14	IFC	ISSUED FOR CONSTRUCTION	PCA	MAR	ASP
2.1D	01-05-13	IFC	ISSUED FOR CONSTRUCTION	RL	CN	MZ
2.1C	31-10-12	IFC	ISSUED FOR CONSTRUCTION	RL	MF	MZ
2.1B	06-08-12	IFC	ISSUED FOR CONSTRUCTION	DSC	CBR	SIN
2	29-12-11	IFC	ISSUED FOR CONSTRUCTION	DSC	CBR	SIN
1	12-08-11	IFCH	ISSUED FOR CONSTRUCTION WITH HOLDS	DSC	CBR	SIN
REV	DATE	STATUS	STATUS DESCRIPTION	BY	CKD	APP.

COMPANY: Abu Dhabi Gas Development Co. Ltd.



CONTRACTOR: 
JOB No. 032090

PROJECT: SHAH GAS DEVELOPMENT (SGD) PROJECT
AGREEMENT No. 13525001

DRAWING TITLE: PIPING & INSTRUMENT DIAGRAM UNIT 0751
SULPHUR RECOVERY AND TAIL GAS TREATING UNIT

EQUIPMENT DESCRIPTION: API PLAN 0751-P-209A/B
TAGITEM No.

CONTRACTOR DRG. No.	751-GD-B-303362	REV. Z1
COMPANY DRG. No.	SR03-0751-00-303362-002	
SCALE:	SIZE: A1 DOC. CLASS: 1	

1. PI-3149B TO BE READABLE FROM PSV-8041A/B MANUAL VENT VALVE.
2. SYMMETRICAL PIPING.
3. LOCATE LV-2081 AT GRADE AT MIN. DISTANCE FROM INLET NOZZLE OF 0751-E-203B
4. LI-2081 AND TI-4159 TO BE READABLE FROM LV-2081 BYPASS VALVE.
5. PSV-8041A/B SIZING CASE: FIRE.
6. DRAIN VALVES TO BE INSTALLED CLOSE TO THE LINE/EQUIPMENT TO BE DRAINED.
7. PI-3205B TO BE READABLE FROM PSV-8049A/B MANUAL VENT VALVE.
8. PSV-8049A/B SIZING CASE: TUBE RUPTURE.
9. USE 45° TOP ENTRY CONNECTION.
10. FLANGES PROVIDED WITH PROTECTORS (METAL SPRAYCONTROL).

Z1	04-11-14	IAB	ISSUED FOR AS BUILT	PCA	MAR	ASP
2.1D	18-04-14	IFC	ISSUED FOR CONSTRUCTION	PCA	MAR	ASP
2.1C	10-03-13	IFC	ISSUED FOR CONSTRUCTION	RL	CN	MZ
2.1B	06-08-12	IFC	ISSUED FOR CONSTRUCTION	DSC	CBR	SIN
2	29-12-11	IFC	ISSUED FOR CONSTRUCTION	DSC	CBR	SIN
1	12-08-11	IFCH	ISSUED FOR CONSTRUCTION WITH HOLDS	DSC	CBR	SIN
0	01-03-11	IFD	ISSUED CLIENT COMMENTS INCORPORATED	BSC	LMA	SIN
B1	30-09-10	ICR	ISSUED FOR CLIENT REVIEW	BSC	LMA	SIN
REV	DATE	STATUS	STATUS DESCRIPTION	BY	CKD	APP.

JOB No. 032090

SHAH GAS DEVELOPMENT (SGD) PROJECT

DRAWING TITLE: PIPING & INSTRUMENT DIAGRAM UNIT 0751
SULPHUR RECOVERY AND TAIL GAS TREATING UNIT

EQUIPMENT DESCRIPTION		CONTACT CONDENSER TRIM COOLER	
TAGITEM No.		0751-E-203B	
CONTRACTOR DRG. No.		751-GD-B-303363	
COMPANY DRG. No.		SR03-0751-00-303363	
SCALE:	SIZE: A1	DOC. CLASS: 1	REV. Z1

THIS DOCUMENT IS THE PROPERTY OF ABU DHABI GAS DEVELOPMENT COMPANY LIMITED AND CONTAINS INFORMATION WHICH IS PROPRIETARY. THIS INFORMATION IS TO BE HELD IN CONFIDENCE. NO DISCLOSURE OR OTHER USE OF THIS DOCUMENT IS TO BE MADE WITHOUT THE PRIOR WRITTEN CONSENT OF ABU DHABI GAS DEVELOPMENT COMPANY LIMITED.


0751-P-213A / B
CENTRAL PLOT OILY WATER SUMP PUMPS

RATED FLOW: 20.00 m³/hr
DIFFERENTIAL HEAD: 38 m
SG @ OP TEMP: 1.000 @ 60 C
SUCTION PRESSURE: 0.04 barg
DISCHARGE PRESSURE: 3.8 barg
DESIGN TEMPERATURE: 5 C / 90 C
MATERIAL: DUPLEX 2205
DRIVER: 11.00 kW
SPEED: 2930 rpm
TRIM: ---

0751-SU-203
CENTRAL PLOT OILY WATER SUMP

WORKING CAPACITY: 9.0 m³
SIZE: 4425 mm (L) x 4500 mm(W) x 6100 mm (H)
DESIGN CONDITION: ATM + FULL OF WATER @ 90 C
MATERIAL: CONCRETE / INTERNAL: SS
TRIM: ---

TRIM: VT-0064-18032S-KV (FOR NOZZLE N4)
VT-0120-13091S-V (FOR LT-2082 PROBE)
VT-0164-18032S-V (FOR NOZZLE N5)
VT-0165-13091S-KV (FOR NOZZLE N5-BLIND FLANGE)
VT-0166-18032S-KV (FOR NOZZLE N8)
VT-0167-13091S-V (FOR LT-2083 PROBE)
VT-0168-18032S-KV (FOR NOZZLE N6)
VT-0169-13091S-V (FOR NOZZLE N6-BLIND FLANGE)
VT-0170-18032S-KV (FOR NOZZLE N9)
VT-0171-18032S-KV (FOR NOZZLE N7)

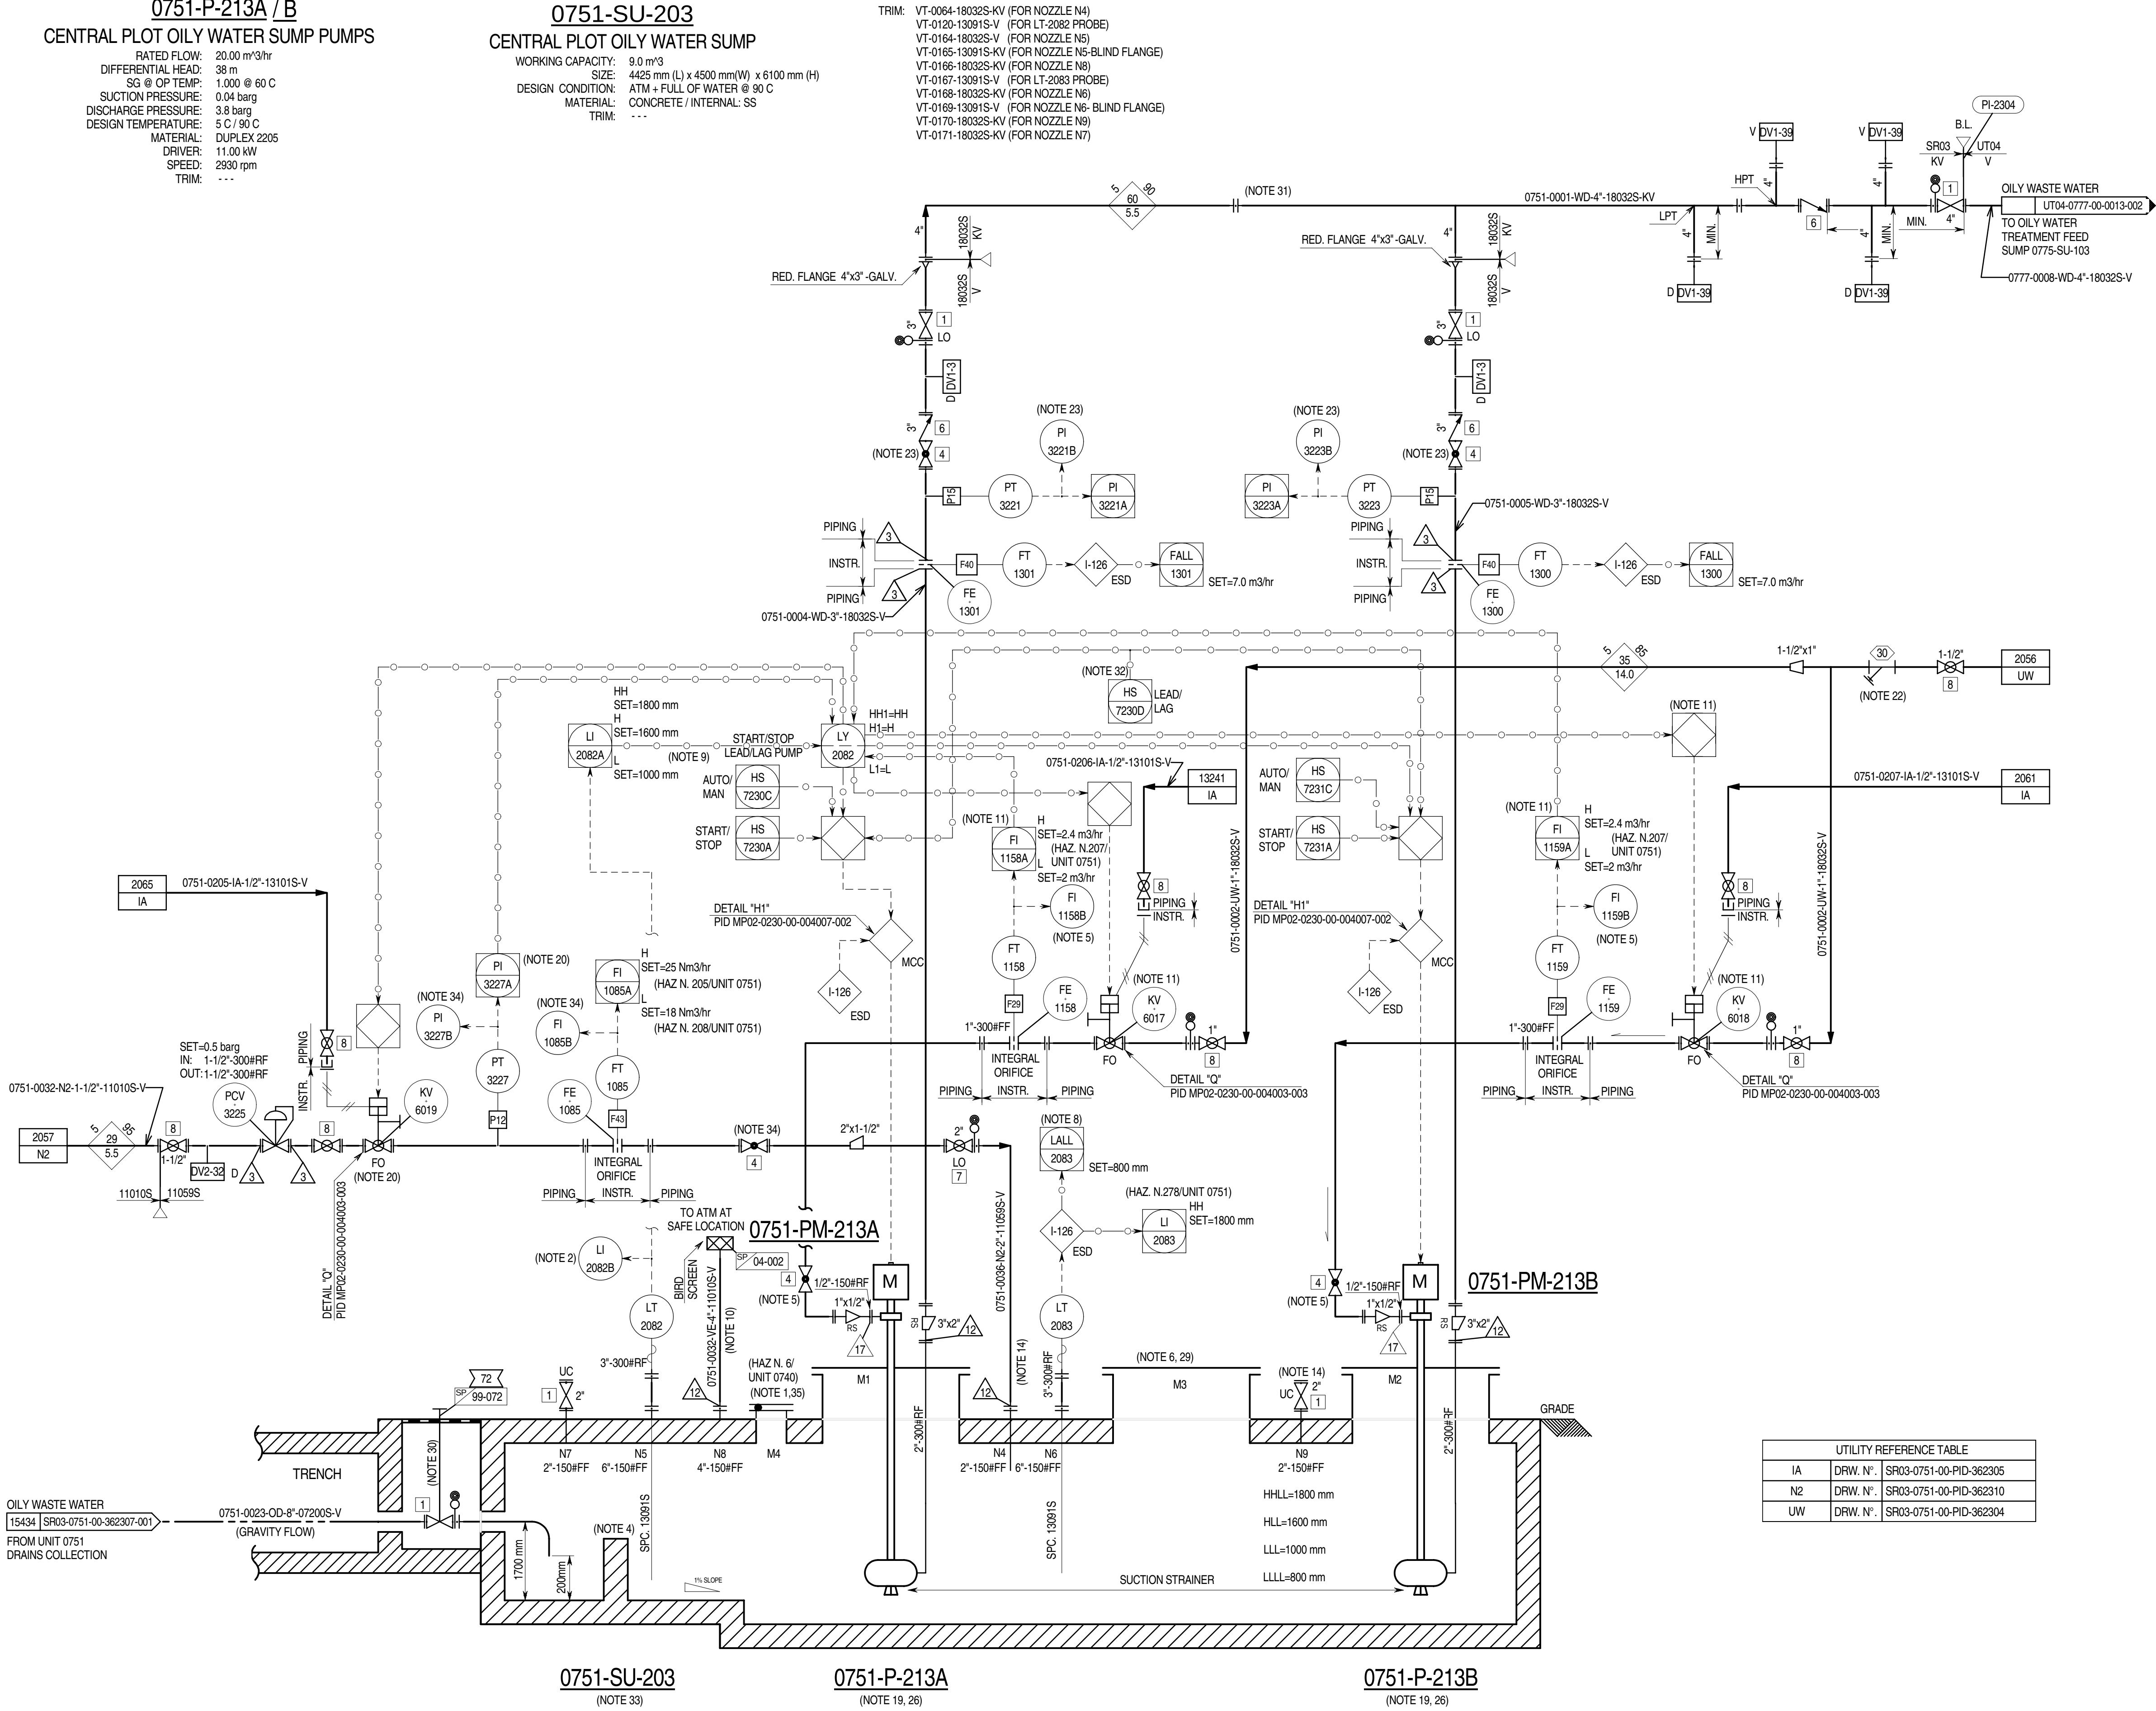

- GENERAL NOTES:
- FOR STANDARD SYMBOLS, DETAILS, ABBREVIATIONS, SAMPLE CONNECTION TYPE, GENERAL NOTES & LEGEND SHEETS REFER TO DRAWING NO. MP02-0230-00-0040000 TO 004015.
 - ALL INSTRUMENT TAG NUMBERS ON THIS P&ID INCLUDING PACKAGE UNITS ARE PREFIXED WITH UNIT NUMBER 0751 UNLESS OTHERWISE NOTED.
 - DELETED.
 - DELETED.
 - PROVIDE A PROTECTION GUARD AROUND THE EXPLOSION HATCH WITH CHAIN (HAZ N. 201/UNIT 0751) TO PREVENT OBJECTS TO BE PLACED ABOVE IT. (HAZ N. 7/UNIT 0740)
 - LI-2082B TO BE REDABLE FROM PUMP LOCAL PANEL.
 - DELETED.
 - BAFFLE REQUIRED TO PROTECT PUMP FROM MAJOR SOLIDS CONTAMINATION.
 - FI-1158B AND FI-1159B TO BE REDABLE FROM CORRESPONDING LOCAL GLOBE VALVE.
 - MANWAY ACCESS FOR SOLID REMOVAL.
 - DELETED.
 - 0751-P-213A/B SHUTDOWN ON LOW LOW LIQUID LEVEL (LALL-2083) IN OILY WASTE WATER COMPARTMENT OF SUMP 0751-SU-203.
 - AT LAH-2082A LEAD PUMP STARTS, AT LAHH-2082A LAG PUMP STARTS AT LAL-2082 BOTH PUMPS STOP.
 - VENT SHALL BE LOCATED AT THE OPPOSITE END OF SUMP FROM THE N2 SUPPLY.
 - BEARING FLUSHING WATER VALVES KV-6017/6018 SHALL OPEN BEFORE THE RELEVANT PUMP STARTS. TIME DELAY IS PROVIDED TO START THE PUMP AFTER A PERMISSIVE SIGNAL FROM FT-1158A/1159A. PUMP WILL STOP IF THE RELEVANT PERMISSIVE SIGNAL IS LOST WHILE IT IS RUNNING. BEARING FLUSHING WATER VALVES KV-6017/6018 SHALL CLOSE WHEN RESPECTIVE PUMP STOPS REFER TO PROCESS CONTROL NARRATIVE SR03-0751-15-SPE-303163
 - DELETED.
 - DELETED.
 - NITROGEN SUPPLY AND UTILITY CONNECTION SHALL BE AS CLOSE AS POSSIBLE TO THE PUMPS LOCATION.
 - DELETED.
 - DELETED.
 - DELETED.
 - DELETED.
 - PUMPS ARE 2X100% (ONE LEAD AND ONE LAG).
 - NITROGEN VALVE KV-6019 SHALL OPEN BEFORE ANY OF THE PUMPS STARTS. TIME DELAY IS PROVIDED TO START THE PUMP AFTER A PERMISSIVE SIGNAL FROM PT-3227 (HAZ. N.5/UNIT 0740). ANY OPERATING PUMP WILL STOP IF NITROGEN PRESSURE IS LOWER THAN PERMISSIVE SET POINT WHILE THEY ARE RUNNING. NITROGEN VALVE KV-6019 SHALL CLOSE WHEN ALL PUMPS STOP. REFER TO PROCESS CONTROL NARRATIVE SR03-0751-15-SPE-303163.
 - DELETED.
 - STRAINER WITH SCREEN 270 MESH.
 - PI-3221B AND PI-3223B TO BE REDABLE FROM CORRESPONDING LOCAL GLOBE VALVES.
 - DELETED.
 - INTERLOCK TABLE IS FOR REFERENCE ONLY. CAUSE AND EFFECT MATRIX SR03-0751-00-CCC-303155 SHALL GOVERN.
 - REFER TO PROCESS CONTROL NARRATIVE SR03-0751-15-SPE-303163 FOR PERMISSIVE TO START CONDITIONS.
 - DELETED.
 - REFER TO CAUSE AND EFFECT CHART FOR FULL REPRESENTATION OF INTERLOCK INITIATORS AND ACTIONS.
 - PROVIDED LADDER FOR SUMP INSPECTION AND MAINTENANCE.
 - VALVE TO BE OPERABLE FROM GRADE.
 - PREFABRICATED PIPE SPOOL SHALL HAVE FLANGED END ACCORDING TO "FBE" REQUIREMENT. REFER TO DOC. N. MP02-0230-66-SPE-060704.
 - LEAD/LAG PUMP CAN BE SELECTED THROUGH HS-7230D. (HAZ N.197/UNIT 0751)
 - ONE SUMP PER UNIT, TOTAL OF FOUR SUMPS.
 - PI-3227B AND FI-1085B TO BE READABLE FROM CORRESPONDING LOCAL GLOBE VALVE. GLOBE VALVE SHALL BE CAR SEALED AFTER START-UP ONCE THE CORRECT OPENING PERCENTAGE HAS BEEN DEFINED.
 - EXPLOSION HATCH IS EXPECTED TO BE OPENED BY A PRESSURE OF 15 mbarg INSIDE THE SUMP. (TDR)

Z1	04-11-14	IAB	ISSUED FOR AS BUILT	PCA	MAR	ASP
2.1E	18-04-14	IFC	ISSUED FOR CONSTRUCTION	PCA	MAR	ASP
2.1D	28-02-14	IFC	ISSUED FOR CONSTRUCTION	PCA	MAR	ASP
2.1C	31-10-12	IFC	ISSUED FOR CONSTRUCTION	RL	MF	MZ
2.1B	06-08-12	IFC	ISSUED FOR CONSTRUCTION	DSC	CBR	SIN
2	29-12-11	IFC	ISSUED FOR CONSTRUCTION	DSC	CBR	SIN
1	12-08-11	IFCH	ISSUED FOR CONSTRUCTION WITH HOLDS	DSC	CBR	SIN
0	01-03-11	IFD	ISSUED CLIENT COMMENTS INCORPORATED	BSC	LMA	SIN
B1	30-09-10	ICR	ISSUED FOR CLIENT REVIEW	BSC	LMA	SIN
REV	DATE	STATUS	STATUS DESCRIPTION	BY	CKD	APP.

COMPANY:

Abu Dhabi Gas Development Co. Ltd.

الحسن للغاز
Al Hosn Gas

CONTRACTOR:

eni saipem

JOB No. 032090

PROJECT:

SHAH GAS DEVELOPMENT (SGD) PROJECT

AGREEMENT No. 13525001

DRAWING TITLE:

PIPING & INSTRUMENT DIAGRAM UNIT 0751
SULPHUR RECOVERY AND TAIL GAS TREATING UNIT


EQUIPMENT DESCRIPTION	OILY WATER SUMP AND PUMPS
TAGITEM No.	0751-P-213A / B 0751-SU-203

CONTRACTOR DRG. No.	751-GD-B-303364	REV. Z1
COMPANY DRG. No.	SR03-0751-00-303364-001	
SCALE:	SIZE: A1 DOC. CLASS: 1	


INTERLOCK TABLE (NOTE 25)		
INTERLOCK NUMBER	LOGIC DESCRIPTION (NOTE 28)	REFERENCE DOCUMENT N.
I-126	CENTRAL PLOT OILY WATER SUMP PUMPS	SR03-0751-00-303375

THIS DOCUMENT IS THE PROPERTY OF ABU DHABI GAS DEVELOPMENT COMPANY LIMITED AND CONTAINS INFORMATION WHICH IS PROPRIETARY. THIS INFORMATION IS TO BE HELD IN CONFIDENCE. NO DISCLOSURE OR OTHER USE OF THIS DOCUMENT IS TO BE MADE WITHOUT THE PRIOR WRITTEN CONSENT OF ABU DHABI GAS DEVELOPMENT COMPANY LIMITED.

PLAN 02 FOR VS4 PUMPS

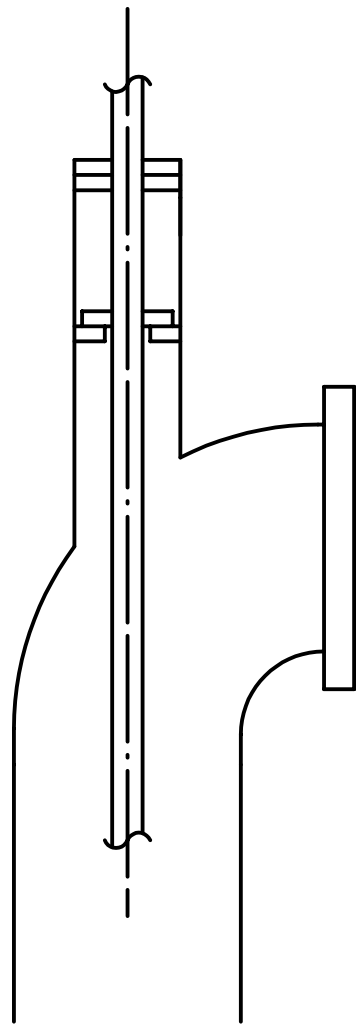

PLAN 02 FOR VS4 PUMPS

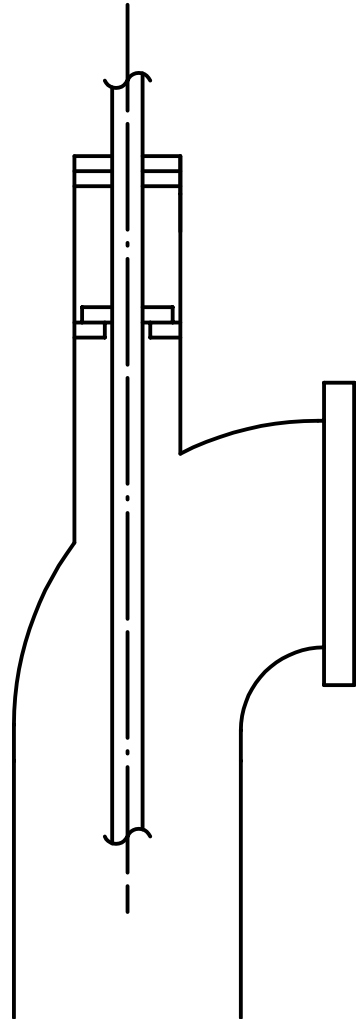

- GENERAL NOTES:
- FOR STANDARD SYMBOLS, DETAILS, ABBREVIATIONS, SAMPLE CONNECTION TYPE, GENERAL NOTES & LEGEND SHEETS REFER TO DRAWING NO. MP02-0230-00-004000 TO 004015.
 - ALL INSTRUMENT TAG NUMBERS ON THIS P&ID INCLUDING PACKAGE UNITS ARE PREFIXED WITH UNIT NUMBER 0751 UNLESS OTHERWISE NOTED.
 - DELETED.

Z1	04-11-14	IAB	ISSUED FOR AS BUILT	PCA	MAR	ASP
2.1E	18-04-14	IFC	ISSUED FOR CONSTRUCTION	PCA	MAR	ASP
2.1D	28-02-14	IFC	ISSUED FOR CONSTRUCTION	PCA	MAR	ASP
2.1C	31-10-12	IFC	ISSUED FOR CONSTRUCTION	RL	MF	MZ
2.1B	06-08-12	IFC	ISSUED FOR CONSTRUCTION	DSC	CBR	SIN
2	29-12-11	IFC	ISSUED FOR CONSTRUCTION	DSC	CBR	SIN
1	12-08-11	IFCH	ISSUED FOR CONSTRUCTION WITH HOLDS	DSC	CBR	SIN
REV	DATE	STATUS	STATUS DESCRIPTION	BY	CKD	APP.

COMPANY:

Abu Dhabi Gas Development Co. Ltd.

CONTRACTOR:

JOB No. 032090

PROJECT:

SHAH GAS DEVELOPMENT (SGD) PROJECT

AGREEMENT No. 13525001


DRAWING TITLE:

PIPING & INSTRUMENT DIAGRAM UNIT 0751
SULPHUR RECOVERY AND TAIL GAS TREATING UNIT

EQUIPMENT DESCRIPTION	API PLAN 0751-P-213		
TAGITEM No.			

CONTRACTOR DRG.No.	751-GD-B-303364	REV. Z1
COMPANY DRG.No.	SR03-0751-00-303364-002	
SCALE:	SIZE: A1 DOC. CLASS: 1	

THIS DOCUMENT IS THE PROPERTY OF ABU DHABI GAS DEVELOPMENT COMPANY LIMITED AND CONTAINS INFORMATION WHICH IS PROPRIETARY. THIS INFORMATION IS TO BE HELD IN CONFIDENCE. NO DISCLOSURE OR OTHER USE OF THIS DOCUMENT IS TO BE MADE WITHOUT THE PRIOR WRITTEN CONSENT OF ABU DHABI GAS DEVELOPMENT COMPANY LIMITED.

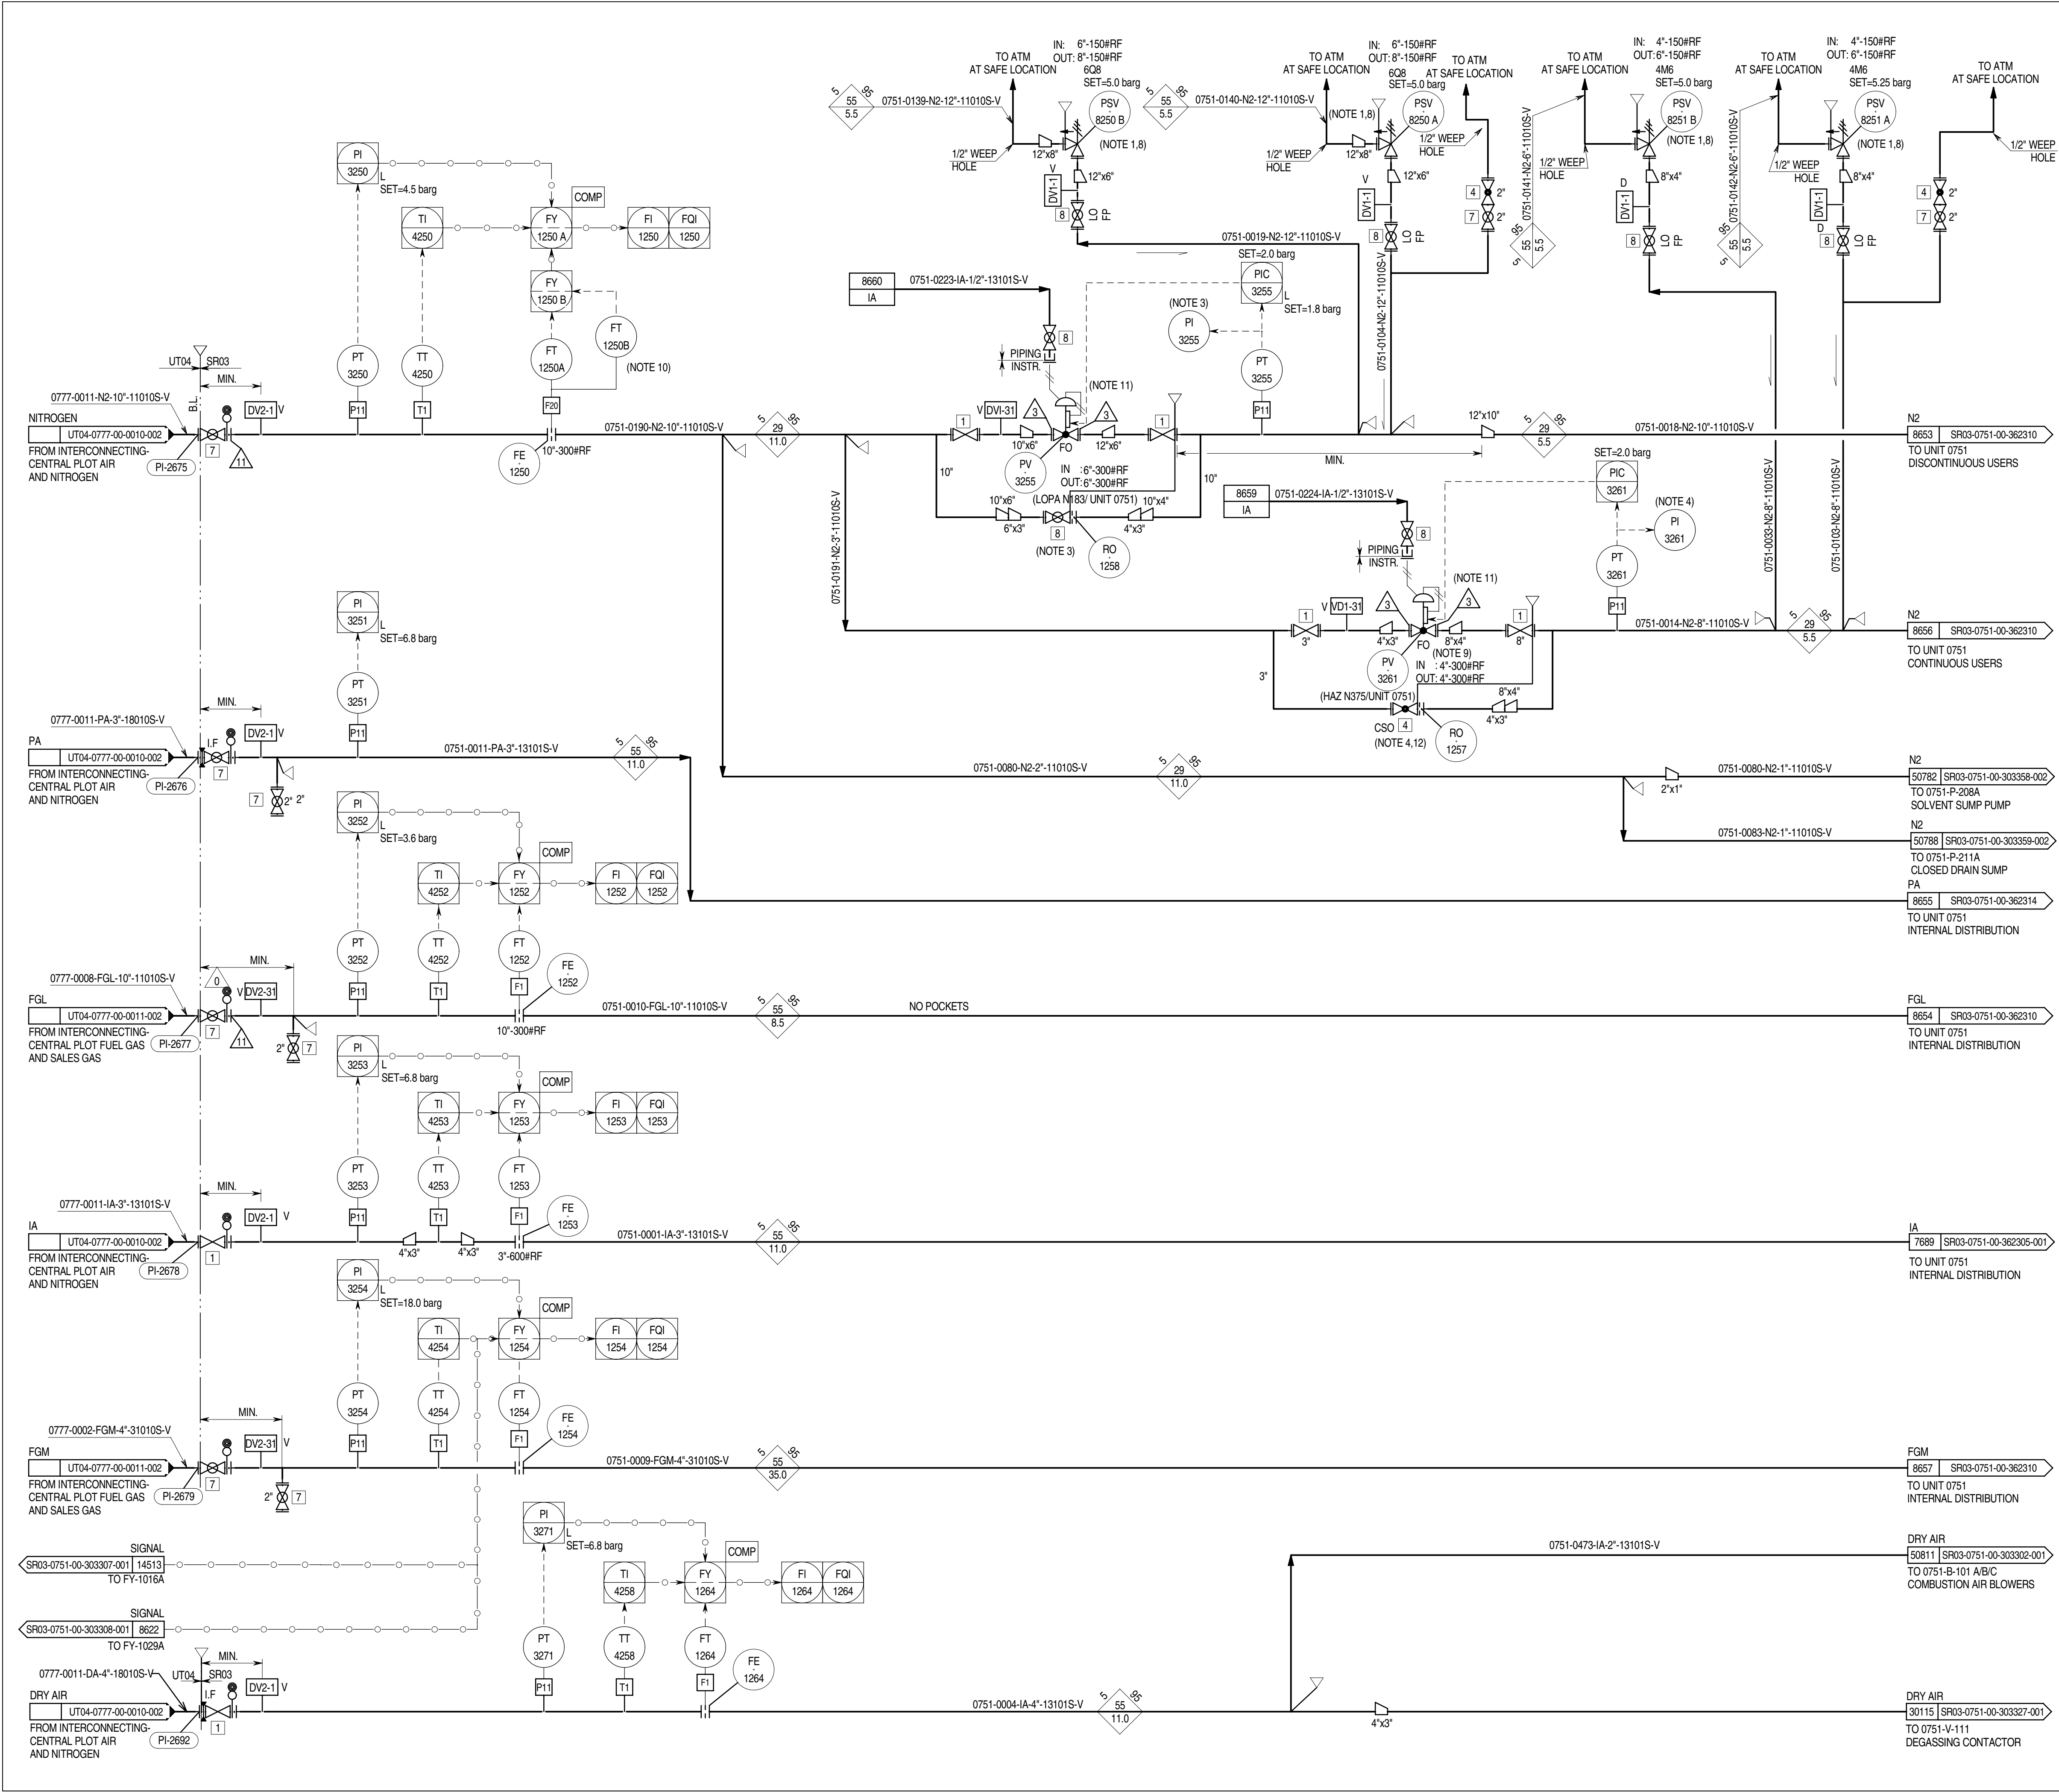

- GENERAL NOTES:**
- FOR STANDARD SYMBOLS, DETAILS, ABBREVIATIONS, SAMPLE CONNECTION TYPE, GENERAL NOTES & LEGEND SHEETS REFER TO DRAWING NO. MP02-0230-00-004000 TO 004015.
 - ALL INSTRUMENT TAG NUMBERS ON THIS P&ID INCLUDING PACKAGE UNITS ARE PREFIXED WITH UNIT NUMBER 751 UNLESS OTHERWISE NOTED.
- NOTES:**
- PROVIDE WAREHOUSE SPARE PSV-8250Z AND PSV-8251Z.
 - DELETED.
 - PI-3255 TO BE READABLE FROM OF PV-36255, BYPASS BALL VALVE.
 - PI-3261 TO BE READABLE FROM OF PV-36261, BYPASS GLOBE VALVE.
 - DELETED.
 - DELETED.
 - DELETED.
 - PSV-8250A/B AND PSV-8251A/B SIZING CASE : GAS BLOW-BY
 - PV-3261 IS EQUIPPED WITH MECHANICAL STOP
 - N2 TRANSMITTERS SHALL BE PROVIDED TO COVER THE COMPLETE REQUEST INSTRUMENT RANGEABILITY:
- TRANSMITTER "A" → LOW RANGE
- TRANSMITTER "B" → HIGH RANGE
 - PV-3255 AND PV-3261 TO BE PROVIDED WITH LOCAL SIGN : " WARNING TRIM SIZE AFFECTS THE RELIEF VALVE CAPACITY".
 - PV-3261 MANUAL BY-PASS VALVE IS CAR SCALED OPEN IN POSITION. VALVE OPENING IS SET DURING UNIT START-UP SO TO ALLOW 323 Nm3/h TROUGH MANUAL VALVE. REFER TO O.M N° SR03-0751-00-MAN-303326 FOR DETAILS.


Z1	04-11-14	IAB	ISSUED FOR AS BUILT	PCA	MAR	ASP
2.1D	18-04-14	IFC	ISSUED FOR CONSTRUCTION	PCA	MAR	ASP
2.1C	28-02-14	IFC	ISSUED FOR CONSTRUCTION	PCA	MAR	ASP
2.1B	06-08-12	IFC	ISSUED FOR CONSTRUCTION	DSC	CBR	SIN
2	29-12-11	IFC	ISSUED FOR CONSTRUCTION	DSC	CBR	SIN
1	08-07-11	IFCH	ISSUED FOR CONSTRUCTION WITH HOLDS	BSC	LMA	SIN
0	28-02-11	IFD	ISSUED CLIENT COMMENTS INCORPORATED	BSC	LMA	SIN
B1	30-09-10	ICR	ISSUED FOR CLIENT REVIEW	BSC	LMA	SIN
REV	DATE	STATUS	STATUS DESCRIPTION	BY	CKD	APP.

COMPANY:

Abu Dhabi Gas Development Co. Ltd.



CONTRACTOR:

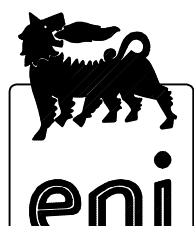

JOB No. 032090

PROJECT:

SHAH GAS DEVELOPMENT (SGD) PROJECT

AGREEMENT No. 13525001


DRAWING TITLE:

PIPING & INSTRUMENT DIAGRAM UNIT 0751
SULPHUR RECOVERY AND TAIL GAS TREATING UNIT

EQUIPMENT DESCRIPTION	N2, PLANT AIR, INSTR. AIR, DRY AIR & FUEL GAS HEADERS	
TAGITEM No.		

CONTRACTOR DRG. No.	751-GD-B-303367	REV. Z1
COMPANY DRG. No.	SR03-0751-00-303367	
SCALE:	SIZE: A1	DOC. CLASS: 1

THIS DOCUMENT IS THE PROPERTY OF ABU DHABI GAS DEVELOPMENT COMPANY LIMITED AND CONTAINS INFORMATION WHICH IS PROPRIETARY. THIS INFORMATION IS TO BE HELD IN CONFIDENCE. NO DISCLOSURE OR OTHER USE OF THIS DOCUMENT IS TO BE MADE WITHOUT THE PRIOR WRITTEN CONSENT OF ABU DHABI GAS DEVELOPMENT COMPANY LIMITED.

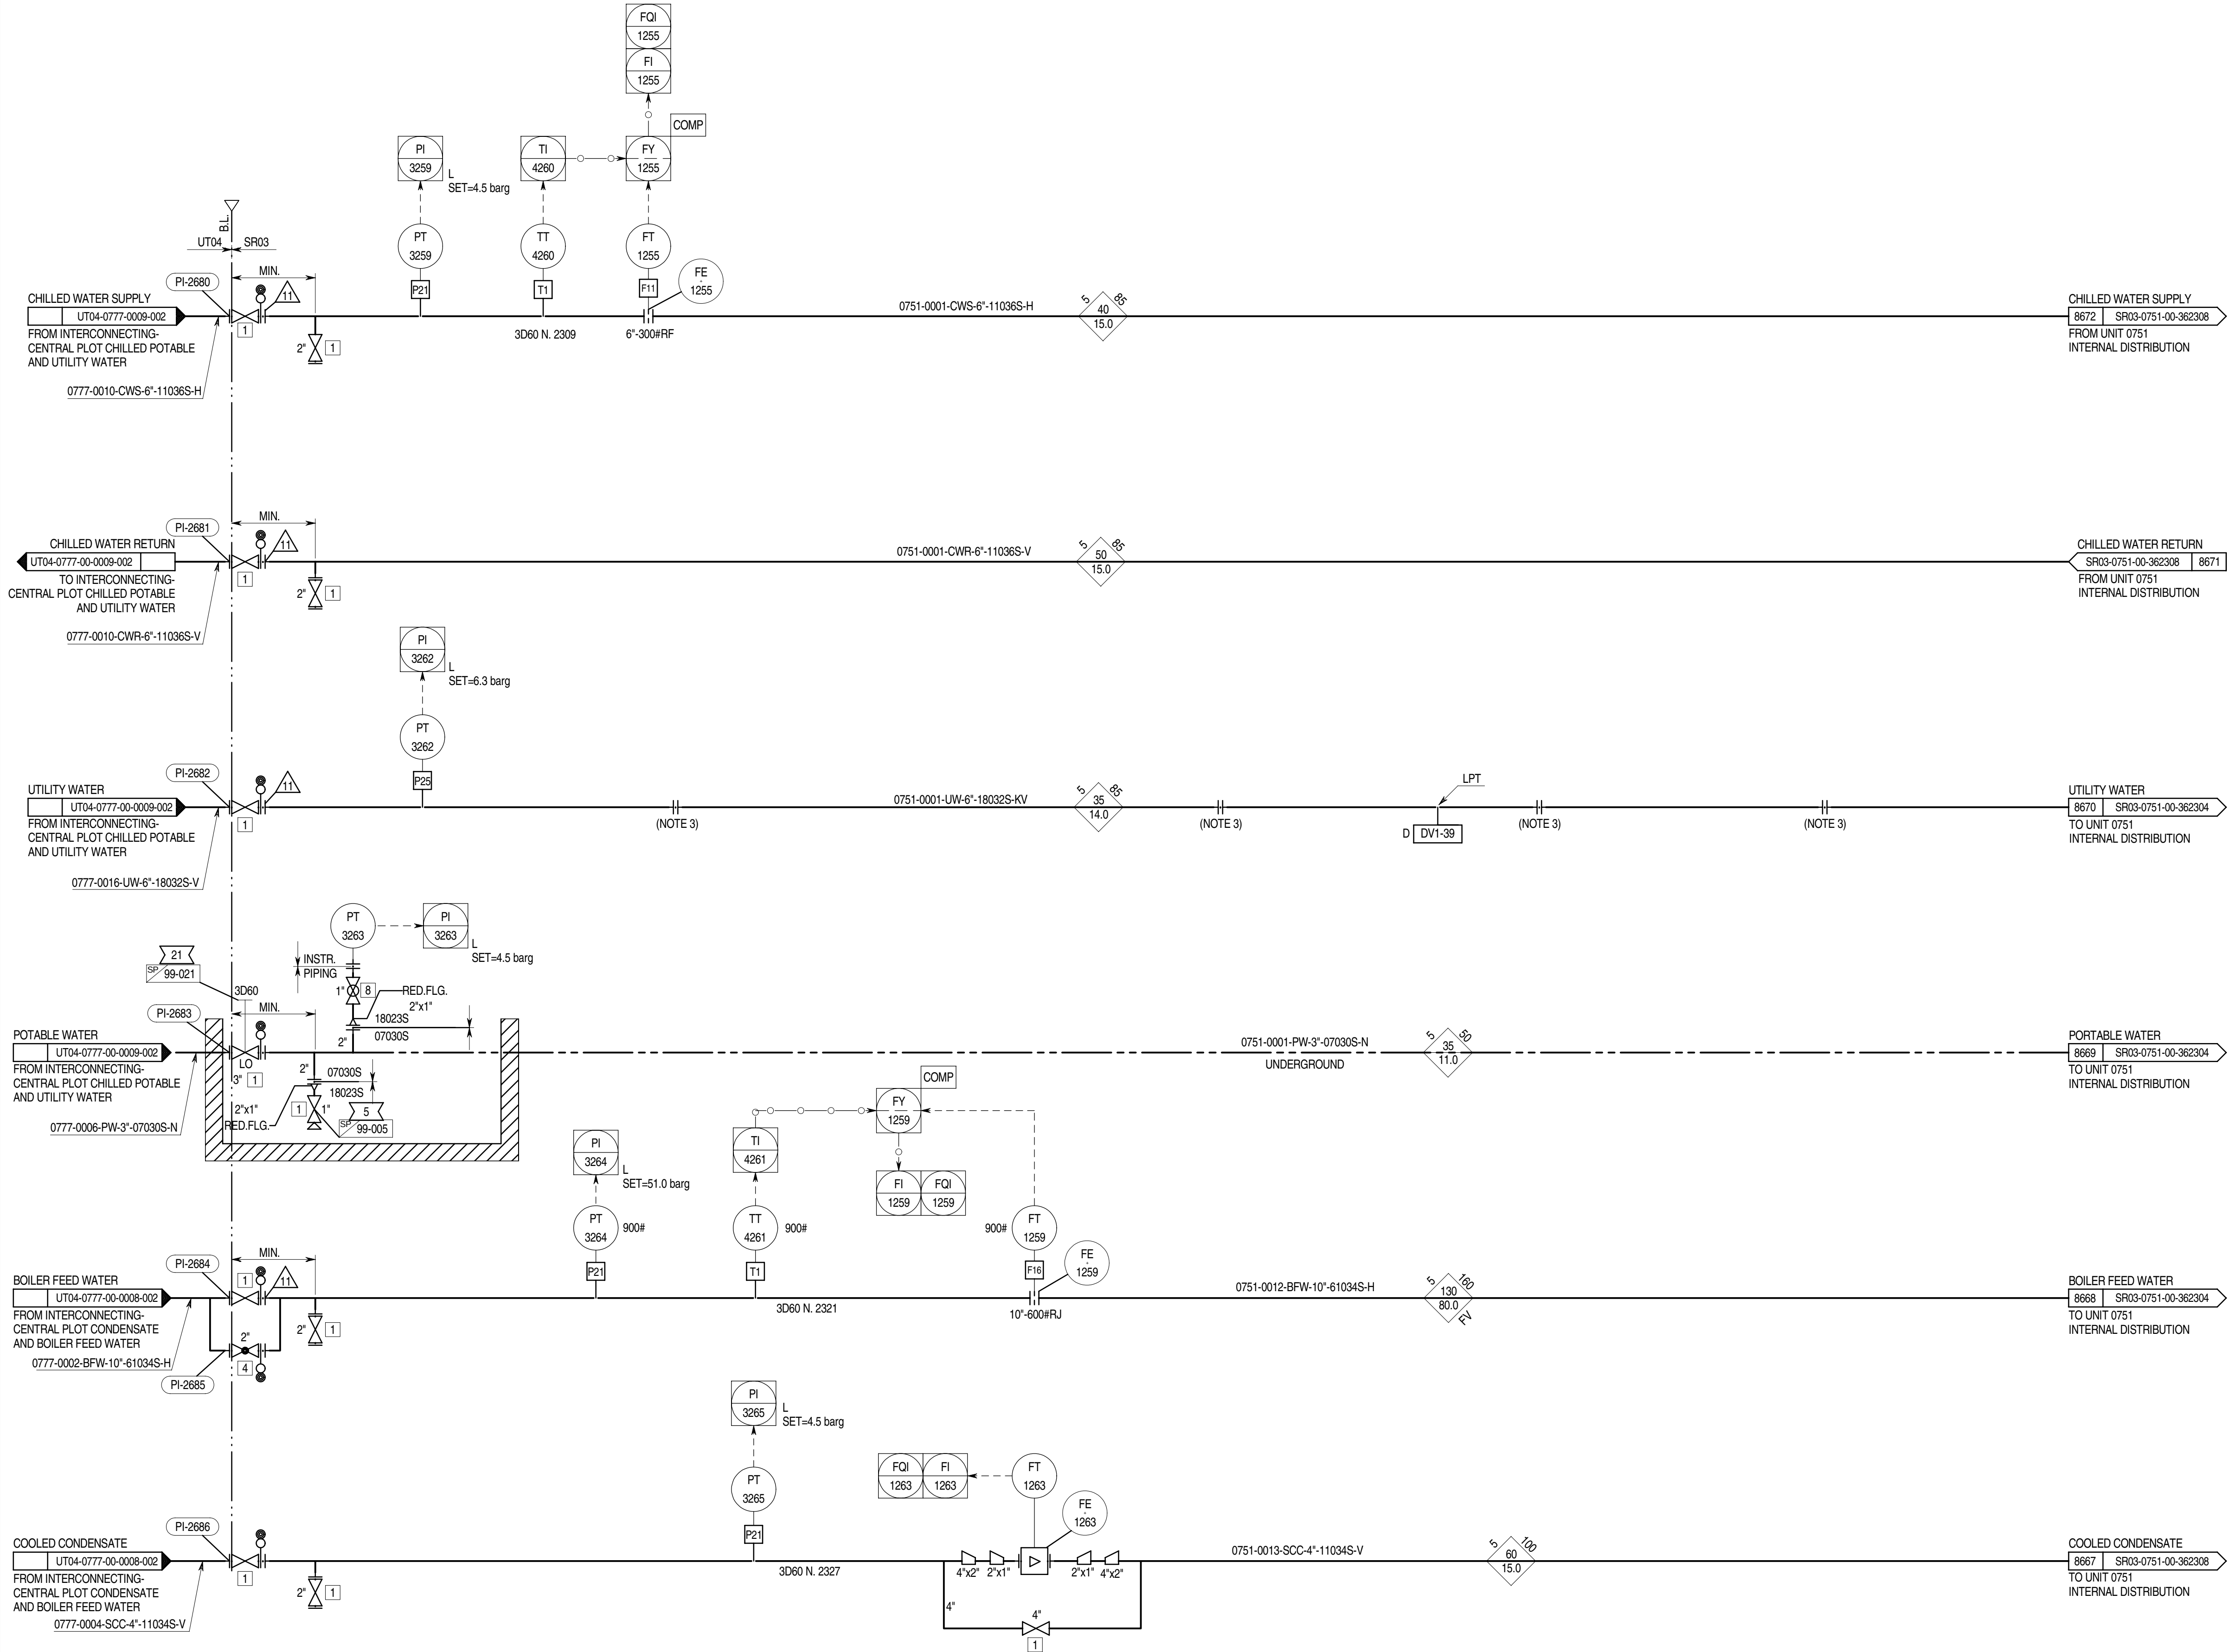

- GENERAL NOTES:**
- FOR STANDARD SYMBOLS, DETAILS, ABBREVIATIONS, SAMPLE CONNECTION TYPE, GENERAL NOTES & LEGEND SHEETS REFER TO DRAWING NO. MP-02-0230-00-004000 TO 04015.
 - ALL INSTRUMENT TAG NUMBERS ON THIS P&ID INCLUDING PACKAGE UNITS ARE PREFIXED WITH UNIT NUMBER 0751 UNLESS OTHERWISE NOTED.
 - DELETED.
- NOTES:**
- DELETED.
 - DELETED.
 - PREFABRICATED PIPE SPOOL SHALL HAVE FLANGED END ACCORDING TO 'FBE' REQUIREMENTS. REFER TO DOC. N. MP02-0230-66-SPE-06704.

Z1	04-11-14	IAB	ISSUED FOE AS BUILT	PCA	MAR	ASP
2.1D	18-04-14	IFC	ISSUED FOR CONSTRUCTION	PCA	MAR	ASP
2.1C	28-02-14	IFC	ISSUED FOR CONSTRUCTION	PCA	MAR	ASP
2.1B	06-08-12	IFC	ISSUED FOR CONSTRUCTION	DSC	CBR	SIN
2	29-12-11	IFC	ISSUED FOR CONSTRUCTION	DSC	CBR	SIN
1	08-07-11	IFCH	ISSUED FOR CONSTRUCTION WITH HOLDS	BSC	LMA	SIN
0	28-02-11	IFD	ISSUED CLIENT COMMENTS INCORPORATED	BSC	LMA	SIN
B1	30-09-10	ICR	ISSUED FOR CLIENT REVIEW	BSC	LMA	SIN
REV	DATE	STATUS	STATUS DESCRIPTION	BY	CKD	APP.

COMPANY:

Abu Dhabi Gas Development Co. Ltd.

CONTRACTOR:

JOB No. 032090

PROJECT: SHAH GAS DEVELOPMENT (SGD) PROJECT


AGREEMENT No. 13525001

DRAWING TITLE: PIPING & INSTRUMENT DIAGRAM UNIT 0751
SULPHUR RECOVERY AND TAIL GAS TREATING UNIT

EQUIPMENT DESCRIPTION	BFW, POTABLE WATER, UTILITY WATER, CHILLED WATER AND STEAM CONDENSATE HEADERS.
TAGITEM No.	

CONTRACTOR DRG. No.	751-GD-B-303368	REV. Z1
COMPANY DRG. No.	SR03-0751-00-303368	
SCALE:	SIZE: A1 DOC. CLASS: 1	

THIS DOCUMENT IS THE PROPERTY OF ABU DHABI GAS DEVELOPMENT COMPANY LIMITED AND CONTAINS INFORMATION WHICH IS PROPRIETARY. THIS INFORMATION IS TO BE HELD IN CONFIDENCE. NO DISCLOSURE OR OTHER USE OF THIS DOCUMENT IS TO BE MADE WITHOUT THE PRIOR WRITTEN CONSENT OF ABU DHABI GAS DEVELOPMENT COMPANY LIMITED.

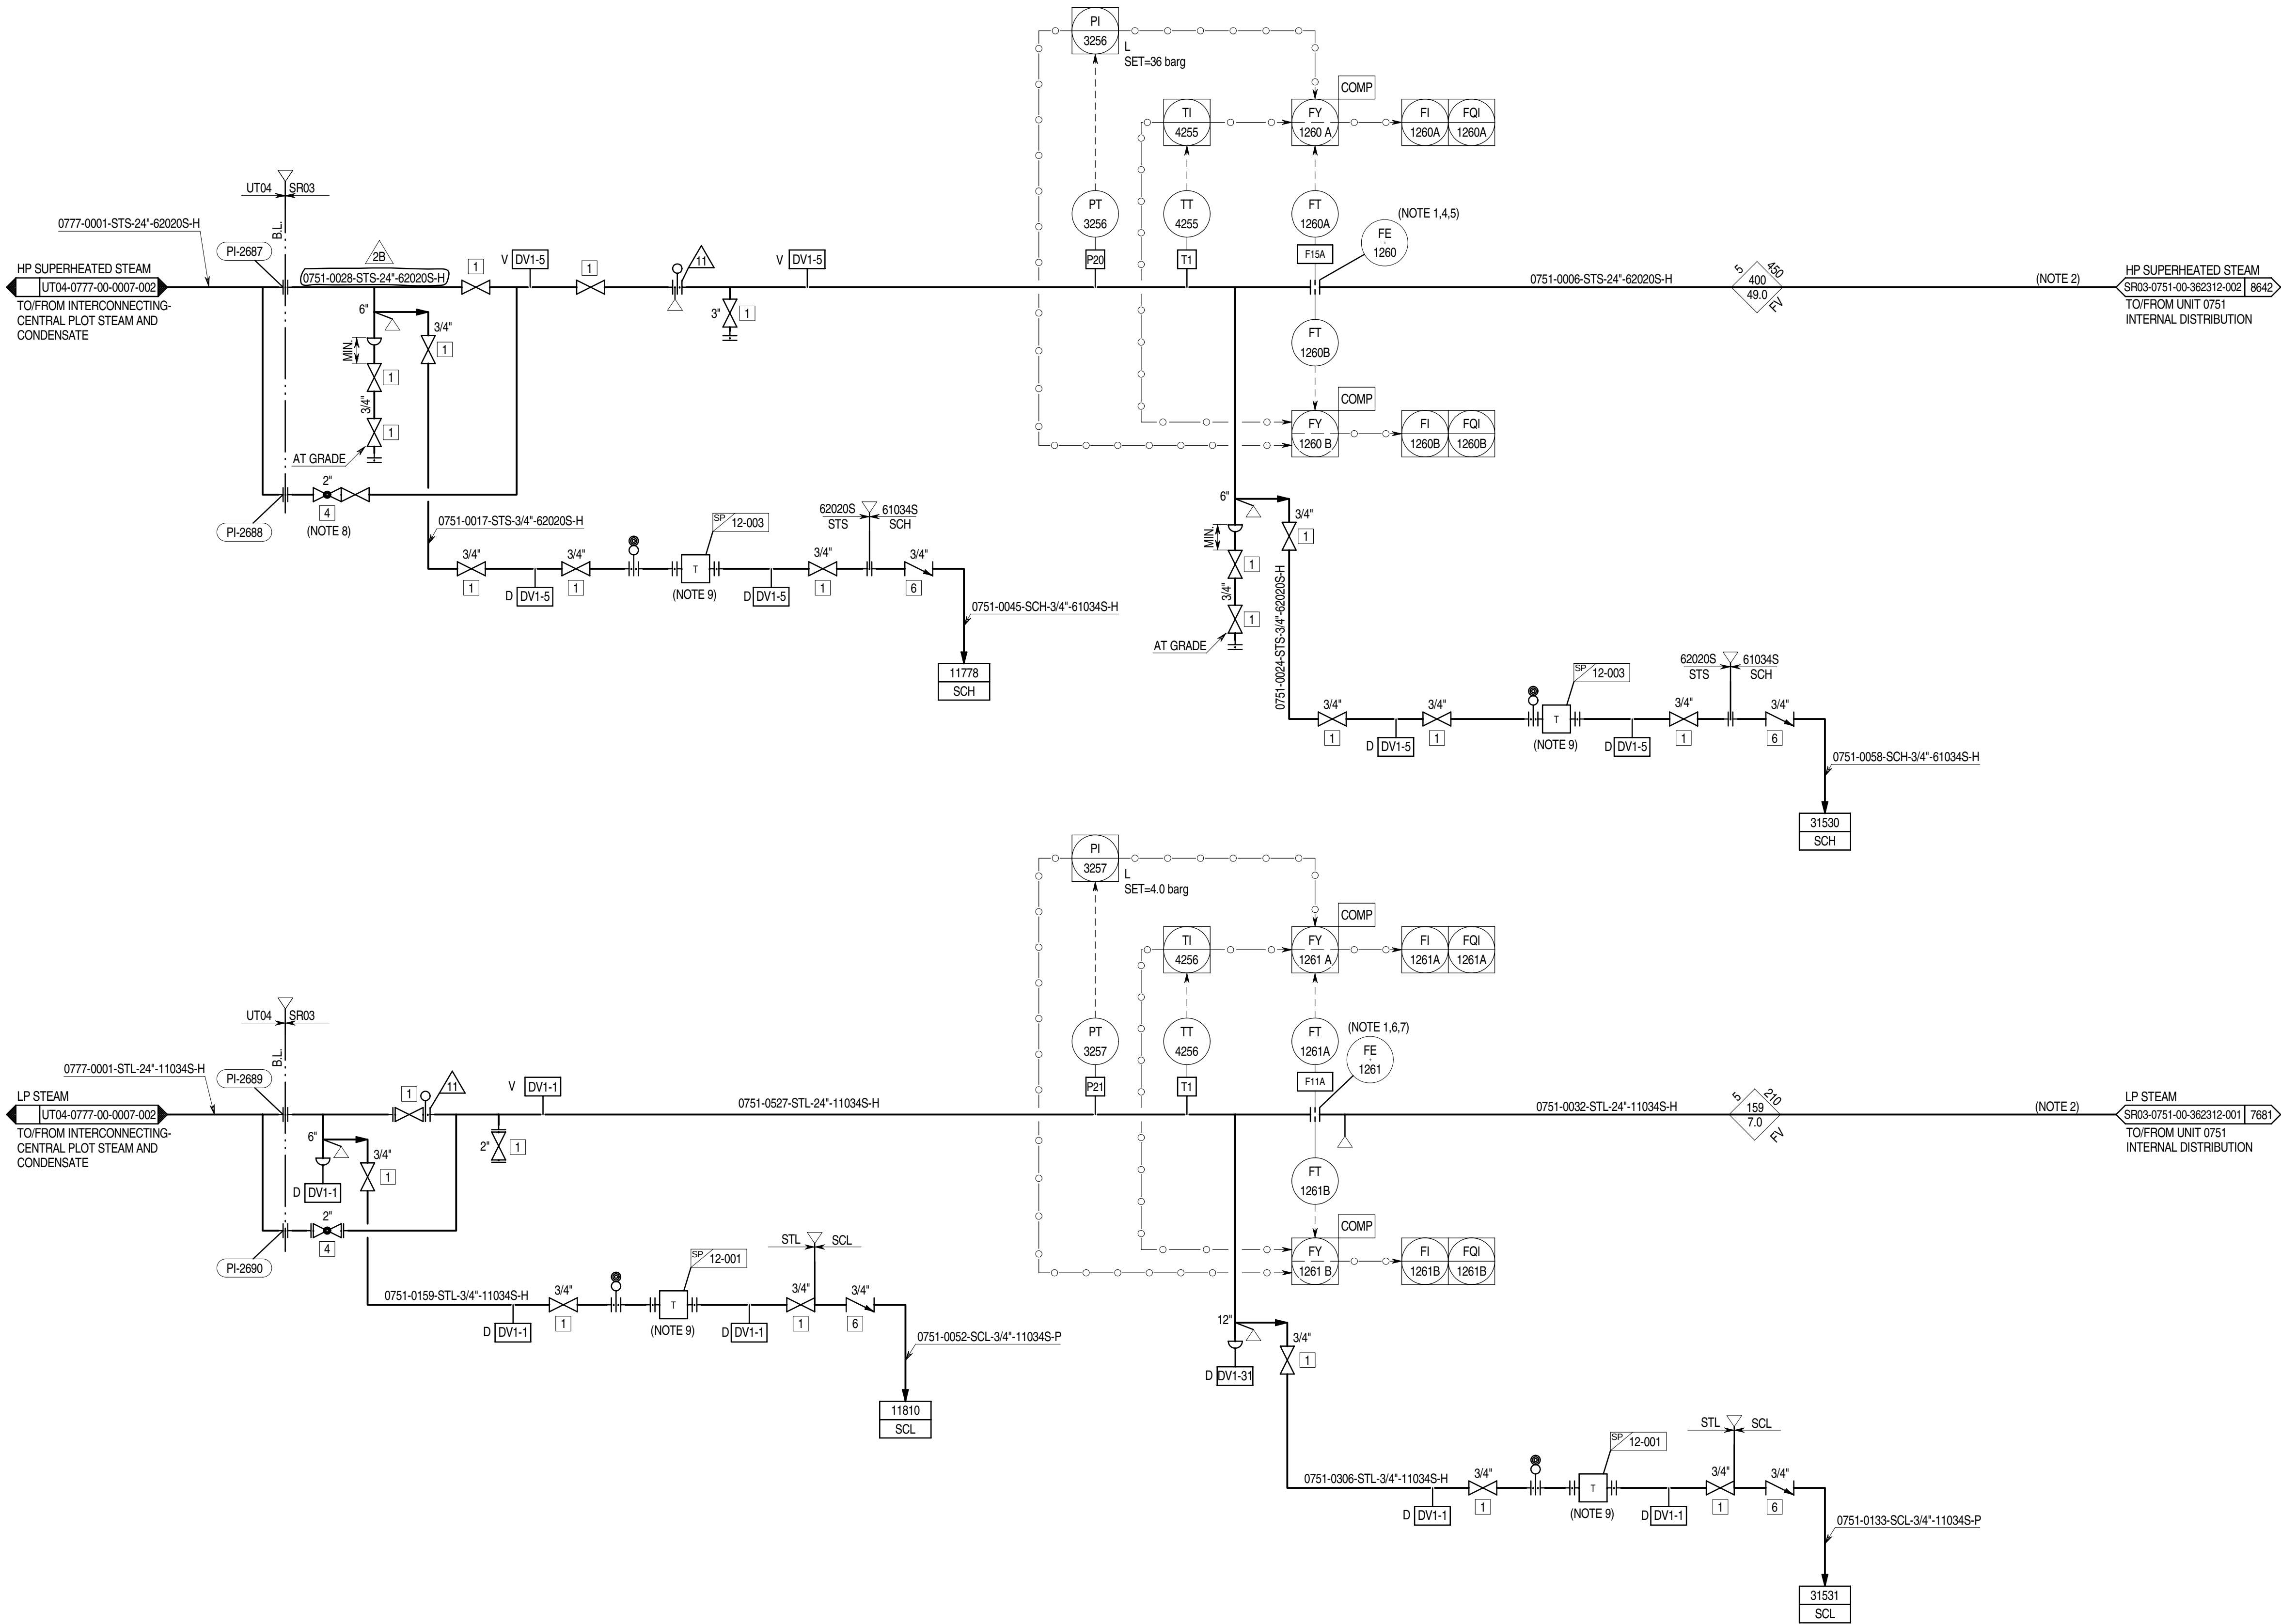

- GENERAL NOTES:**
- FOR STANDARD SYMBOLS, DETAILS, ABBREVIATIONS, SAMPLE CONNECTION TYPE, GENERAL NOTES & LEGEND SHEETS REFER TO DRAWING NO. MP02-0230-00-004000 TO 004015.
 - ALL INSTRUMENT TAG NUMBERS ON THIS P&ID INCLUDING PACKAGE UNITS ARE PREFIXED WITH UNIT NUMBER 0751 UNLESS OTHERWISE NOTED.

- NOTES:**
- BI-DIRECTIONAL FLOW ELEMENTS ARE REQUIRED.
 - PROVIDE STEAM HEADER DRIP LEG PER PIPING STANDARD.
 - DELETED.
 - FT-1260A - HP SUPERHEATED STEAM TO INTERCONNECTING.
 - FT-1260B - HP SUPERHEATED STEAM FROM INTERCONNECTING.
 - FT-1261A - LP SUPERHEATED STEAM TO INTERCONNECTING.
 - FT-1261B - LP SUPERHEATED STEAM FROM INTERCONNECTING.
 - GLOBE VALVE TO BE USED FOR WARM-UP.
 - STEAM TRAP TO BE PROVIDED WITH INTEGRAL INLET STRAINER OTHERWISE A DEDICATED PIPING STRAINER TO BE INSTALLED.

UTILITY REFERENCE TABLE		
SCH	DRW. N°.	SR03-0751-00-PID-362312
SCL	DRW. N°.	SR03-0751-00-PID-362303

Z1	04-11-14	IAB	ISSUED FOR AS BUILT	PCA	MAR	ASP
2.1B	06-08-12	IFC	ISSUED FOR CONSTRUCTION	DSC	CBR	SIN
2	29-12-11	IFC	ISSUED FOR CONSTRUCTION	DSC	CBR	SIN
1	08-07-11	IFCH	ISSUED FOR CONSTRUCTION WITH HOLDS	BSC	LMA	SIN
0	28-02-11	IFD	ISSUED CLIENT COMMENTS INCORPORATED	BSC	LMA	SIN
B1	30-09-10	ICR	ISSUED FOR CLIENT REVIEW	BSC	LMA	SIN
REV	DATE	STATUS	STATUS DESCRIPTION	BY	CKD	APP.

COMPANY: Abu Dhabi Gas Development Co. Ltd.



CONTRACTOR:



JOB No. 032090

PROJECT: SHAH GAS DEVELOPMENT (SGD) PROJECT


AGREEMENT No. 13525001

DRAWING TITLE: PIPING & INSTRUMENT DIAGRAM UNIT 0751
SULPHUR RECOVERY AND TAIL GAS TREATING UNIT

EQUIPMENT DESCRIPTION	STEAM HEADER
TAG/ITEM No.	

CONTRACTOR DRG.No.	751-GD-B-303369	REV. Z1
COMPANY DRG.No.	SR03-0751-00-303369	
SCALE:	SIZE: A1 DOC. CLASS: 1	

THIS DOCUMENT IS THE PROPERTY OF ABU DHABI GAS DEVELOPMENT COMPANY LIMITED AND CONTAINS INFORMATION WHICH IS PROPRIETARY. THIS INFORMATION IS TO BE HELD IN CONFIDENCE. NO DISCLOSURE OR OTHER USE OF THIS DOCUMENT IS TO BE MADE WITHOUT THE PRIOR WRITTEN CONSENT OF ABU DHABI GAS DEVELOPMENT COMPANY LIMITED.

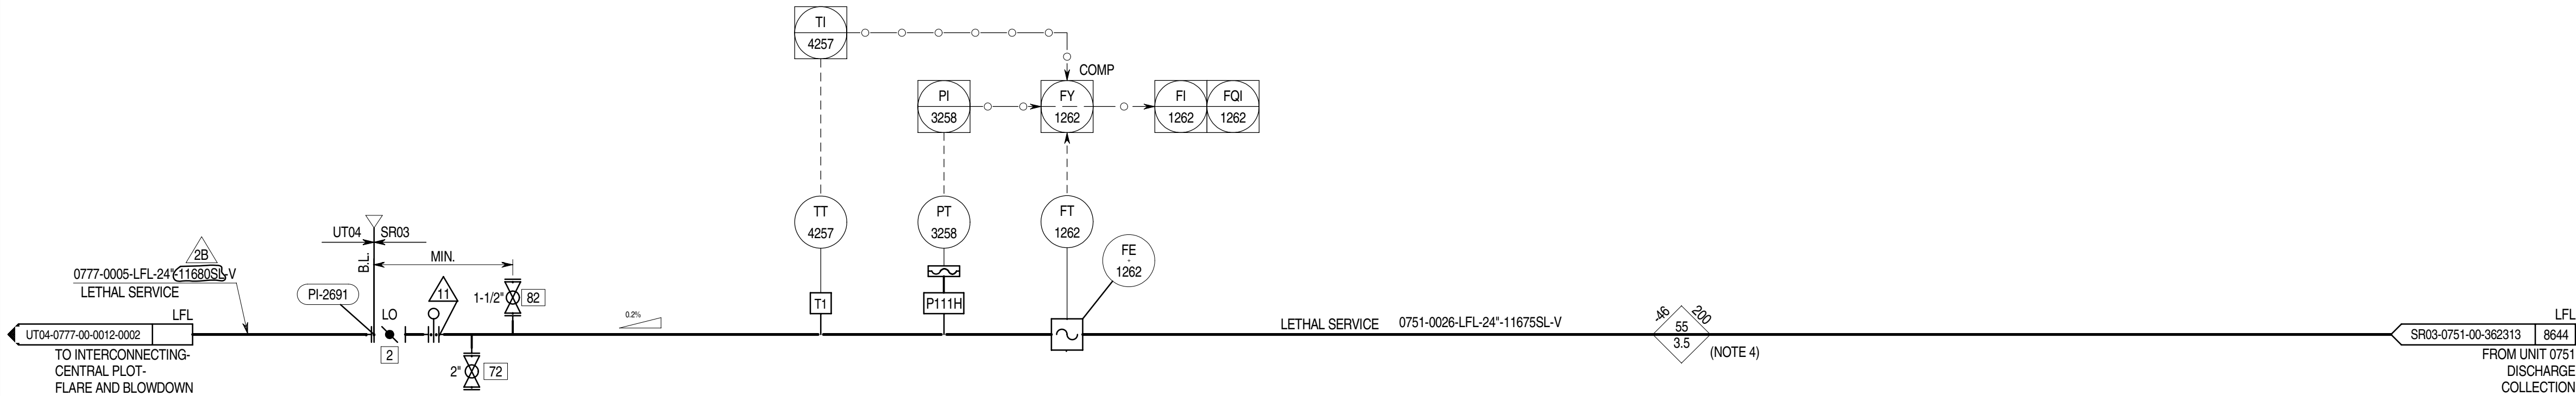

- GENERAL NOTES:
- FOR STANDARD SYMBOLS, DETAILS, ABBREVIATIONS, SAMPLE CONNECTION TYPE, GENERAL NOTES & LEGEND SHEETS REFER TO DRAWING NO. MP02-0230-00-004000 TO 004015.
 - ALL INSTRUMENT TAG NUMBERS ON THIS P&ID INCLUDING PACKAGE UNITS ARE PREFIXED WITH UNIT NUMBER 0751 UNLESS OTHERWISE NOTED.
- NOTES:
- DELETED.
 - DELETED.
 - DELETED.
 - MAXIMUM OPERATING TEMPERATURE WITHOUT FLARING.
MAXIMUM OPERATING TEMPERATURE DURING FLARING IS 170 °C

Z1	04-11-14	IAB	ISSUED FOR AS BUILT	PCA	MAR	ASP
2.1B	06-08-12	IFC	ISSUED FOR CONSTRUCTION	DSC	CBR	SIN
2	29-12-11	IFC	ISSUED FOR CONSTRUCTION	DSC	CBR	SIN
1	08-07-11	IFCH	ISSUED FOR CONSTRUCTION WITH HOLDS	BSC	LMA	SIN
0	28-02-11	IFD	ISSUED CLIENT COMMENTS INCORPORATED	BSC	LMA	SIN
B1	30-09-10	ICR	ISSUED FOR CLIENT REVIEW	BSC	LMA	SIN
REV	DATE	STATUS	STATUS DESCRIPTION	BY	CKD	APP.

COMPANY:

Abu Dhabi Gas Development Co. Ltd.



CONTRACTOR:



JOB No. 032090

PROJECT: SHAH GAS DEVELOPMENT (SGD) PROJECT


AGREEMENT No. 13525001

DRAWING TITLE: PIPING & INSTRUMENT DIAGRAM UNIT 0751
SULPHUR RECOVERY AND TAIL GAS TREATING UNIT

EQUIPMENT DESCRIPTION	LOW PRESSURE FLARE HEADER
TAG/ITEM No.	

CONTRACTOR DRG.No.	751-GD-B-303370	REV. Z1
COMPANY DRG.No.	SR03-0751-00-303370	
SCALE:	SIZE: A1 DOC. CLASS: 1	

THIS DOCUMENT IS THE PROPERTY OF ABU DHABI GAS DEVELOPMENT COMPANY LIMITED AND CONTAINS INFORMATION WHICH IS PROPRIETARY. THIS INFORMATION IS TO BE HELD IN CONFIDENCE. NO DISCLOSURE OR OTHER USE OF THIS DOCUMENT IS TO BE MADE WITHOUT THE PRIOR WRITTEN CONSENT OF ABU DHABI GAS DEVELOPMENT COMPANY LIMITED.

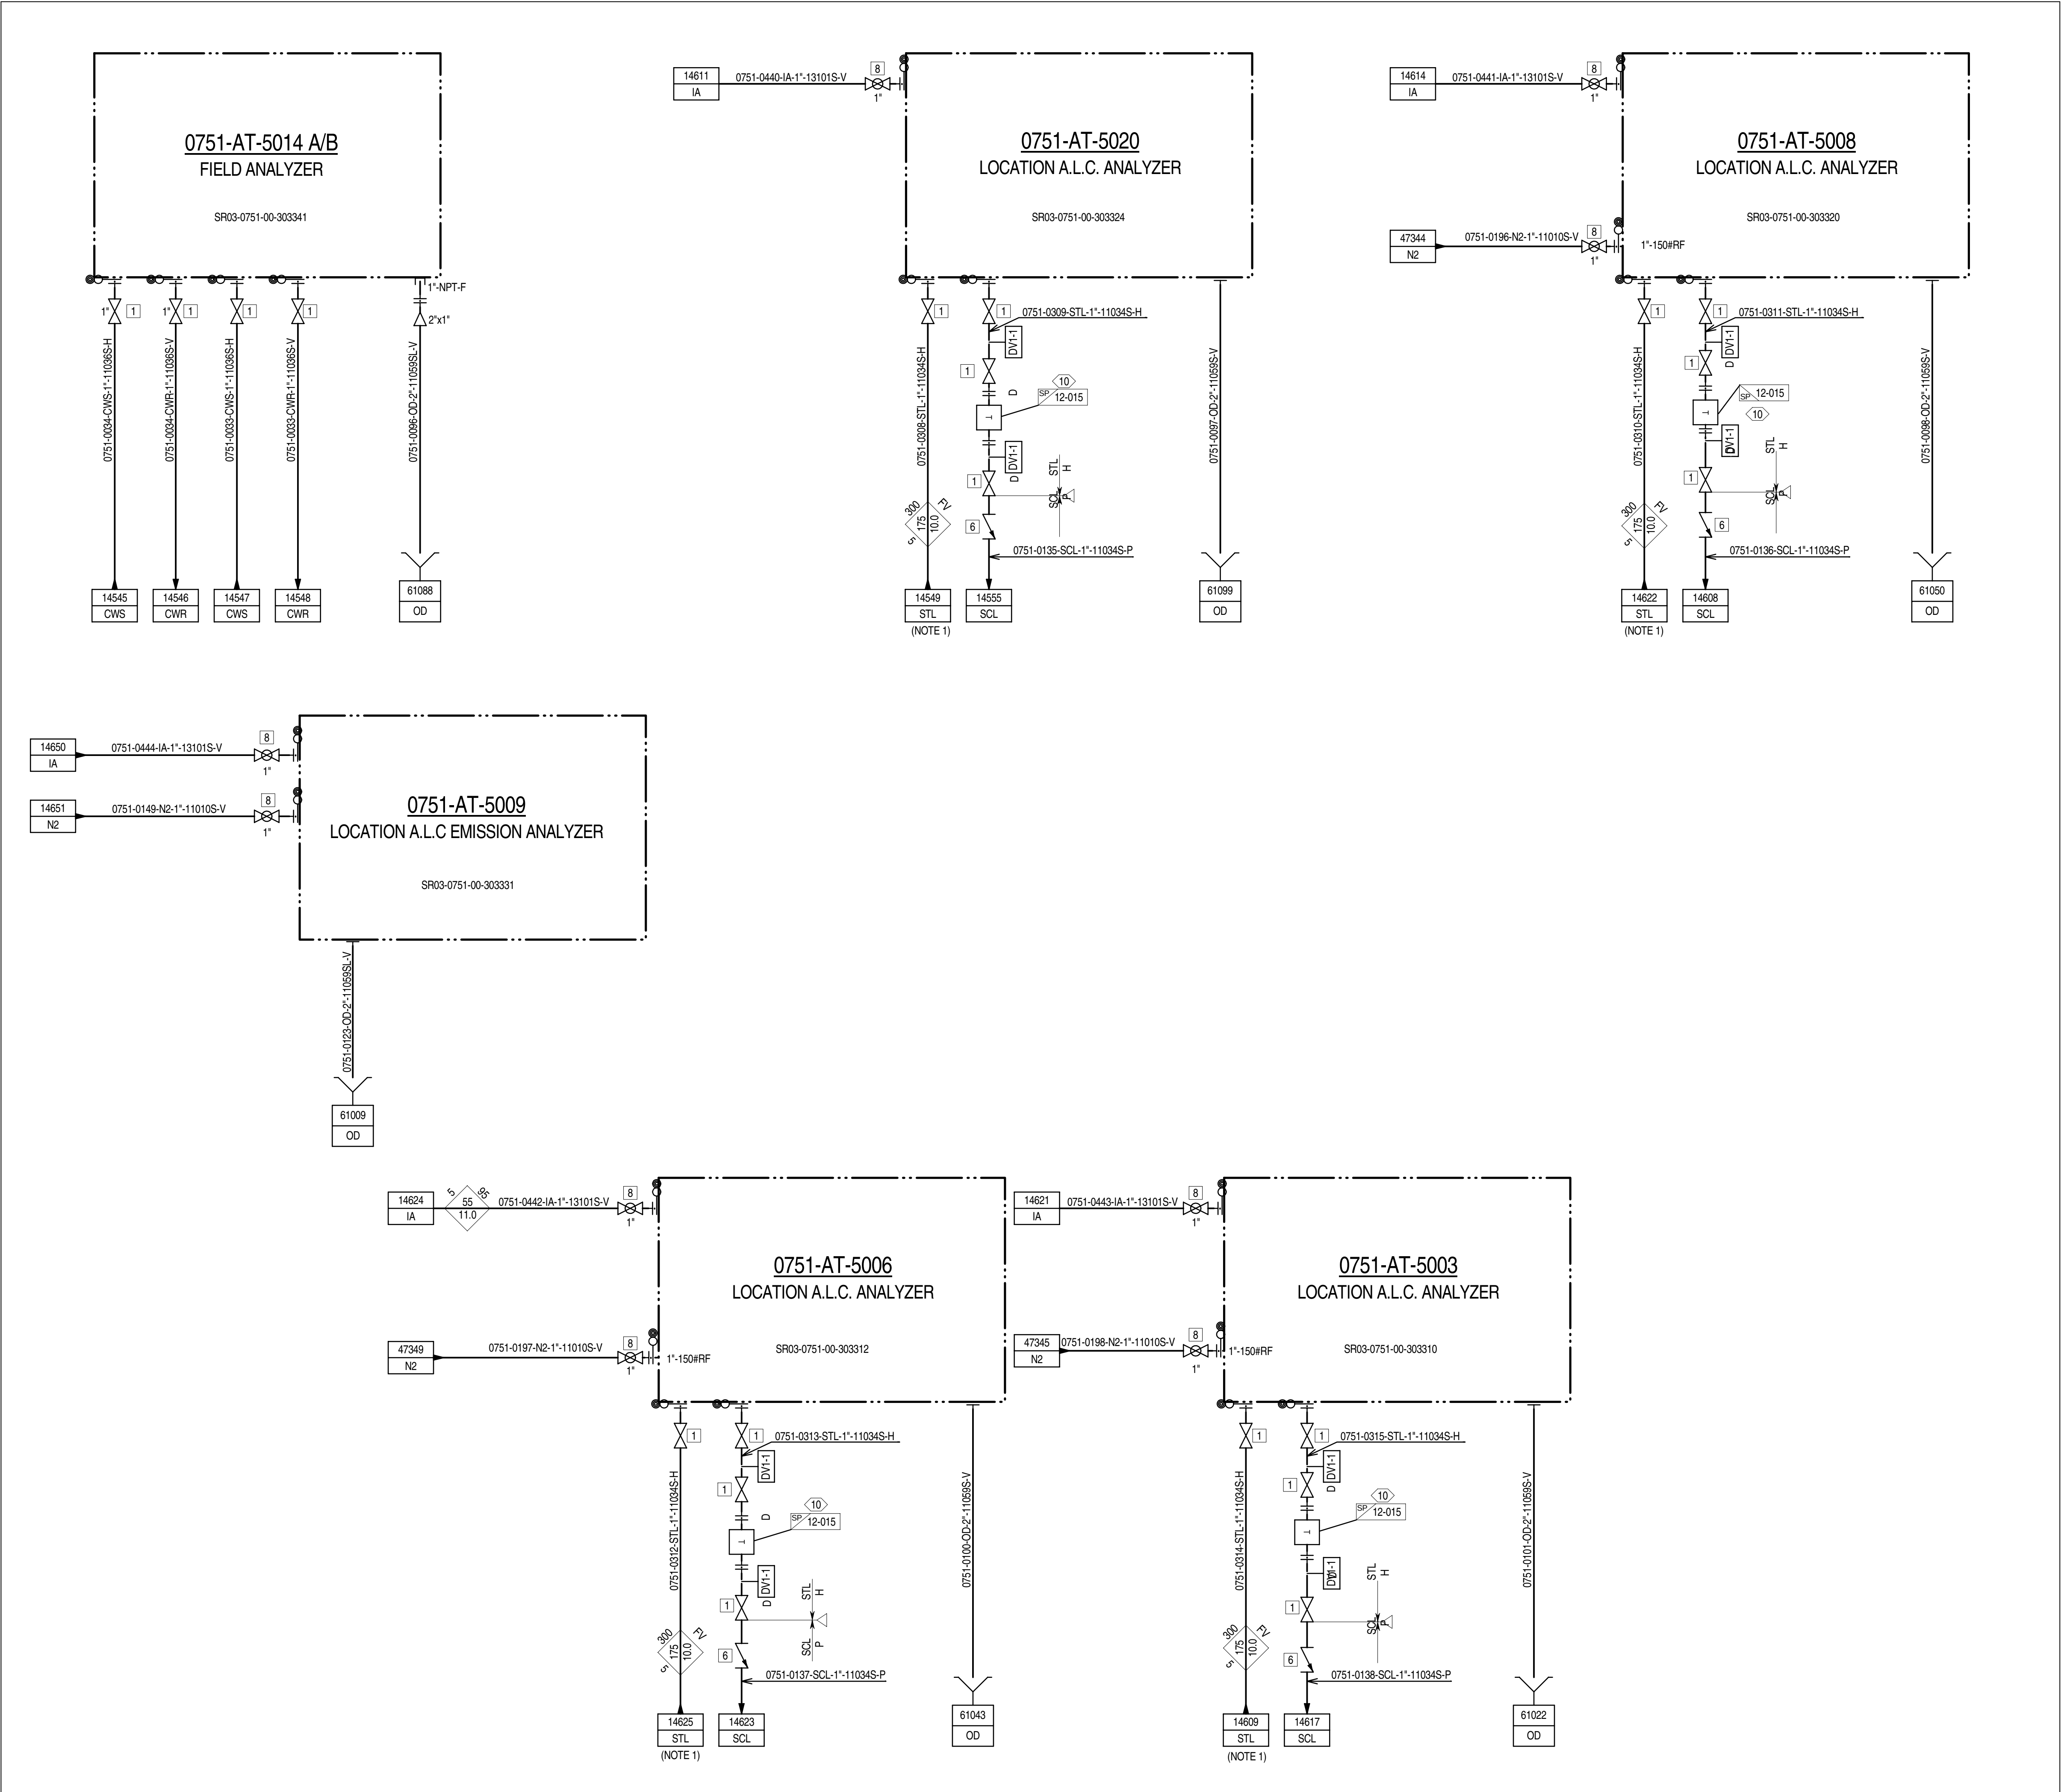

GENERAL NOTES:

1. FOR STANDARD SYMBOLS, DETAILS, ABBREVIATION, SAMPLE CONNECTION TYPE, GENERAL NOTES & LEGEND SHEETS REFER TO DRAWING No. MP02-0230-00-004000 TO 004017.

2. ALL INSTRUMENT TAG NUMBERS ON THIS P&ID INCLUDING PACKAGE UNITS ARE PREFIXED WITH UNIT NUMBERS 0751 UNLESS OTHERWISE NOTED.

NOTES:

1. STL SUPPLIED @ 8 barg AND 175°C

UTILITY REFERENCE TABLE			
BBD SCL	DRW:	No.SR03-0751-00-PID-362303	
IA	DRW:	No.SR03-0751-00-PID-362305_001	
OD	DRW:	No.SR03-0751-00-PID-362307	
CWR CWS	DRW:	No.SR03-0751-00-PID-362308	
N2	DRW:	No.SR03-0751-00-PID-362310	
STL SCL	DRW:	No.SR03-0751-00-PID-362312_001	

Z1	04-11-14	IAB	ISSUED FOR AS BUILT	PCA	MAR	ASP
2.1E	18-04-14	IFC	ISSUED FOR CONSTRUCTION	PCA	MAR	ASP
2.1D	28-02-14	IFC	ISSUED FOR CONSTRUCTION	PCA	MAR	ASP
2.1C	31-10-12	IFC	ISSUED FOR CONSTRUCTION	RL	MF	MZ
2.1B	06-08-12	IFC	ISSUED FOR CONSTRUCTION	DSC	CBR	SIN
2	03-10-11	IFC	ISSUED FOR CONSTRUCTION	DSC	CBR	SIN
1	11-05-11	IFCH	ISSUED AS 230-GD-B-004007 FOR CONSTRUCTION WITH HOLDS	FDA	MVI	ASP
0	24-01-11	IFD	ISSUED AS 230-GD-B-004007 FOR CLIENT COMMENTS INCORPORATED	FDA	MVI	ASP
REV	DATE	STATUS	STATUS DESCRIPTION	BY	CKD	APP.

COMPANY:

Abu Dhabi Gas Development Co. Ltd.

CONTRACTOR:

JOB No. 032090

PROJECT:

SHAH GAS DEVELOPMENT (SGD) PROJECT
SHAH PROCESS PLANT

AGREEMENT No: **13525001**







DRAWING TITLE:

PIPING & INSTRUMENT DIAGRAM UNIT 0751
SULPHUR RECOVERY AND TAIL GAS TREATING UNIT

EQUIPMENT DESCRIPTION	INSTRUMENT DETAILS: ANALYZER		
TAG/ITEM No.	A.L.C. - FIELD		

CONTRACTOR DRG.No.	751-GD-B-303371	REV. Z1
COMPANY DRG.No.	SR03-0751-00-303371-001	
SCALE:	SIZE: A1 DOC. CLASS: 1	

THIS DOCUMENT IS THE PROPERTY OF ABU DHABI GAS DEVELOPMENT COMPANY LIMITED AND CONTAINS INFORMATION WHICH IS PROPRIETARY. THIS INFORMATION IS TO BE HELD IN CONFIDENCE. NO DISCLOSURE OR OTHER USE OF THIS DOCUMENT IS TO BE MADE WITHOUT THE PRIOR WRITTEN CONSENT OF ABU DHABI GAS DEVELOPMENT COMPANY LIMITED.

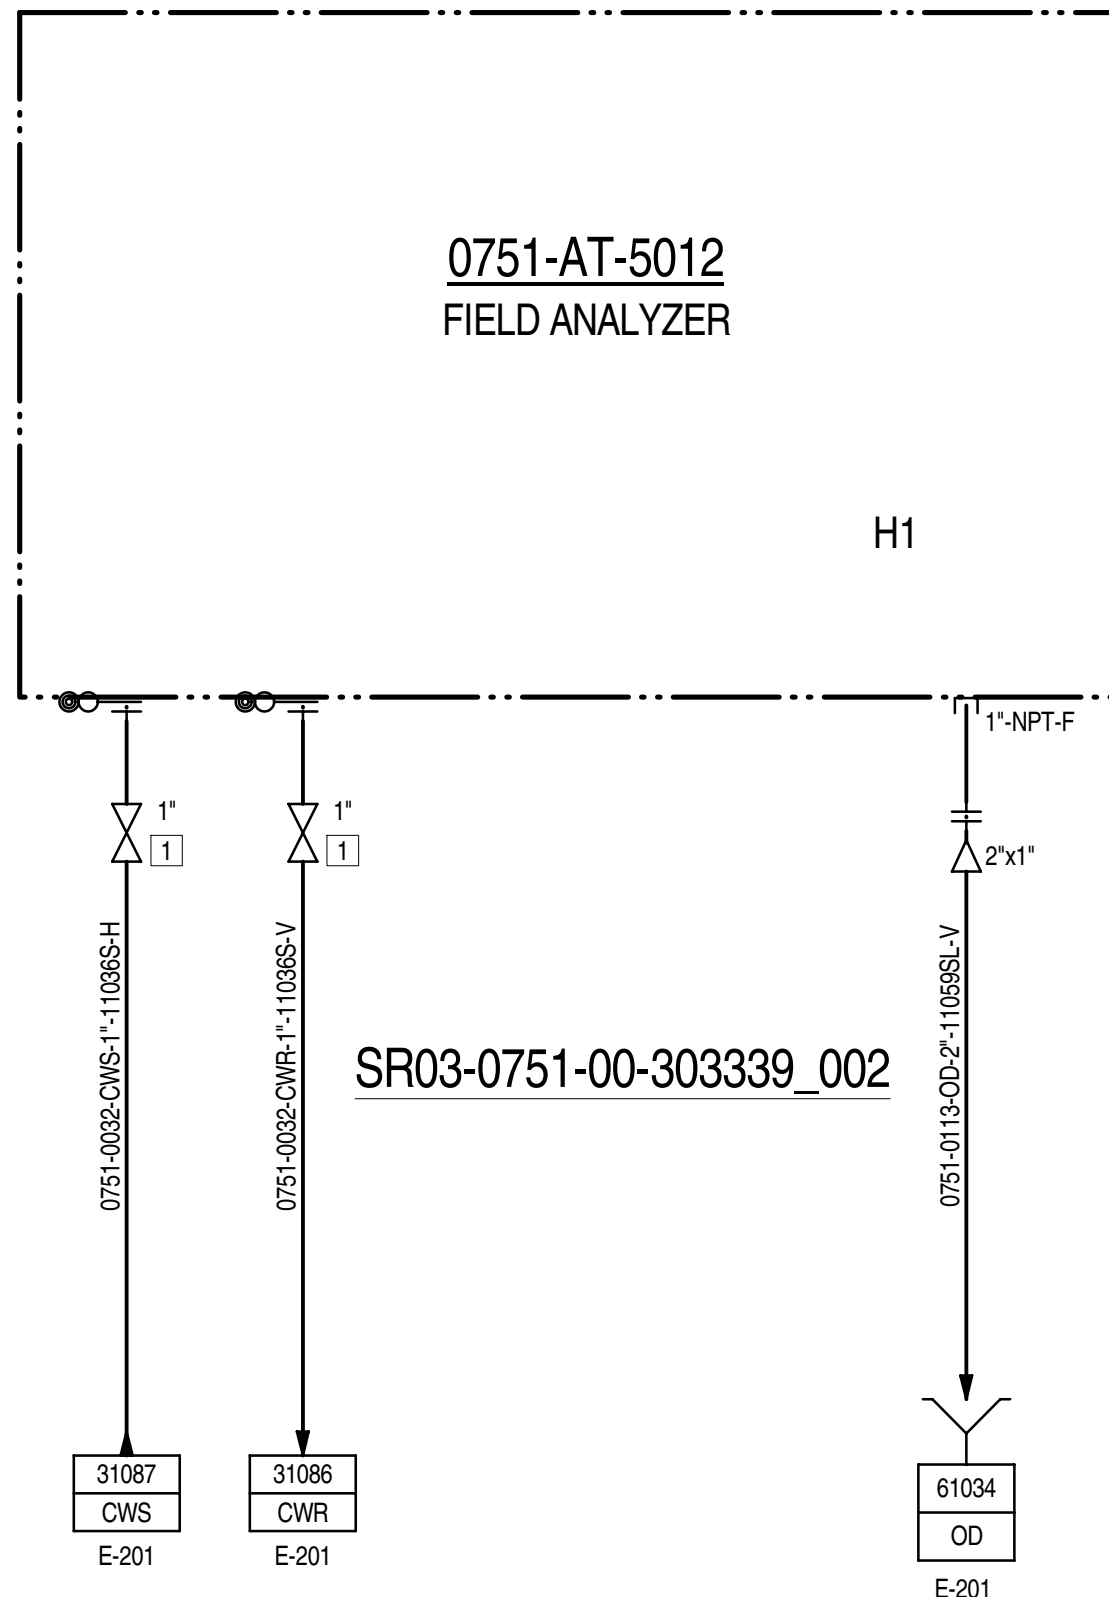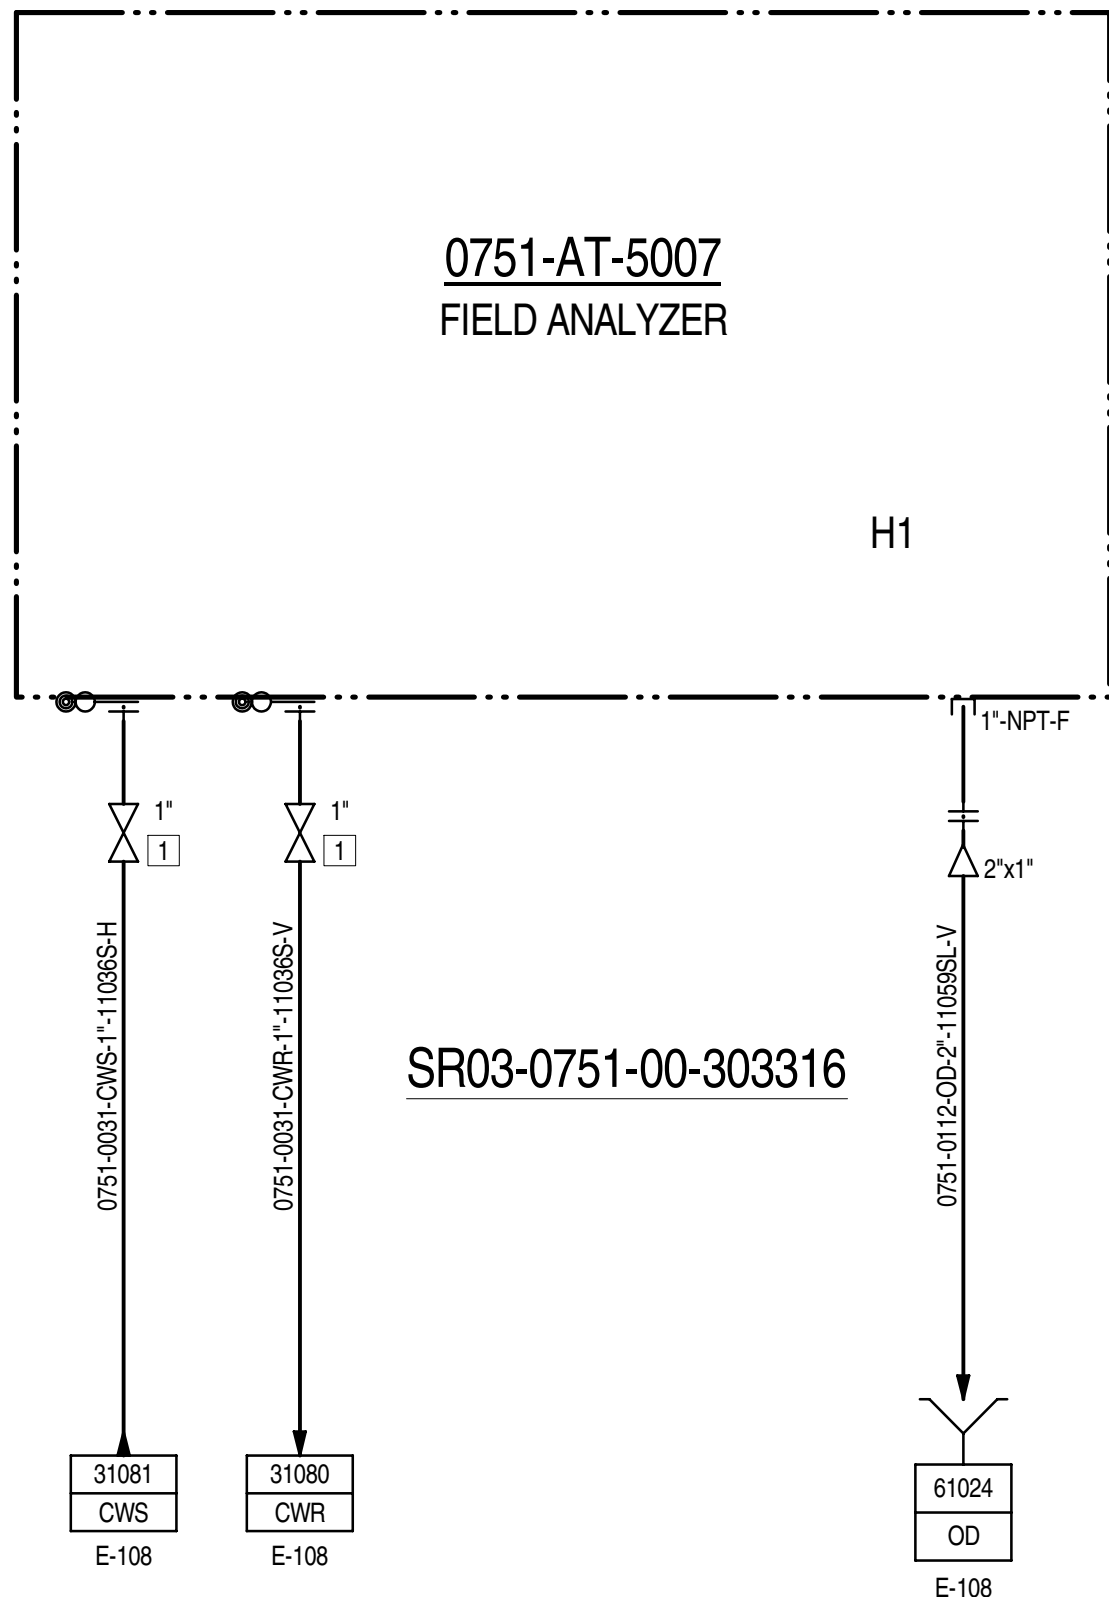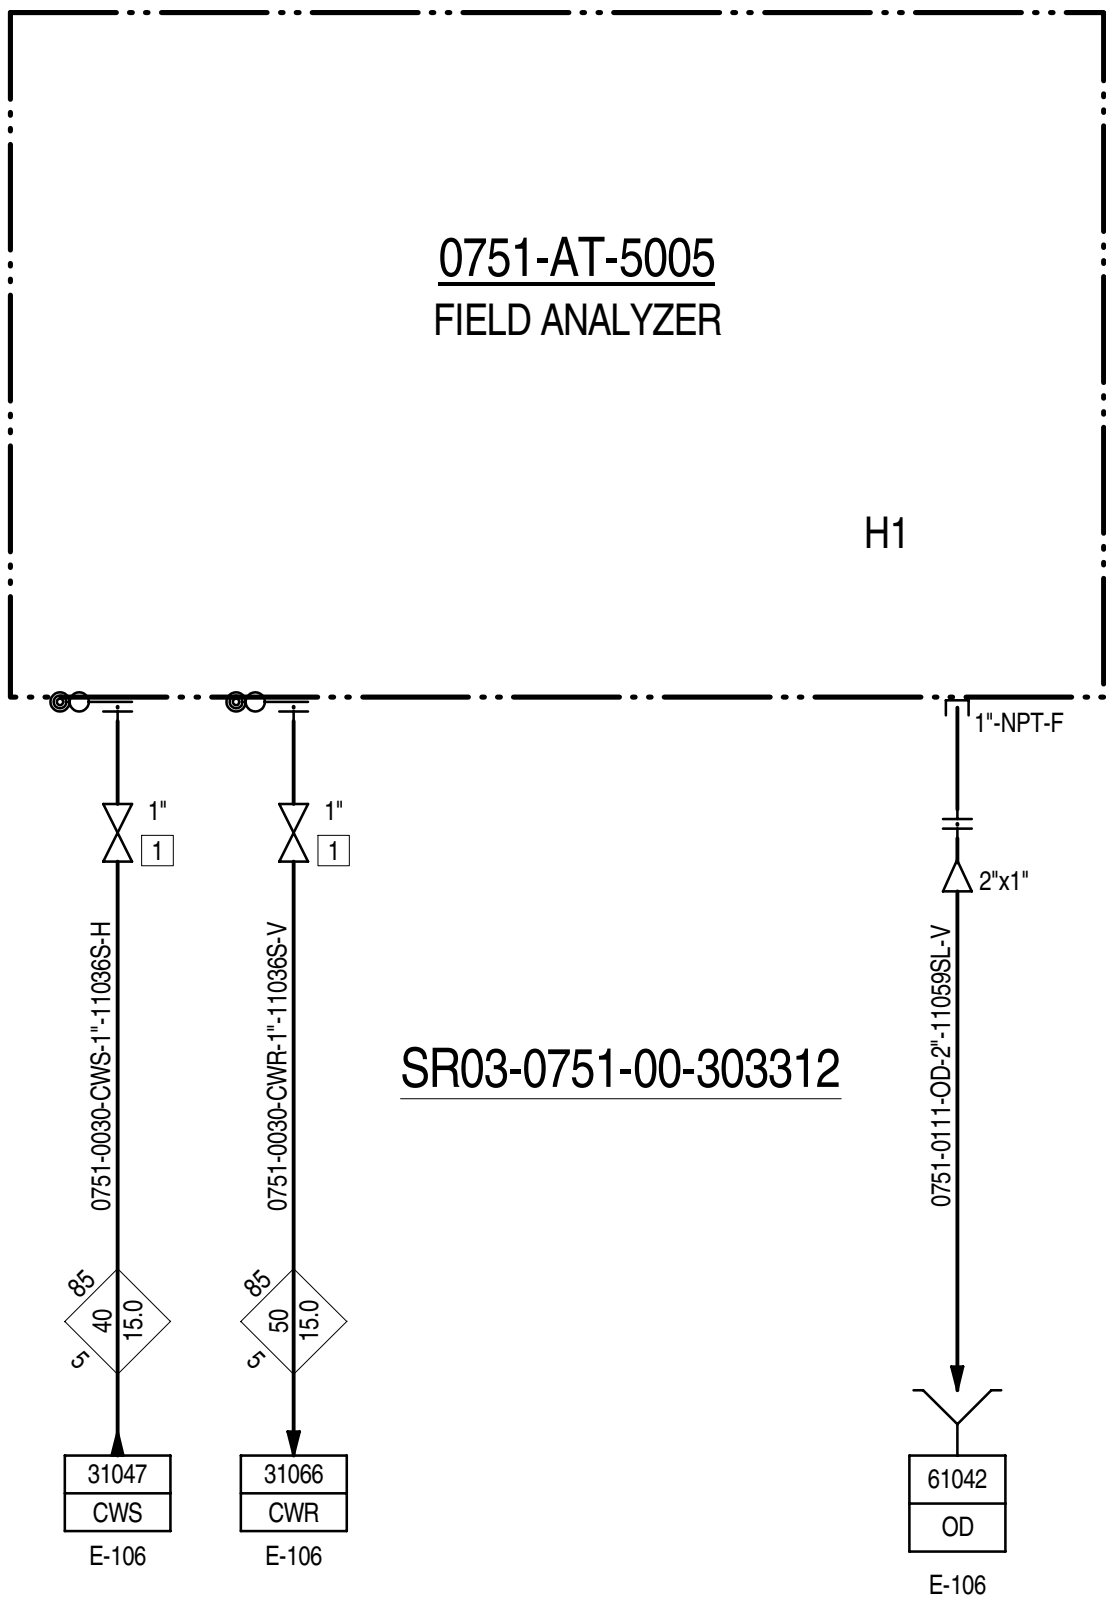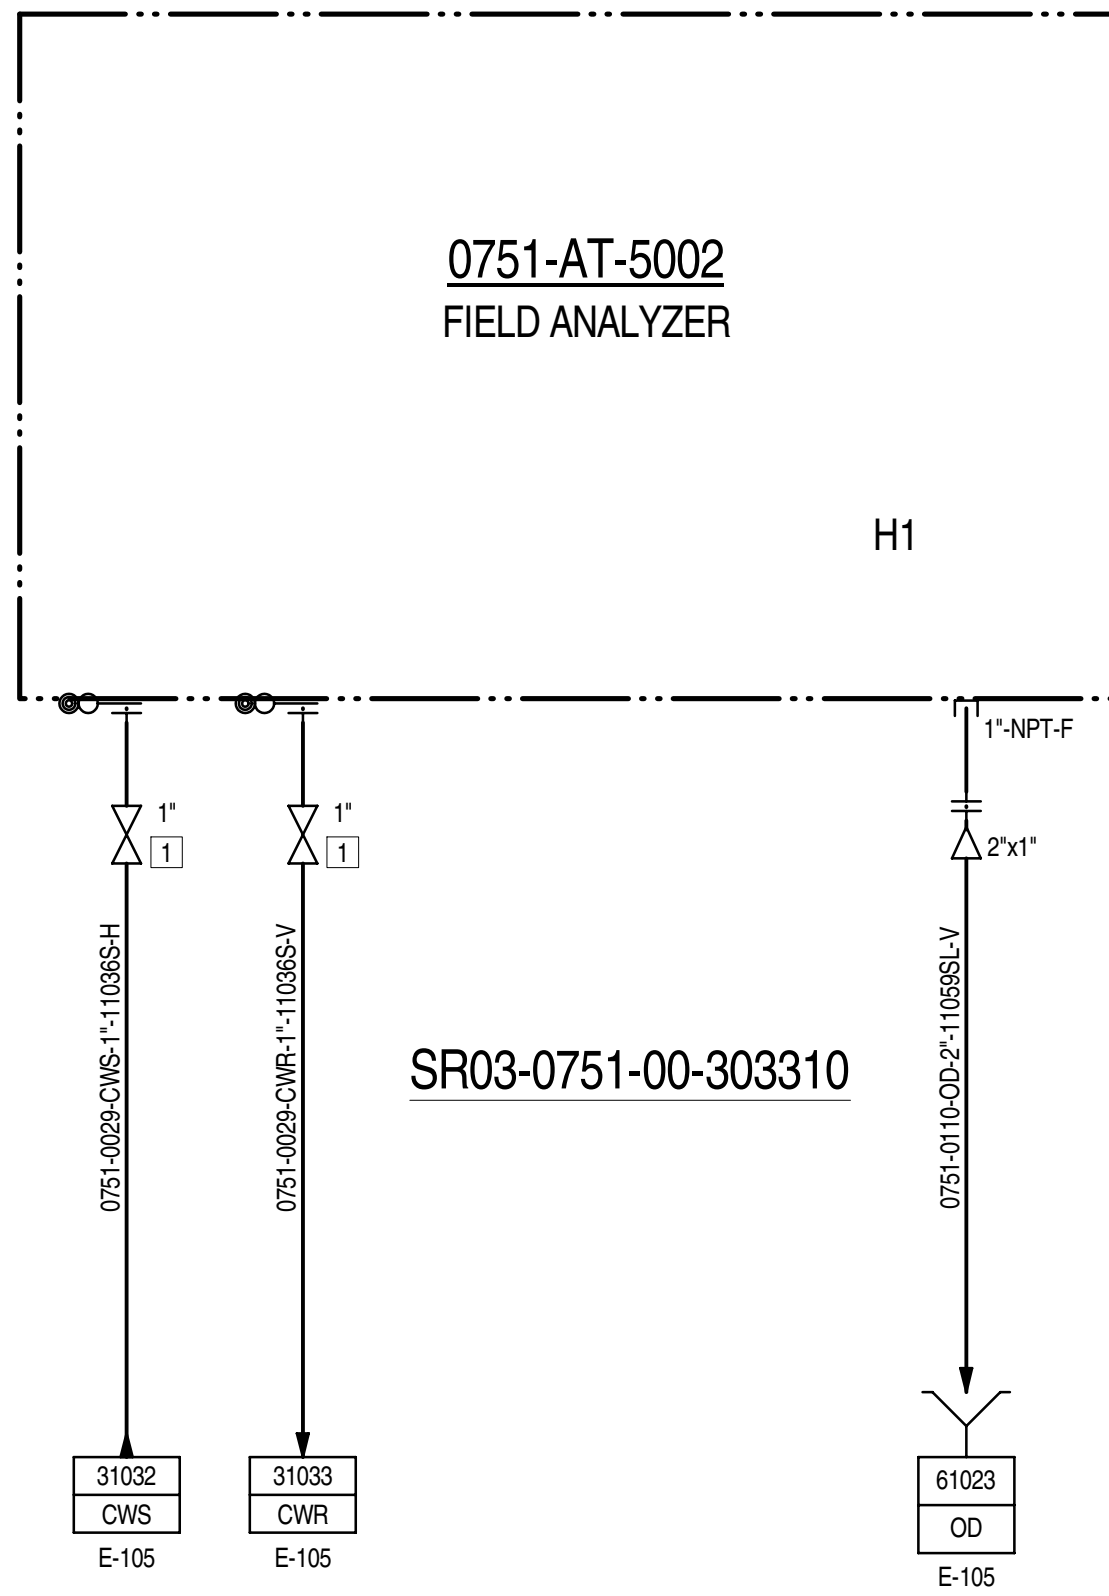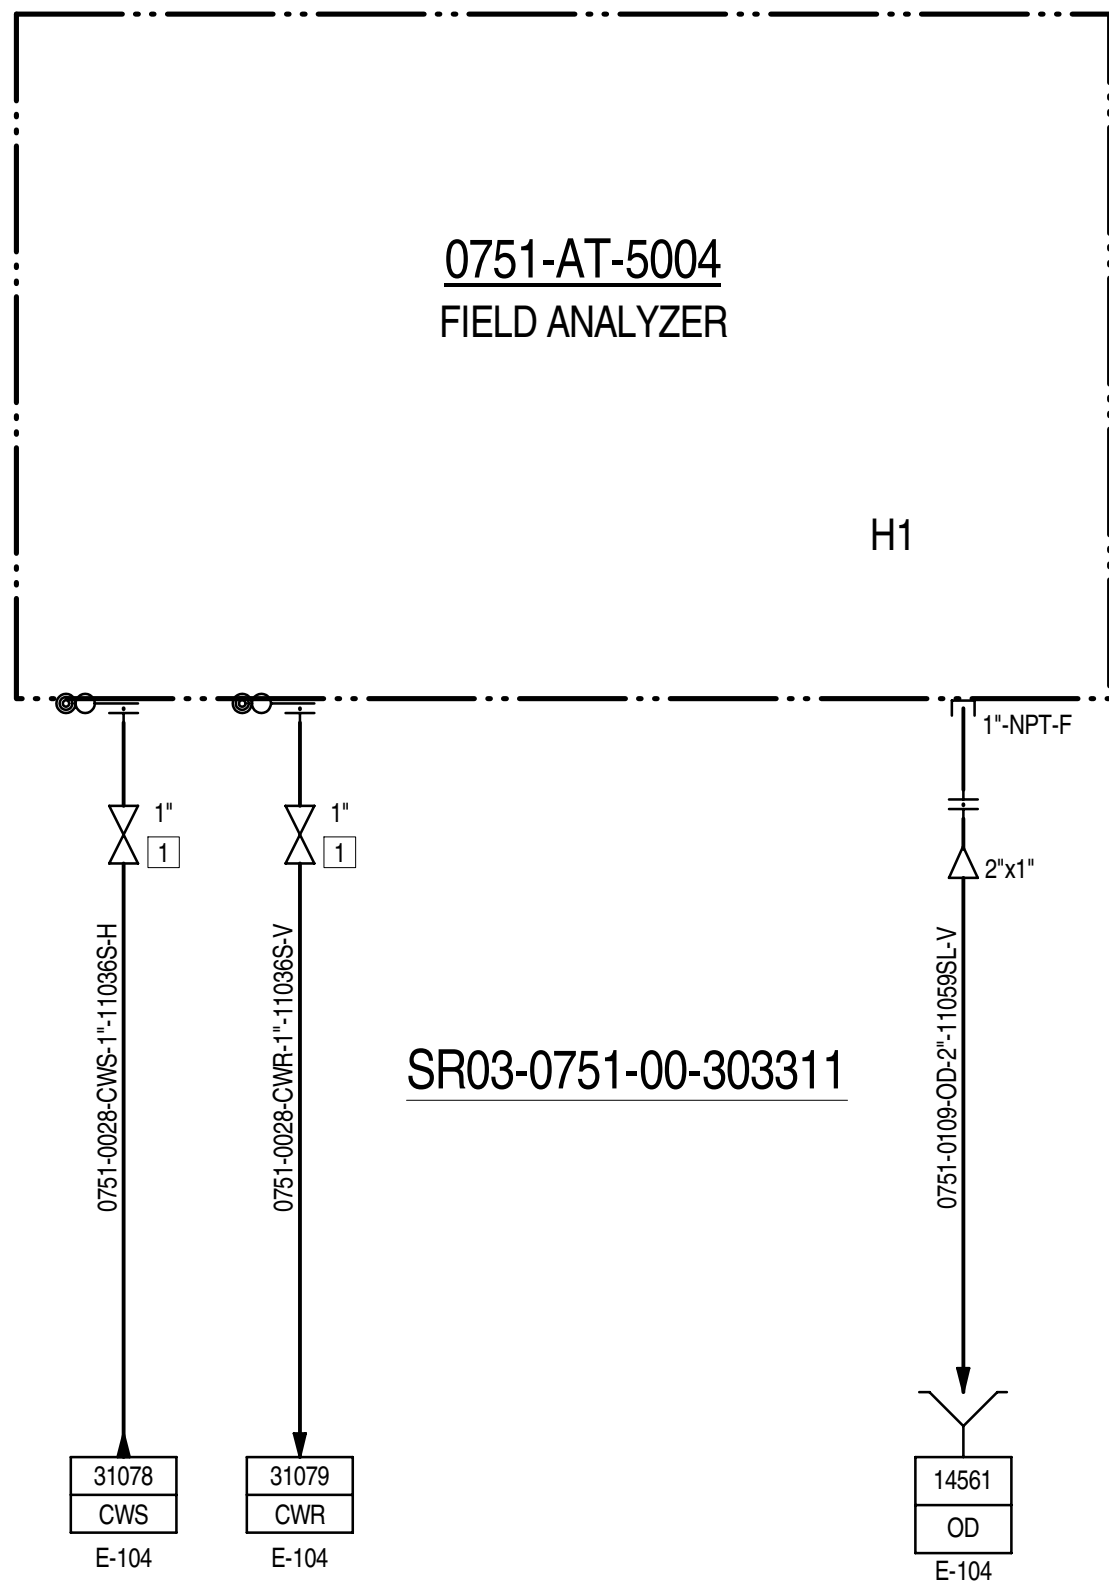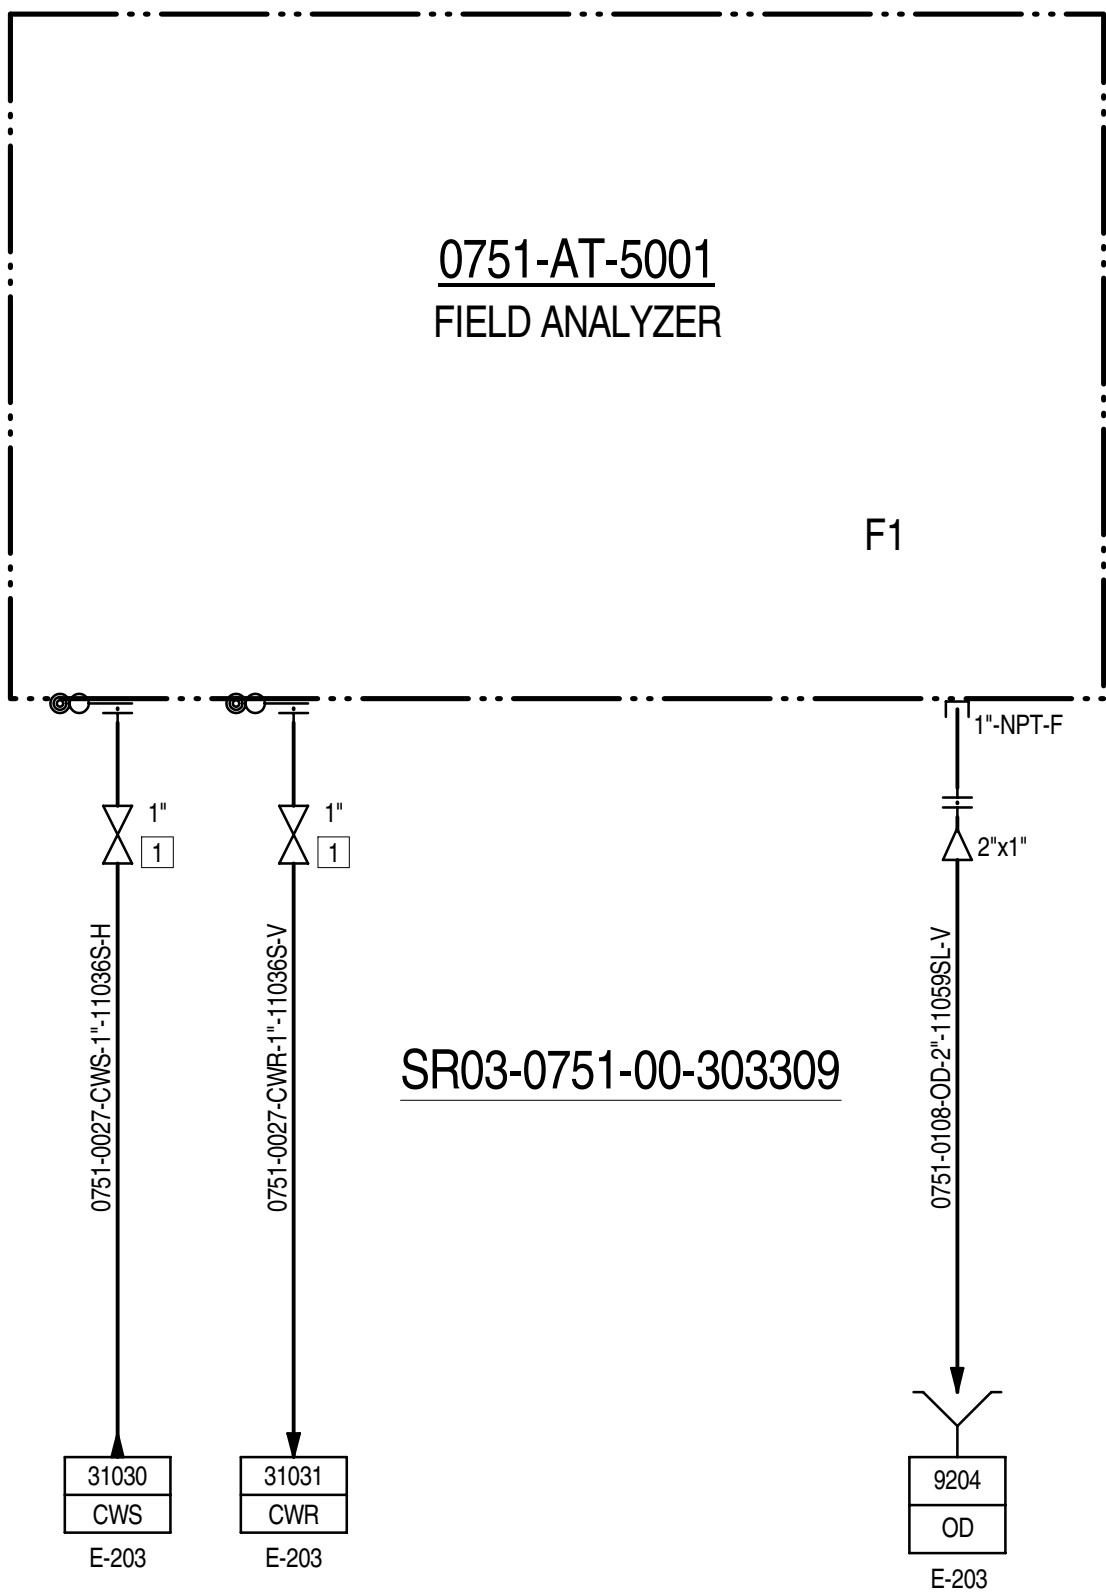

UTILITY REFERENCE TABLE			
OD	DRW.	No.SR03-0751-00-PID-362307	
CWR CWS	DRW.	No.SR03-0751-00-PID-362308	

Z1	04-11-14	IAB	ISSUED FOR AS BUILT	PCA	MAR	ASP
2.1E	18-04-14	IFC	ISSUED FOR CONSTRUCTION	PCA	MAR	ASP
2.1D	28-02-14	IFC	ISSUED FOR CONSTRUCTION	PCA	MAR	ASP
2.1C	31-10-12	IFC	ISSUED FOR CONSTRUCTION	RL	MF	MZ
2.1B	06-08-12	IFC	ISSUED FOR CONSTRUCTION	DSC	CBR	SIN
2	03-10-11	IFC	ISSUED FOR CONSTRUCTION	DSC	CBR	SIN
1	11-05-11	IFCH	ISSUED AS 230-GD-B-004007 FOR CONSTRUCTION WITH HOLDS	FDA	MVI	ASP
0	24-01-11	IFD	ISSUED AS 230-GD-B-004007 FOR CLIENT COMMENTS INCORPORATED	FDA	MVI	ASP
REV	DATE	STATUS	STATUS DESCRIPTION	BY	CKD	APP.

COMPANY:

Abu Dhabi Gas Development Co. Ltd.



CONTRACTOR:



JOB No. 032090

PROJECT: SHAH GAS DEVELOPMENT (SGD) PROJECT
SHAH PROCESS PLANT

AGREEMENT No. 13525001

DRAWING TITLE: PIPING & INSTRUMENT DIAGRAM UNIT 0751
SULPHUR RECOVERY AND TAIL GAS TREATING UNIT


EQUIPMENT DESCRIPTION INSTRUMENT DETAILS: ANALYZER

TAG/ITEM No. FIELD

CONTRACTOR DRG.No.	751-GD-B-303371	REV. Z1
COMPANY DRG.No.	SR03-0751-00-303371-002	

SCALE:	SIZE: A1	DOC. CLASS: 1
--------	----------	---------------

THIS DOCUMENT IS THE PROPERTY OF ABU DHABI GAS DEVELOPMENT COMPANY LIMITED AND CONTAINS INFORMATION WHICH IS PROPRIETARY. THIS INFORMATION IS TO BE HELD IN CONFIDENCE. NO DISCLOSURE OR OTHER USE OF THIS DOCUMENT IS TO BE MADE WITHOUT THE PRIOR WRITTEN CONSENT OF ABU DHABI GAS DEVELOPMENT COMPANY LIMITED.

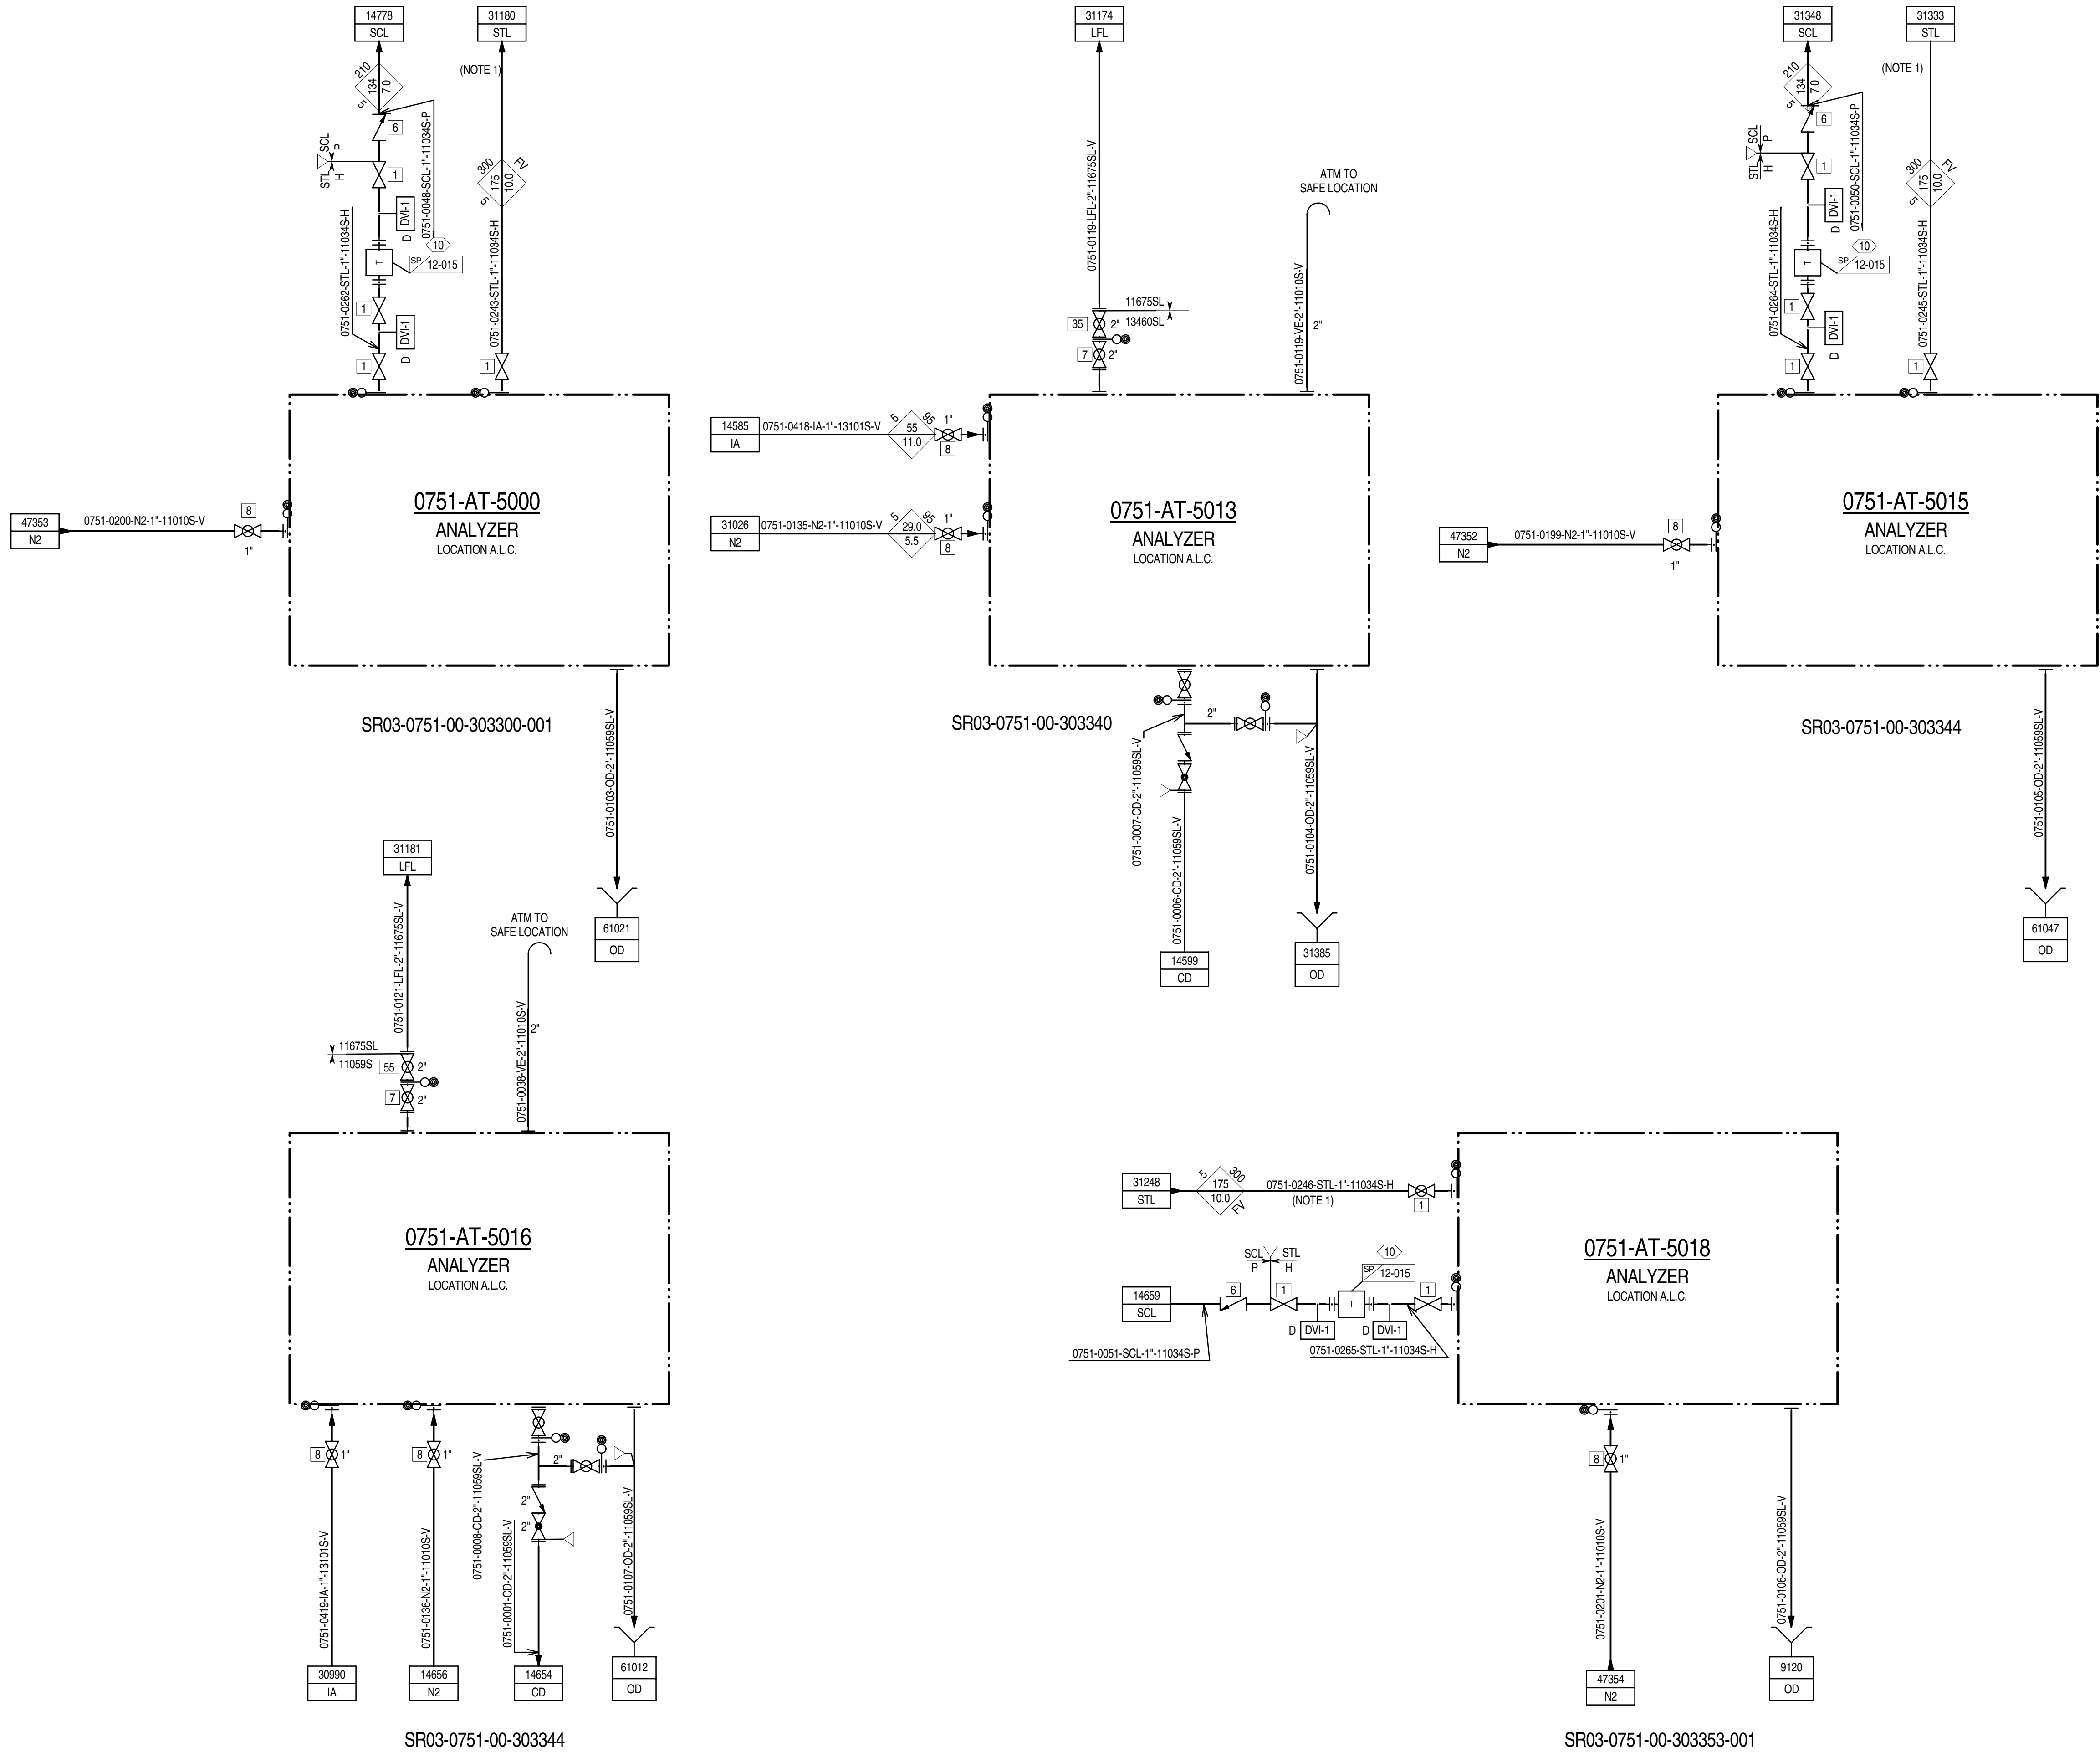

- GENERAL NOTES:**
- FOR STANDARD SYMBOLS, DETAILS, ABBREVIATIONS, SAMPLE CONNECTION TYPE, GENERAL NOTES & LEGEND SHEETS REFER TO DRAWING N°. MP02-0230-00-004000 TO 004017.
 - ALL INSTRUMENT TAG NUMBERS ON THIS P&ID INCLUDING PACKAGE UNITS ARE PREFIXED WITH UNIT NUMBER 0751 UNLESS OTHERWISE NOTED.

- NOTES:**
- STL SUPPLIED @ 8 barg AND 175 °C.

UTILITY REFERENCE TABLE		
BBD SCL	DRW.	No. SR03-0751-00-PID-362303
IA	DRW.	No. SR03-0751-00-PID-362305_001
CD	DRW.	No. SR03-0751-00-PID-362306
OD	DRW.	No. SR03-0751-00-PID-362307
N2 FGL	DRW.	No. SR03-0751-00-PID-362310
STH SCL	DRW.	No. SR03-0751-00-PID-362312_001
LFL	DRW.	No. SR03-0751-00-PID-362313

REV	DATE	STATUS	STATUS DESCRIPTION	BY	CKD	APP.
Z1	04-11-14	IAB	ISSUED FOR AS BUILT	PCA	MAR	ASP
2.1E	18-04-14	IFC	ISSUED FOR CONSTRUCTION	PCA	MAR	ASP
2.1D	28-02-14	IFC	ISSUED FOR CONSTRUCTION	PCA	MAR	ASP
2.1C	31-10-12	IFC	ISSUED FOR CONSTRUCTION	RL	MF	MZ
2.1B	06-08-12	IFC	ISSUED FOR CONSTRUCTION	DSC	CBF	SIN
2	03-10-11	IFC	ISSUED FOR CONSTRUCTION	DSC	CBF	SIN
1	11-05-11	IFCH	ISSUED AS 230-GD-B-004007 FOR CONSTRUCTION WITH HOLDS	FDA	MVI	ASP
0	24-01-11	IFD	ISSUED AS 230-GD-B-004007 FOR CLIENT COMMENTS INCORPORATED	FDA	MVI	ASP

COMPANY:

Abu Dhabi Gas Development Co. Ltd.

CONTRACTOR:

JOB No. 032090

PROJECT:

SHAH GAS DEVELOPMENT (SGD) PROJECT
SHAH PROCESS PLANT


AGREEMENT No. 13525001

DRAWING TITLE: PIPING & INSTRUMENT DIAGRAM UNIT 0751
SULPHUR RECOVERY AND TAIL GAS TREATING UNIT

EQUIPMENT DESCRIPTION	INSTRUMENT DETAIL ANALYZER
TAGITEM No.	A.L.C.

CONTRACTOR DRG. No.	751-GD-B-303371	REV. Z1
COMPANY DRG. No.	SR03-0751-00-303371-003	
SCALE:	SIZE: A1 DOC. CLASS: 1	

THIS DOCUMENT IS THE PROPERTY OF ABU DHABI GAS DEVELOPMENT COMPANY LIMITED AND CONTAINS INFORMATION WHICH IS PROPRIETARY. THIS INFORMATION IS TO BE HELD IN CONFIDENCE. NO DISCLOSURE OR OTHER USE OF THIS DOCUMENT IS TO BE MADE WITHOUT THE PRIOR WRITTEN CONSENT OF ABU DHABI GAS DEVELOPMENT COMPANY LIMITED.

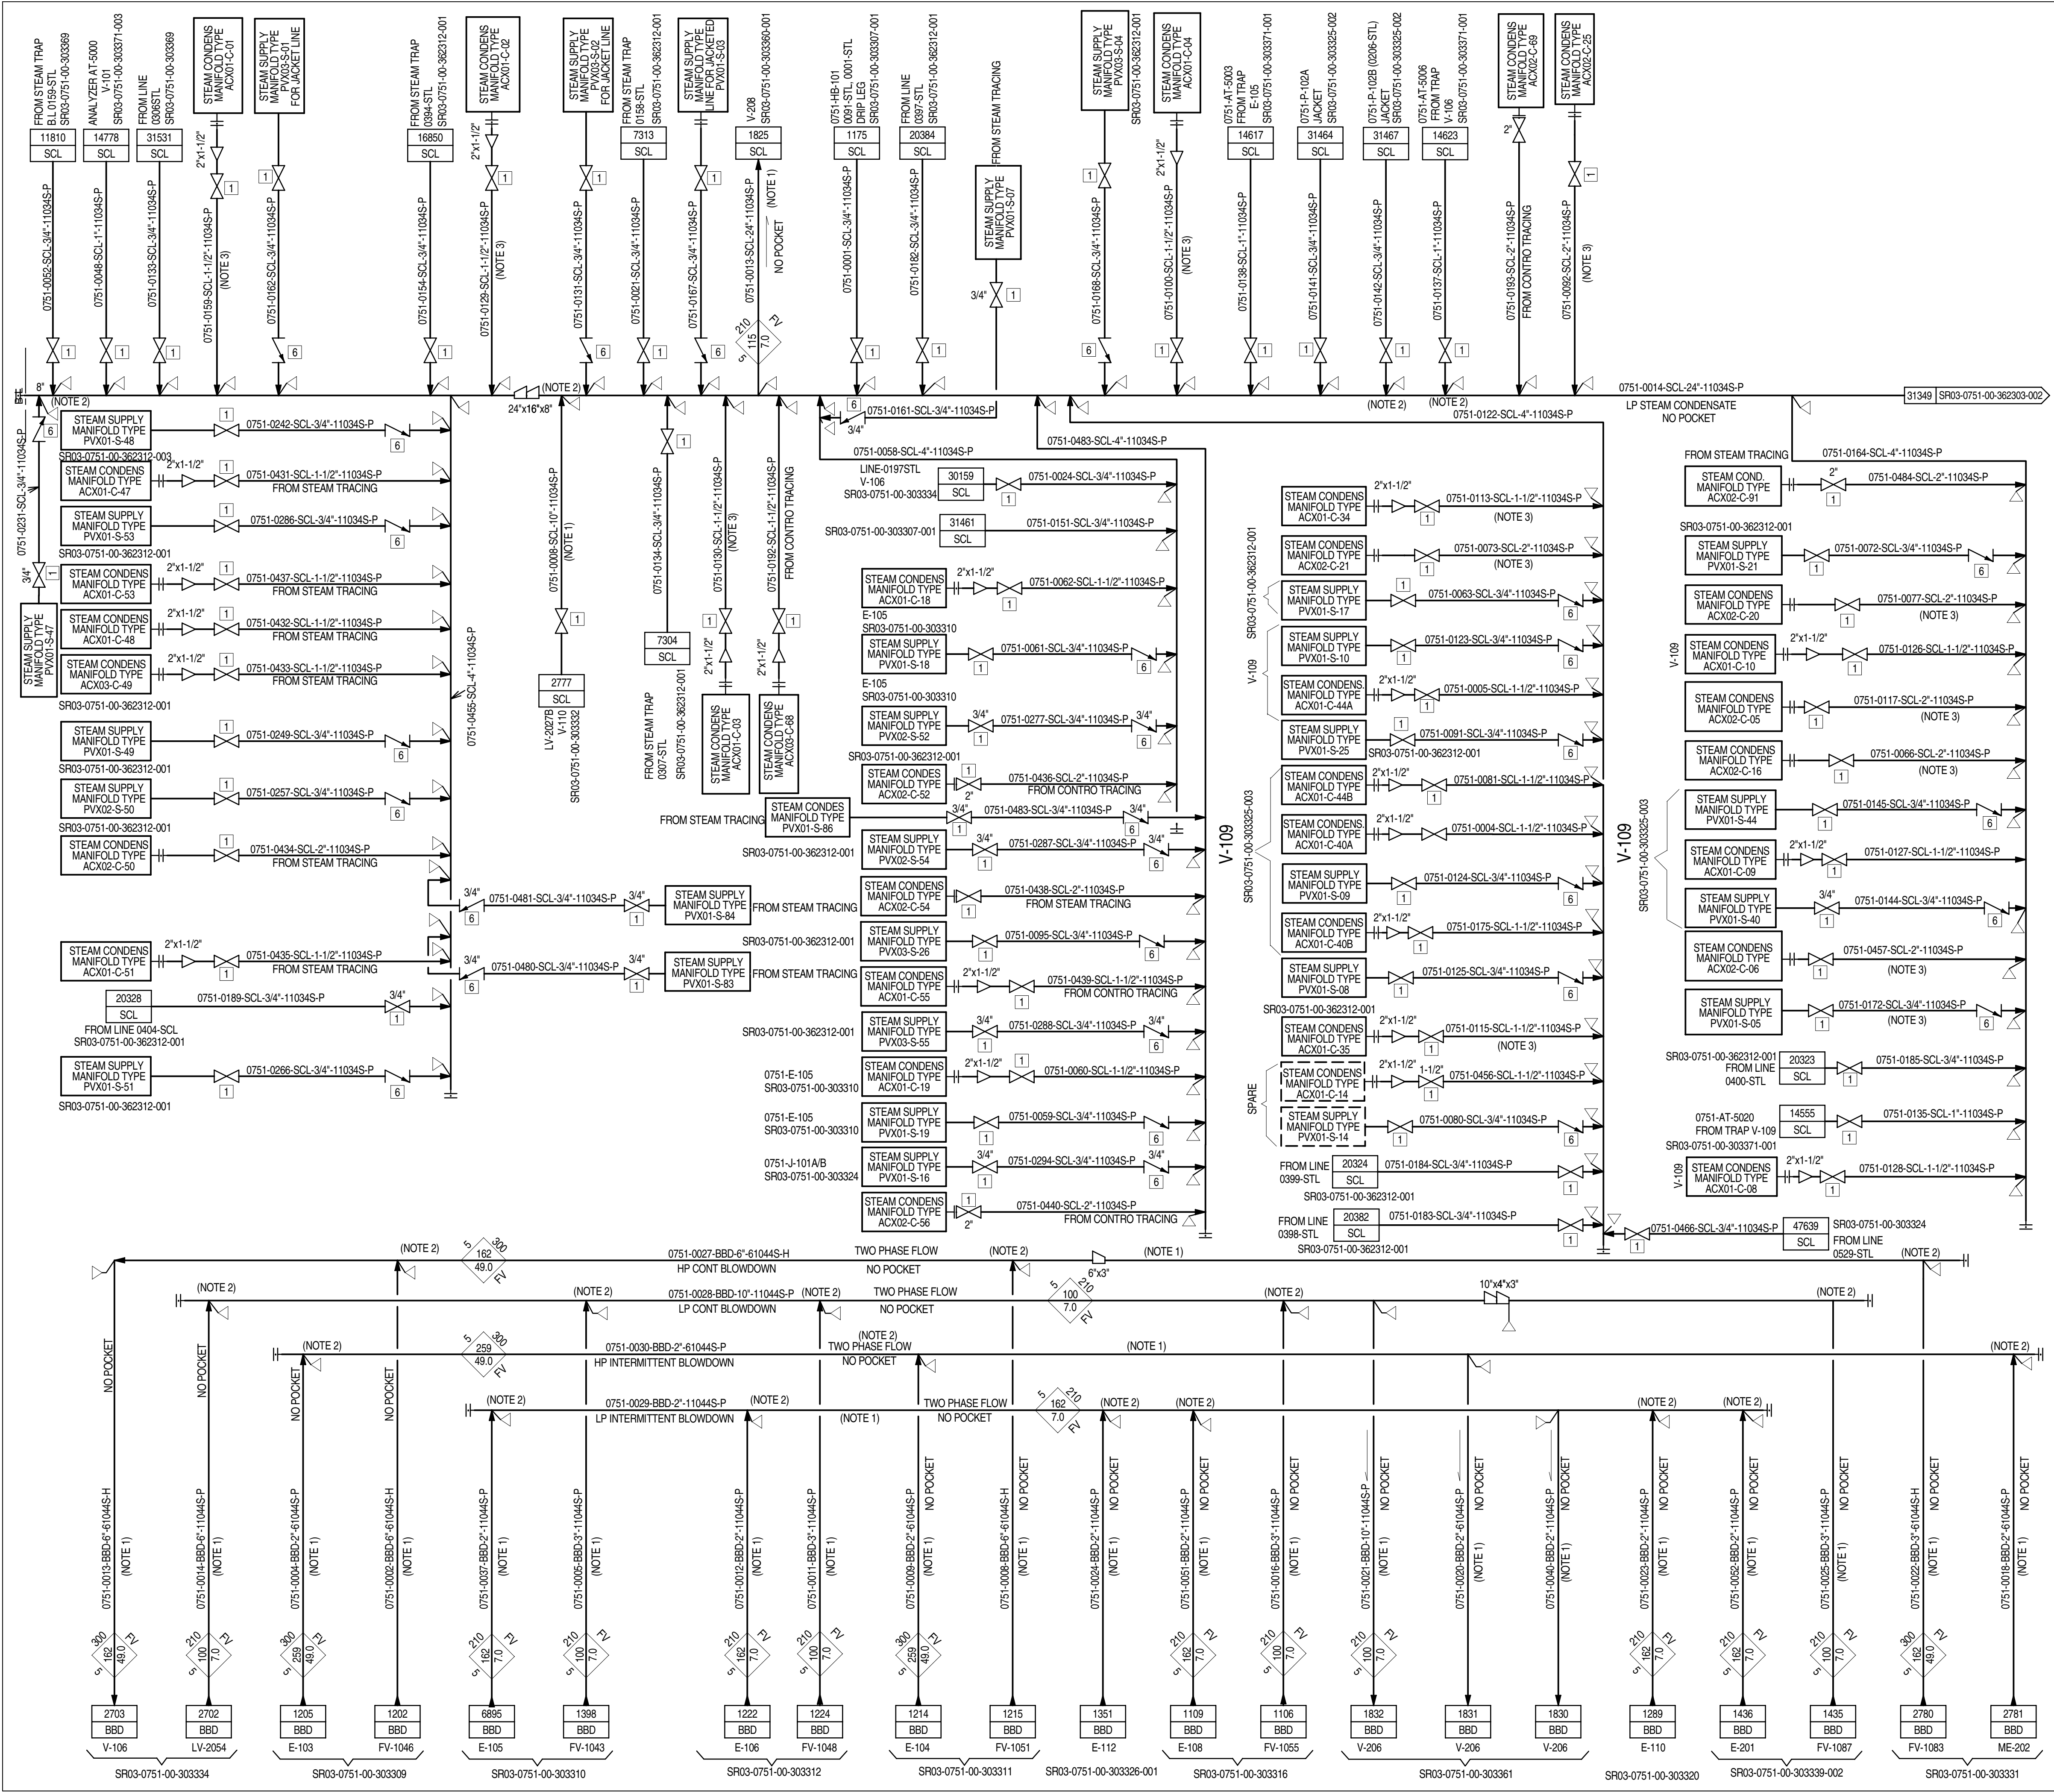

GENERAL NOTES:

1. FOR STANDARD SYMBOLS, DETAILS, ABBREVIATIONS, SAMPLE CONNECTION TYPE, GENERAL NOTES & LEGEND SHEETS REFER TO DRAWING NO. MP02-0230-00-004000 TO 004015.

NOTES:

1. TWO PHASE FLOW
2. TOP ENTRY
3. CONDENSATE RETURN FROM JACKETED LINE, REFER P&ID SR03-0751-00-362312-005.

REV	DATE	STATUS	STATUS DESCRIPTION	BY	CKD	APP.
Z1	10-11-14	IAB	ISSUED FOR AS BUILT	ANI	MAR	ASP
3.1C	15-07-14	IFC	ISSUED FOR CONSTRUCTION	ANI	MAR	ASP
3.1B	04-05-13	IFC	ISSUED FOR CONSTRUCTION	RL	IP	MZ
3.1A	31-10-12	IFC	ISSUED FOR CONSTRUCTION	RL	LM	MZ
3	24/08/12	IFC	ISSUED FOR CONSTRUCTION	FP	LM	PP
2	17/01/12	IFC	ISSUED FOR CONSTRUCTION	FZ	LM	PP
1	16/09/11	IFCH	ISSUED FOR CONSTRUCTION WITH HOLDS	FZ	LM	PP
0	22/03/11	IFD	ISSUED CLIENT COMMENTS INCORPORATED	FZ	LM	PP
B1	07-10-10	ICR	ISSUED FOR CLIENT REVIEW	CM	FZ	LM

COMPANY:

Abu Dhabi Gas Development Co. Ltd.

CONTRACTOR:

PROJECT: SHAH GAS DEVELOPMENT (SGD) PROJECT
SHAH SULPHUR RECOVERY UNIT

AGREEMENT No. 13525001

DRAWING TITLE: PIPING & INSTRUMENT DIAGRAM UNIT 0751
SULPHUR RECOVERY AND TAIL GAS TREATING UNIT

EQUIPMENT DESCRIPTION	LP STEAM CONDENSATE & BLOWDOWN DISTRIBUTION
TAGITEM No.	

CONTRACTOR DRG. No.	751-GD-B-362303	REV.
COMPANY DRG. No.	SR03-0751-00-362303-001	Z1
SCALE:	SIZE: A1	DOC. CLASS: 1

1
2
3
4
5
6
7
8
9
10


1. TWO PHASE FLOW
2. TOP ENTRY
3. STEAM CONDENSATE RETURN FROM JACKETED LINES, REFER SR03-0751-00-362312-005.

CONTRACTOR DRG. No.	751-GD-B-362303		REV. Z1
COMPANY DRG. No.	SR03-0751-00-362303-002		
SCALE:	SIZE: A1	DOC. CLASS: 1	

1. TWO PHASE FLOW
2. TOP ENTRY

CONTRACTOR DRG.No.		751-GD-B-362303	REV. Z1
COMPANY DRG.No.		SR03-0751-00-362303-003	
SCALE:	SIZE: A1	DOC. CLASS:	

THIS DOCUMENT IS THE PROPERTY OF ABU DHABI GAS DEVELOPMENT COMPANY LIMITED AND CONTAINS INFORMATION WHICH IS PROPRIETARY. THIS INFORMATION IS TO BE HELD IN CONFIDENCE. NO DISCLOSURE OR OTHER USE OF THIS DOCUMENT IS TO BE MADE WITHOUT THE PRIOR WRITTEN CONSENT OF ABU DHABI GAS DEVELOPMENT COMPANY LIMITED.

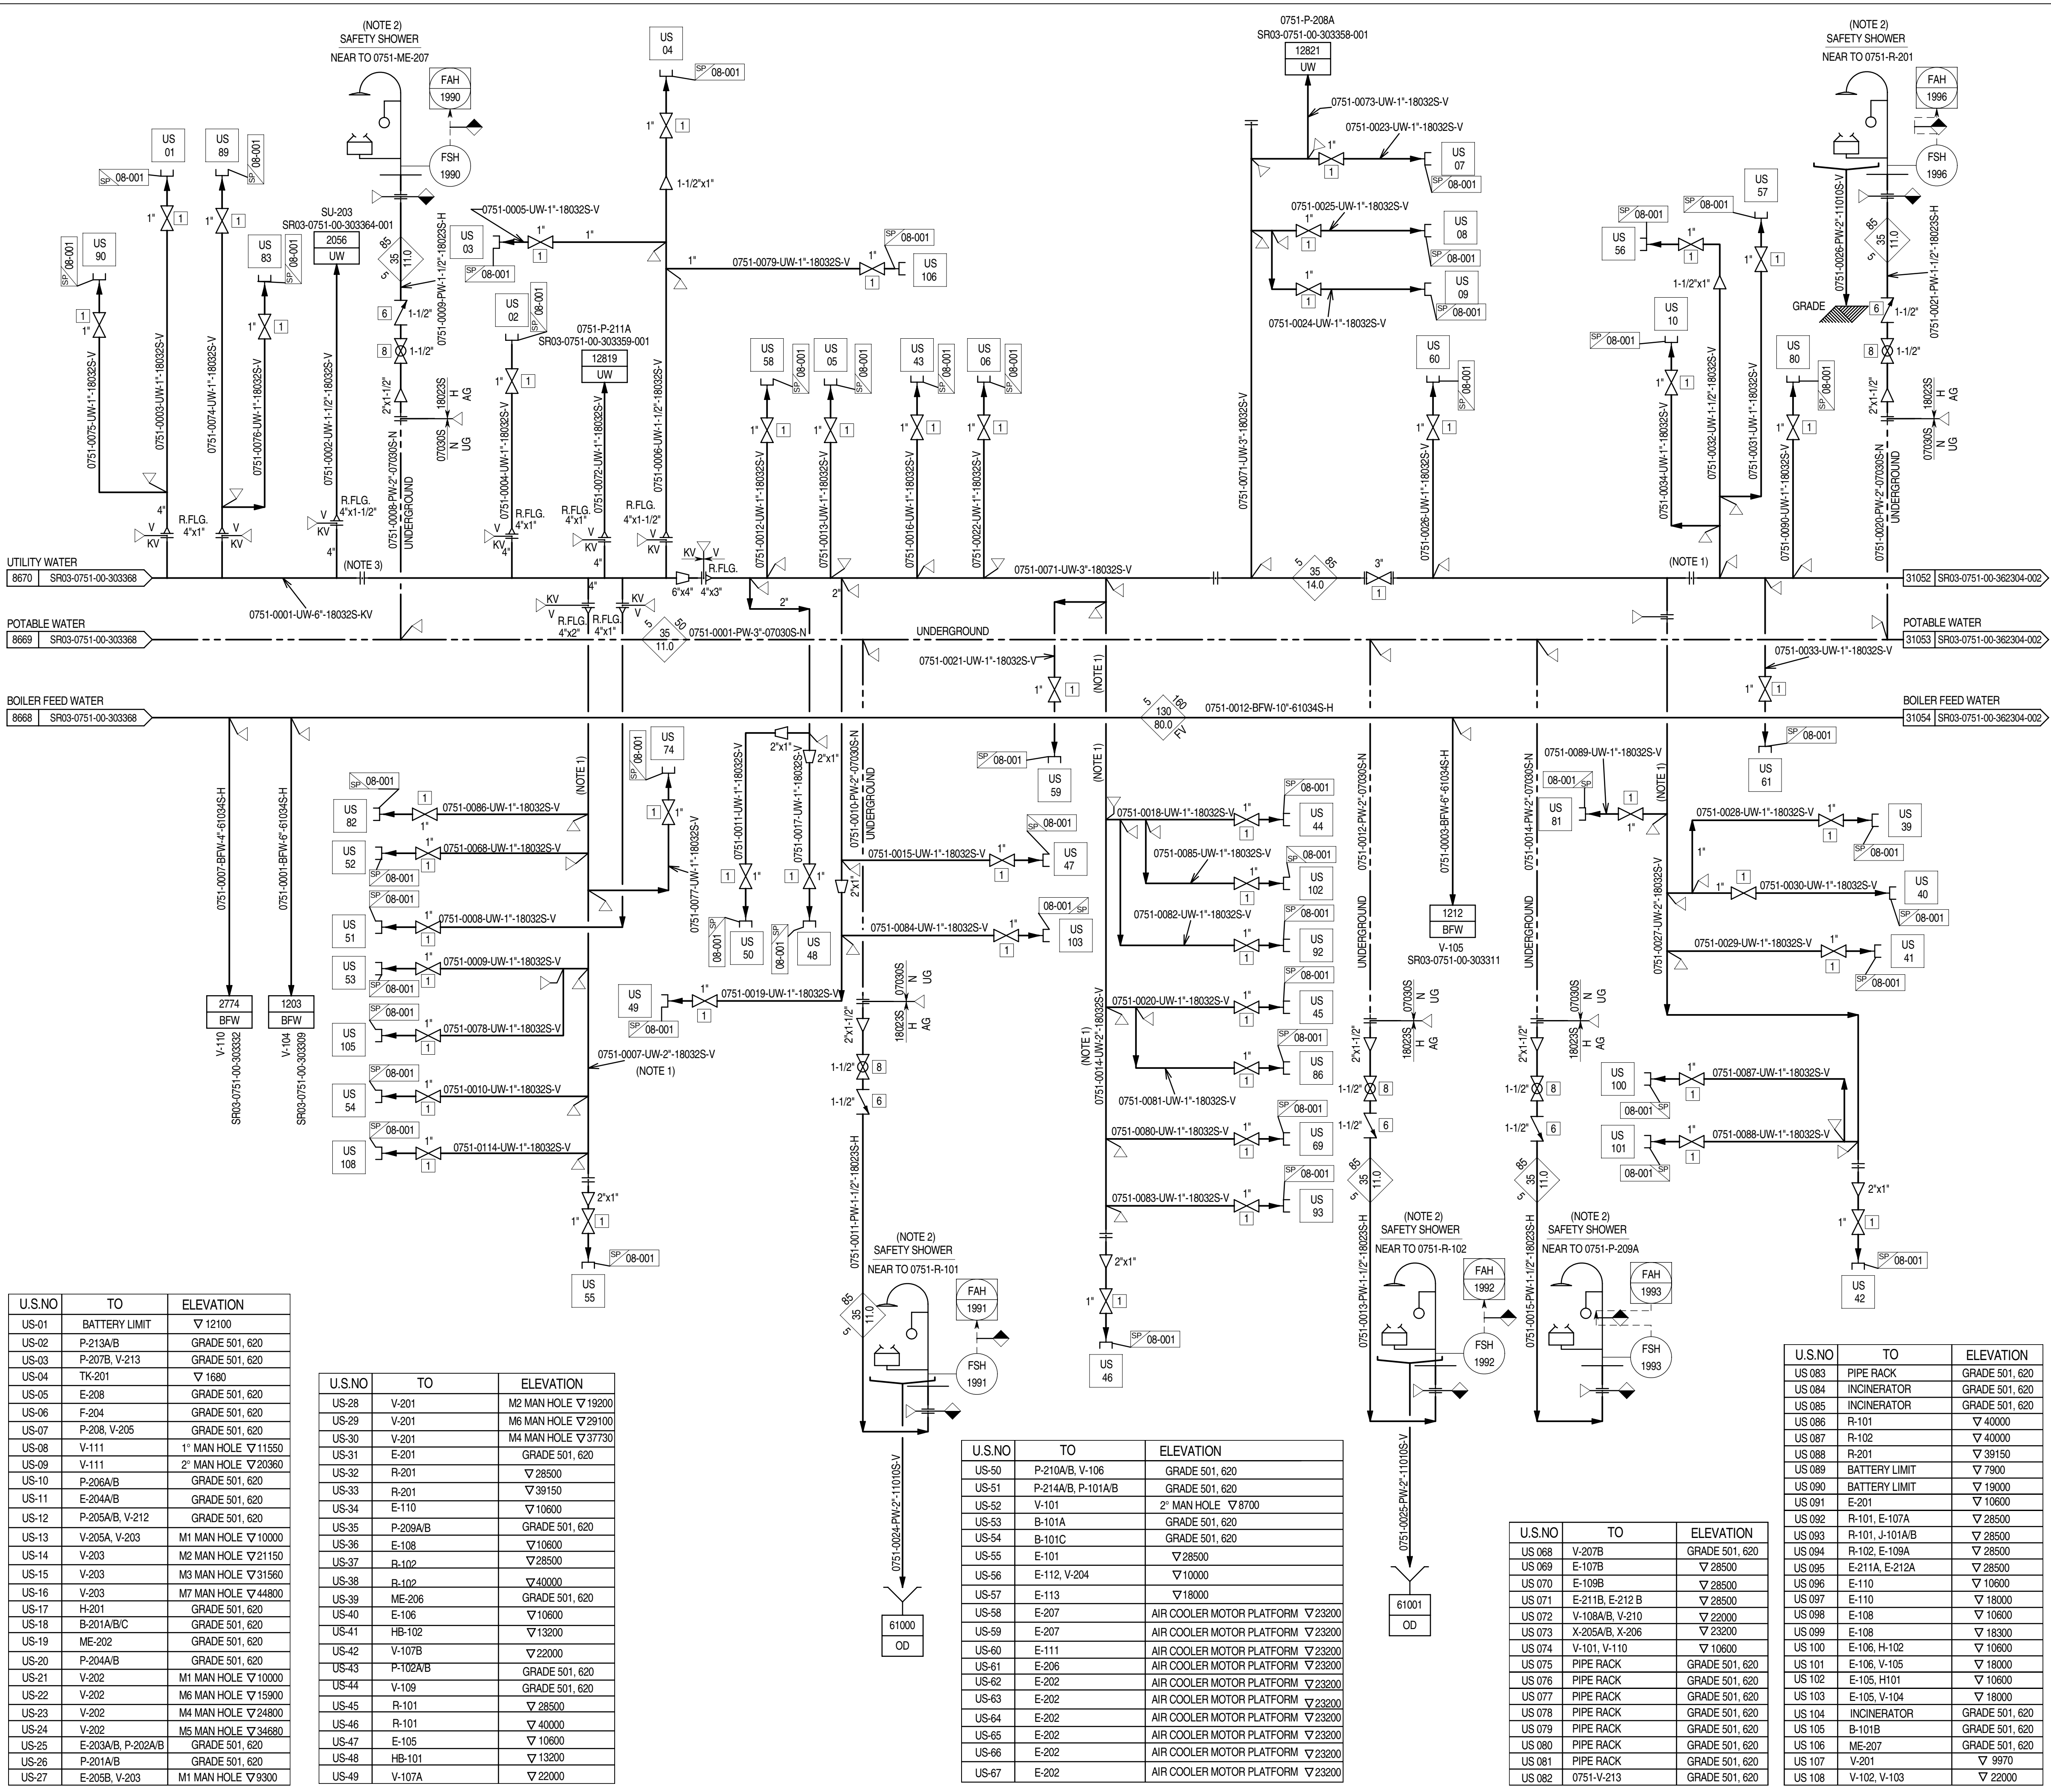

GENERAL NOTES:

- FOR STANDARD SYMBOLS, DETAILS, ABBREVIATIONS, SAMPLE CONNECTION TYPE, GENERAL NOTES & LEGEND SHEETS REFER TO DRAWING NO. MP02-0230-00-004000 TO 004015.

NOTES:

- PROVIDE A COUPLE OF FLANGES ANY THIRTY METERS ON HEADERS AND SUBHEADERS.
- SAFETY SHOWER NUMBER AND POSITION TO BE DEFINED BY LOSPE Dep:
- PREFABRICATED PIPE SPOOL SHALL HAVE FLANGED END ACCORDING TO "FBE" REQUIREMENTS SEE-SPE-MP02-0230-66-SPE-0674.

Z1	10-11-14	IAB	ISSUED FOR AS BUILT	ANI	MAR	ASP
3.1D	15-07-14	IFC	ISSUED FOR CONSTRUCTION	ANI	MAR	ASP
3.1C	30-03-14	IFC	ISSUED FOR CONSTRUCTION	ANI	MAR	ASP
3.1B	15-04-13	IFC	ISSUED FOR CONSTRUCTION	VM	IP	MZ
3.1A	31-10-12	IFC	ISSUED FOR CONSTRUCTION	RL	LM	MZ
3	10/07/12	IFC	ISSUED FOR CONSTRUCTION	FP	FZ	AS
2	17/01/12	IFC	ISSUED FOR CONSTRUCTION	FP	LM	PP
1	16/09/11	IFCH	ISSUED FOR CONSTRUCTION WITH HOLDS	FP	LM	PP
0	22/03/11	IFD	ISSUED CLIENT COMMENTS INCORPORATED	FZ	LM	PP
B1	12/10/10	ICR	ISSUED FOR CLIENT REVIEW	CM	FZ	LM
REV	DATE	STATUS	STATUS DESCRIPTION	BY	CKD	APP.

COMPANY:

Abu Dhabi Gas Development Co. Ltd.

CONTRACTOR:

PROJECT:

SHAH GAS DEVELOPMENT (SGD) PROJECT
SHAH SULPHUR RECOVERY UNIT

AGREEMENT No. 13525001

DRAWING TITLE: PIPING & INSTRUMENT DIAGRAM UNIT 0751
SULPHUR RECOVERY AND TAIL GAS TREATING UNIT

EQUIPMENT DESCRIPTION	BOILER FEED WATER, UTILITY & POTABLE WATER DISTR.
TAGITEM No.	


CONTRACTOR DRG. No.	751-GD-B-362304	REV.
COMPANY DRG. No.	SR03-0751-00-362304-001	Z1
SCALE:	SIZE: A1	DOC. CLASS: 1

1
2
3
4
5
6
7
8
9
10

1. PROVIDE A COUPLE OF FLANGES ANY THIRTY METERS ON HEADERS AND SUBHEADERS.
2. SAFETY SHOWER NUMBER AND POSITION TO BE DEFINED BY LOSPE Dep:
3. PREFABRICATED PIPE SPOOL SHALL HAVE FLANGED END ACCORDING TO "FBE" REQUIREMENTS SEE-SPE-MP02-0230-66-SPE-06704.

CONTRACTOR DRG. No.		751-GD-B-362304	REV. Z1
COMPANY DRG. No.		SR03-0751-00-362304-002	
SCALE:	SIZE: A1	DOC. CLASS: 1	

THIS DOCUMENT IS THE PROPERTY OF ABU DHABI GAS DEVELOPMENT COMPANY LIMITED AND CONTAINS INFORMATION WHICH IS PROPRIETARY. THIS INFORMATION IS TO BE HELD IN CONFIDENCE. NO DISCLOSURE OR OTHER USE OF THIS DOCUMENT IS TO BE MADE WITHOUT THE PRIOR WRITTEN CONSENT OF ABU DHABI GAS DEVELOPMENT COMPANY LIMITED.

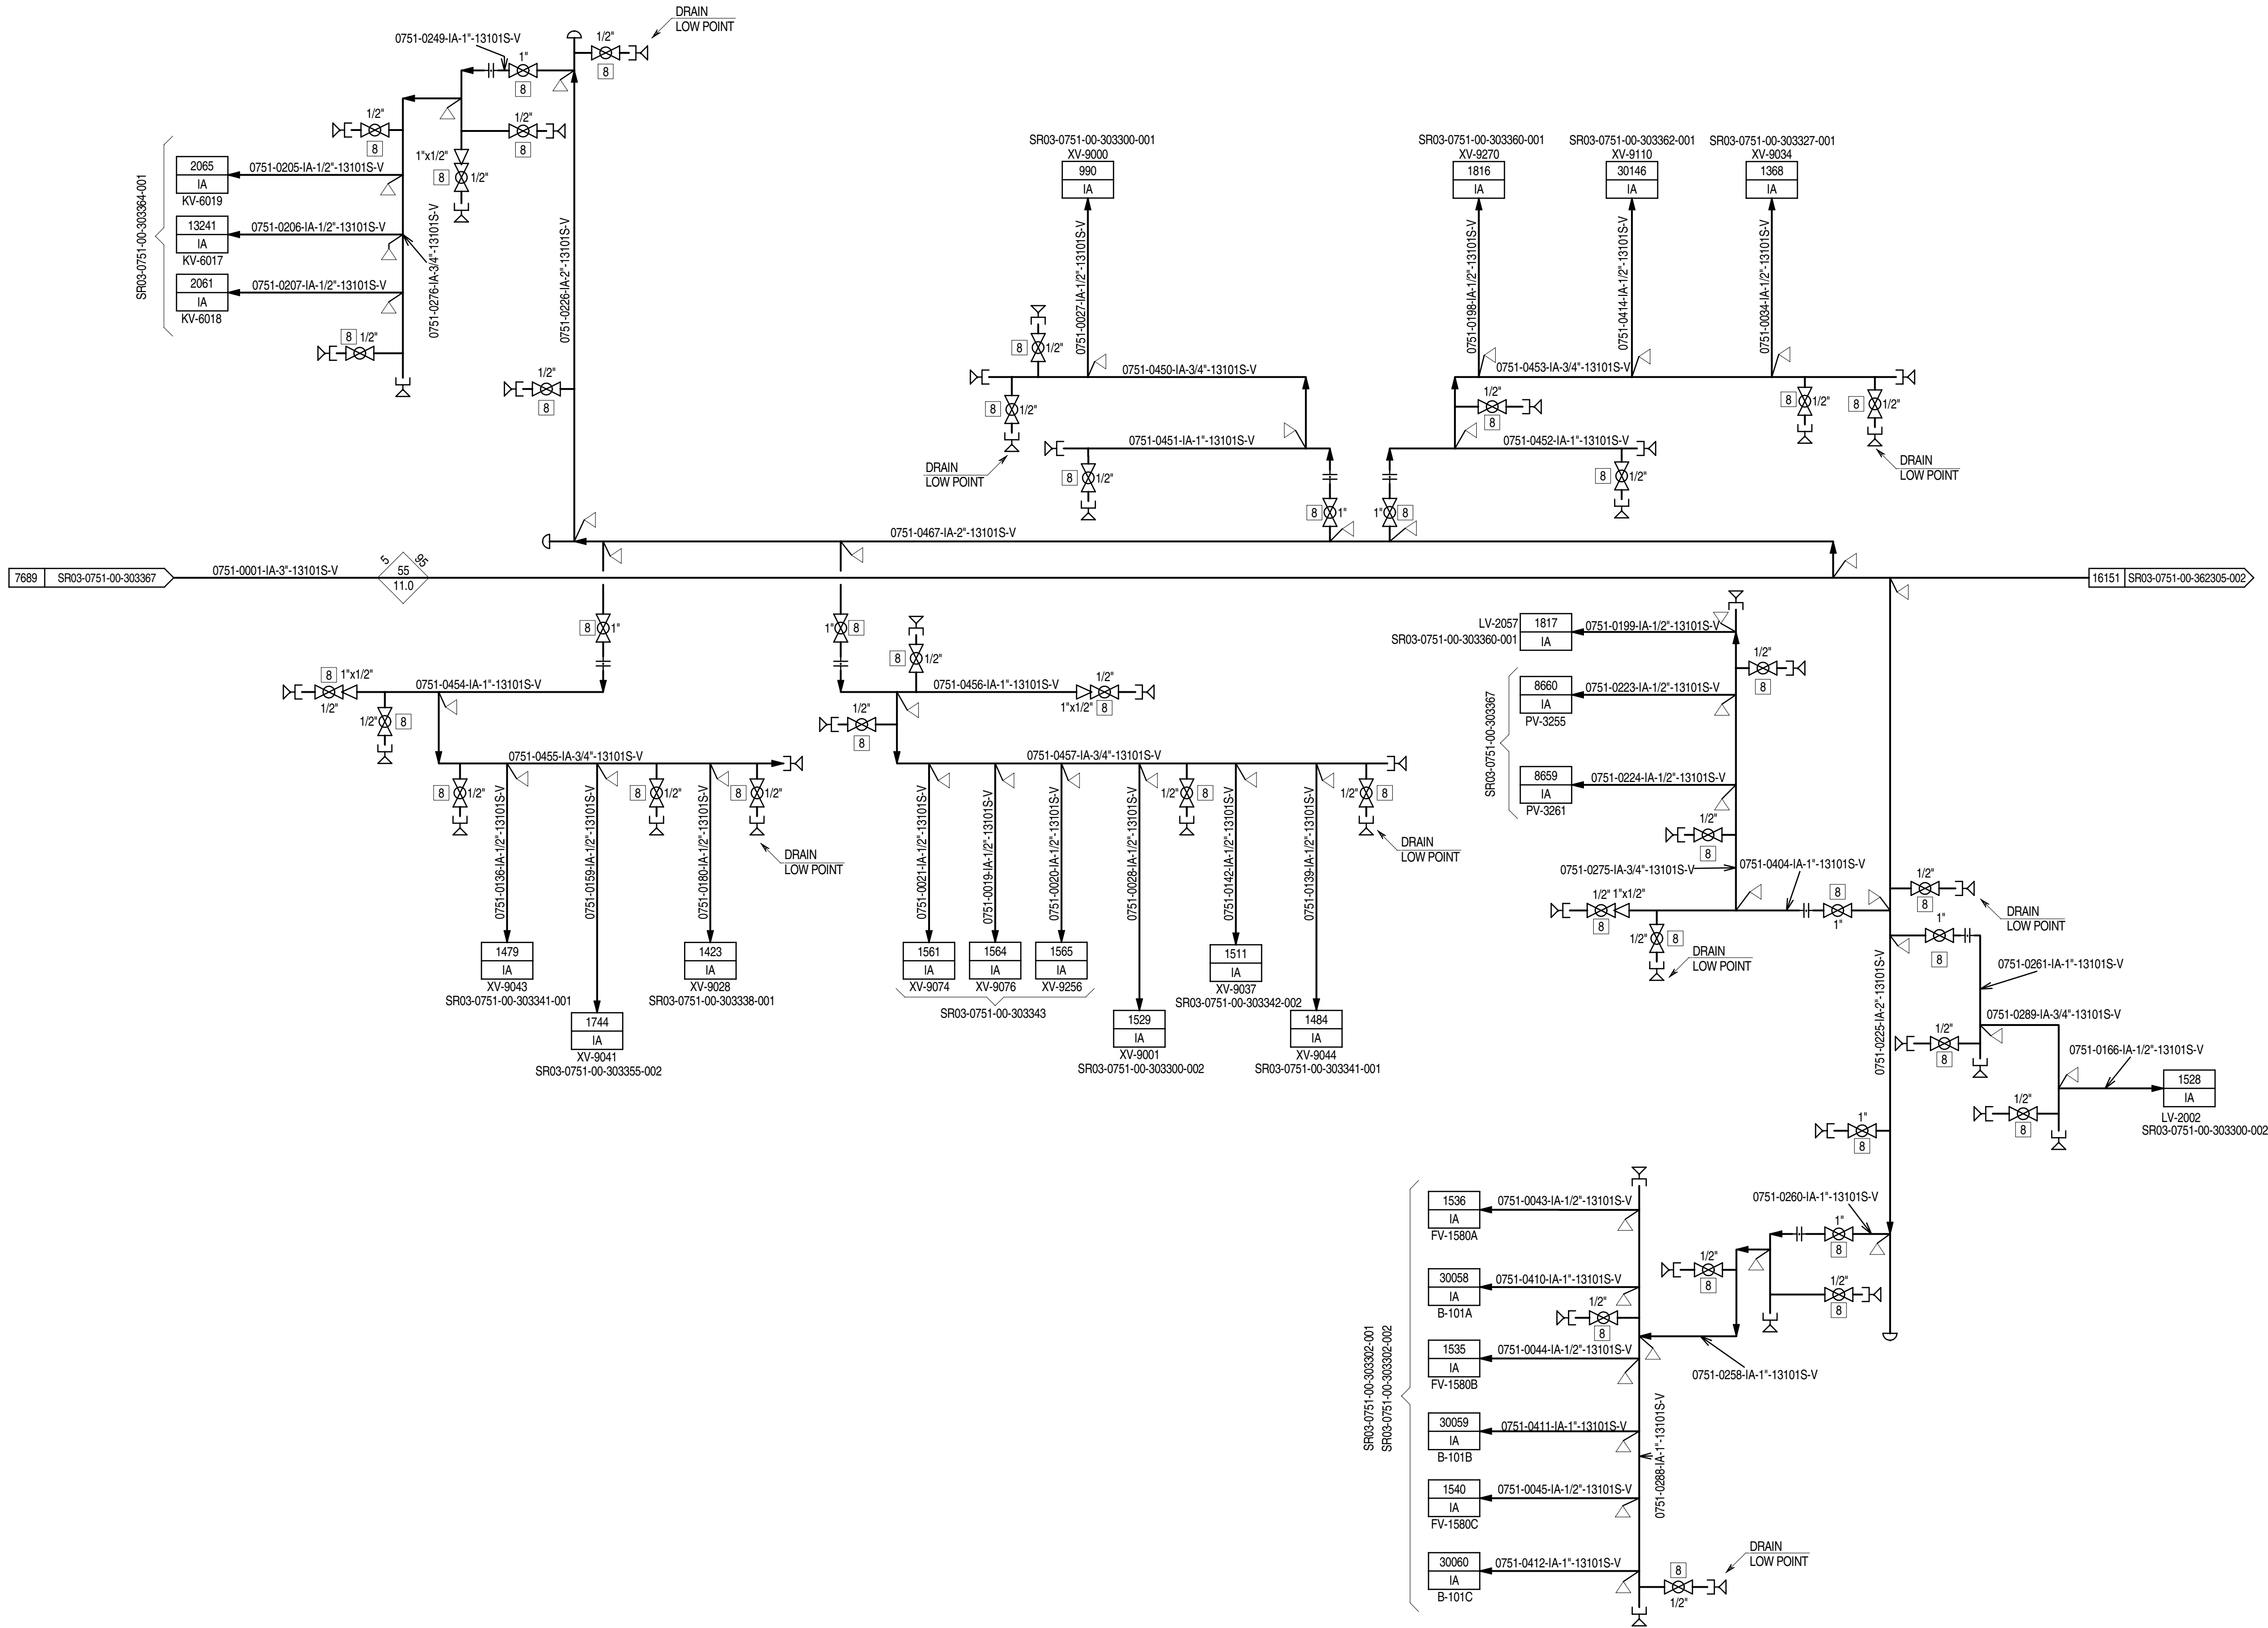

- GENERAL NOTES:**
- FOR STANDARD SYMBOLS, DETAILS, ABBREVIATIONS, SAMPLE CONNECTION TYPE, GENERAL NOTES & LEGEND SHEETS REFER TO DRAWING NO. MP02-0230-00-004000 TO 004015.
- NOTES:**
- REFER TO INSTRUMENT INSTALLIAN DESIGN SPECIFICATION DGS 1511-032 (INSTRUMENT AIR PIPING).
 - DRAIN VALVE SHALL BE PROVIDED FOR ANY LOW POINTS.

Z1	10-11-14	IAB	ISSUED FOR AS BUILT	ANI	MAR	ASP
3.1D	15-07-14	IFC	ISSUED FOR CONSTRUCTION	ANI	MAR	ASP
3.1C	30-03-14	IFC	ISSUED FOR CONSTRUCTION	ANI	MAR	ASP
3.1B	17-04-13	IFC	ISSUED FOR CONSTRUCTION	VM	IP	MZ
3.1A	31-10-12	IFC	ISSUED FOR CONSTRUCTION	RL	LM	MZ
3	05/07/12	IFC	ISSUED FOR CONSTRUCTION	FP	FZ	AS
2	17/01/12	IFC	ISSUED FOR CONSTRUCTION	FZ	LM	PP
1	16/09/11	IFCH	ISSUED FOR CONSTRUCTION WITH HOLDS	FZ	LM	PP
0	22/03/11	IFD	ISSUED CLIENT COMMENTS INCORPORATED	FZ	LM	PP
B1	15/10/10	ICR	ISSUED FOR CLIENT REVIEW	CM	FZ	LM
REV	DATE	STATUS	STATUS DESCRIPTION	BY	CKD	APP.

COMPANY:

Abu Dhabi Gas Development Co. Ltd.



CONTRACTOR:



JOB No. 032090

PROJECT:

SHAH GAS DEVELOPMENT (SGD) PROJECT
SHAH SULPHUR RECOVERY UNIT

AGREEMENT No. 13525001


DRAWING TITLE:

PIPING & INSTRUMENT DIAGRAM UNIT 0751
SULPHUR RECOVERY AND TAIL GAS TREATING UNIT

EQUIPMENT DESCRIPTION	INSTRUMENT AIR SYSTEM DISTRIBUTION	
TAGITEM No.		

CONTRACTOR DRG. No.	0751-GD-B-362305	REV. Z1
COMPANY DRG. No.	SR03-0751-00-362305-001	
SCALE:	SIZE: A1	DOC. CLASS: 1

THIS DOCUMENT IS THE PROPERTY OF ABU DHABI GAS DEVELOPMENT COMPANY LIMITED AND CONTAINS INFORMATION WHICH IS PROPRIETARY. THIS INFORMATION IS TO BE HELD IN CONFIDENCE. NO DISCLOSURE OR OTHER USE OF THIS DOCUMENT IS TO BE MADE WITHOUT THE PRIOR WRITTEN CONSENT OF ABU DHABI GAS DEVELOPMENT COMPANY LIMITED.

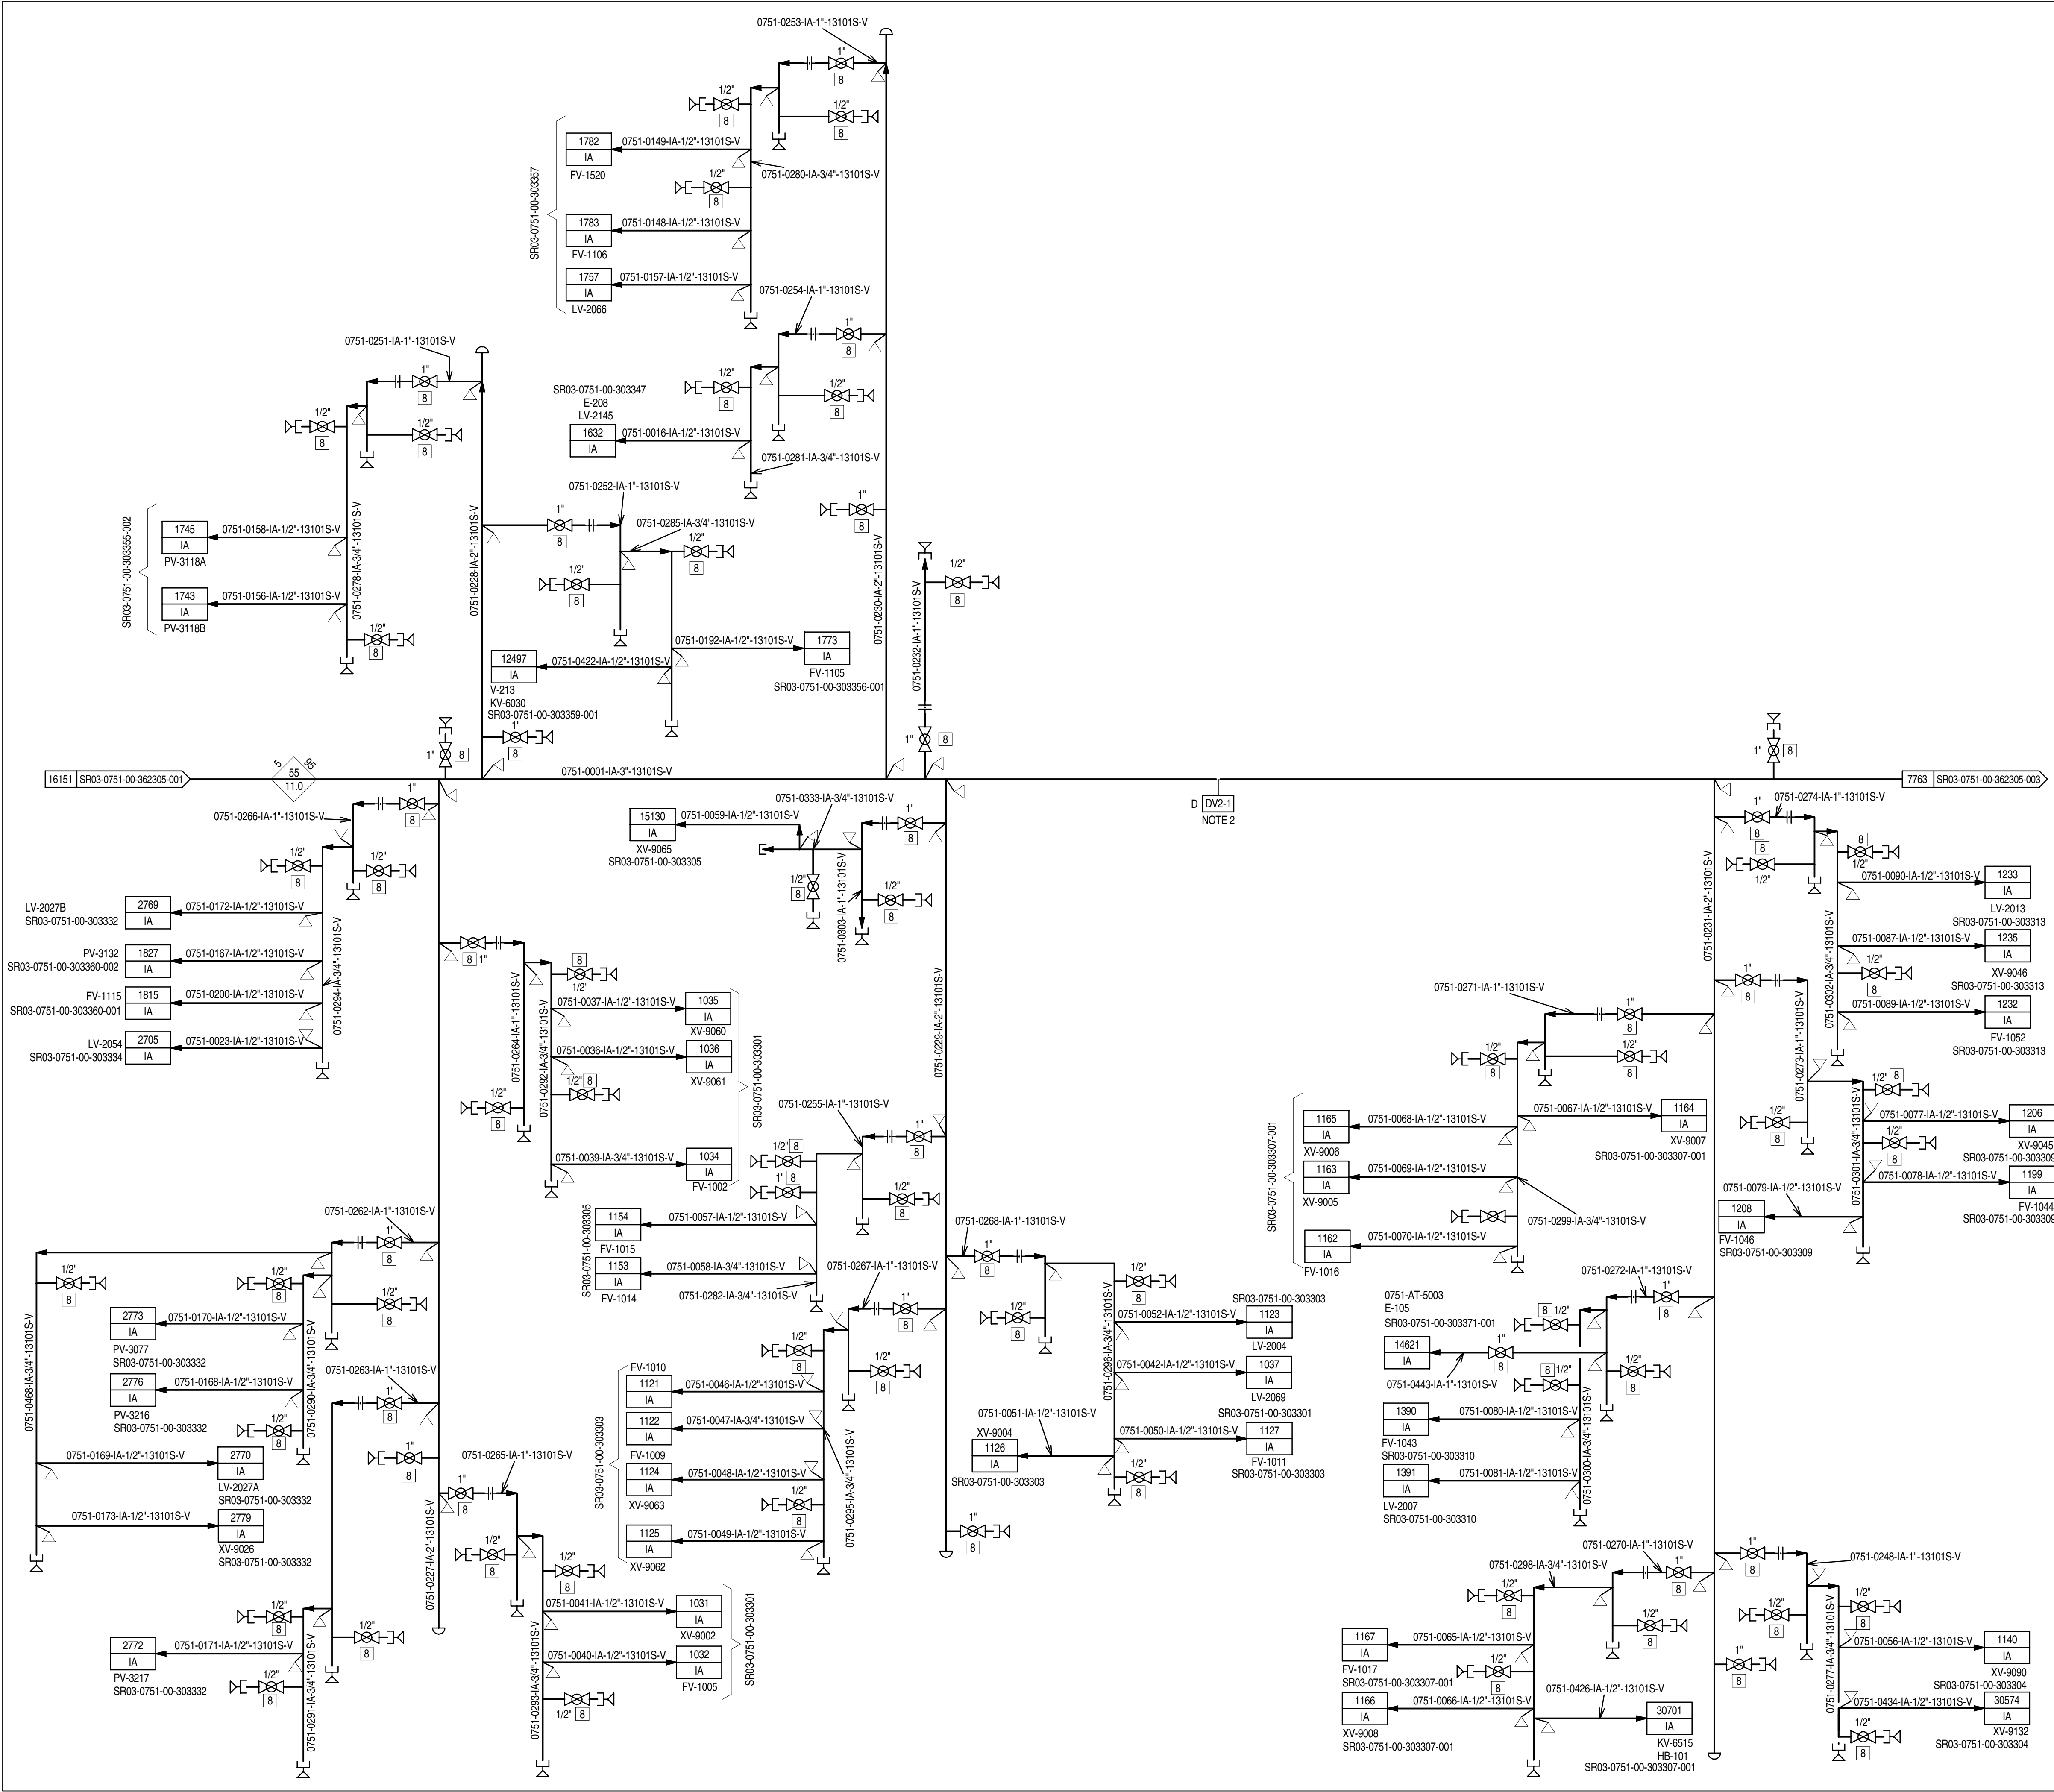


1. REFER TO INSTRUMENT INSTALLATION DESIGN SPECIFICATION DGS 1511-032 (INSTRUMENT AIR PIPING).
2. DRAIN VALVES SHALL BE PROVIDED FOR ANY LOW POINT.


CONTRACTOR DRG.No.		751-GD-B-362305		REV. Z1
COMPANY DRG.No.		SR03-0751-00-362305-003		
SCALE:	SIZE: A1	DOC. CLASS: 1		

2. DRAIN VALVES SHALL BE PROVIDED FOR ANY LOW POINT.

CONTRACTOR DRG.No.		751-GD-B-362305	REV. Z1
COMPANY DRG.No.		SR03-0751-00-362305-004	
SCALE:	SIZE: A1	DOC. CLASS: 1	

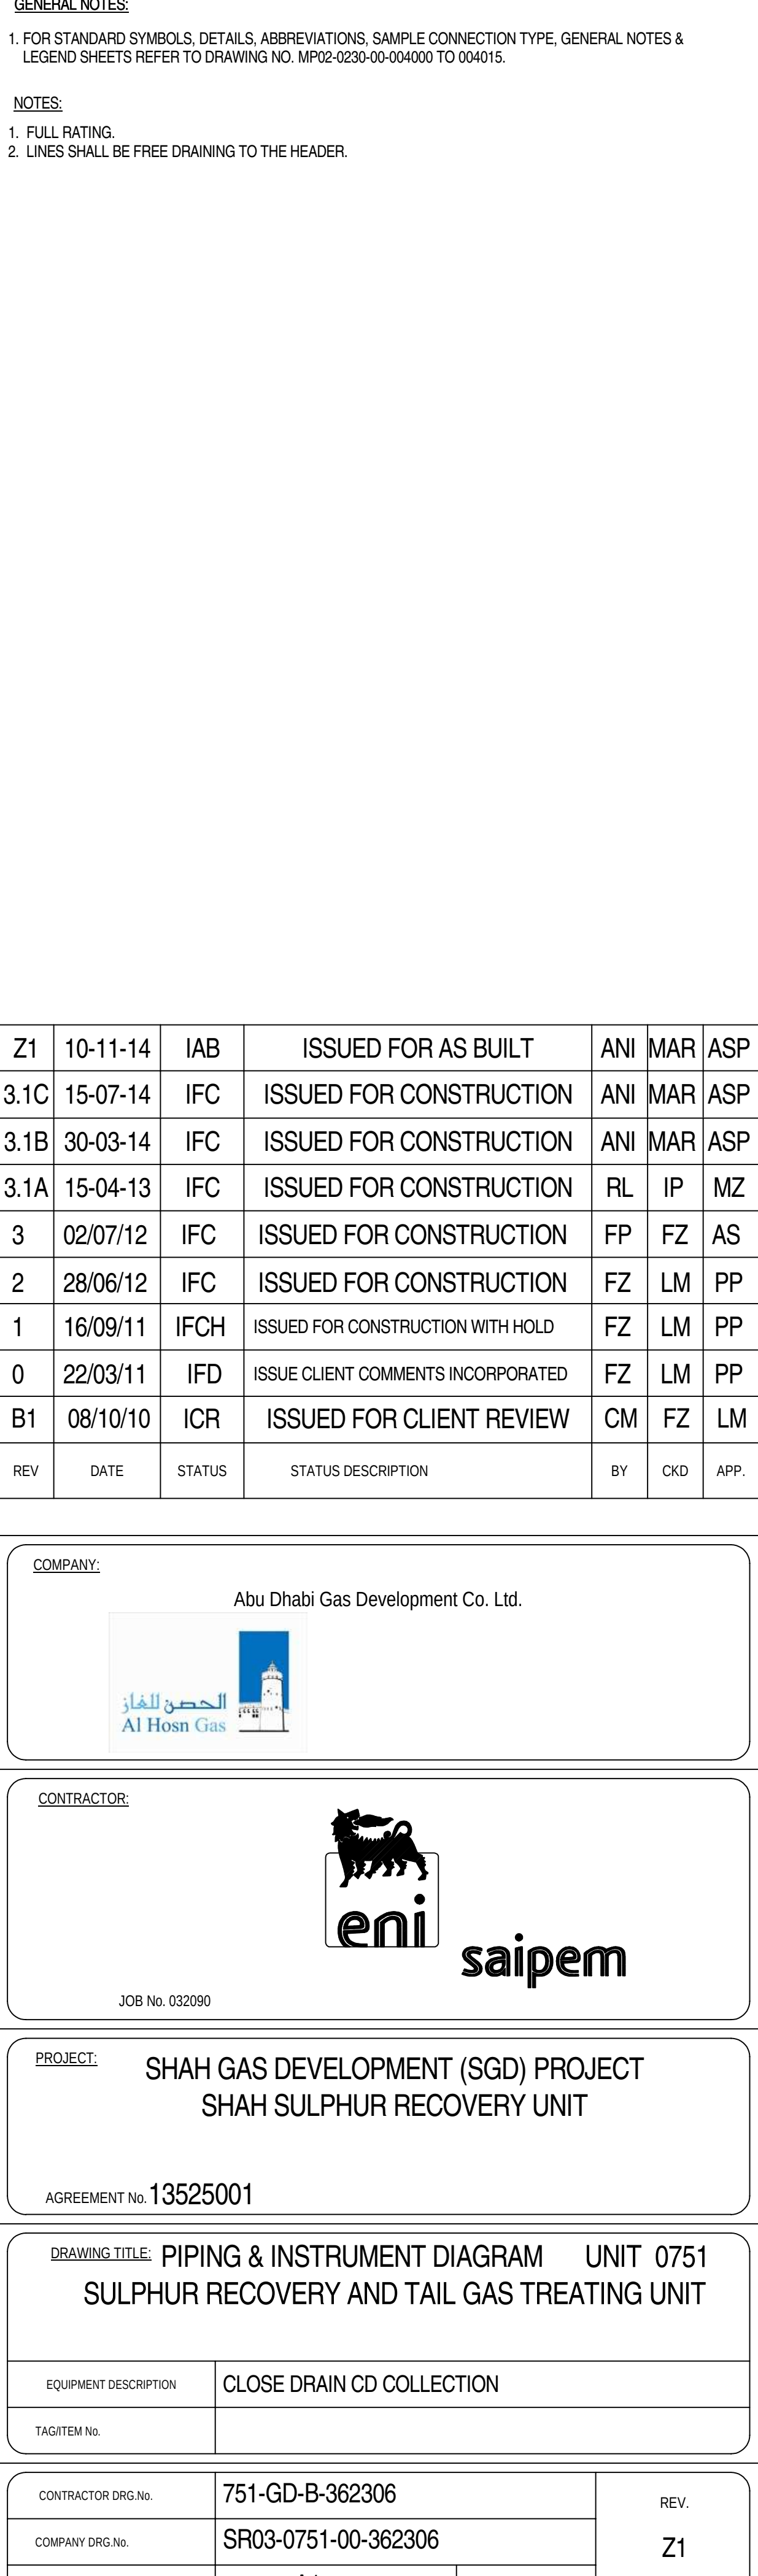

THIS DOCUMENT IS THE PROPERTY OF ABU DHABI GAS DEVELOPMENT COMPANY LIMITED AND CONTAINS INFORMATION WHICH IS PROPRIETARY. THIS INFORMATION IS TO BE HELD IN CONFIDENCE. NO DISCLOSURE OR OTHER USE OF THIS DOCUMENT IS TO BE MADE WITHOUT THE PRIOR WRITTEN CONSENT OF ABU DHABI GAS DEVELOPMENT COMPANY LIMITED.

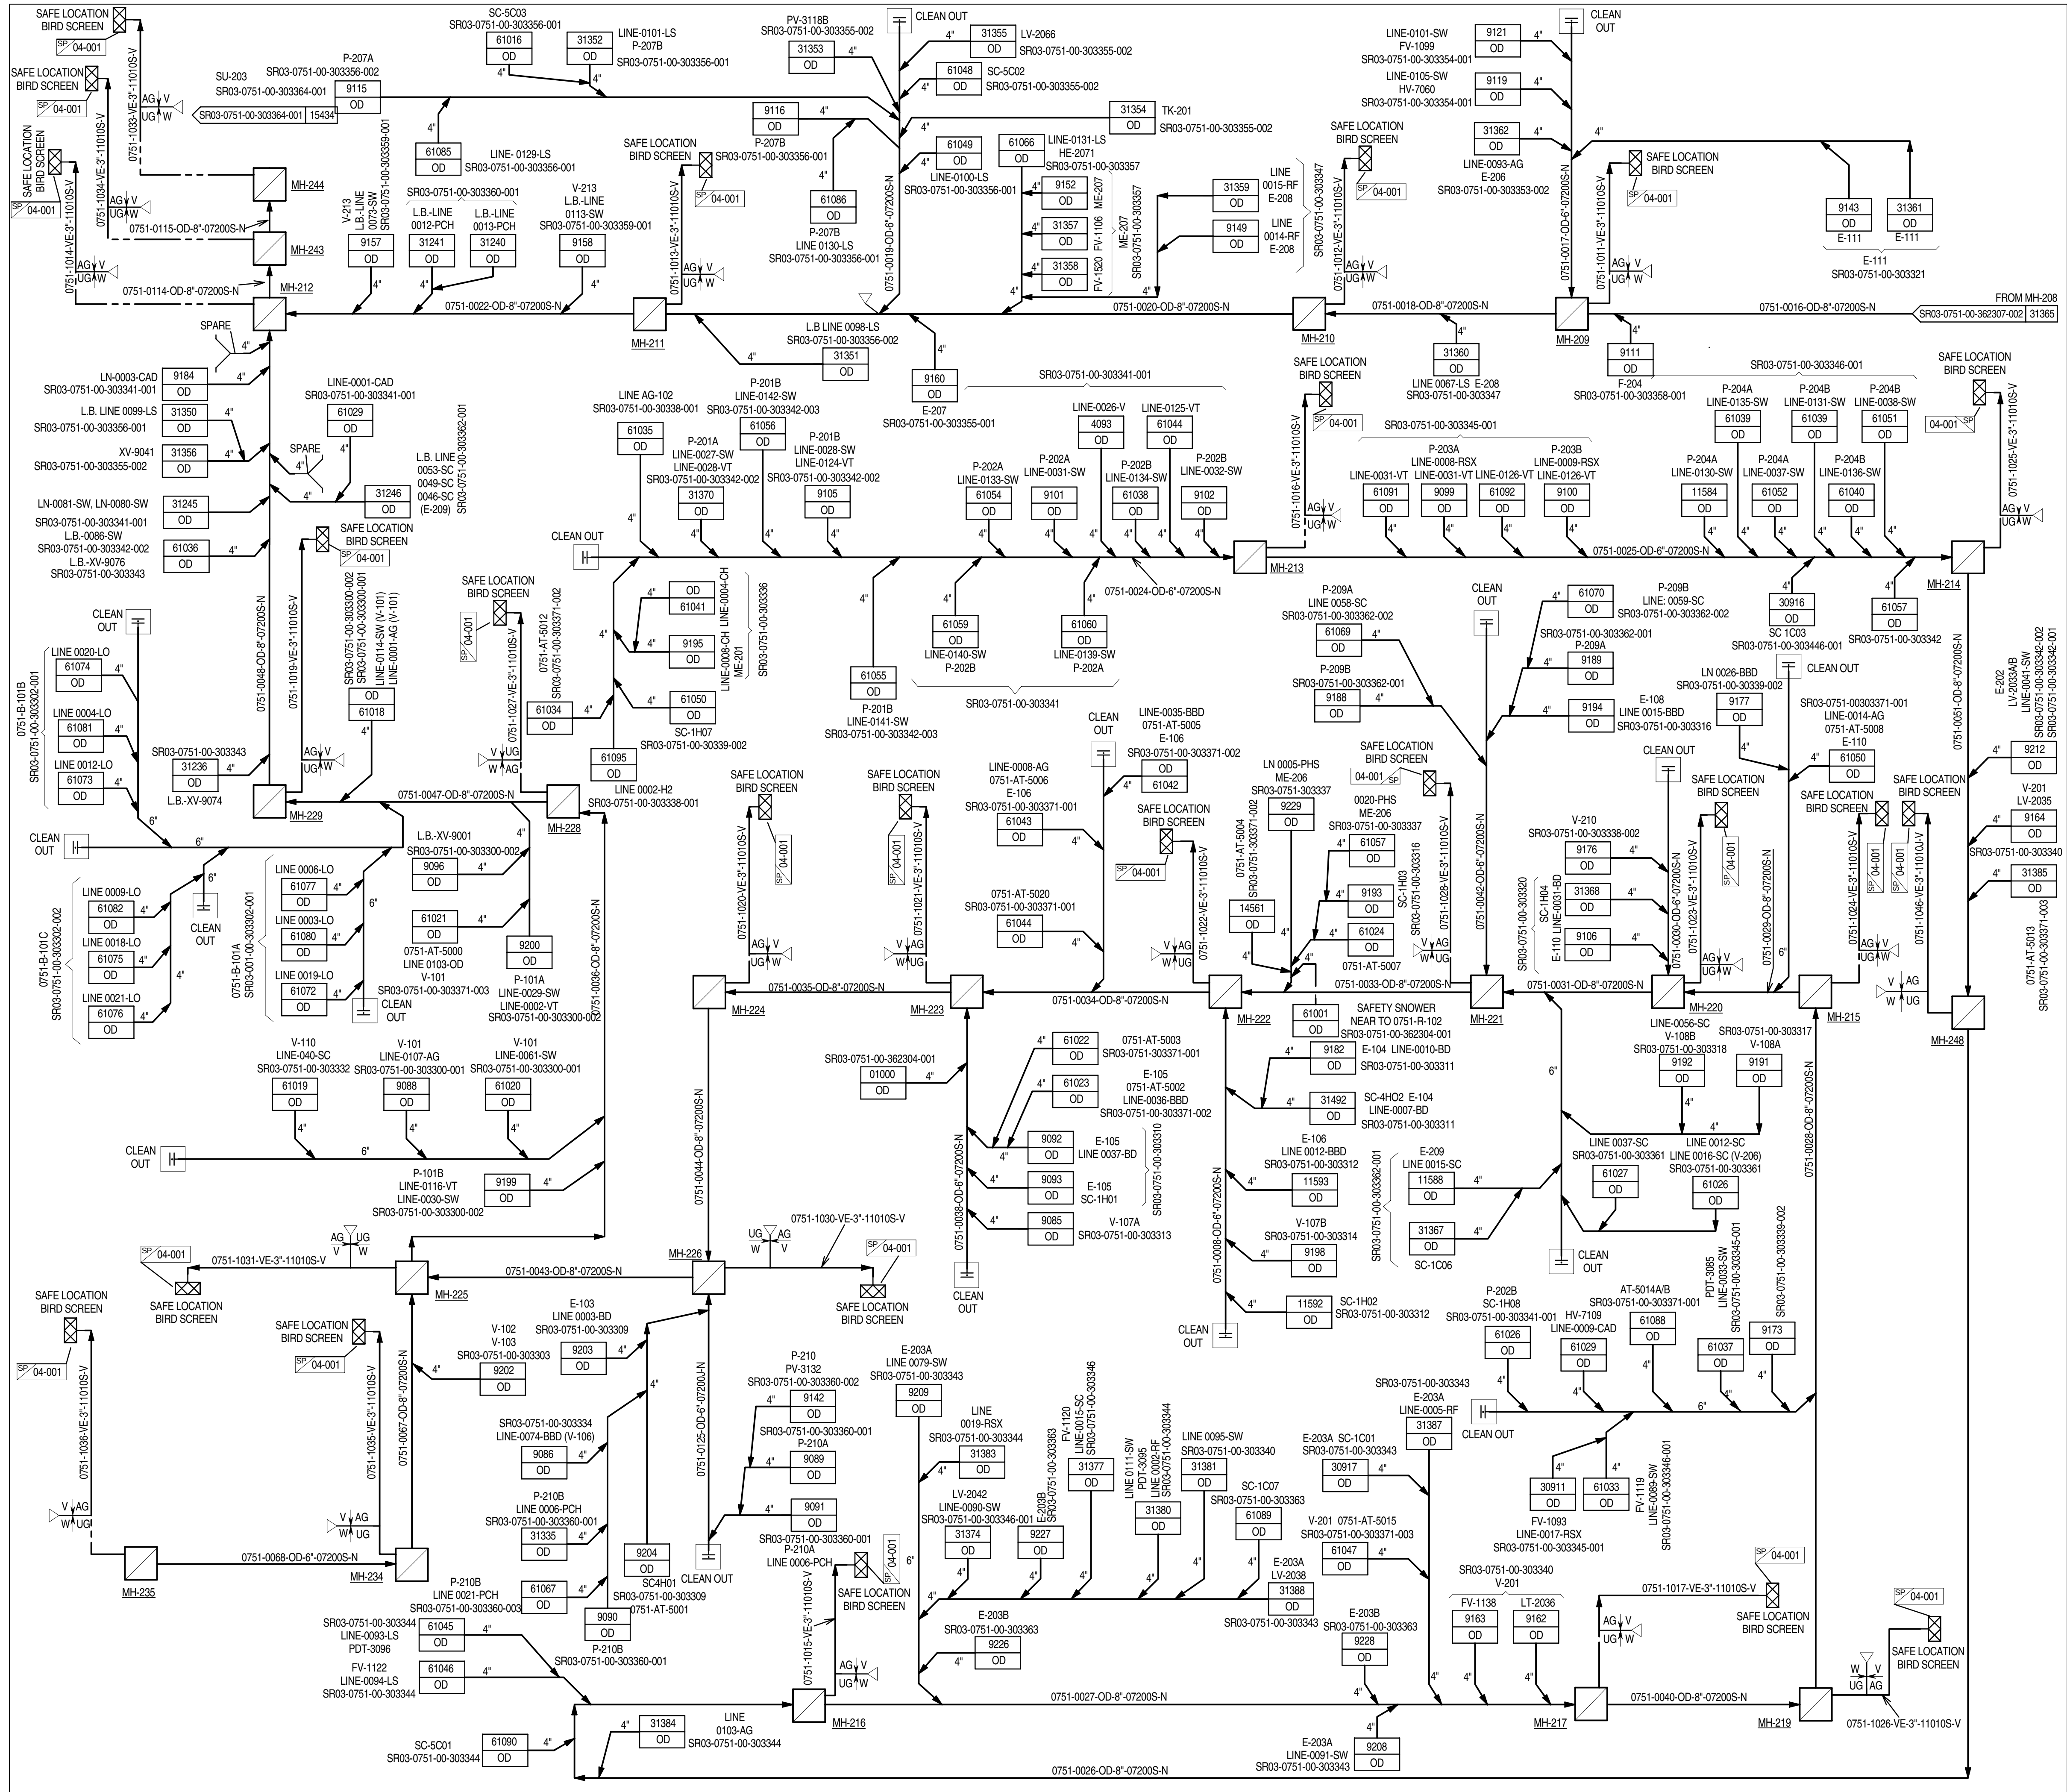

GENERAL NOTES:
1. FOR STANDARD SYMBOLS, DETAILS, ABBREVIATIONS, SAMPLE CONNECTION TYPE, GENERAL NOTES & LEGEND SHEETS REFER TO DRAWING NO. MP02-0230-00-004000 TO 004015.
2. VENTS FROM PIT TO SAFE LOCATION.

Z1	10-11-14	IAB	ISSUED FOR AS BUILT	ANI	MAR	ASP
3.1B	15-07-14	IFC	ISSUED FOR CONSTRUCTION	ANI	MAR	ASP
3.1A	15-04-13	IFC	ISSUED FOR CONSTRUCTION	VM	IP	MZ
3	19/06/12	IFC	ISSUED FOR CONSTRUCTION	FP	FZ	AS
2	17/01/11	IFC	ISSUED FOR CONSTRUCTION	FP	LM	PP
1	16/09/11	IFCH	ISSUED FOR CONSTRUCTION WITH HOLDS	FP	LM	PP
0	22/03/11	IFD	ISSUED CLIENT COMMENTS INCORPORATED	FZ	LM	PP
B1	27/10/10	ICR	ISSUED FOR CLIENT REVIEW	CM	FZ	LM
REV	DATE	STATUS	STATUS DESCRIPTION	BY	CKD	APP.

COMPANY:

Abu Dhabi Gas Development Co. Ltd.

CONTRACTOR:

PROJECT:

SHAH GAS DEVELOPMENT (SGD) PROJECT
SHAH SULPHUR RECOVERY UNIT


AGREEMENT NO. 13525001

DRAWING TITLE: PIPING & INSTRUMENT DIAGRAM UNIT 0751
SULPHUR RECOVERY AND TAIL GAS TREATING UNIT



EQUIPMENT DESCRIPTION: OPEN DRAIN OD COLLECTION

TAGITEM No.

CONTRACTOR DRG. No.	0751-GD-B-362307	REV.	Z1
COMPANY DRG. No.	SR03-0751-00-362307-001		
SCALE:	SIZE: A1	DOC. CLASS: 1	

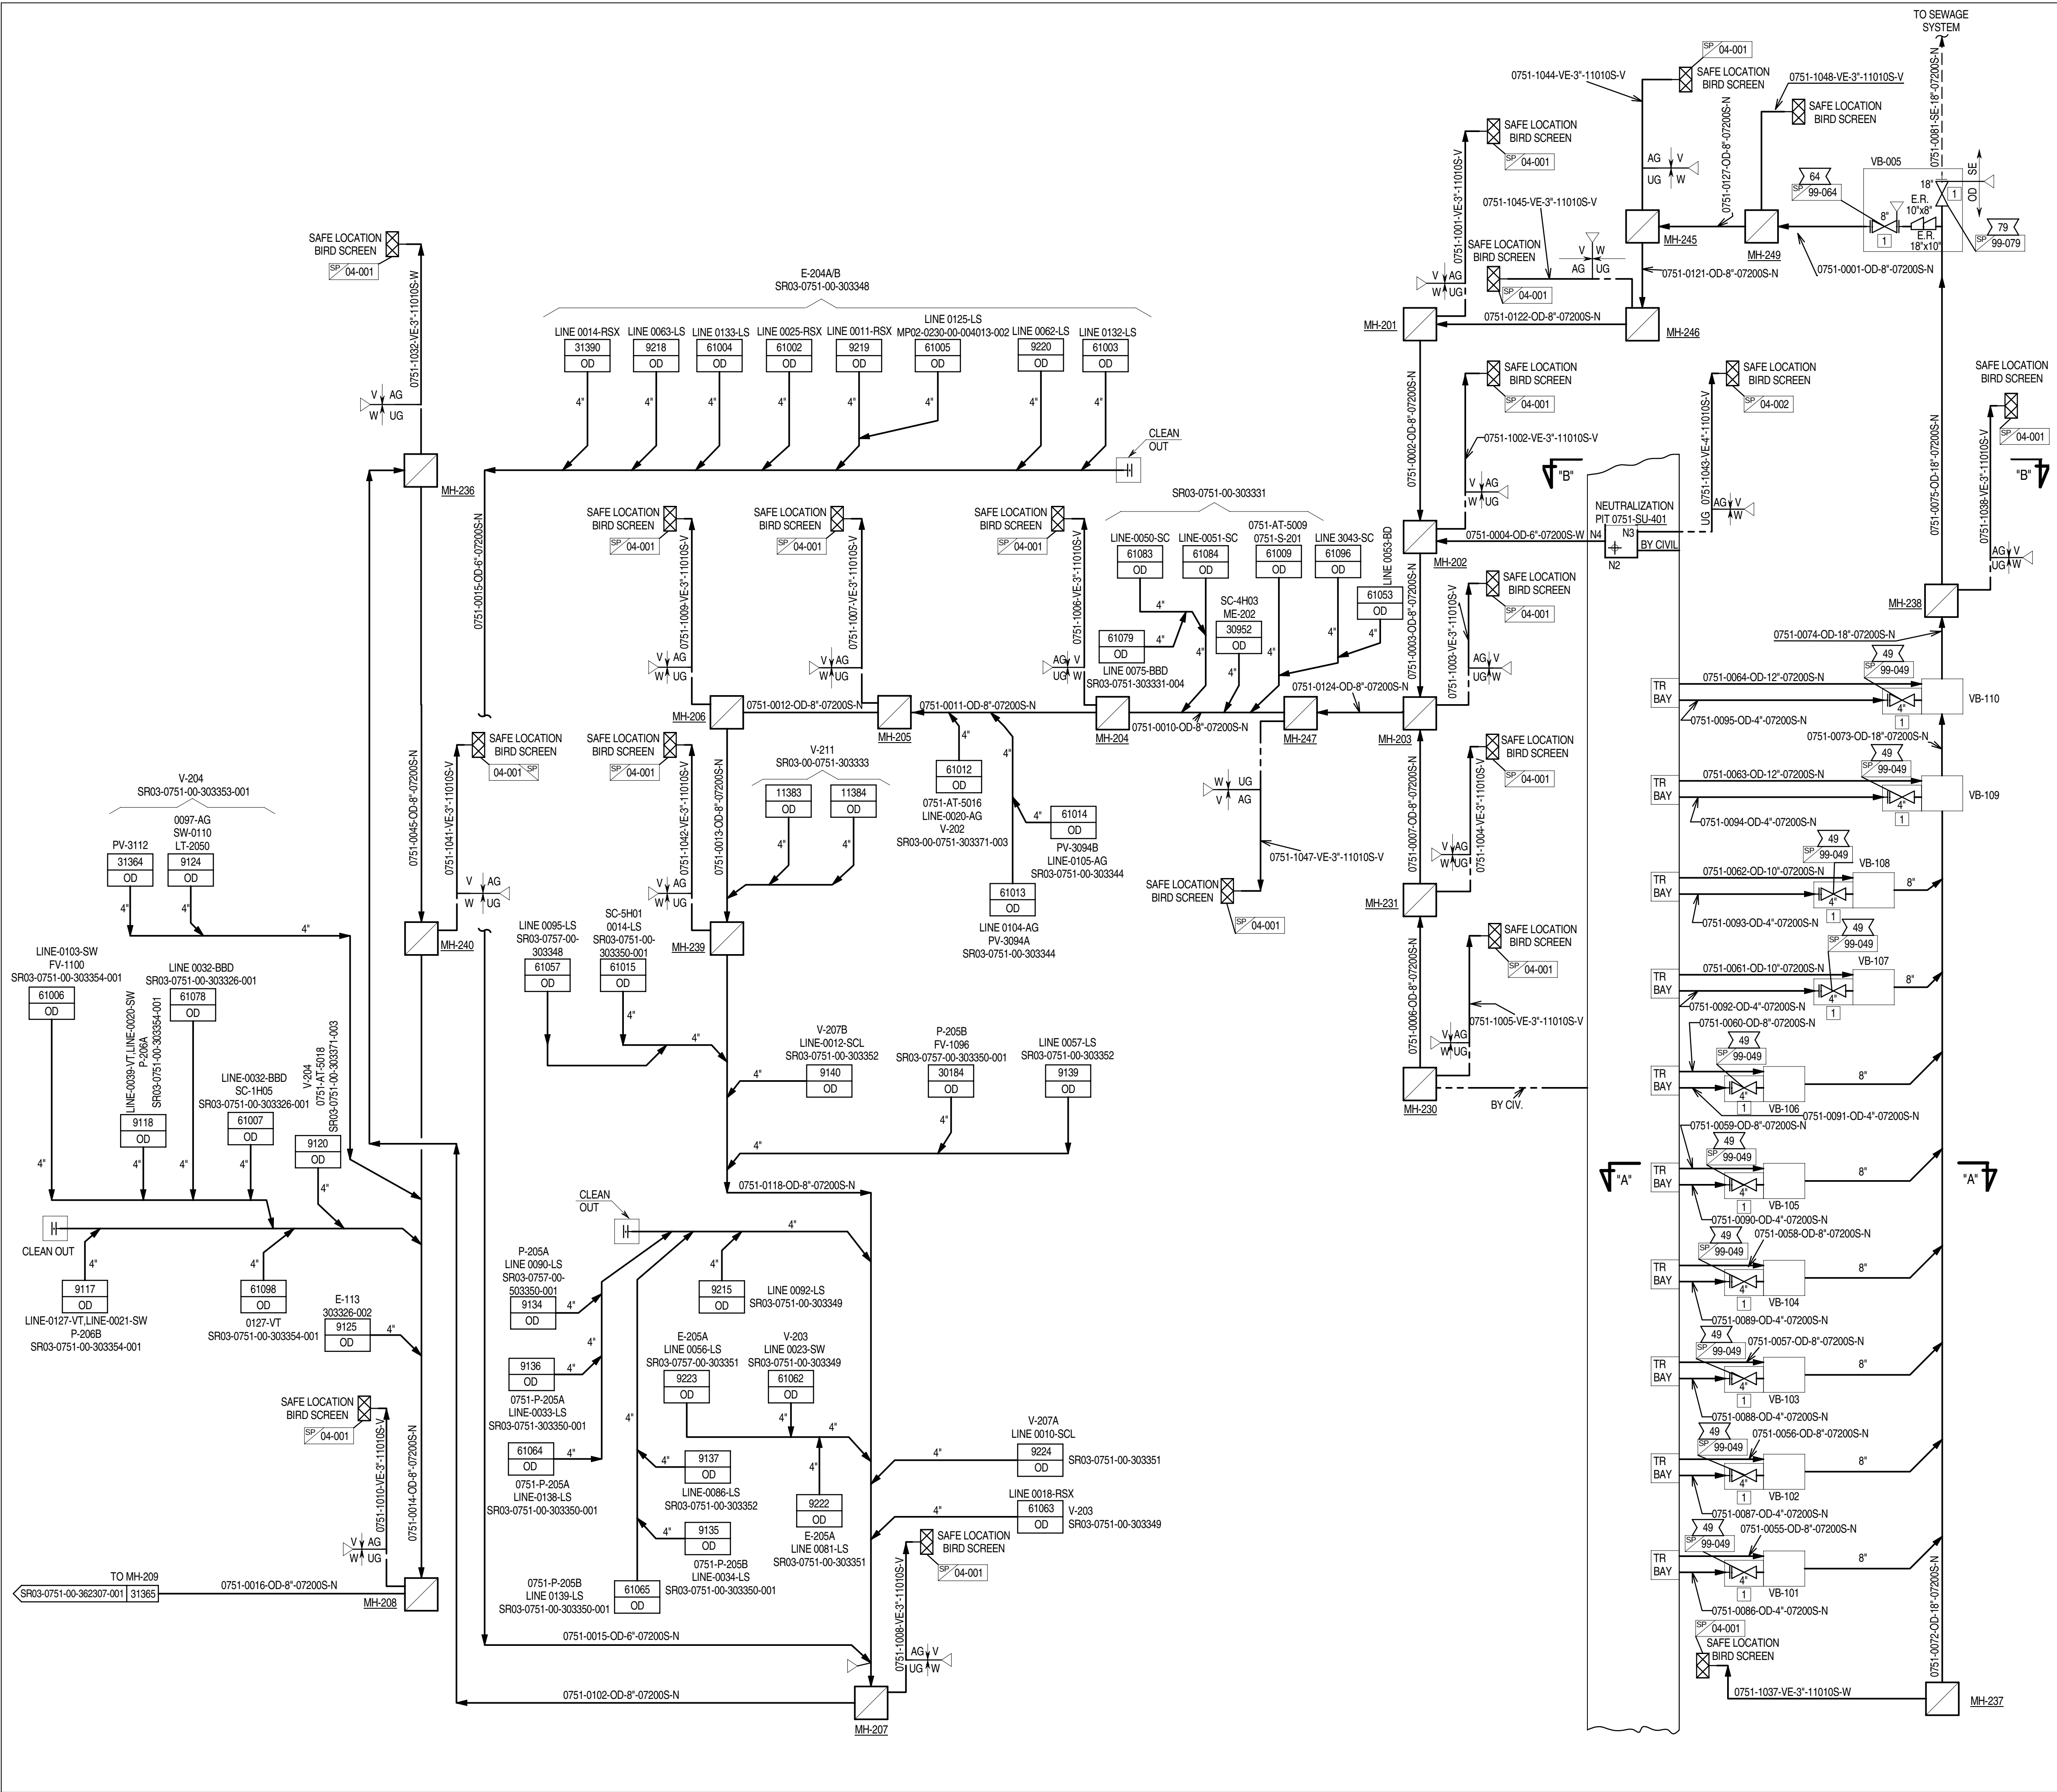

GENERAL NOTES:
1. FOR STANDARD SYMBOLS, DETAILS, ABBREVIATIONS, SAMPLE CONNECTION TYPE, GENERAL NOTES & LEGEND SHEETS REFER TO DRAWING NO. MP02-0230-00-004000 TO 004015.
2. VENTS FROM PIT TO SAFE LOCATION.

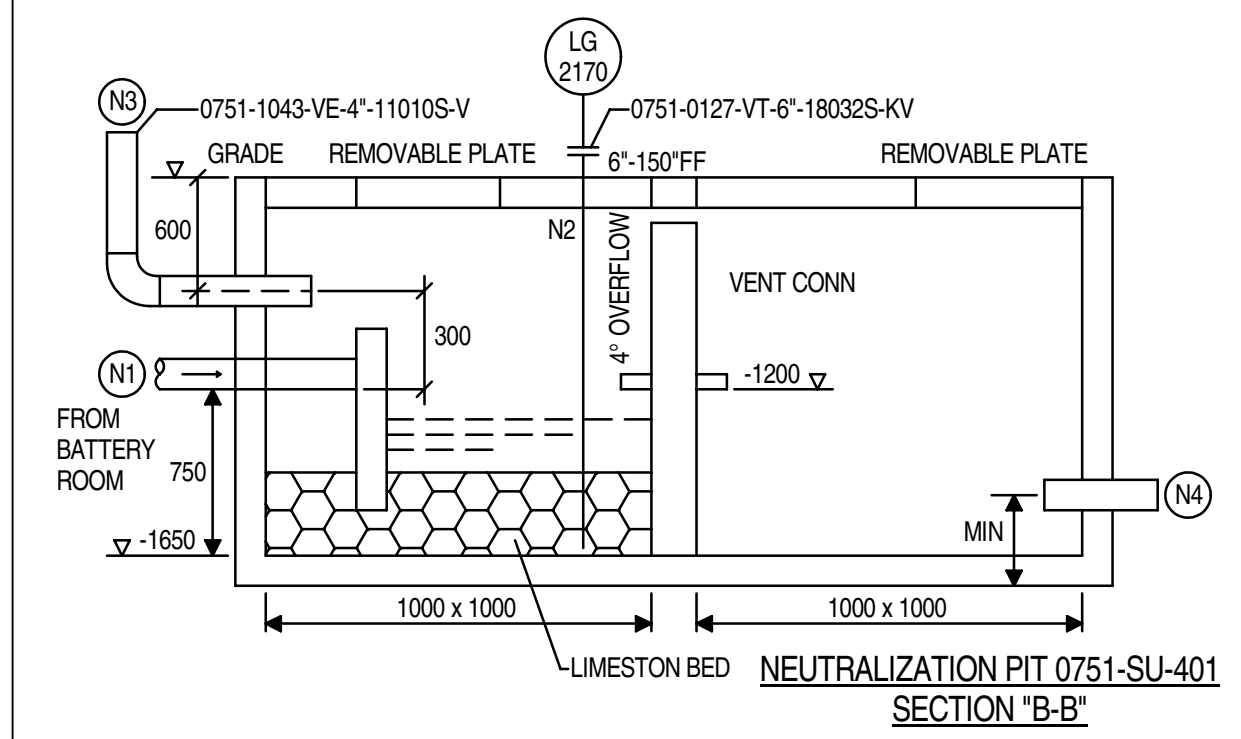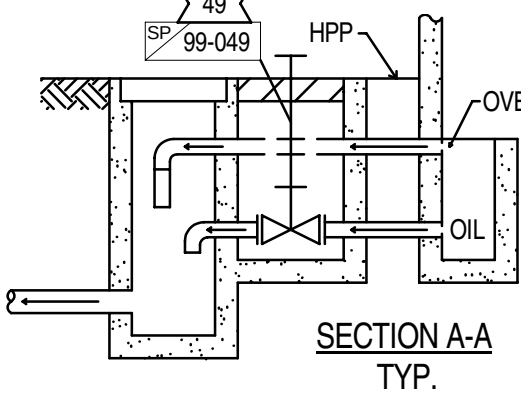

Z1	10-11-14	IAB	ISSUED FOR AS BUILT	ANI	MAR	ASP
3.1B	15-07-14	IFC	ISSUED FOR CONSTRUCTION	ANI	MAR	ASP
3.1A	15-04-13	IFC	ISSUED FOR CONSTRUCTION	VM	IP	MZ
3	19/06/12	IFC	ISSUED FOR CONSTRUCTION	FP	FZ	AS
2	17/01/12	IFC	ISSUED FOR CONSTRUCTION	FP	LM	PP
1	16/09/11	IFCH	ISSUED FOR CONSTRUCTION WITH HOLDS	FP	LM	PP
0	22/03/11	IFD	ISSUED CLIENT COMMENTS INCORPORATED	FZ	LM	PP
B1	27/10/10	ICR	ISSUED FOR CLIENT REVIEW	CM	FZ	LM
REV	DATE	STATUS	STATUS DESCRIPTION	BY	CKD	APP.

COMPANY:

Abu Dhabi Gas Development Co. Ltd.

CONTRACTOR:

PROJECT:

SHAH GAS DEVELOPMENT (SGD) PROJECT
SHAH SULPHUR RECOVERY UNIT


AGREEMENT NO. 13525001

DRAWING TITLE: PIPING & INSTRUMENT DIAGRAM UNIT 0751
SULPHUR RECOVERY AND TAIL GAS TREATING UNIT

EQUIPMENT DESCRIPTION	OPEN DRAIN OD COLLECTION
TAGITEM No.	

CONTRACTOR DRG. No.	751-GD-B-362307	REV.	
COMPANY DRG. No.	SR03-0751-00-362307-002		Z1
SCALE:	SIZE: A1	DOC. CLASS: 1	

THIS DOCUMENT IS THE PROPERTY OF ABU DHABI GAS DEVELOPMENT COMPANY LIMITED AND CONTAINS INFORMATION WHICH IS PROPRIETARY. THIS INFORMATION IS TO BE HELD IN CONFIDENCE. NO DISCLOSURE OR OTHER USE OF THIS DOCUMENT IS TO BE MADE WITHOUT THE PRIOR WRITTEN CONSENT OF ABU DHABI GAS DEVELOPMENT COMPANY LIMITED.

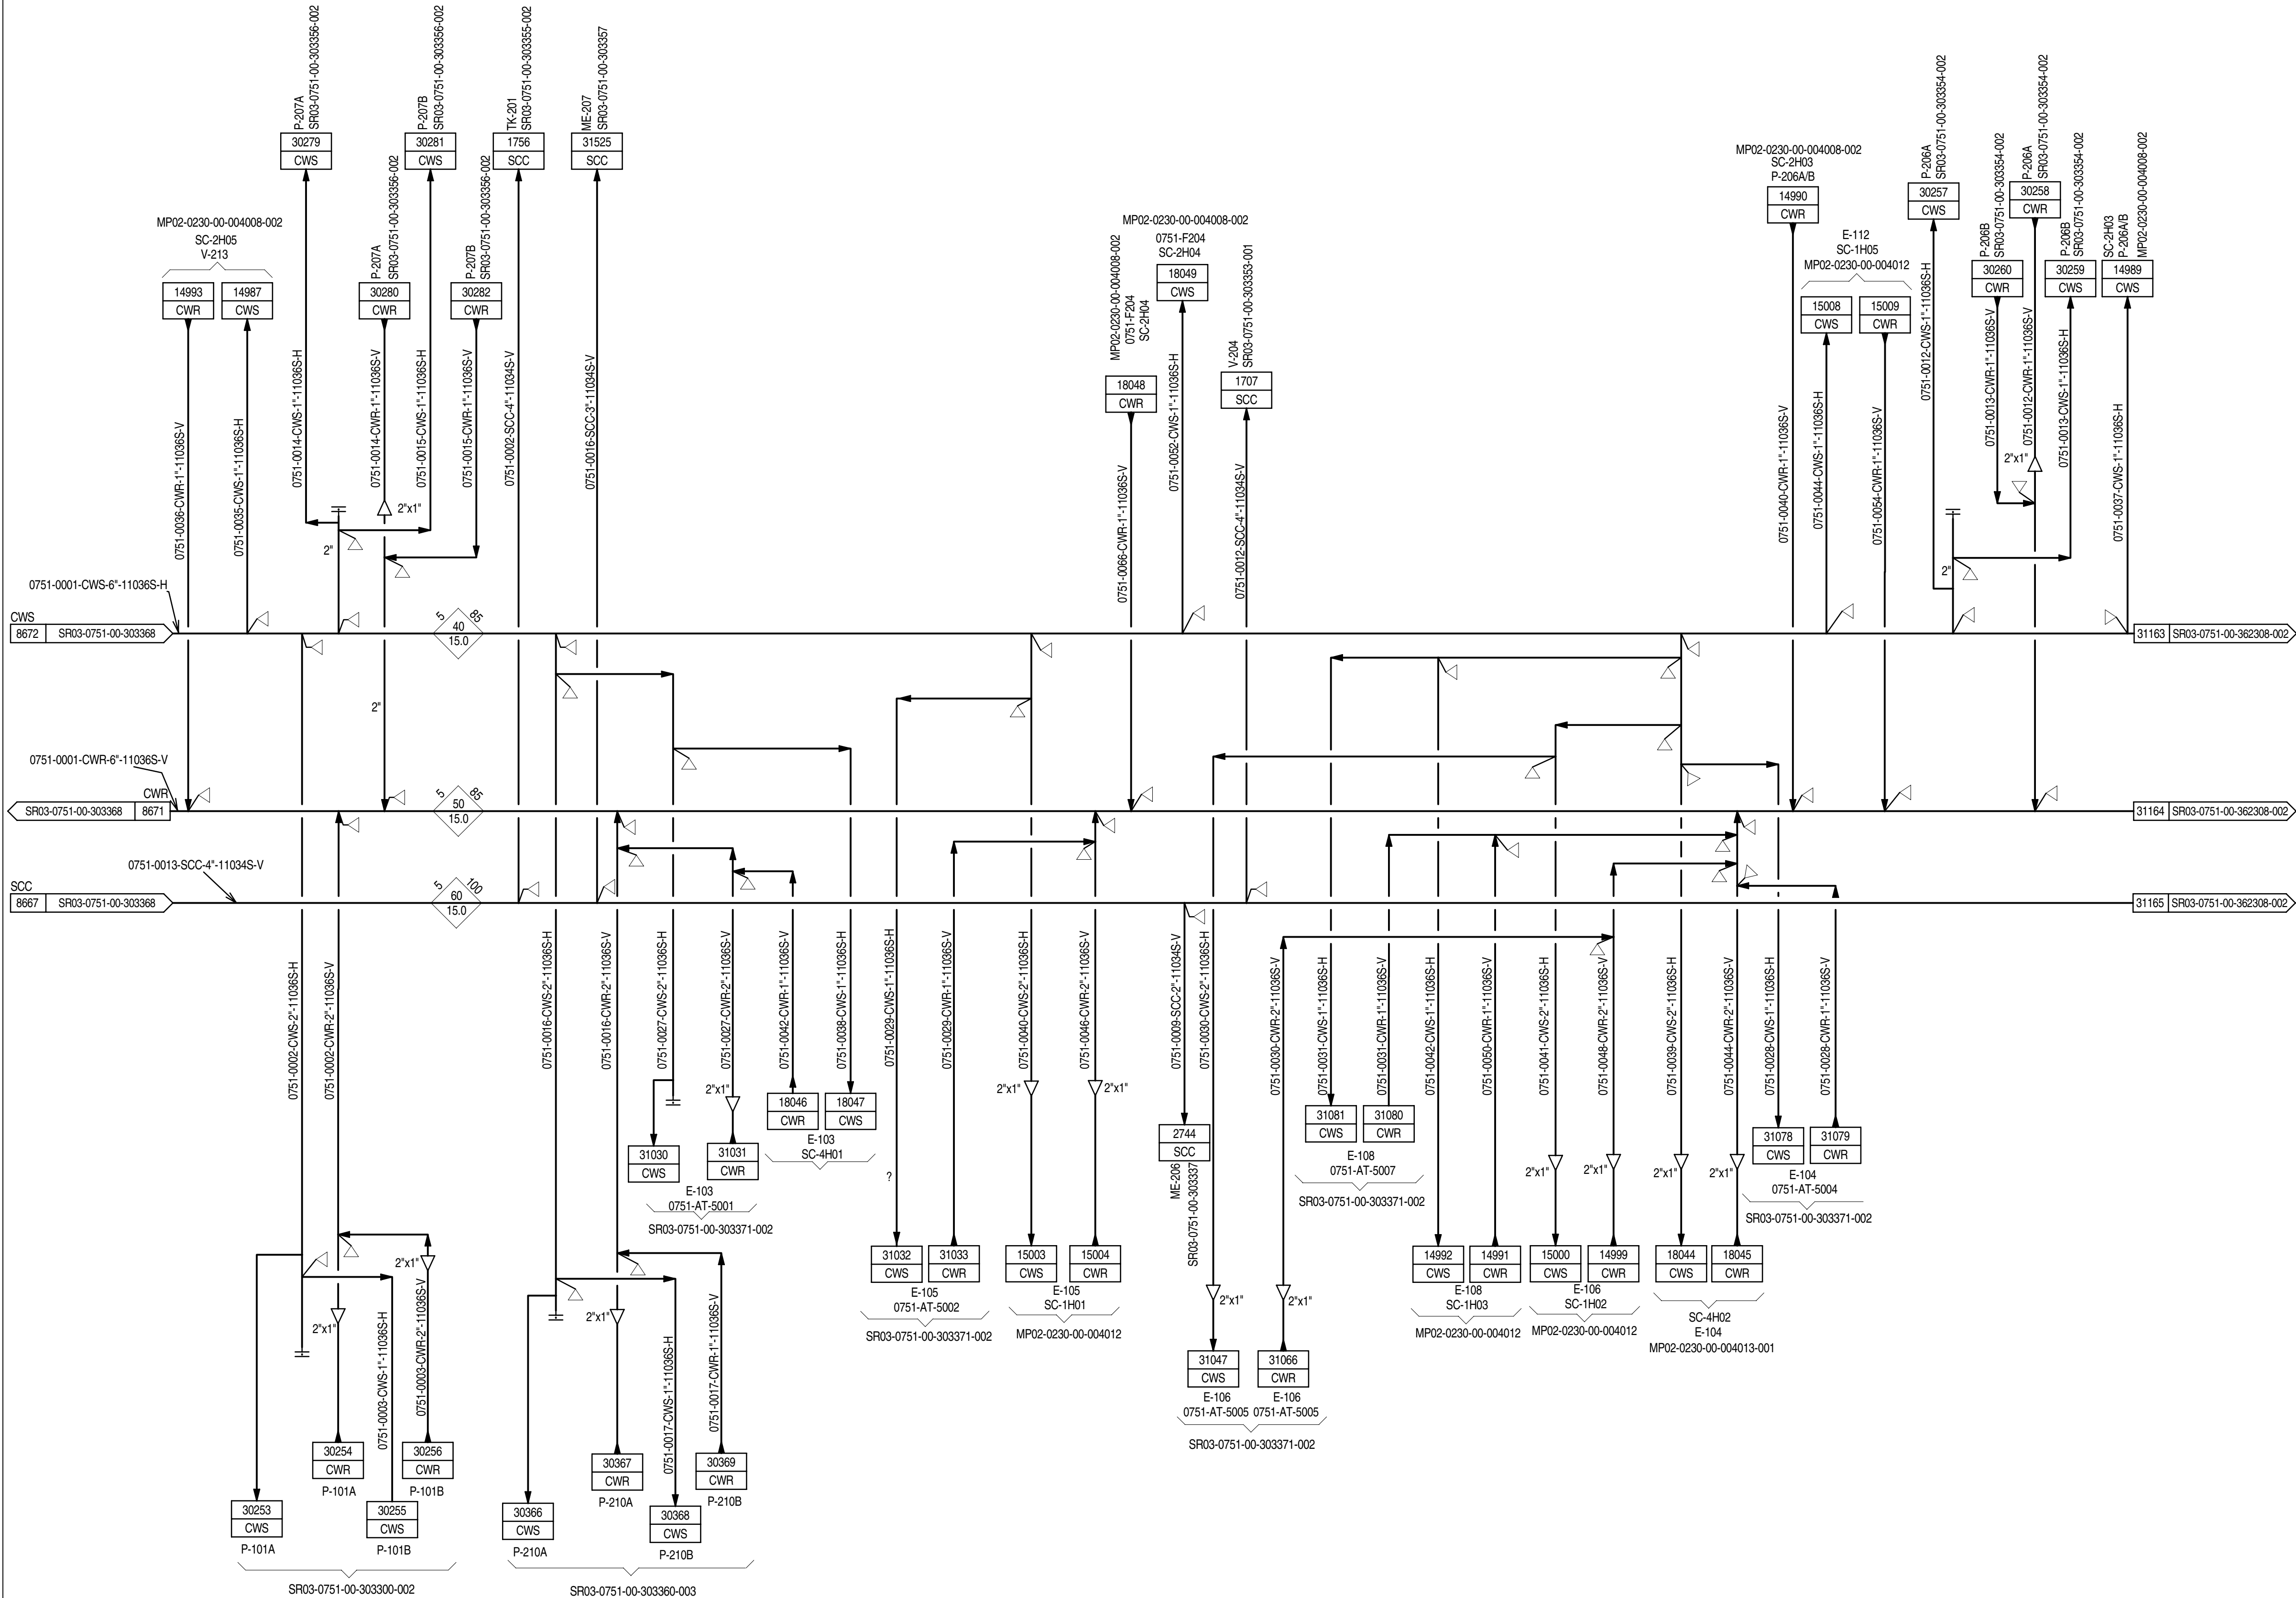

GENERAL NOTES:
1. FOR STANDARD SYMBOLS, DETAILS, ABBREVIATIONS, SAMPLE CONNECTION TYPE, GENERAL NOTES & LEGEND SHEETS REFER TO DRAWING NO. MP02-0230-00-004000 TO 004015.
NOTES:
1. COOLING WATER LINES TO PUMPS AND COMPRESSOR SHALL HAVE THE TAKE-OFF CONNECTIONS FROM THE TOP OF WATER MAIN HEADER.

Z1	10-11-14	IAB	ISSUED FOR AS BUILT	ANI	MAR	ASP
3.1D	15-07-14	IFC	ISSUED FOR CONSTRUCTION	ANI	MAR	ASP
3.1C	30-03-14	IFC	ISSUED FOR CONSTRUCTION	ANI	MAR	ASP
3.1B	15-04-13	IFC	ISSUED FOR CONSTRUCTION	VM	IP	MZ
3.1A	31-10-12	IFC	ISSUED FOR CONSTRUCTION	RL	LM	MZ
3	04/07/12	IFC	ISSUED FOR CONSTRUCTION	FP	FZ	AS
2	17/01/12	IFC	ISSUED FOR CONSTRUCTION	FZ	LM	PP
1	16/09/11	IFCH	ISSUED FOR CONSTRUCTION WITH HOLDS	FZ	LM	PP
0	22/03/11	IFD	ISSUED CLIENT COMMENTS INCORPORATED	FZ	LM	PP
B1	11/10/10	ICR	ISSUED FOR CLIENT	CM	FZ	LM
REV	DATE	STATUS	STATUS DESCRIPTION	BY	CKD	APP.

COMPANY:

Abu Dhabi Gas Development Co. Ltd.

CONTRACTOR:

JOB No. 032090

PROJECT:

SHAH GAS DEVELOPMENT (SGD) PROJECT
SHAH SULPHUR RECOVERY UNIT


AGREEMENT No. 13525001

DRAWING TITLE:

PIPING & INSTRUMENT DIAGRAM UNIT 0751
SULPHUR RECOVERY AND TAIL GAS TREATING UNIT

EQUIPMENT DESCRIPTION	CHILLED WATER AND COOLED COND. PHOSPATE DISTRIB.
TAGITEM No.	

CONTRACTOR DRG. No.	751-GD-B-362308	REV. Z1
COMPANY DRG. No.	SR03-0751-00-362308-001	
SCALE:	SIZE: A1	DOC. CLASS: 1

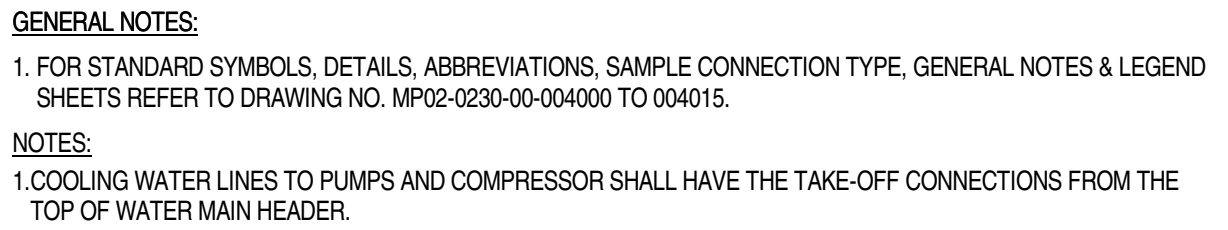

COMPANY:

Abu Dhabi Gas Development Co. Ltd.



PROJECT: SHAH GAS DEVELOPMENT (SGD) PROJECT
SHAH SULPHUR RECOVERY UNIT

AGREEMENT No. 13525001

CONTRACTOR DRG. No.		751-GD-B-362308		REV. Z1
COMPANY DRG. No.		SR03-0751-00-362308-002		
SCALE:	SIZE: A1	DOC. CLASS: 1		

THIS DOCUMENT IS THE PROPERTY OF ABU DHABI GAS DEVELOPMENT COMPANY LIMITED AND CONTAINS INFORMATION WHICH IS PROPRIETARY. THIS INFORMATION IS TO BE HELD IN CONFIDENCE. NO DISCLOSURE OR OTHER USE OF THIS DOCUMENT IS TO BE MADE WITHOUT THE PRIOR WRITTEN CONSENT OF ABU DHABI GAS DEVELOPMENT COMPANY LIMITED.


U.S.NO	TO	ELEVATION
US-01	BATTERY LIMIT	▽ 12100
US-03	P-207B, V-213	GRADE 501, 620
US-05	E-208	GRADE 501, 620
US-07	P-208, V-205	GRADE 501, 620
US-08	V-111	1" MAN HOLE ▽11550
US-11	E-204A/B	GRADE 501, 620
US-12	P-205A/B, V-212	GRADE 501, 620
US-13	V-205A, V-203	M1 MAN HOLE ▽10000
US-21	V-202	M1 MAN HOLE ▽10000
US-25	E-203A/B, P-202A/B	GRADE 501, 620
US-27	E-205B, V-203	M1 MAN HOLE ▽9300

U.S.NO	TO	ELEVATION
US-34	E-110	▽ 10600
US-36	E-108	▽10600
US-37	R-102	▽28500
US-40	E-106	▽10600
US-42	V-107B	▽22000
US-43	P-102A/B	GRADE 501, 620
US-44	V-109	GRADE 501, 620
US-47	E-105	▽ 10600
US-49	V-107A	▽22000

U.S.NO	TO	ELEVATION
US-50	P-210A/B, V-106	GRADE 501, 620
US-51	P-214A/B, P-101A/B	GRADE 501, 620
US-52	V-101	2" MAN HOLE ▽ 8700
US-53	B-101A	GRADE 501, 620
US-55	E-101	▽ 28500
US-56	E-112, V-204	▽ 10000
US-57	E-113	▽18000
US-58	E-207	AIR COOLER MOTOR PLATFORM ▽23200
US-59	E-207	AIR COOLER MOTOR PLATFORM ▽23200
US-60	E-111	AIR COOLER MOTOR PLATFORM ▽23200
US-61	E-206	AIR COOLER MOTOR PLATFORM ▽23200
US-62	E-202	AIR COOLER MOTOR PLATFORM ▽23200
US-63	E-202	AIR COOLER MOTOR PLATFORM ▽23200
US-65	E-202	AIR COOLER MOTOR PLATFORM ▽23200
US-66	E-202	AIR COOLER MOTOR PLATFORM ▽23200
US-67	E-202	AIR COOLER MOTOR PLATFORM ▽23200

U.S.NO	TO	ELEVATION
US 068	V-207B	GRADE 501, 620
US 069	E-107B	▽ 28500
US 070	E-109B	▽ 28500
US 071	E-211B, E-212 B	▽ 28500
US 072	V-108A/B, V-210	▽ 22000
US 073	X-205A/B, X-206	▽ 23200
US 074	V-101, V-110	▽ 10600
US 077	PIPE RACK	GRADE 501, 620
US 081	PIPE RACK	GRADE 501, 620
US 084	INCINERATOR	GRADE 501, 620
US 085	INCINERATOR	GRADE 501, 620
US 088	R-201	▽ 39150
US 089	BATTERY LIMIT	▽ 7900
US 090	BATTERY LIMIT	▽ 19000
US 091	E-201	▽ 10600
US 092	R-101, E-107A	▽ 28500
US 093	R-101, J-101A/B	▽ 28500
US 094	R-102, E-109A	▽ 28500
US 095	E-211A, E-212A	▽ 28500
US 096	E-110	▽ 10600

U.S.NO	TO	ELEVATION
US 097	E-110	▽ 18000
US 098	E-108	▽ 10600
US 099	E-108	▽ 18300
US 100	E-106, H-102	▽ 10600
US 101	E-106, V-105	▽ 18000
US 102	E-105, H101	▽ 10600
US 103	E-105, V-104	▽ 18000
US 104	INCINERATOR	GRADE 501, 620
US 106	ME-207	GRADE 501, 620
US 107	V-201	▽ 9970
US 108	V-102, V-103	▽ 22000

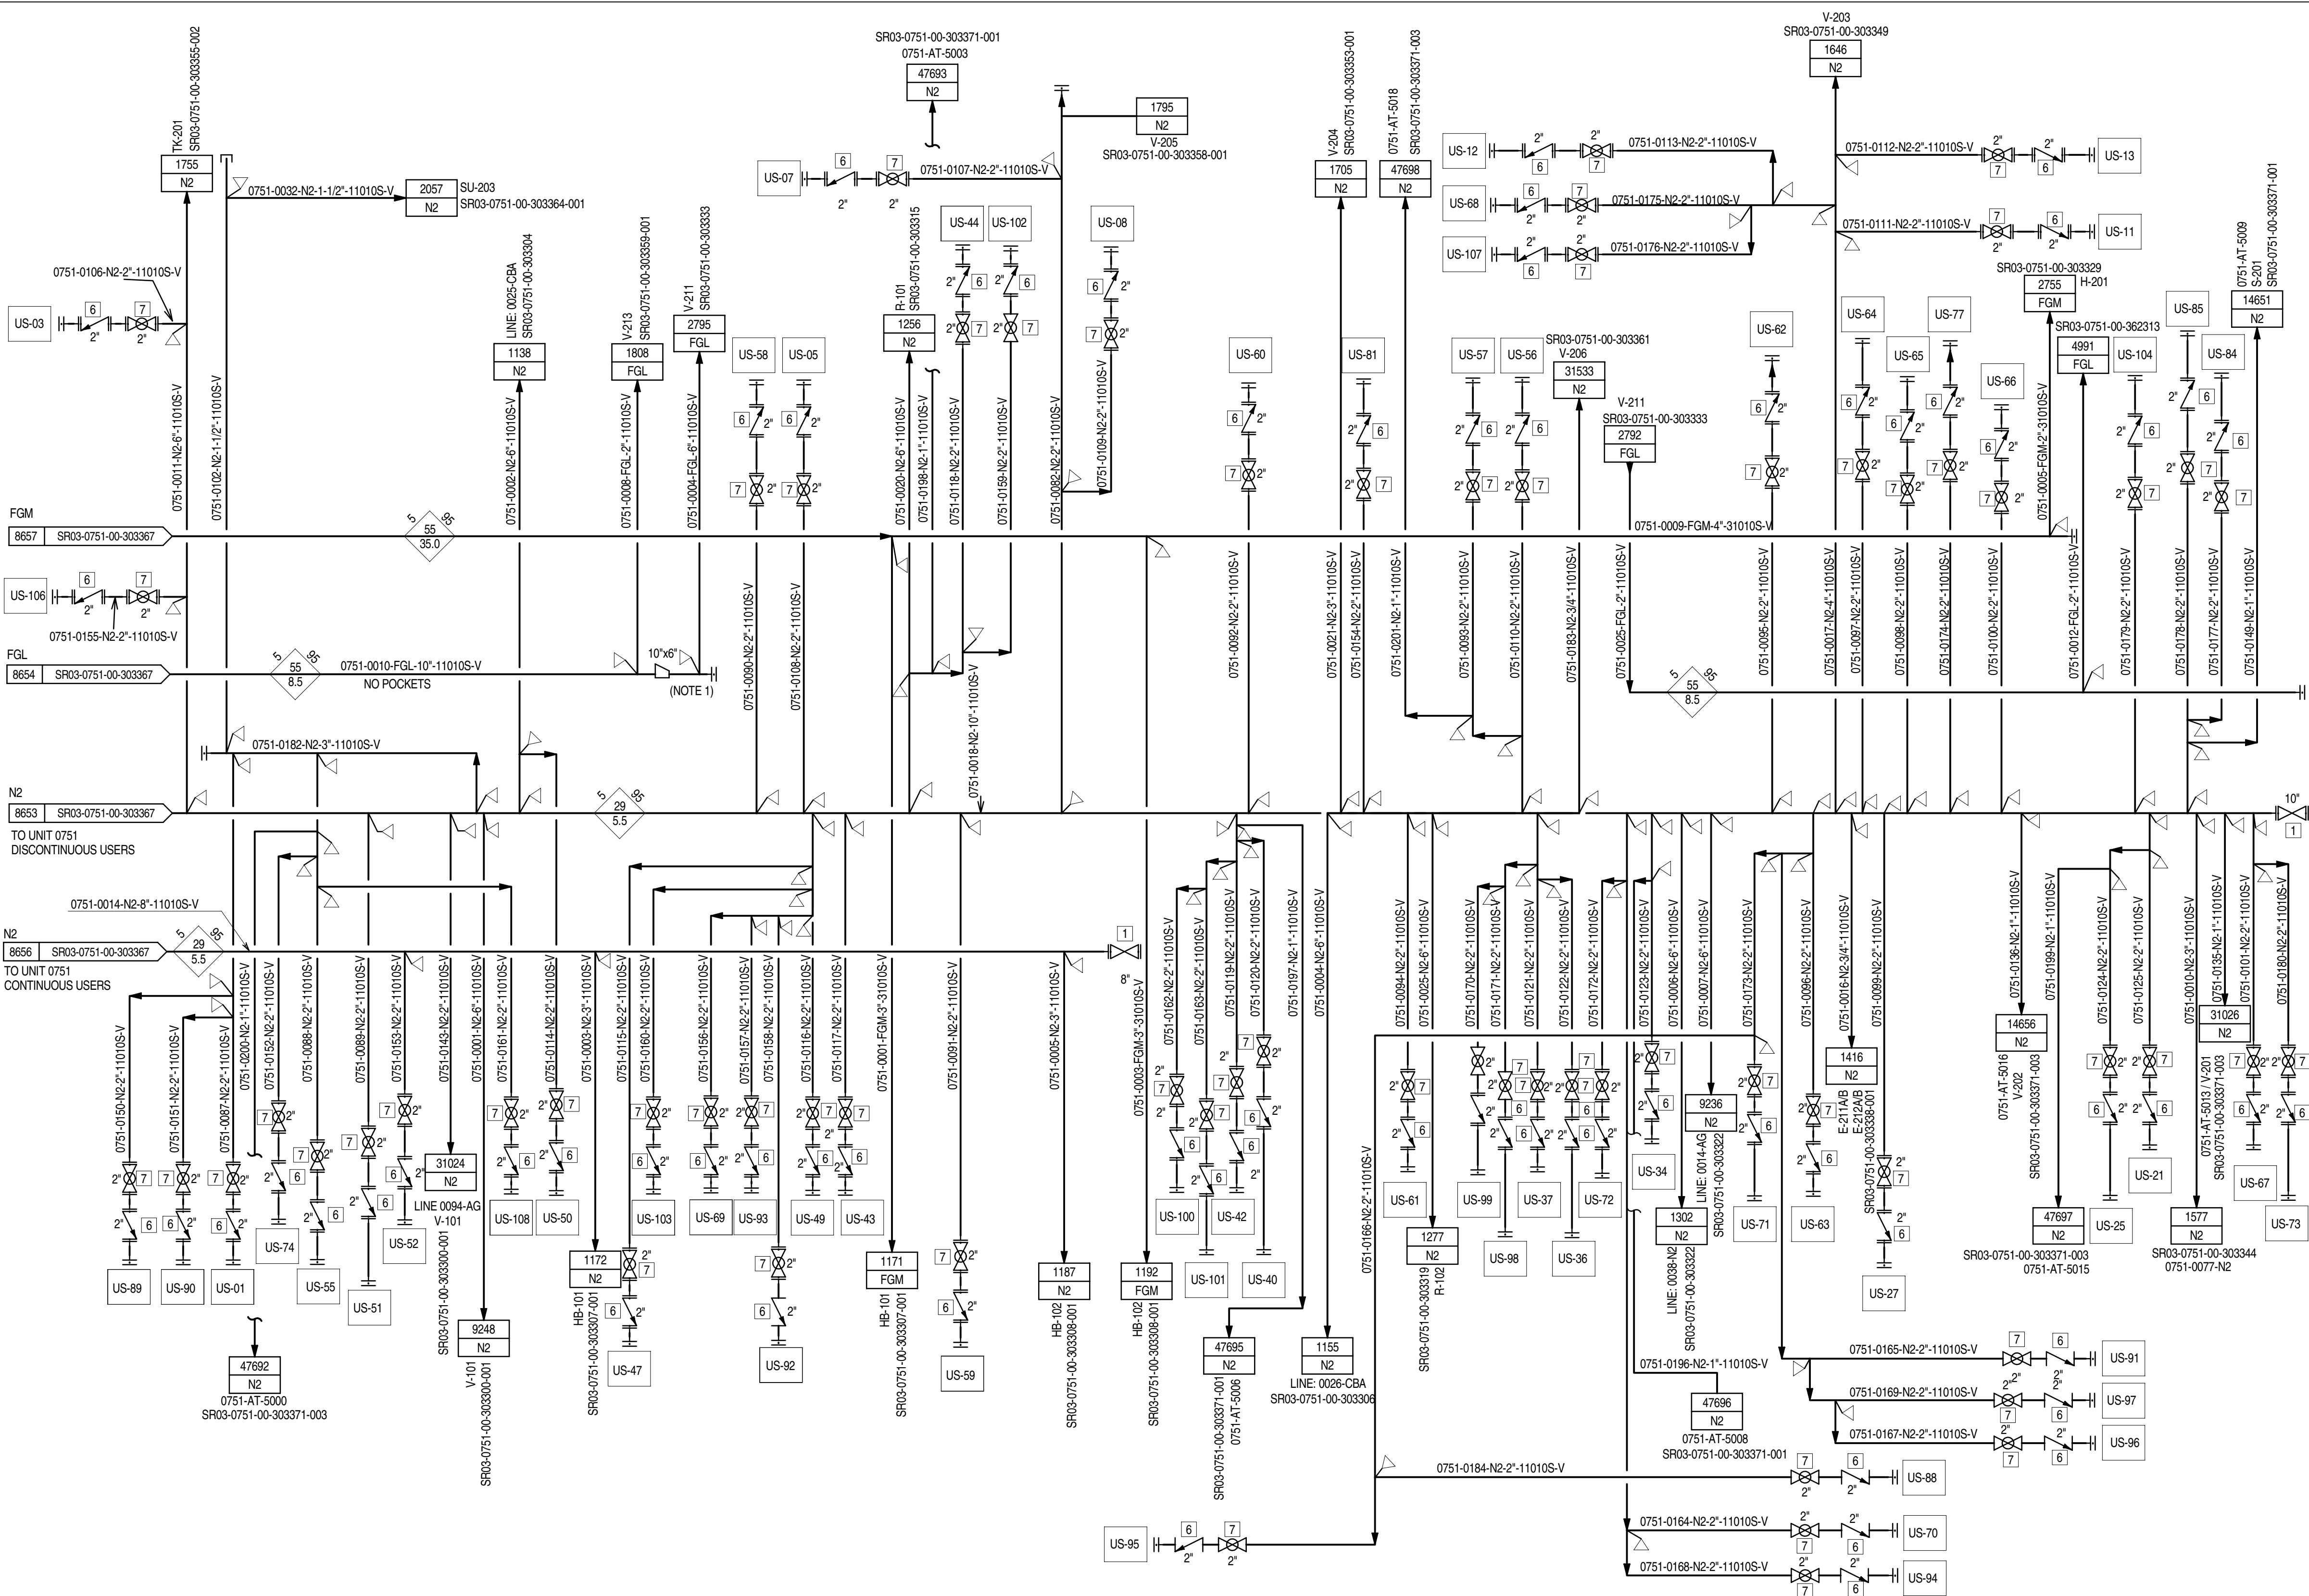

CONTRACTOR DRG. No.		751-GD-B-362311	REV. Z1
COMPANY DRG. No.		SR03-0751-00-362311	
SCALE:	SIZE: A1	DOC. CLASS: 1	


THIS DOCUMENT IS THE PROPERTY OF ABU DHABI GAS DEVELOPMENT COMPANY LIMITED AND CONTAINS INFORMATION WHICH IS PROPRIETARY. THIS INFORMATION IS TO BE HELD IN CONFIDENCE. NO DISCLOSURE OR OTHER USE OF THIS DOCUMENT IS TO BE MADE WITHOUT THE PRIOR WRITTEN CONSENT OF ABU DHABI GAS DEVELOPMENT COMPANY LIMITED.

U.S.NO	TO	ELEVATION
US-01	BATTERY LIMIT	▽ 12100
US-02	P-213A/B	GRADE 501, 620
US-03	P-207B, V-213	GRADE 501, 620
US-04	TK-201	GRADE 501, 620
US-05	E-208	GRADE 501, 620
US-06	F-204	GRADE 501, 620
US-07	P-208, V-205	GRADE 501, 620
US-08	V-111	1" MAN HOLE ▽ 11550
US-09	V-111	2" MAN HOLE ▽ 20260
US-10	P-206A/B	GRADE 501, 620
US-11	E-204A/B	GRADE 501, 620
US-12	P-205A/B, V-212	GRADE 501, 620
US-13	V-205A, V-203	M1 MAN HOLE ▽ 10000
US-14	V-203	M2 MAN HOLE ▽ 21150
US-15	V-203	M3 MAN HOLE ▽ 31560
US-16	V-203	M7 MAN HOLE ▽ 45100
US-17	H-201	GRADE 501, 620
US-18	B-201A/B/C	GRADE 501, 620
US-19	ME-202	▽ 10000
US-20	P-204A/B	GRADE 501, 620
US-21	V-202	M1 MAN HOLE ▽ 10000
US-22	V-202	M6 MAN HOLE ▽ 14800
US-23	V-202	M4 MAN HOLE ▽ 24800
US-24	V-202	M5 MAN HOLE ▽ 29800
US-25	E-203A/B, P-202A/B	GRADE 501, 620
US-26	P-201A/B	GRADE 501, 620
US-27	E-205B, V-203	M1 MAN HOLE ▽ 10000

U.S.NO	TO	ELEVATION
US-28	V-201	M2 MAN HOLE ▽ 19200
US-29	V-201	M6 MAN HOLE ▽ 29100
US-30	V-201	M4 MAN HOLE ▽ 32450
US-31	E-201	GRADE 501, 620
US-32	R-201	▽ 28500
US-33	R-201	▽ 39150
US-34	E-110	▽ 10600
US-35	P-209A/B	GRADE 501, 620
US-36	E-108	▽ 10600
US-37	R-102	▽ 28500
US-38	R-102	▽ 40000
US-39	ME-206	GRADE 501, 620
US-40	E-106	▽ 10600
US-41	HB-102	▽ 13200
US-42	V-107B	▽ 22000
US-43	P-102A/B	GRADE 501, 620
US-44	V-109	GRADE 501, 620
US-45	R-101	▽ 28500
US-46	R-101	▽ 40000
US-47	E-105	▽ 10600
US-48	HB-101	▽ 19800
US-49	V-107A	▽ 22000

U.S.NO	TO	ELEVATION
US-50	P-210A/B, V-106	GRADE 501, 620
US-51	P-214A/B, P-101A/B	GRADE 501, 620
US-52	V-101	2" MAN HOLE ▽ 8700
US-53	B-101A	GRADE 501, 620
US-54	B-101C	GRADE 501, 620
US-55	E-101	▽ 28500
US-56	E-112, V-204	▽ 10000
US-57	E-113	▽ 18000
US-58	E-207	AIR COOLER MOTOR PLATFORM ▽ 23200
US-59	E-207	AIR COOLER MOTOR PLATFORM ▽ 23200
US-60	E-111	AIR COOLER MOTOR PLATFORM ▽ 23200
US-61	E-206	AIR COOLER MOTOR PLATFORM ▽ 23200
US-62	E-202	AIR COOLER MOTOR PLATFORM ▽ 23200
US-63	E-202	AIR COOLER MOTOR PLATFORM ▽ 23200
US-64	E-202	AIR COOLER MOTOR PLATFORM ▽ 23200
US-65	E-202	AIR COOLER MOTOR PLATFORM ▽ 23200
US-66	E-202	AIR COOLER MOTOR PLATFORM ▽ 23200
US-67	E-202	AIR COOLER MOTOR PLATFORM ▽ 23200

U.S.NO	TO	ELEVATION
US 068	V-207B	GRADE 501, 620
US 069	E-107B	▽ 28500
US 070	E-109B	▽ 28500
US 071	E-211B, E-212 B	▽ 28500
US 072	V-108A/B, V-210	▽ 22000
US 073	X-205A/B, X-206	▽ 23200
US 074	V-101, V-110	▽ 10600
US 075	PIPE RACK	GRADE 501, 620
US 076	PIPE RACK	GRADE 501, 620
US 077	PIPE RACK	GRADE 501, 620
US 078	PIPE RACK	GRADE 501, 620
US 079	P-202A/B	GRADE 501, 620
US 080	PIPE RACK	GRADE 501, 620
US 081	PIPE RACK	GRADE 501, 620
US 082	V-151-V-213	GRADE 501, 620

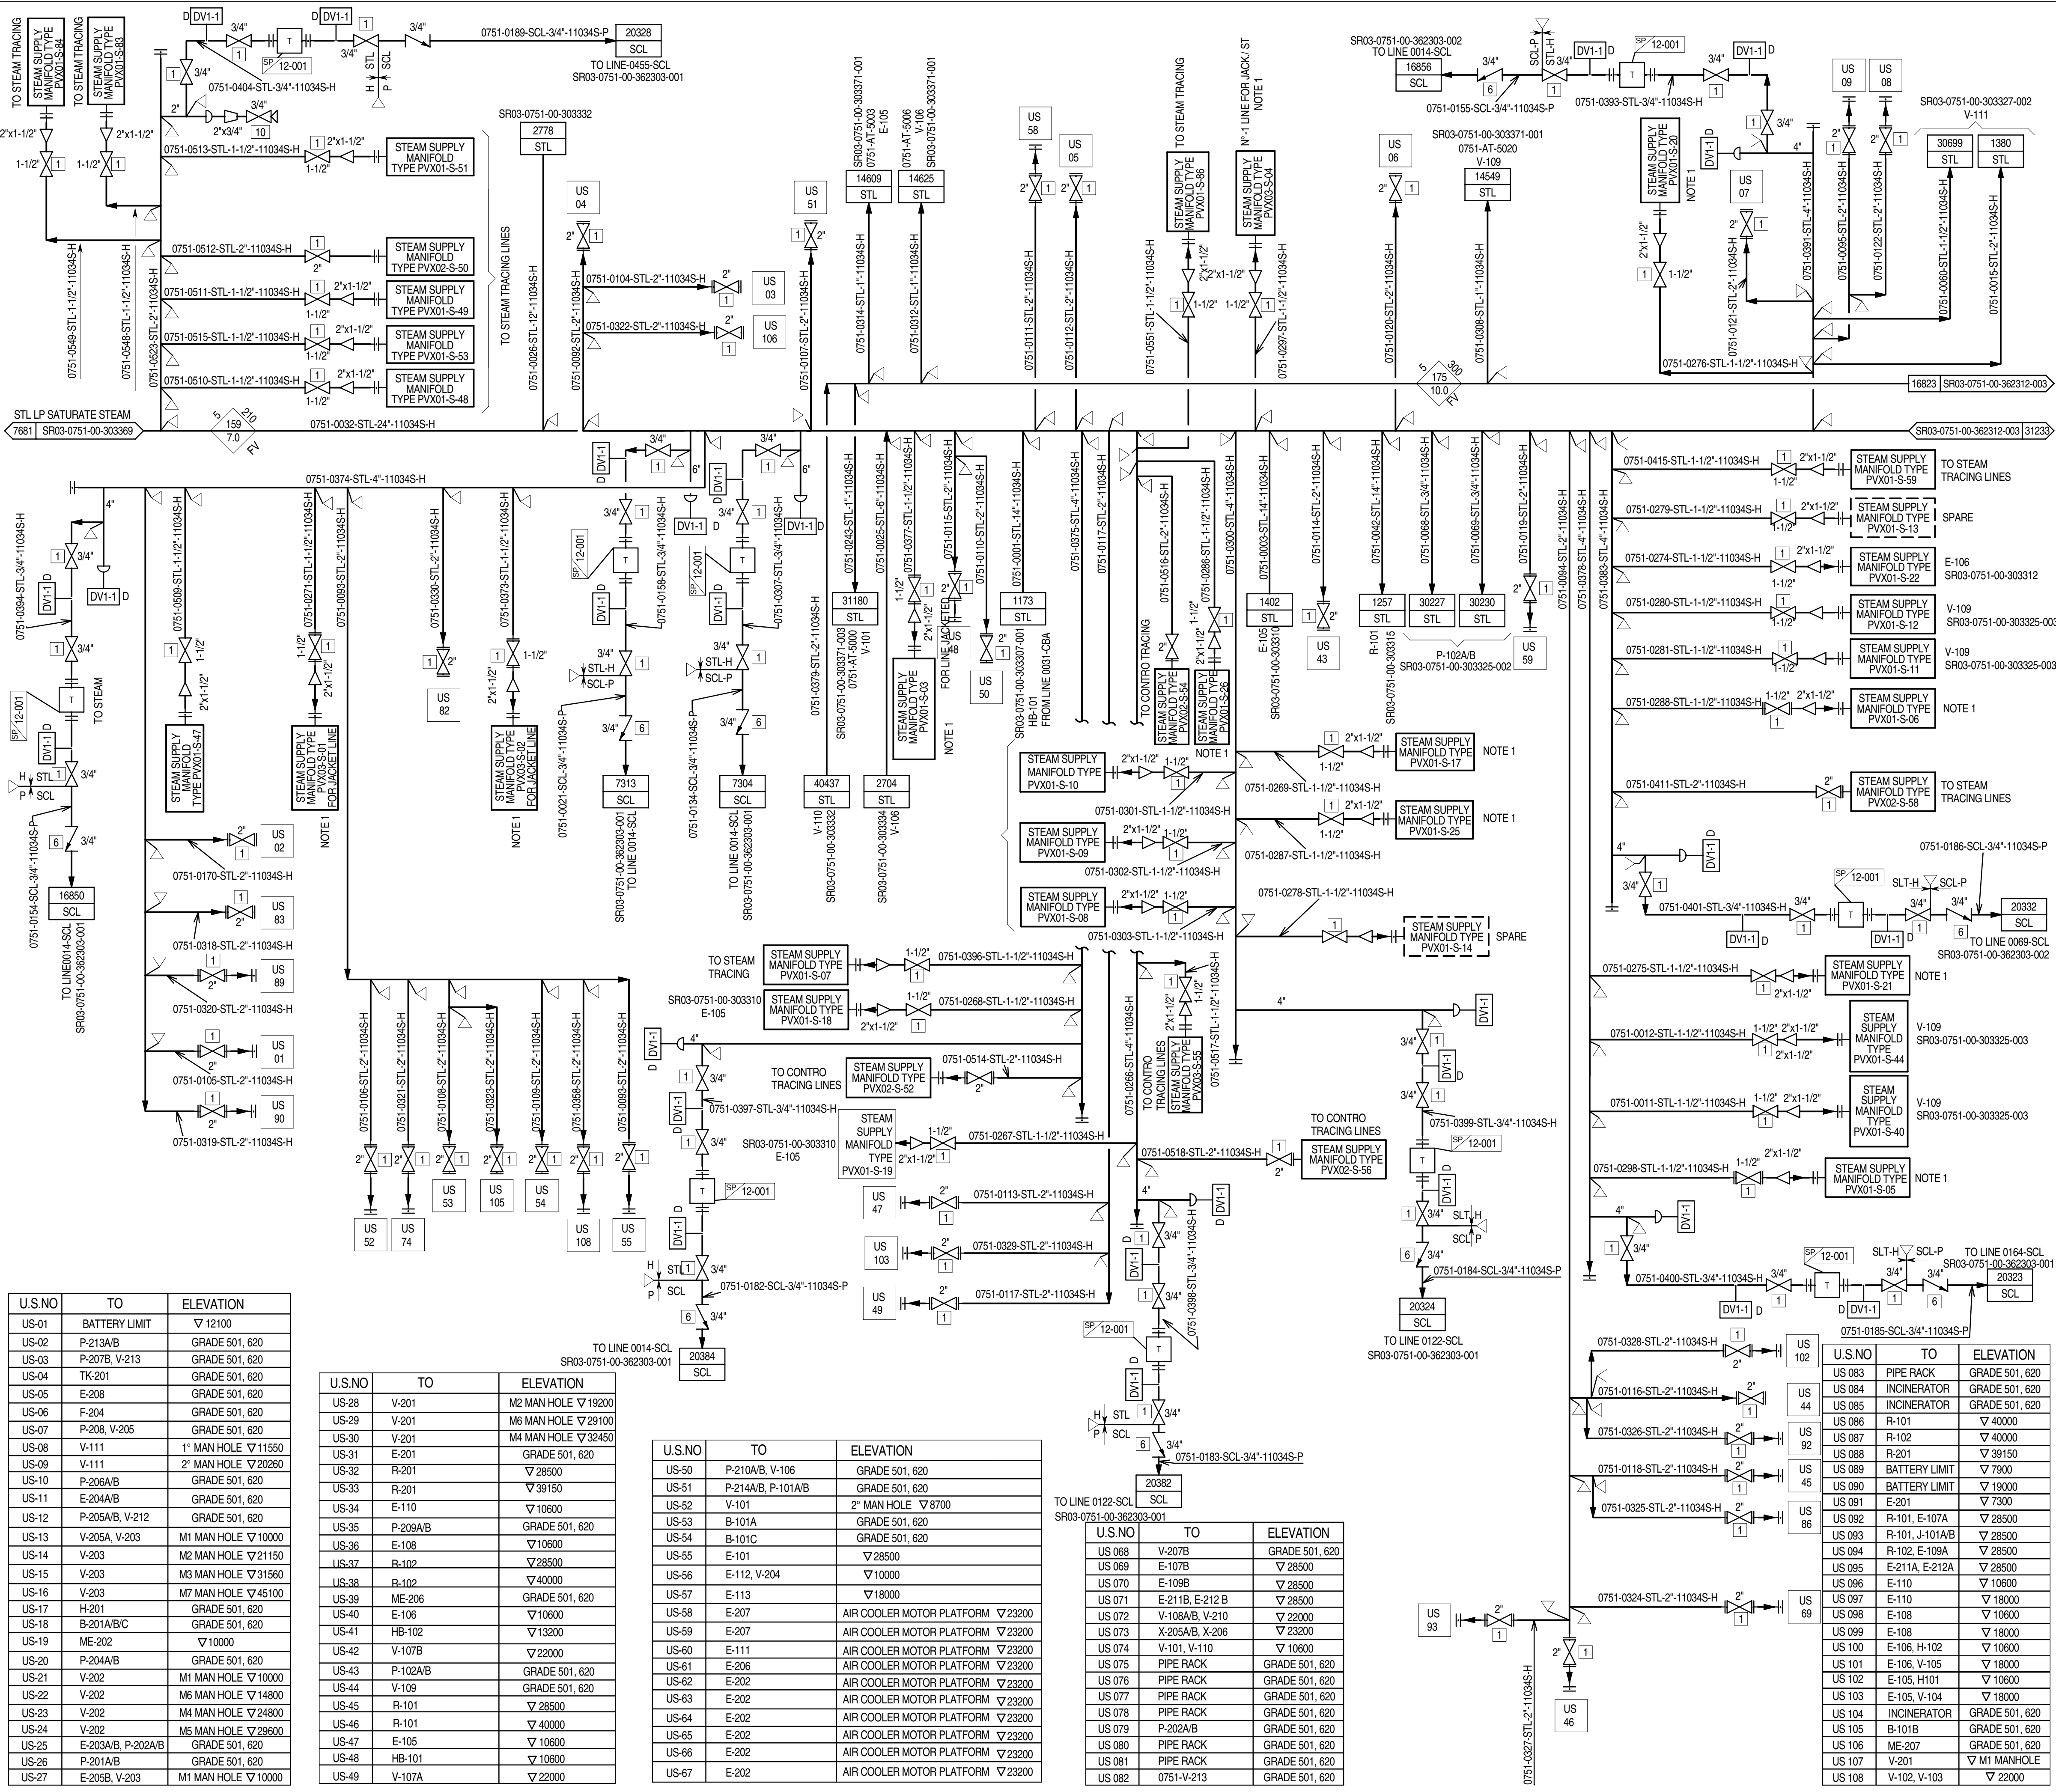

GENERAL NOTES:

1. FOR STANDARD SYMBOLS, DETAILS, ABBREVIATIONS, SAMPLE CONNECTION TYPE, GENERAL NOTES & LEGEND SHEETS REFER TO DRAWING NO. MP02-0230-00-004000 TO 004015.

NOTES:

1. STEAM SUPPLY FROM MANIFOLD TO JACKETED LINES.
REFER: SR03-0751-00-362312-005

Z1	10-11-14	IAB	ISSUED FOR AS BUILT	ANI	MAR	ASP
3.1E	15-07-14	IFC	ISSUED FOR CONSTRUCTION	ANI	MAR	ASP
3.1D	02-02-14	IFC	ISSUED FOR CONSTRUCTION	RL	IP	NA
3.1C	04-05-13	IFC	ISSUED FOR CONSTRUCTION	VM	IP	MZ
3.1B	21-01-13	IFC	ISSUED FOR CONSTRUCTION	RL	IP	MZ
3.1A	31-10-12	IFC	ISSUED FOR CONSTRUCTION	RL	LM	MZ
3	24/08/12	IFC	ISSUE FOR CONSTRUCTION	FP	FZ	AS
2	17/01/12	IFC	ISSUE FOR CONSTRUCTION	FZ	LM	PP
1	16/09/11	IFCH	ISSUED FOR CONSTRUCTION WITH HOLDS	FZ	LM	PP
0	22/03/11	IFD	ISSUED CLIENT COMMENTS INCORPORATED	FZ	LM	PP
B1	07/10/10	ICR	ISSUED FOR CLIENT REVIEW	CM	FZ	LM
REV	DATE	STATUS	STATUS DESCRIPTION	BY	CKD	APP.

COMPANY:

Abu Dhabi Gas Development Co. Ltd.



CONTRACTOR:



saipem

JOB No. 032090

PROJECT: SHAH GAS DEVELOPMENT (SGD) PROJECT
SHAH SULPHUR RECOVERY UNIT

AGREEMENT No. 13525001

DRAWING TITLE: PIPING & INSTRUMENT DIAGRAM UNIT 0751
SULPHUR RECOVERY AND TAIL GAS TREATING UNIT

EQUIPMENT DESCRIPTION LP STEAM DISTRIBUTION

TAGITEM No.

CONTRACTOR DRG.No.

751-GD-B-362312

COMPANY DRG.No.

SR03-0751-00-362312-001

SCALE:


SIZE: A1

DOC. CLASS: 1

REV.

Z1

THIS DOCUMENT IS THE PROPERTY OF ABU DHABI GAS DEVELOPMENT COMPANY LIMITED AND CONTAINS INFORMATION WHICH IS PROPRIETARY. THIS INFORMATION IS TO BE HELD IN CONFIDENCE. NO DISCLOSURE OR OTHER USE OF THIS DOCUMENT IS TO BE MADE WITHOUT THE PRIOR WRITTEN CONSENT OF ABU DHABI GAS DEVELOPMENT COMPANY LIMITED.

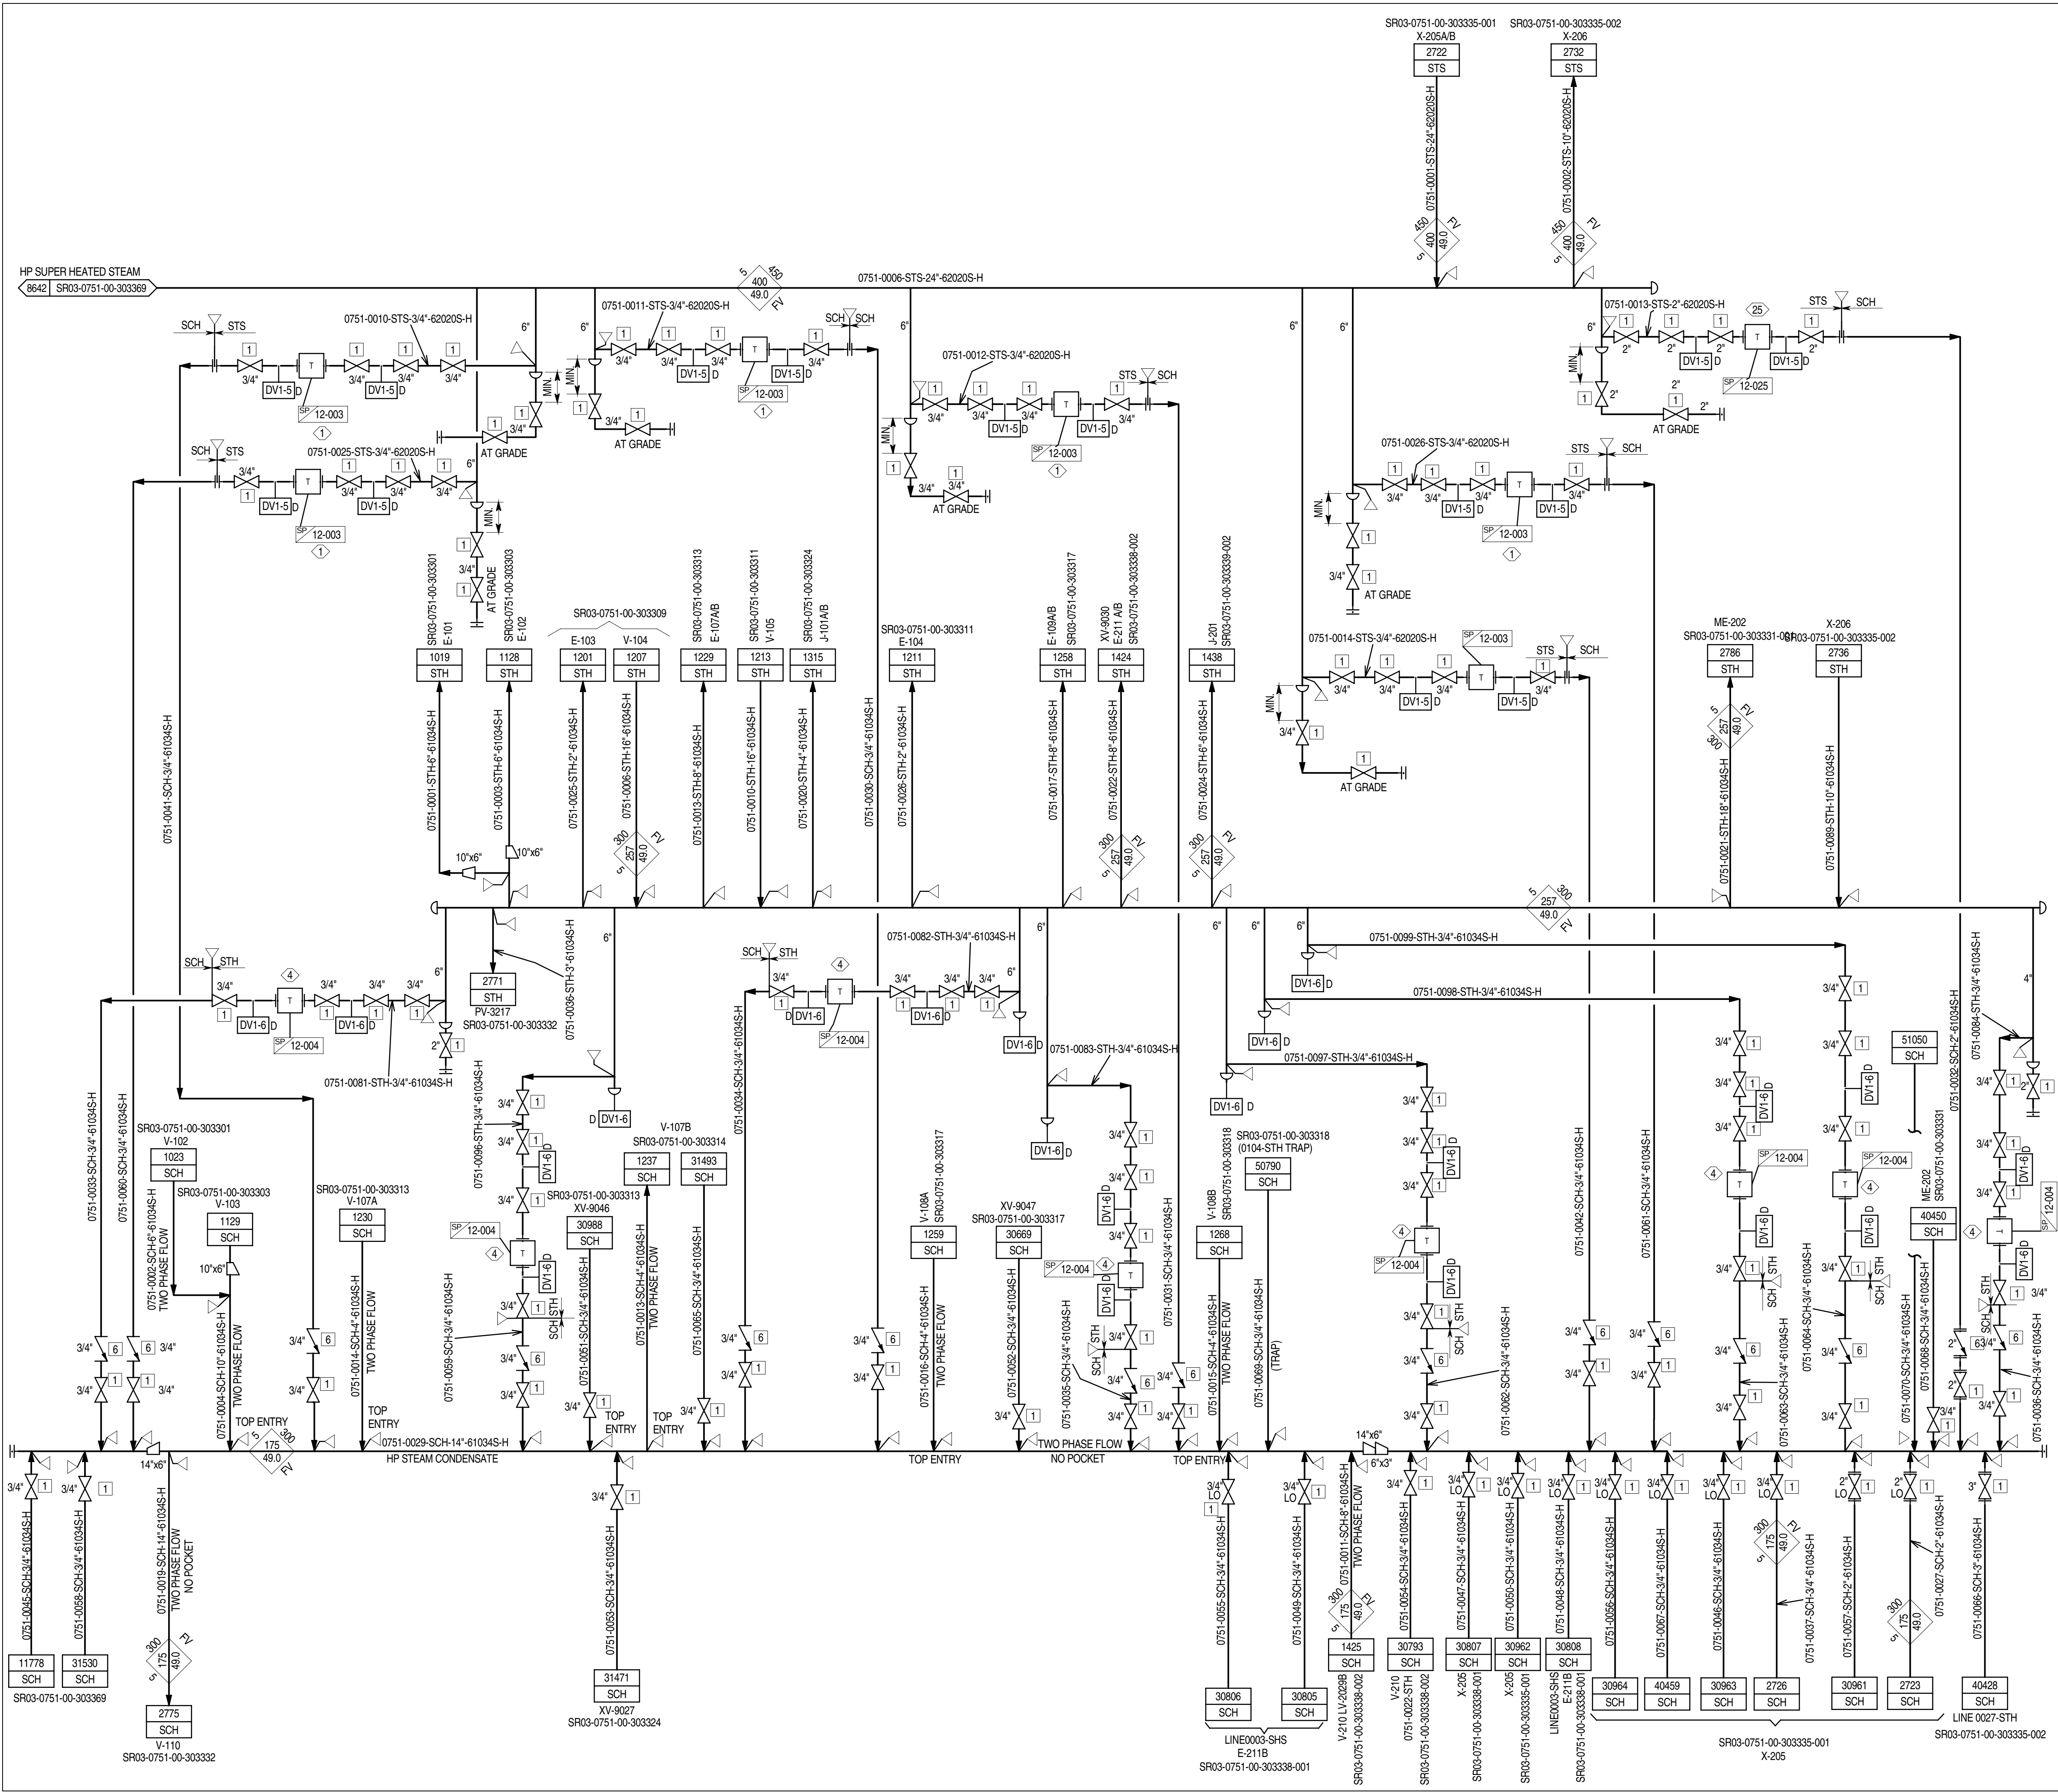

GENERAL NOTES:

1. FOR STANDARD SYMBOLS, DETAILS, ABBREVIATIONS, SAMPLE CONNECTION TYPE, GENERAL NOTES & LEGEND SHEETS REFER TO DRAWING NO. MP02-0230-00-004000 TO 004015.

Z1	10-11-14	IAB	ISSUED FOR AS BUILT	ANI	MAR	ASP
3.1E	15-07-14	IFC	ISSUED FOR CONSTRUCTION	ANI	MAR	ASP
3.1D	02-02-14	IFC	ISSUED FOR CONSTRUCTION	RL	IP	MA
3.1C	04-05-13	IFC	ISSUED FOR CONSTRUCTION	VM	IP	MZ
3.1B	21-01-13	IFC	ISSUED FOR CONSTRUCTION	VM	LM	MZ
3.1A	31-10-12	IFC	ISSUED FOR CONSTRUCTION	RL	LM	MZ
3	24/08/12	IFC	ISSUED FOR CONSTRUCTION	FP	FZ	AS
2	17/01/12	IFC	ISSUED FOR CONSTRUCTION	FZ	LM	PP
1	16/09/11	IFCH	ISSUED FOR CONSTRUCTION WITH HOLDS	FZ	LM	PP
0	22/03/11	IFD	ISSUED CLIENT COMMENTS INCORPORATED	FZ	LM	PP
B1	07/10/10	ICR	ISSUED FOR CLIENT REVIEW	CM	FZ	LM
REV	DATE	STATUS	STATUS DESCRIPTION	BY	CKD	APP.

COMPANY:

Abu Dhabi Gas Development Co. Ltd.



CONTRACTOR:



JOB No. 032090

PROJECT:

SHAH GAS DEVELOPMENT (SGD) PROJECT
SHAH SULPHUR RECOVERY UNIT

AGREEMENT No. 13525001

DRAWING TITLE: PIPING & INSTRUMENT DIAGRAM UNIT 0751
SULPHUR RECOVERY AND TAIL GAS TREATING UNIT

EQUIPMENT DESCRIPTION	HP STEAM AND CONDENSATE DISTRIBUTION	
TAGITEM No.		


CONTRACTOR DRG. No.	751-GD-B-362312	REV. Z1
COMPANY DRG. No.	SR03-0751-00-362312-002	
SCALE:	SIZE: A1 DOC. CLASS: 1	

THIS DOCUMENT IS THE PROPERTY OF ABU DHABI GAS DEVELOPMENT COMPANY LIMITED. NO DISCLOSURE OR OTHER USE OF THIS DOCUMENT IS TO BE MADE WITHOUT THE PRIOR WRITTEN CONSENT OF ABU DHABI GAS DEVELOPMENT COMPANY LIMITED.

U.S.NO	TO	ELEVATION
US-01	BATTERY LIMIT	▽ 12100
US-02	P-213A/B	GRADE 501, 620
US-03	P-207B, V-213	GRADE 501, 620
US-04	TK-201	GRADE 501, 620
US-05	E-208	GRADE 501, 620
US-06	F-204	GRADE 501, 620
US-07	P-208, V-205	GRADE 501, 620
US-08	V-111	1" MAN HOLE ▽ 11550
US-09	V-111	2" MAN HOLE ▽ 20260
US-10	P-205A/B	GRADE 501, 620
US-11	E-204A/B	GRADE 501, 620
US-12	P-205A/B, V-212	GRADE 501, 620
US-13	V-205A, V-203	M1 MAN HOLE ▽ 10000
US-14	V-203	M2 MAN HOLE ▽ 21150
US-15	V-203	M3 MAN HOLE ▽ 31560
US-16	V-203	M7 MAN HOLE ▽ 45100
US-17	H-201	GRADE 501, 620
US-18	B-201A/B/C	GRADE 501, 620
US-19	ME-202	▽ 10000
US-20	P-204A/B	GRADE 501, 620
US-21	V-202	M1 MAN HOLE ▽ 10000
US-22	V-202	M6 MAN HOLE ▽ 14800
US-23	V-202	M4 MAN HOLE ▽ 24800
US-24	V-202	M5 MAN HOLE ▽ 29600
US-25	E-203A/B, P-202A/B	GRADE 501, 620
US-26	P-201A/B	GRADE 501, 620
US-27	E-205B, V-203	M1 MAN HOLE ▽ 10000

U.S.NO	TO	ELEVATION
US-28	V-201	M2 MAN HOLE ▽ 19200
US-29	V-201	M6 MAN HOLE ▽ 29100
US-30	V-201	M4 MAN HOLE ▽ 32450
US-31	E-201	GRADE 501, 620
US-32	R-201	▽ 28500
US-33	R-201	▽ 39150
US-34	E-110	▽ 10600
US-35	P-209A/B	GRADE 501, 620
US-36	E-108	▽ 10600
US-37	R-102	▽ 28500
US-38	R-102	▽ 40000
US-39	ME-206	GRADE 501, 620
US-40	E-106	▽ 10600
US-41	HB-102	▽ 13200
US-42	V-107B	▽ 22000
US-43	P-102A/B	GRADE 501, 620
US-44	V-109	GRADE 501, 620
US-45	R-101	▽ 28500
US-46	R-101	▽ 40000
US-47	E-105	▽ 10600
US-48	HB-101	▽ 10600
US-49	V-107A	▽ 22000

U.S.NO	TO	ELEVATION
US-50	P-210A/B, V-106	GRADE 501, 620
US-51	P-214A/B, P-101A/B	GRADE 501, 620
US-52	V-101	2" MAN HOLE ▽ 8700
US-53	B-101A	GRADE 501, 620
US-54	B-101C	GRADE 501, 620
US-55	E-101	▽ 28500
US-56	E-112, V-204	▽ 10000
US-57	E-113	▽ 18000
US-58	E-207	AIR COOLER MOTOR PLATFORM ▽ 23200
US-59	E-207	AIR COOLER MOTOR PLATFORM ▽ 23200
US-60	E-111	AIR COOLER MOTOR PLATFORM ▽ 23200
US-61	E-206	AIR COOLER MOTOR PLATFORM ▽ 23200
US-62	E-202	AIR COOLER MOTOR PLATFORM ▽ 23200
US-63	E-202	AIR COOLER MOTOR PLATFORM ▽ 23200
US-64	E-202	AIR COOLER MOTOR PLATFORM ▽ 23200
US-65	E-202	AIR COOLER MOTOR PLATFORM ▽ 23200
US-66	E-202	AIR COOLER MOTOR PLATFORM ▽ 23200
US-67	E-202	AIR COOLER MOTOR PLATFORM ▽ 23200

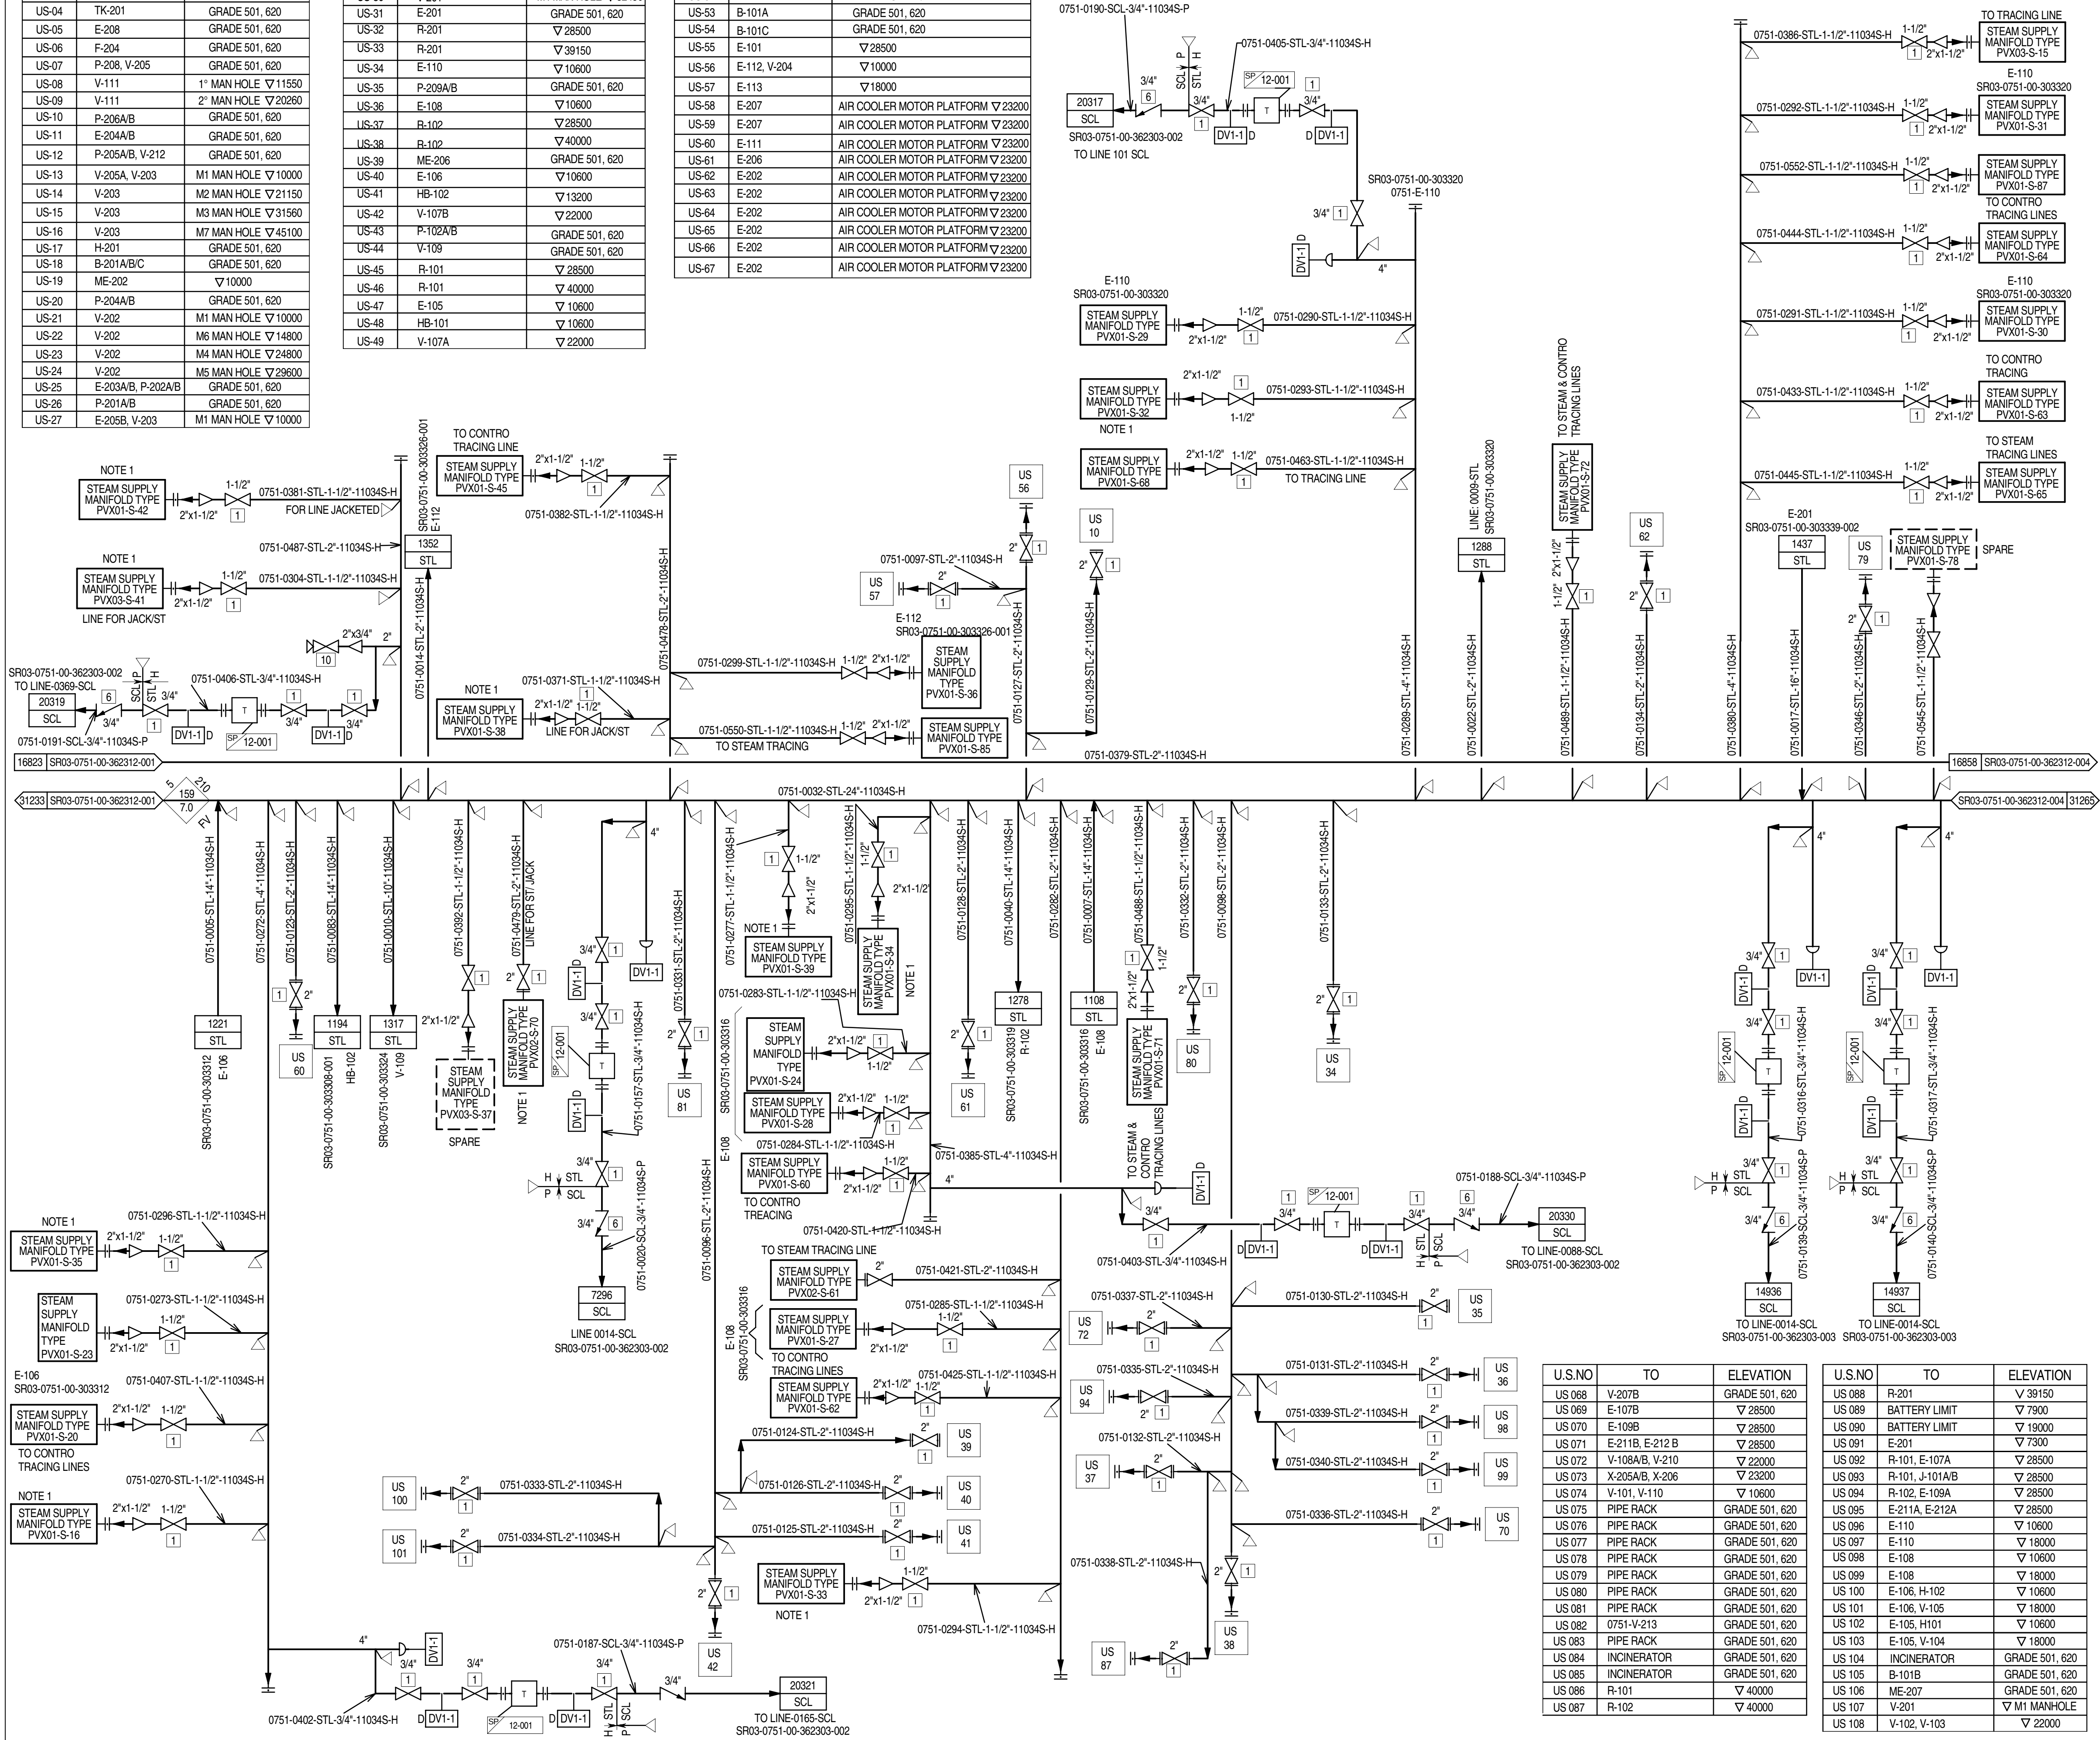

NOTES:

1. STEAM SUPPLY FROM MANIFOLD TO JACKETED LINES
REFER: SR03-0751-00-362312-005.

<u>COMPANY:</u>			
Abu Dhabi Gas Development Co. Ltd.			
			
<u>CONTRACTOR:</u>			
			
JOB No. 032090			
<u>PROJECT:</u>			
SHAH GAS DEVELOPMENT (SGD) PROJECT SHAH SULPHUR RECOVERY UNIT			
AGREEMENT No. 13525001			
<u>DRAWING TITLE:</u>			
PIPING & INSTRUMENT DIAGRAM UNIT 0751 SULPHUR RECOVERY AND TAIL GAS TREATING UNIT			
EQUIPMENT DESCRIPTION		LP STEAM DISTRIBUTION	
TAG/ITEM No.			
CONTRACTOR DRG.No.		751-GD-B-362312	
COMPANY DRG.No.		SR03-0751-00-362312-004	
SCALE:		SIZE: A1	DOC. CLASS: 1
			REV. Z1

THIS DOCUMENT IS THE PROPERTY OF ABU DHABI GAS DEVELOPMENT COMPANY LIMITED. NO DISCLOSURE OR OTHER USE OF THIS DOCUMENT IS TO BE MADE WITHOUT THE PRIOR WRITTEN CONSENT OF ABU DHABI GAS DEVELOPMENT COMPANY LIMITED.

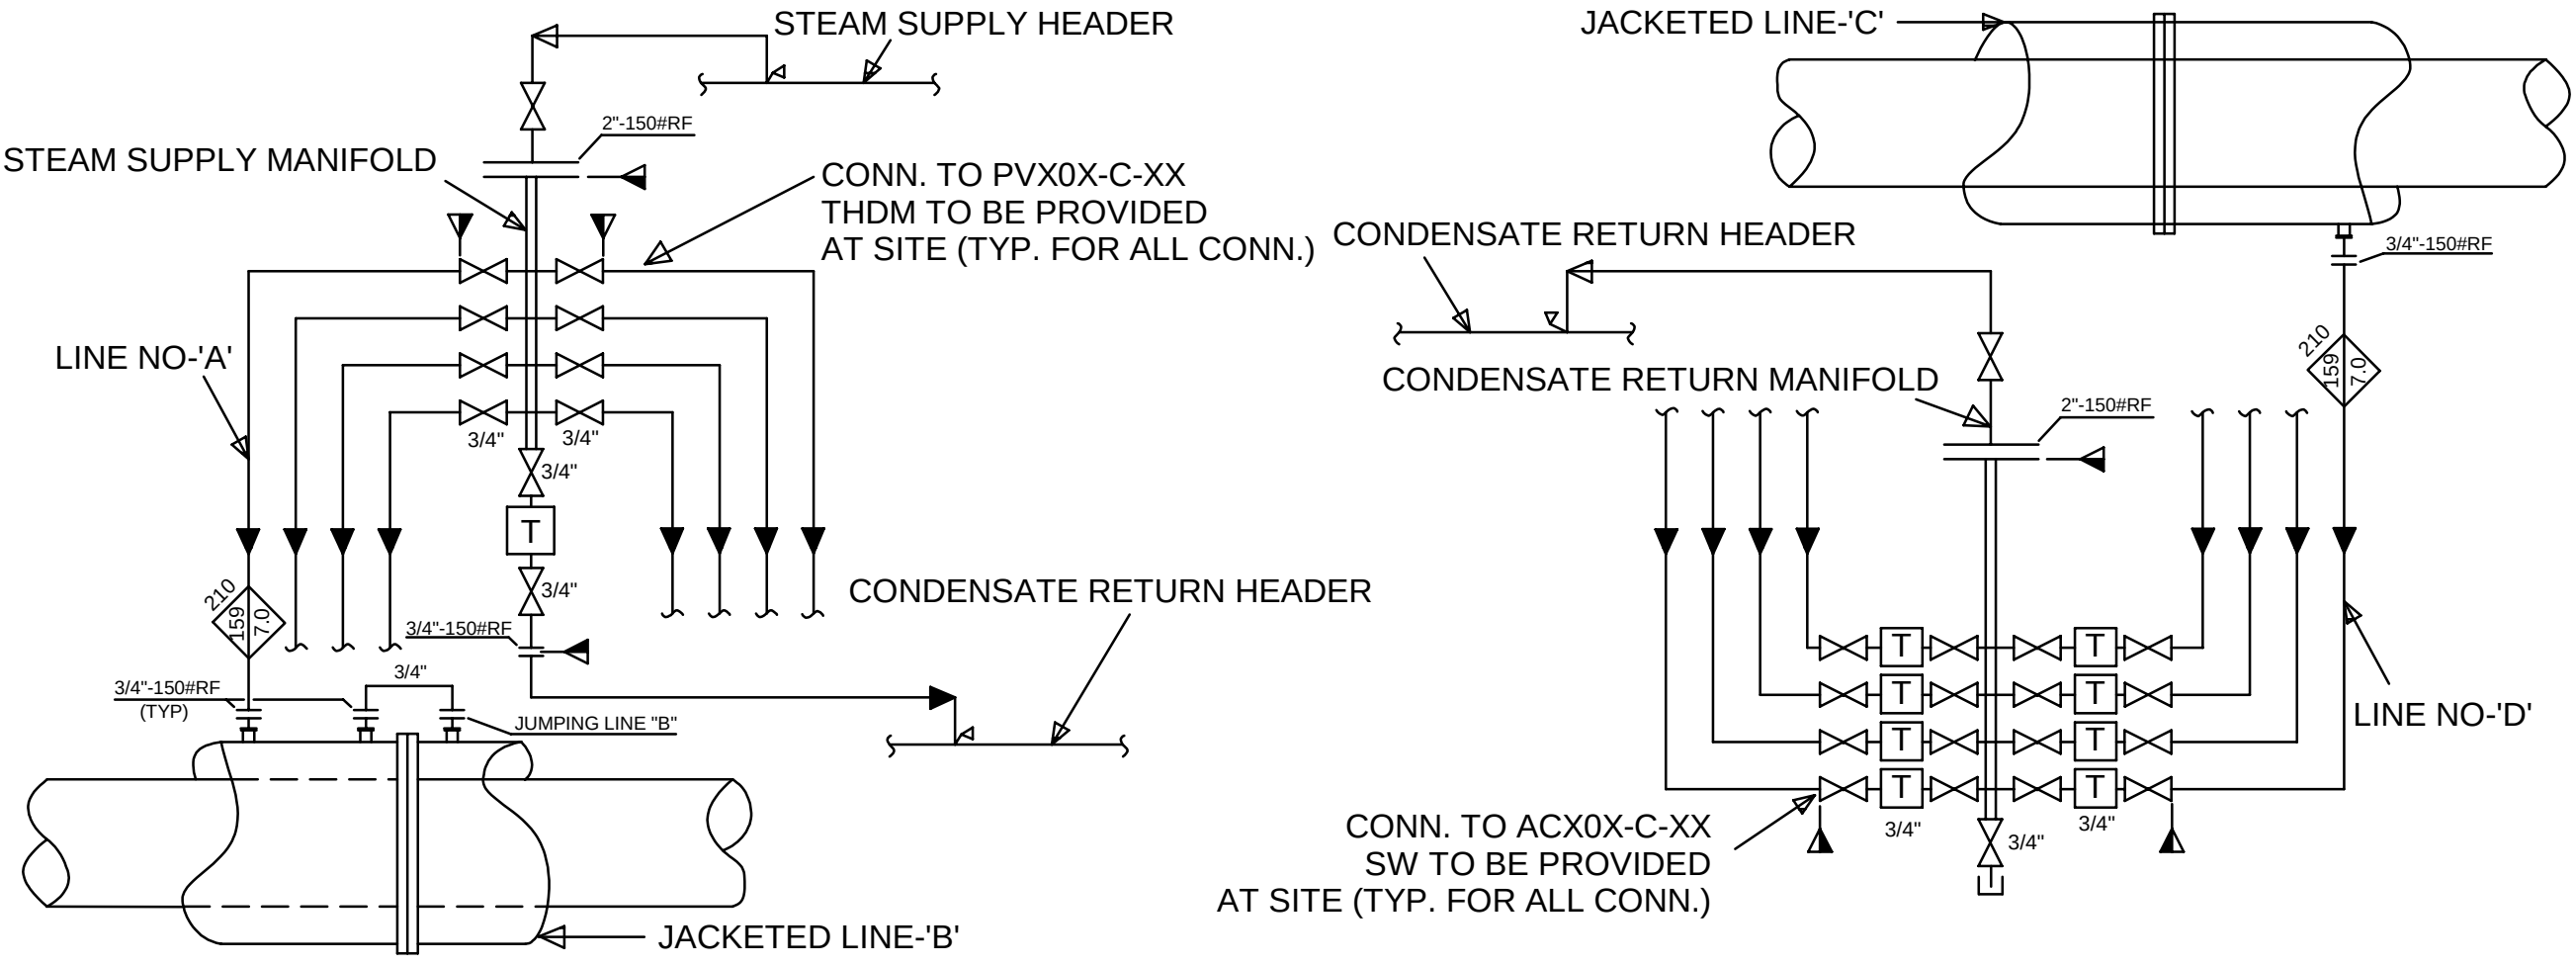



TABLE - 'A'		
STEAM SUPPLY MANIFOLD	STEAM SUPPLY LINE TAG - 'A'	JACKETED LINE NO. - 'B'
PVX01-S-25	0751-0422-STL-3/4"-11034S-H	0751-0198-STL
PVX01-S-25	0751-0423-STL-3/4"-11034S-H	0751-0198-STL
PVX01-S-25	0751-0424-STL-3/4"-11034S-H	0751-0198-STL
PVX03-S-26	0751-0426-STL-3/4"-11034S-H	0751-0224-STL
PVX03-S-26	0751-0427-STL-3/4"-11034S-H	0751-0224-STL
PVX01-S-17	0751-0447-STL-3/4"-11034S-H	0751-0224-STL
PVX01-S-17	0751-0446-STL-3/4"-11034S-H	0751-0224-STL
PVX01-S-17	0751-0448-STL-3/4"-11034S-H	0751-0217-STL
PVX01-S-21	0751-0449-STL-3/4"-11034S-H	0751-0217-STL
PVX01-S-17	0751-0450-STL-3/4"-11034S-H	0751-0539-STL
PVX01-S-17	0751-0451-STL-3/4"-11034S-H	0751-0217-STL
PVX01-S-05	0751-0464-STL-3/4"-11034S-H	0751-0214-STL
PVX01-S-05	0751-0465-STL-3/4"-11034S-H	0751-0203-STL
PVX01-S-06	0751-0458-STL-3/4"-11034S-H	0751-0206-STL
PVX01-S-06	0751-0459-STL-3/4"-11034S-H	0751-0206-STL
PVX01-S-06	0751-0460-STL-3/4"-11034S-H	0751-0209-STL
PVX01-S-05	0751-0468-STL-3/4"-11034S-H	0751-0211-STL
PVX01-S-16	0751-0453-STL-3/4"-11034S-H	0751-0212-STL
PVX01-S-16	0751-0454-STL-3/4"-11034S-H	0751-0212-STL
PVX01-S-16	0751-0455-STL-3/4"-11034S-H	0751-0212-STL
PVX01-S-06	0751-0457-STL-3/4"-11034S-H	0751-0212-STL
PVX01-S-05	0751-0469-STL-3/4"-11034S-H	0751-0212-STL
PVX01-S-16	0751-0470-STL-3/4"-11034S-H	0751-0213-STL
PVX01-S-06	0751-0461-STL-3/4"-11034S-H	0751-0201-STL
PVX01-S-06	0751-0462-STL-3/4"-11034S-H	0751-0201-STL
PVX01-S-25	0751-0471-STL-3/4"-11034S-H	0751-0200-STL
PVX01-S-34	0751-0416-STL-3/4"-11034S-H	0751-0204-STL
PVX01-S-34	0751-0417-STL-3/4"-11034S-H	0751-0204-STL
PVX01-S-35	0751-0418-STL-3/4"-11034S-H	0751-0204-STL
PVX01-S-32	0751-0408-STL-3/4"-11034S-H	0751-0207-STL
PVX01-S-16	0751-0526-STL-3/4"-11034S-H	0751-J-101B


TABLE - 'B'		
CONDENSATE RETURN MANIFOLD	JACKETED LINE NO - 'C'	CONDENSATE RETURN LINE TAG - 'D'
ACX01-C-35	0751-0198-STL	0751-0218-SCL-3/4"-11034S-H
ACX01-C-35	0751-0198-STL	0751-0219-SCL-3/4"-11034S-H
ACX01-C-35	0751-0198-STL	0751-0220-SCL-3/4"-11034S-H
ACX01-C-35	0751-0198-STL	0751-0221-SCL-3/4"-11034S-H
ACX01-C-35	0751-0198-STL	0751-0222-SCL-3/4"-11034S-H
ACX01-C-34	0751-0224-STL	0751-0226-SCL-3/4"-11034S-H
ACX01-C-34	0751-0224-STL	0751-0227-SCL-3/4"-11034S-H
ACX01-C-34	0751-0224-STL	0751-0228-SCL-3/4"-11034S-H
ACX01-C-34	0751-0224-STL	0751-0229-SCL-3/4"-11034S-H
ACX02-C-20	0751-0224-STL	0751-0285-SCL-3/4"-11034S-H
ACX02-C-21	0751-0223-STL	0751-0270-SCL-3/4"-11034S-H
ACX02-C-21	0751-0223-STL	0751-0271-SCL-3/4"-11034S-H
ACX02-C-20	0751-0223-STL	0751-0284-SCL-3/4"-11034S-H
ACX02-C-21	0751-0535/361-STL	0751-0274-SCL-3/4"-11034S-H
ACX02-C-21	0751-0535-STL	0751-0275-SCL-3/4"-11034S-H
ACX02-C-21	0751-0217/535-STL	0751-0276-SCL-3/4"-11034S-H
ACX02-C-20	0751-0217-STL	0751-0281-SCL-3/4"-11034S-H
ACX02-C-20	0751-0217-STL	0751-0282-SCL-3/4"-11034S-H
ACX02-C-20	0751-0217-STL	0751-0283-SCL-3/4"-11034S-H
ACX02-C-05	0751-0214-STL	0751-0320-SCL-3/4"-11034S-H
ACX02-C-05	0751-0214-STL	0751-0321-SCL-3/4"-11034S-H
ACX02-C-05	0751-0214-STL	0751-0322-SCL-3/4"-11034S-H
ACX02-C-05	0751-0203-STL	0751-0323-SCL-3/4"-11034S-H
ACX02-C-05	0751-0203-STL	0751-0324-SCL-3/4"-11034S-H
ACX02-C-05	0751-0203-STL	0751-0325-SCL-3/4"-11034S-H
ACX02-C-16	0751-0206-STL	0751-0301-SCL-3/4"-11034S-H
ACX02-C-05	0751-0206-STL	0751-0317-SCL-3/4"-11034S-H
ACX02-C-05	0751-0206-STL	0751-0318-SCL-3/4"-11034S-H
ACX02-C-83	0751-0200-VT	0751-0388-SCL-3/4"-11034S-H

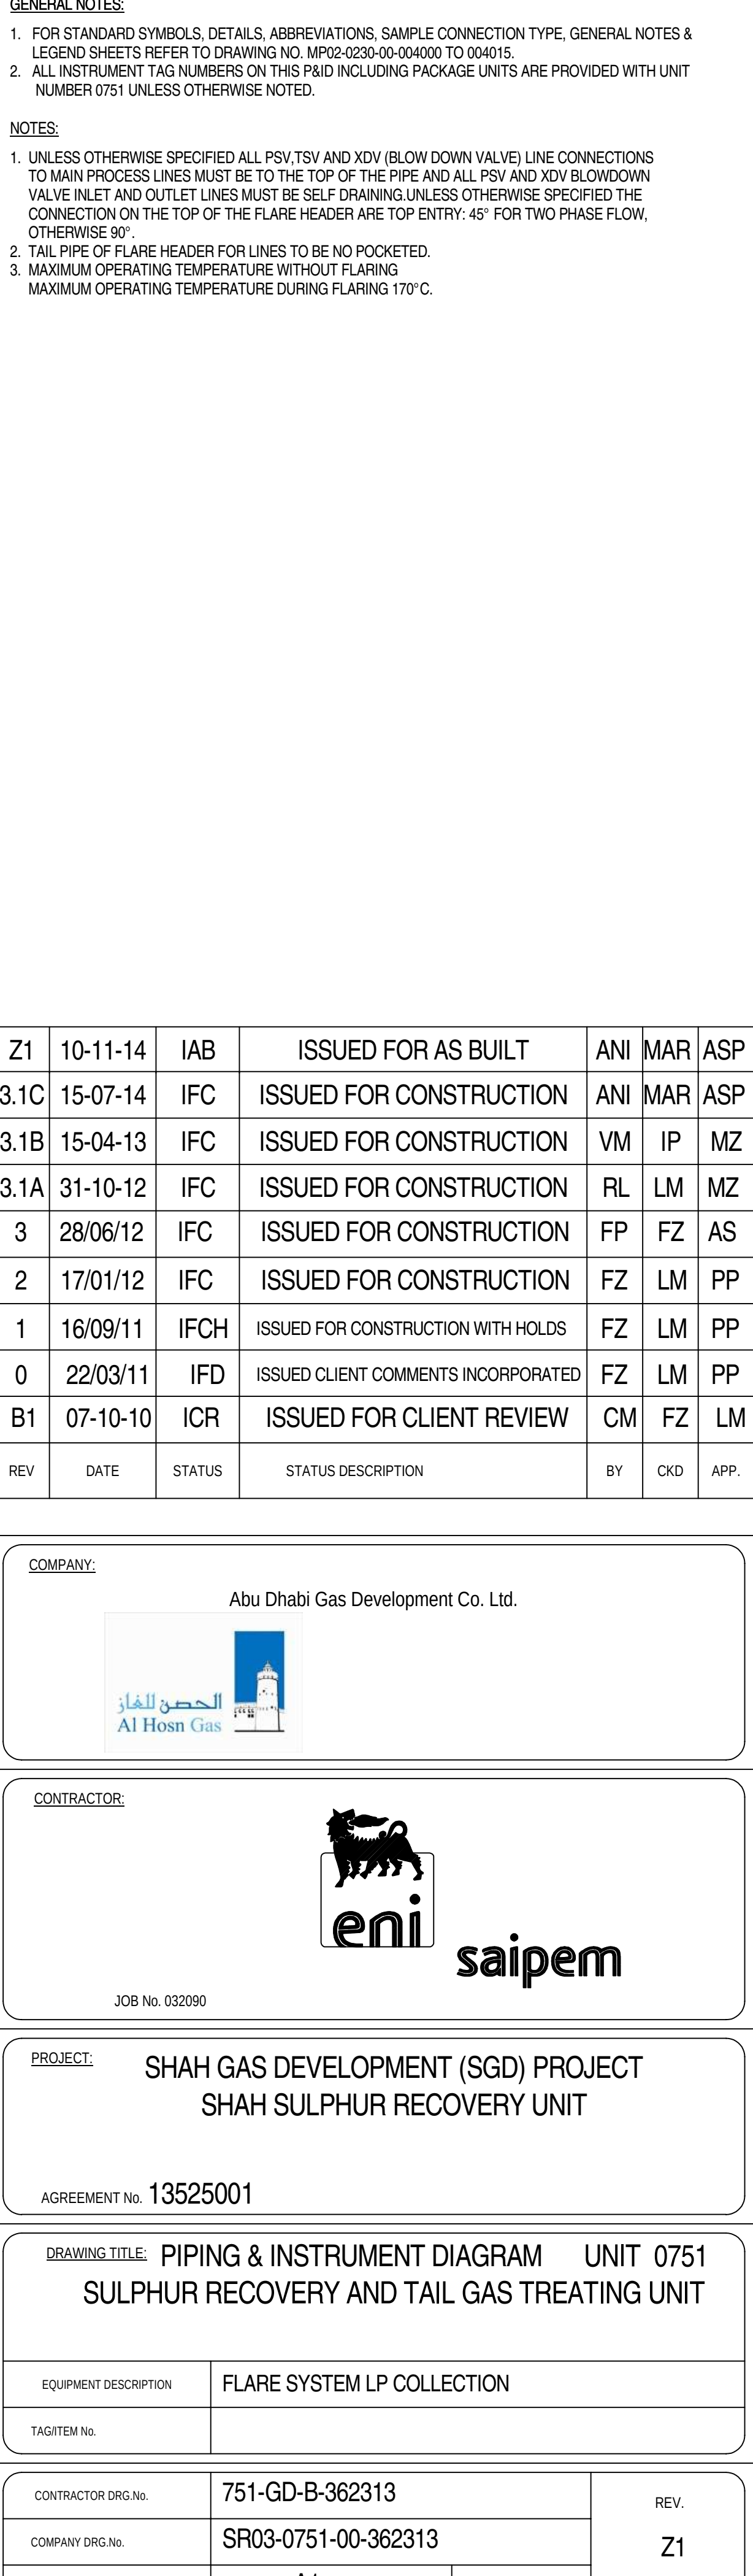

THIS DOCUMENT IS THE PROPERTY OF ABU DHABI GAS DEVELOPMENT COMPANY LIMITED AND CONTAINS INFORMATION WHICH IS PROPRIETARY. THIS INFORMATION IS TO BE HELD IN CONFIDENCE. NO DISCLOSURE OR OTHER USE OF THIS DOCUMENT IS TO BE MADE WITHOUT THE PRIOR WRITTEN CONSENT OF ABU DHABI GAS DEVELOPMENT COMPANY LIMITED.

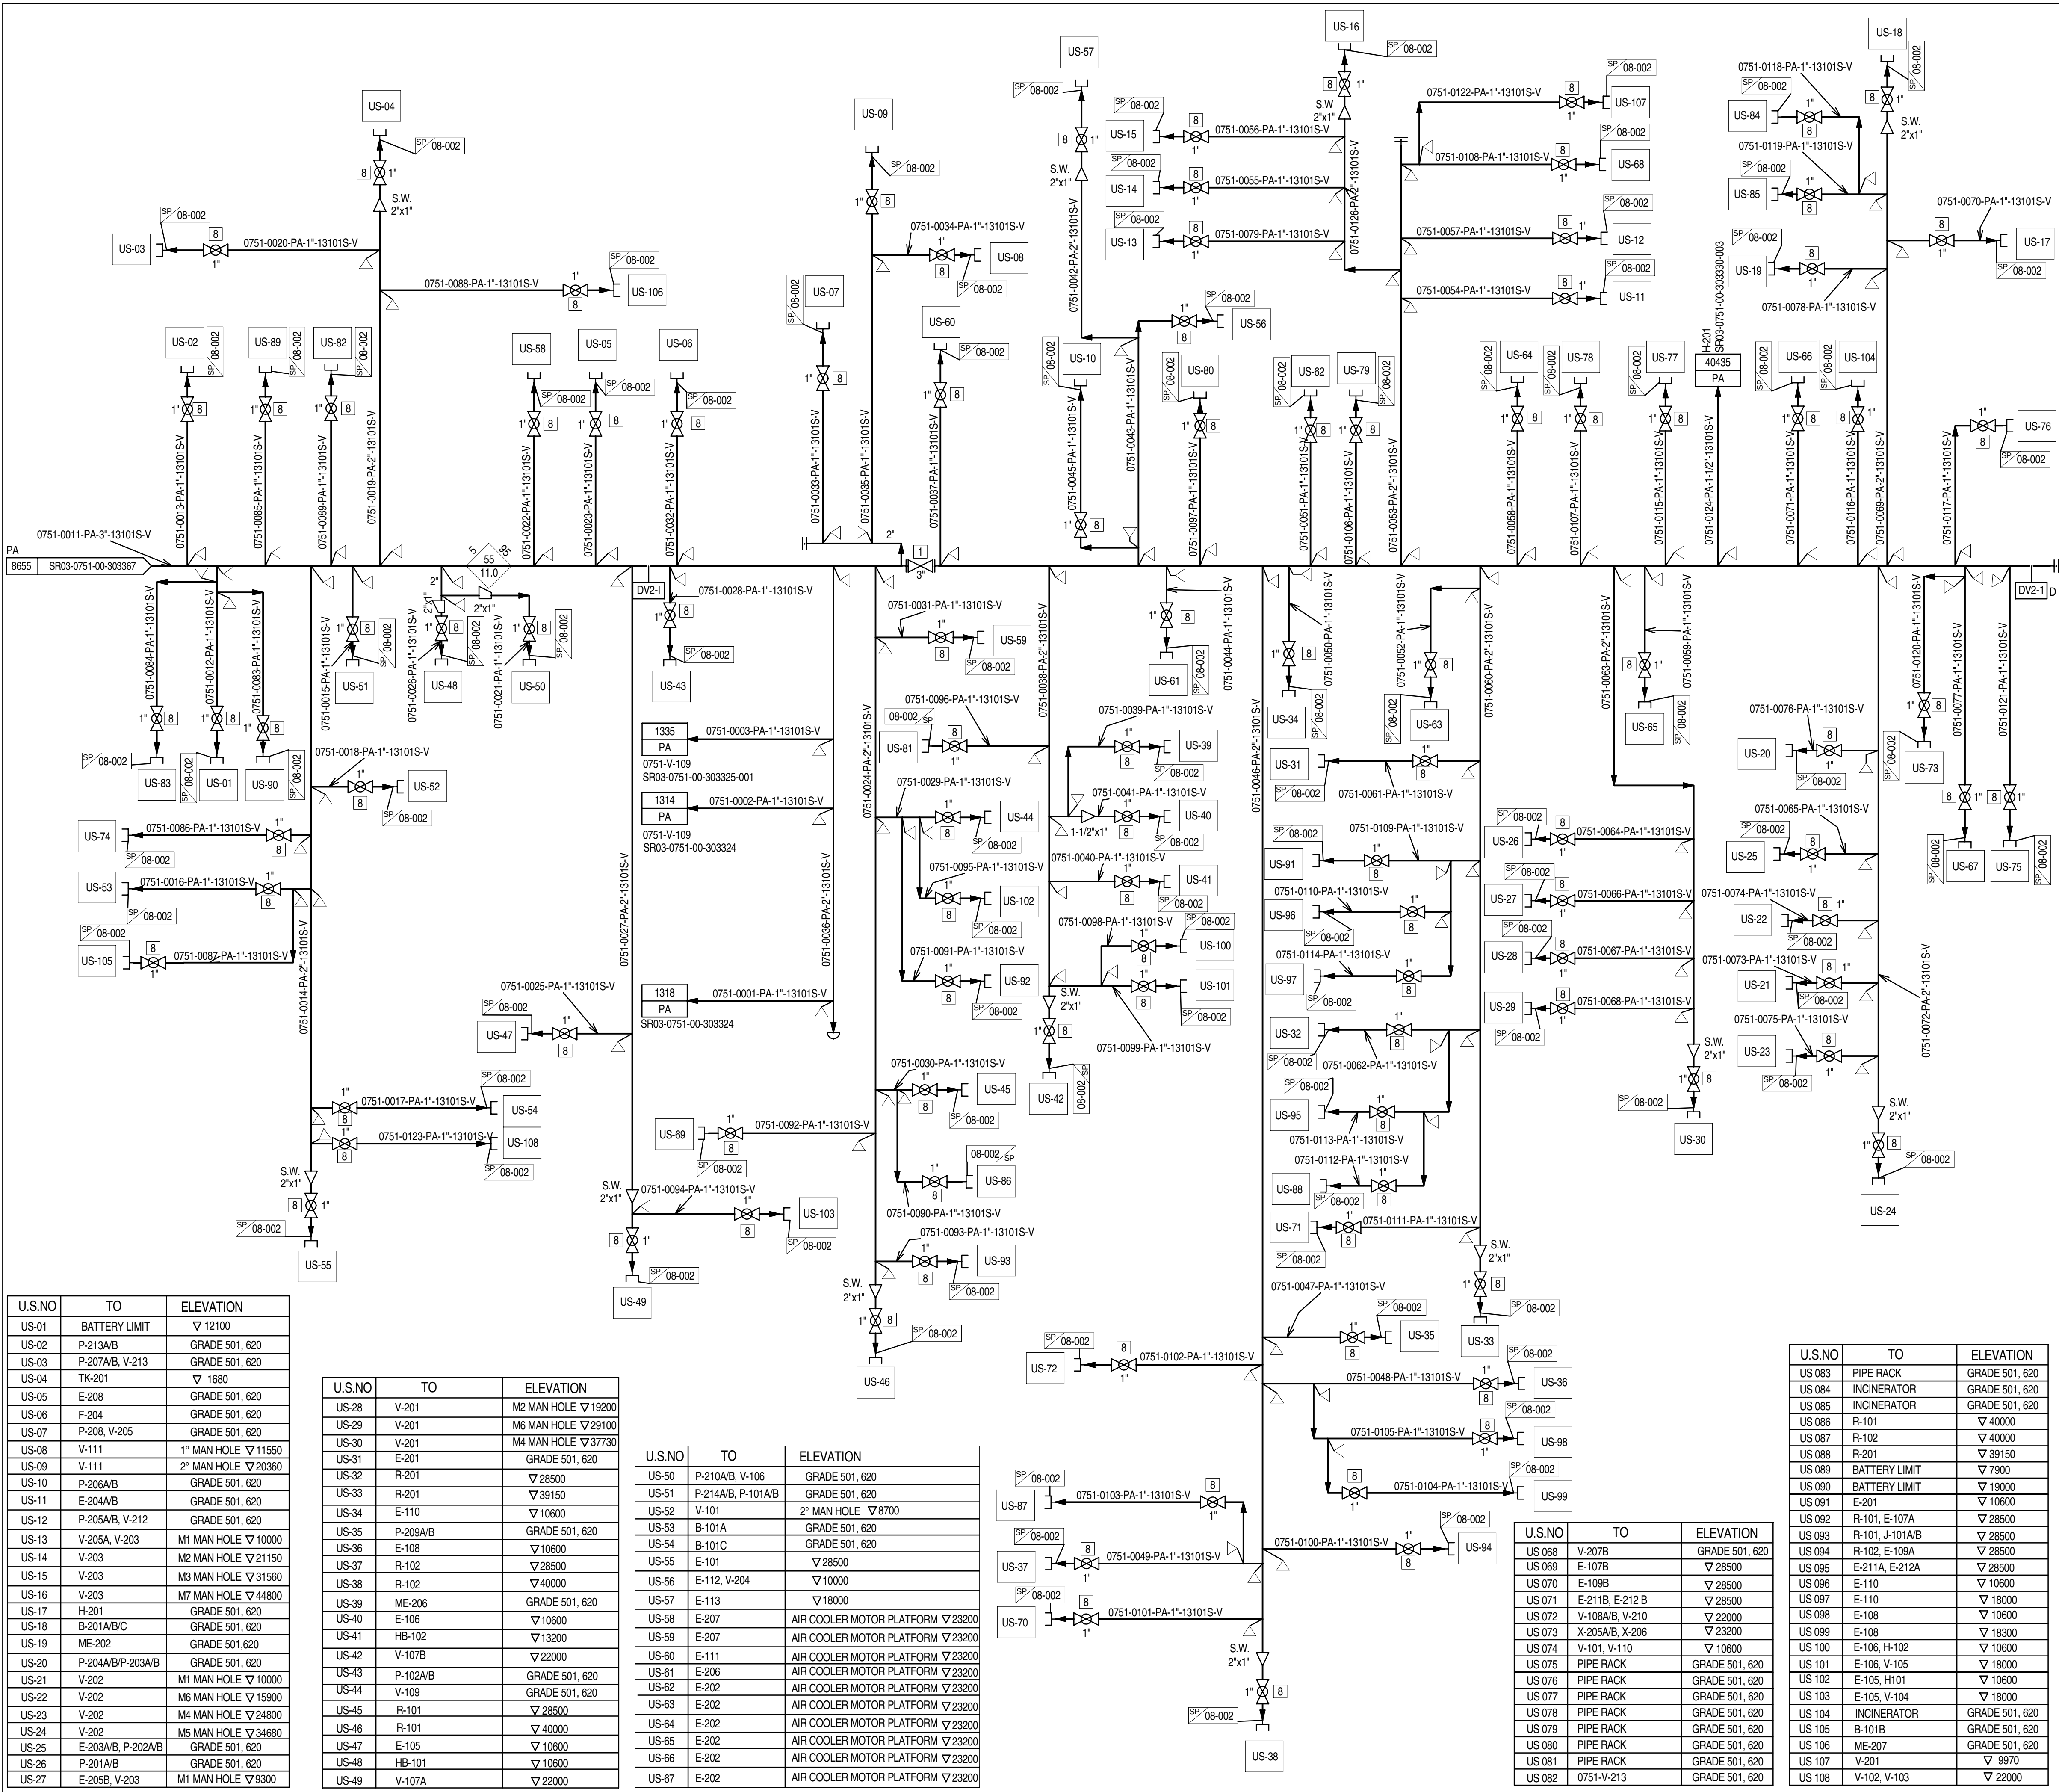

GENERAL NOTES:
1. FOR STANDARD SYMBOLS, DETAILS, ABBREVIATIONS, SAMPLE CONNECTION TYPE, GENERAL NOTES & LEGEND SHEETS REFER TO DRAWING NO. MP02-0230-00-004000 TO 004015.

REV	DATE	STATUS	STATUS DESCRIPTION	BY	CHKD	APP.
Z1	10-11-14	IAB	ISSUED FOR AS BUILT	ANI	MAR	ASP
3.1C	15-07-14	IFC	ISSUED FOR CONSTRUCTION	ANI	MAR	ASP
3.1B	30-03-14	IFC	ISSUED FOR CONSTRUCTION	ANI	MAR	ASP
3.1A	15-04-13	IFC	ISSUED FOR CONSTRUCTION	VM	IP	MZ
3	02/07/12	IFC	ISSUED FOR CONSTRUCTION	FP	FZ	AS
2	17/01/12	IFC	ISSUED FOR CONSTRUCTION	FZ	LM	PP
1	16/09/11	IFCH	ISSUED FOR CONSTRUCTION WITH HOLDS	FZ	LM	PP
0	22/03/11	IFD	ISSUED CLIENT COMMENTS INCORPORATED	FZ	LM	PP
B1	27/10/10	ICR	ISSUED FOR CLIENT REVIEW	CM	FZ	LM

COMPANY:
Abu Dhabi Gas Development Co. Ltd.


CONTRACTOR:


PROJECT:
SHAH GAS DEVELOPMENT (SGD) PROJECT
SHAH SULPHUR RECOVERY UNIT
AGREEMENT No. 13525001

DRAWING TITLE: PIPING & INSTRUMENT DIAGRAM UNIT 0751
SULPHUR RECOVERY AND TAIL GAS TREATING UNIT
EQUIPMENT DESCRIPTION: PLANT AIR DISTRIBUTION
TAGITEM No.

CONTRACTOR DRG. No. 751-GD-B-362314
COMPANY DRG. No. SR03-0751-00-362314
SCALE: A1
REV. Z1
DOC. CLASS: 1

