



THIS DOCUMENT IS THE PROPERTY OF ABU DHABI GAS DEVELOPMENT COMPANY LIMITED. NO DISCLOSURE OR OTHER USE OF THIS DOCUMENT IS TO BE MADE WITHOUT THE PRIOR WRITTEN CONSENT OF ABU DHABI GAS DEVELOPMENT COMPANY LIMITED.

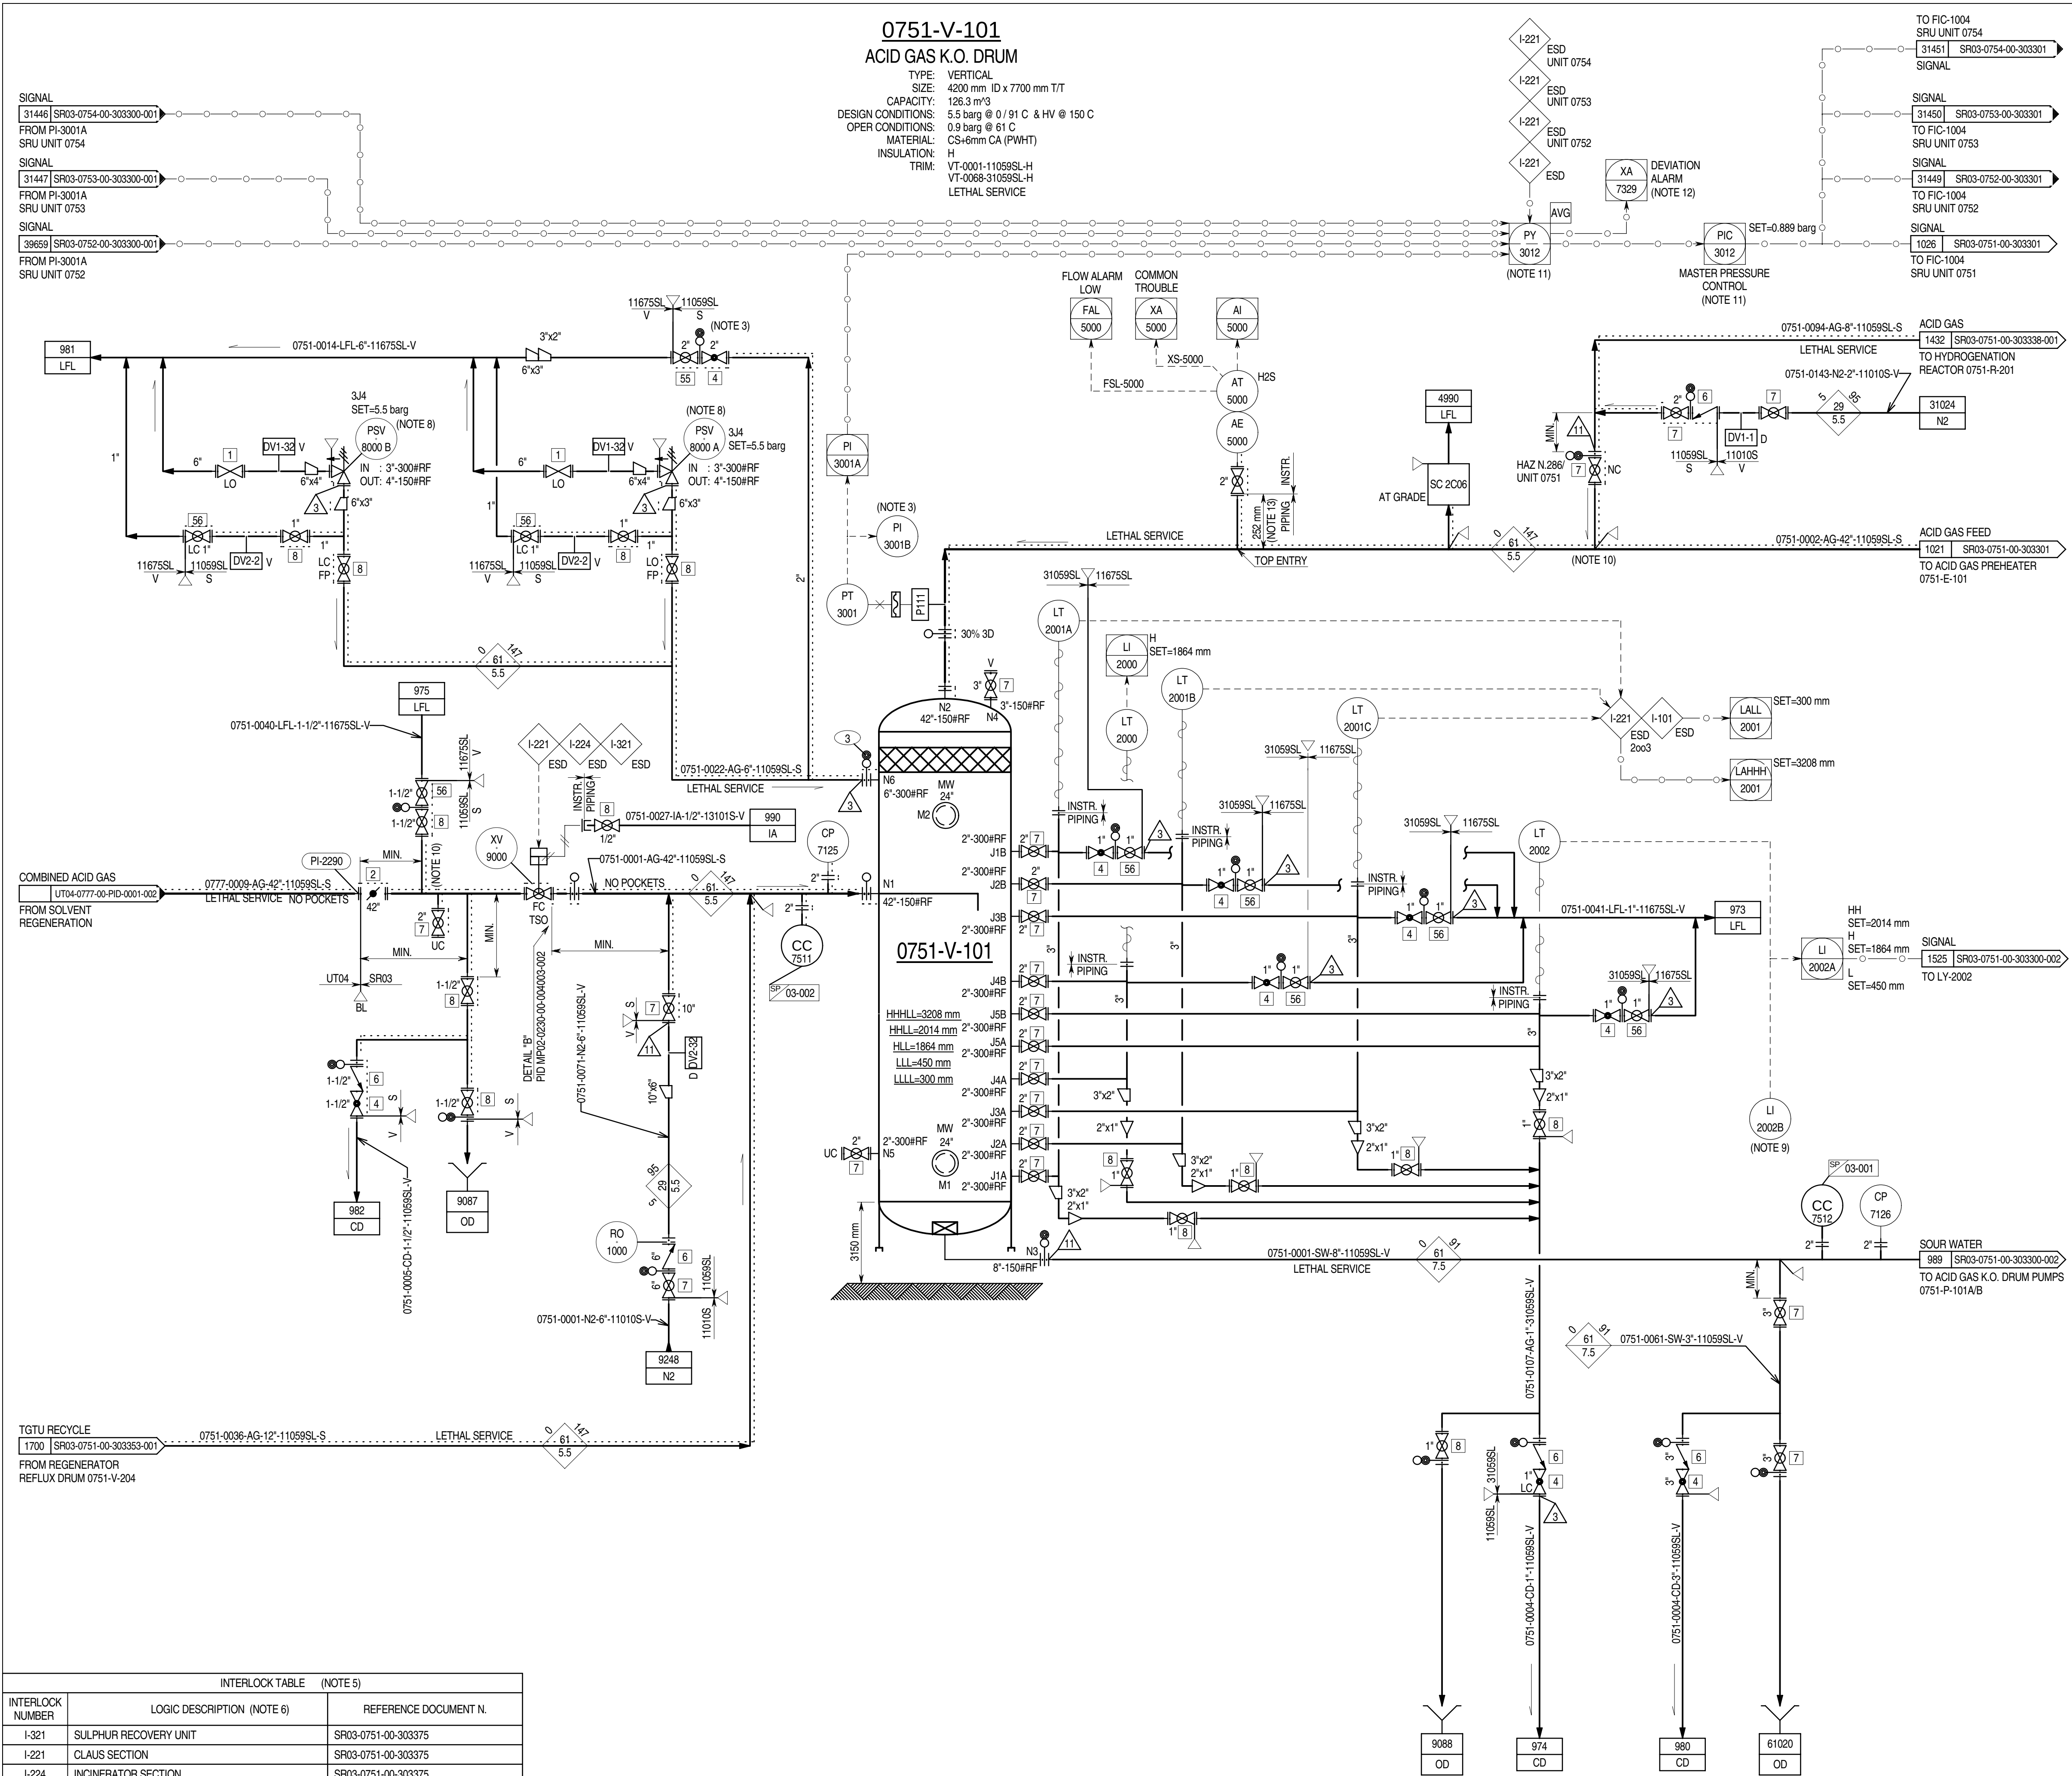

RATED FLOW:	75.0 m3/hr
DIFFERENTIAL HEAD:	37.5 m
SG @ OP TEMP:	0.982 @ 61.0 C
SUCTION PRESSURE:	1.2 barg
DISCHARGE PRESSURE:	4.8 barg
DESIGN TEMPERATURE:	0/191 C & HV @ 150 C
MATERIAL:	DUPLEX 2205
DRIVER:	15.0 kW
SPEED:	2930 rpm
TRIM:	---

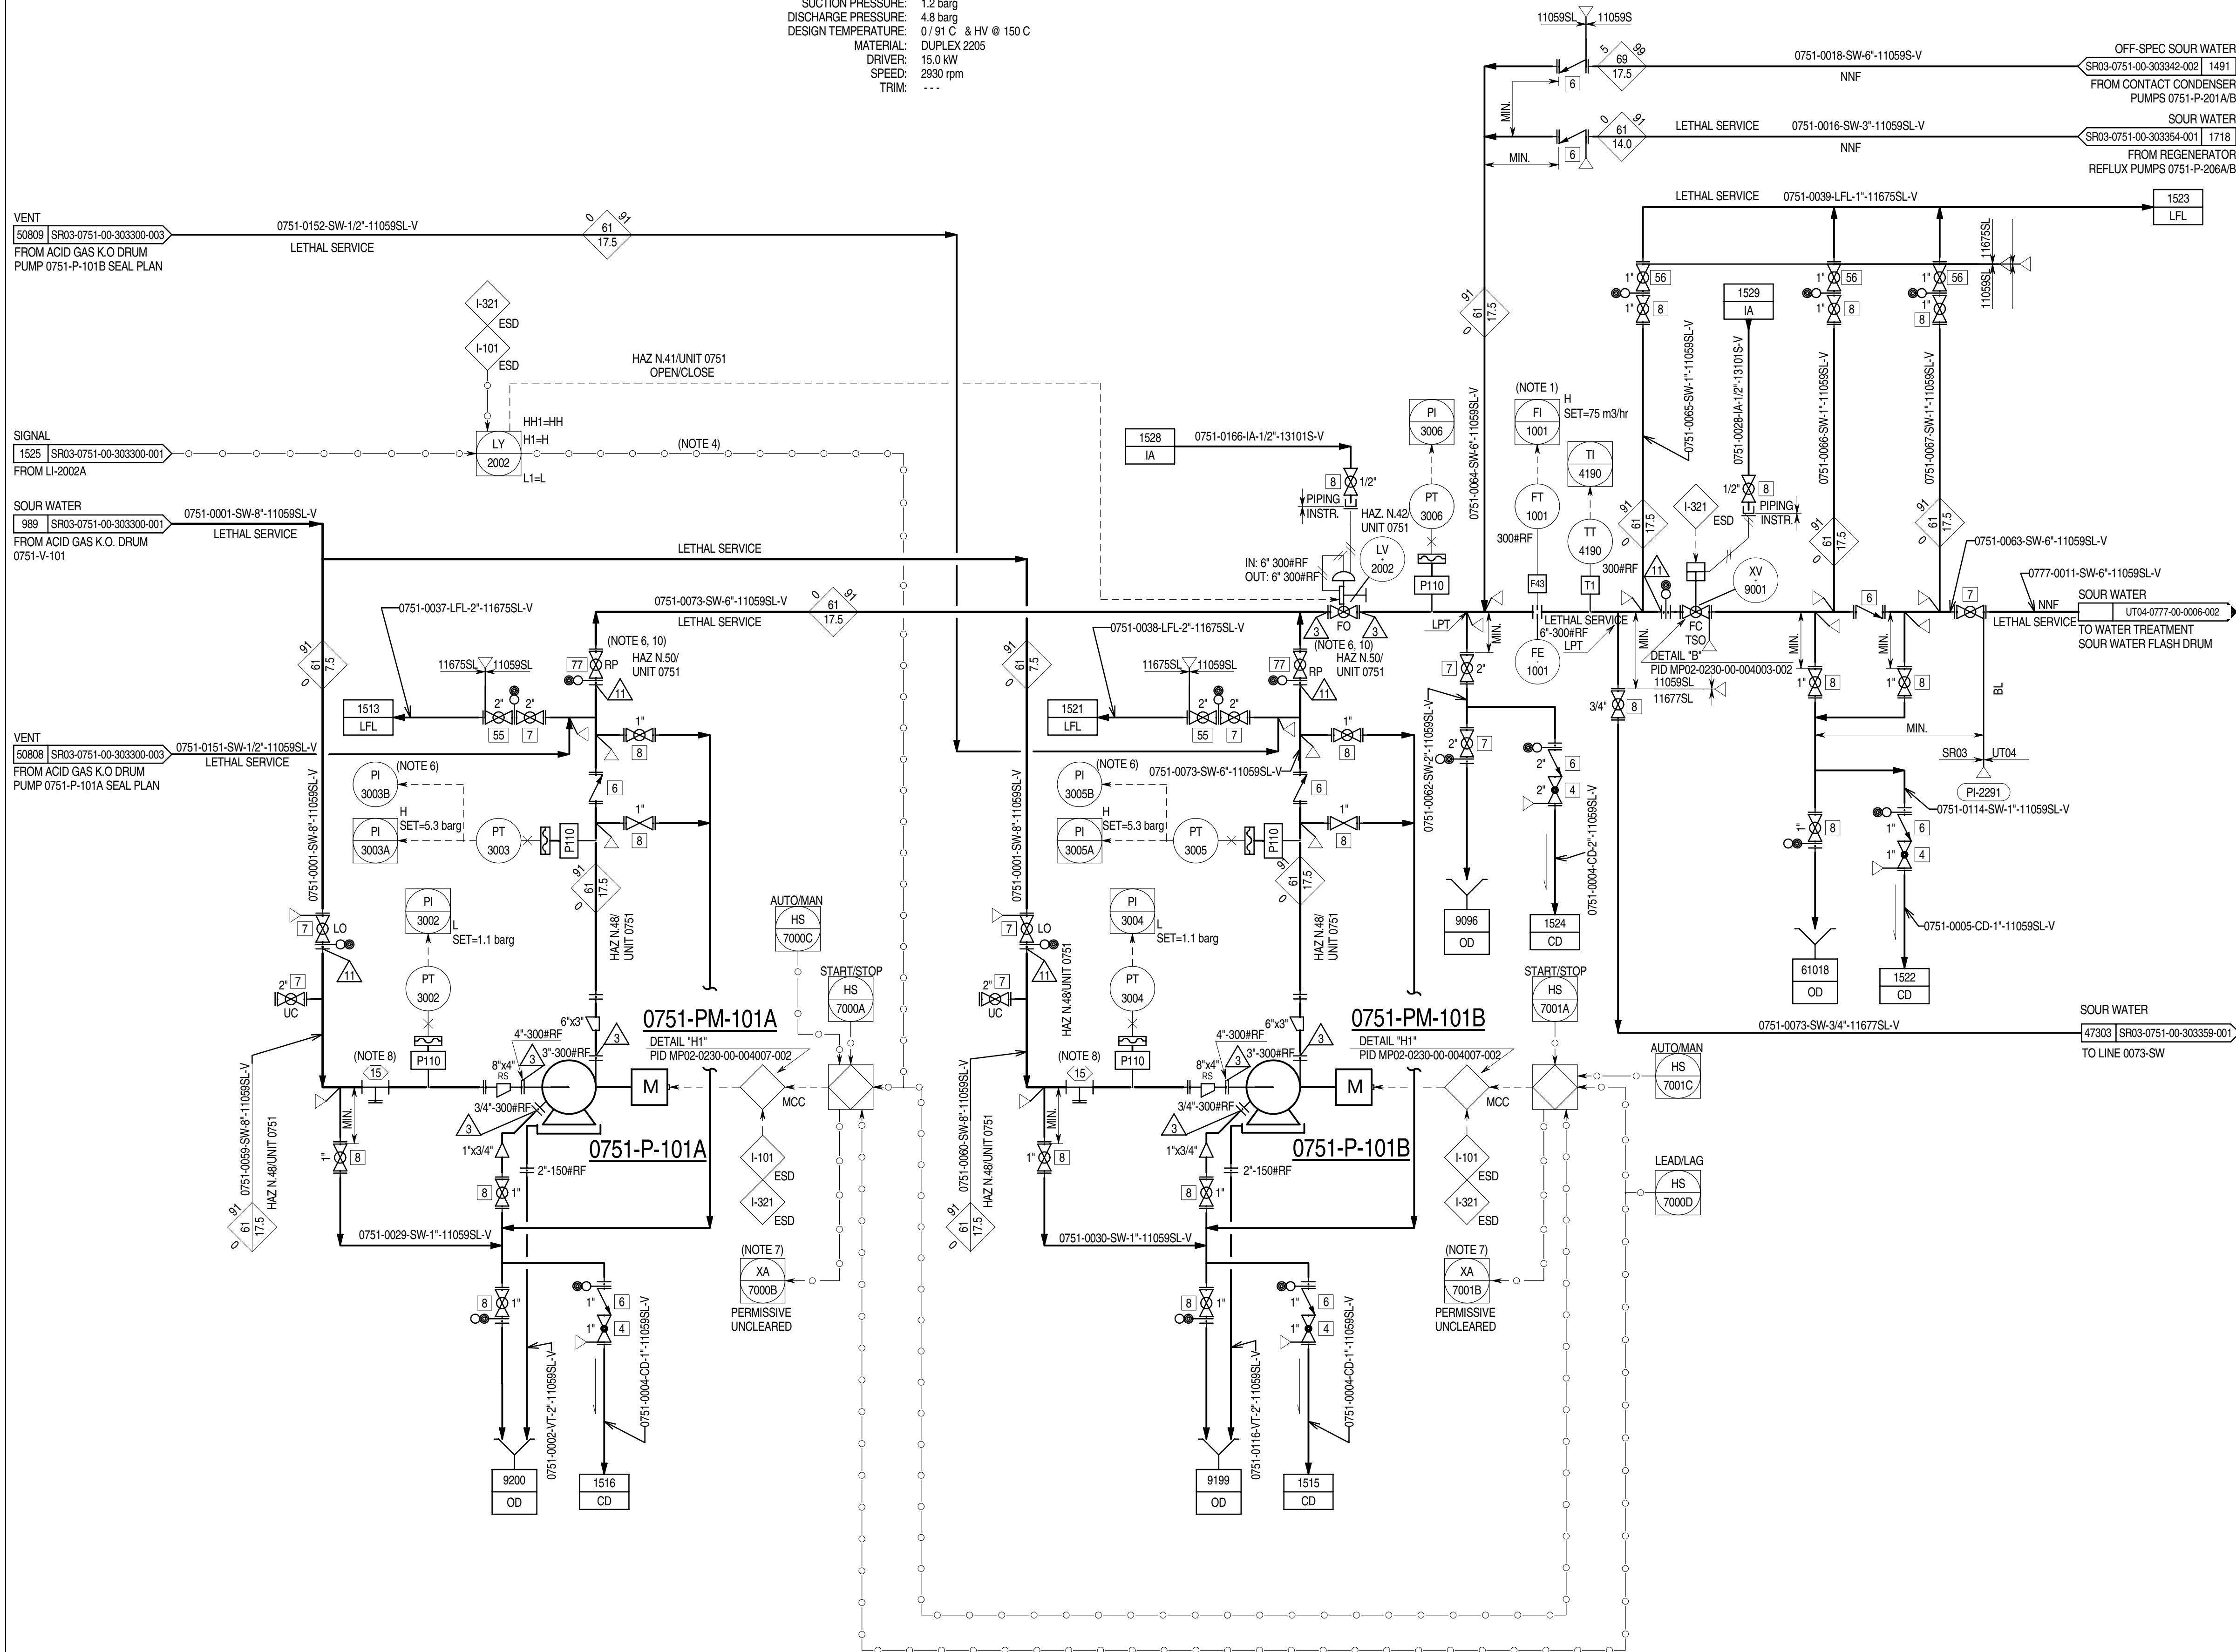

INTERLOCK TABLE (NOTE 2)		
INTERLOCK NUMBER	LOGIC DESCRIPTION (NOTE 3)	REFERENCE DOCUMENT N.
I-321	SULPHUR RECOVERY UNIT	SR03-0751-00-303375
I-101	ACID GAS KO DRUM	SR03-0751-00-303375

UTILITY REFERENCE TABLE		
IA	DRW. N°.	SR03-0751-00-PID-362305
CD	DRW. N°.	SR03-0751-00-PID-362306
OD	DRW. N°.	SR03-0751-00-PID-362307
LFL	DRW. N°.	SR03-0751-00-PID-362313

Z1	04-11-14	IAB	ISSUED FOR AS BUILT	PCA	MAR	ASP
2.1D	18-04-14	IFC	ISSUED FOR CONSTRUCTION	PCA	MAR	ASP
2.1C	01-05-13	IFC	ISSUED FOR CONSTRUCTION	RL	CN	MZ
2.1B	06-08-12	IFC	ISSUED FOR CONSTRUCTION	DSC	CBR	SIN
2	02-12-11	IFC	ISSUED FOR CONSTRUCTION	DSC	CBR	SIN
1	28-07-11	IFCH	ISSUED FOR CONSTRUCTION WITH HOLDS	DSC	CBR	SIN
0	15-02-11	IFD	ISSUED CLIENT COMMENTS INCORPORATED	BSC	LMA	SIN
B1	30-09-10	ICR	ISSUED FOR CLIENT REVIEW	BSC	LMA	SIN
REV	DATE	STATUS	STATUS DESCRIPTION	BY	CKD	APP.

COMPANY:

Abu Dhabi Gas Development Co. Ltd.



CONTRACTOR:

 **saipem**

JOB No. 032090

PROJECT: SHAH GAS DEVELOPMENT (SGD) PROJECT


AGREEMENT No. 13525001

<u>DRAWING TITLE:</u> PIPING & INSTRUMENT DIAGRAM UNIT 0751 SULPHUR RECOVERY AND TAIL GAS TREATING UNIT	
EQUIPMENT DESCRIPTION	ACID GAS KO DRUM PUMPS
TAGITEM No.	0751-P-101A / B

CONTRACTOR DRG. No.		751-GD-B-303300		REV. Z1
COMPANY DRG. No.		SR03-0751-00-303300-002		
SCALE:	SIZE:	A1	DOC. CLASS: 1	


THIS DOCUMENT IS THE PROPERTY OF ABU DHABI GAS DEVELOPMENT COMPANY LIMITED AND CONTAINS INFORMATION WHICH IS PROPRIETARY. THIS INFORMATION IS TO BE HELD IN CONFIDENCE. NO DISCLOSURE OR OTHER USE OF THIS DOCUMENT IS TO BE MADE WITHOUT THE PRIOR WRITTEN CONSENT OF ABU DHABI GAS DEVELOPMENT COMPANY LIMITED.

PLAN 11/53B FOR OH PUMPS

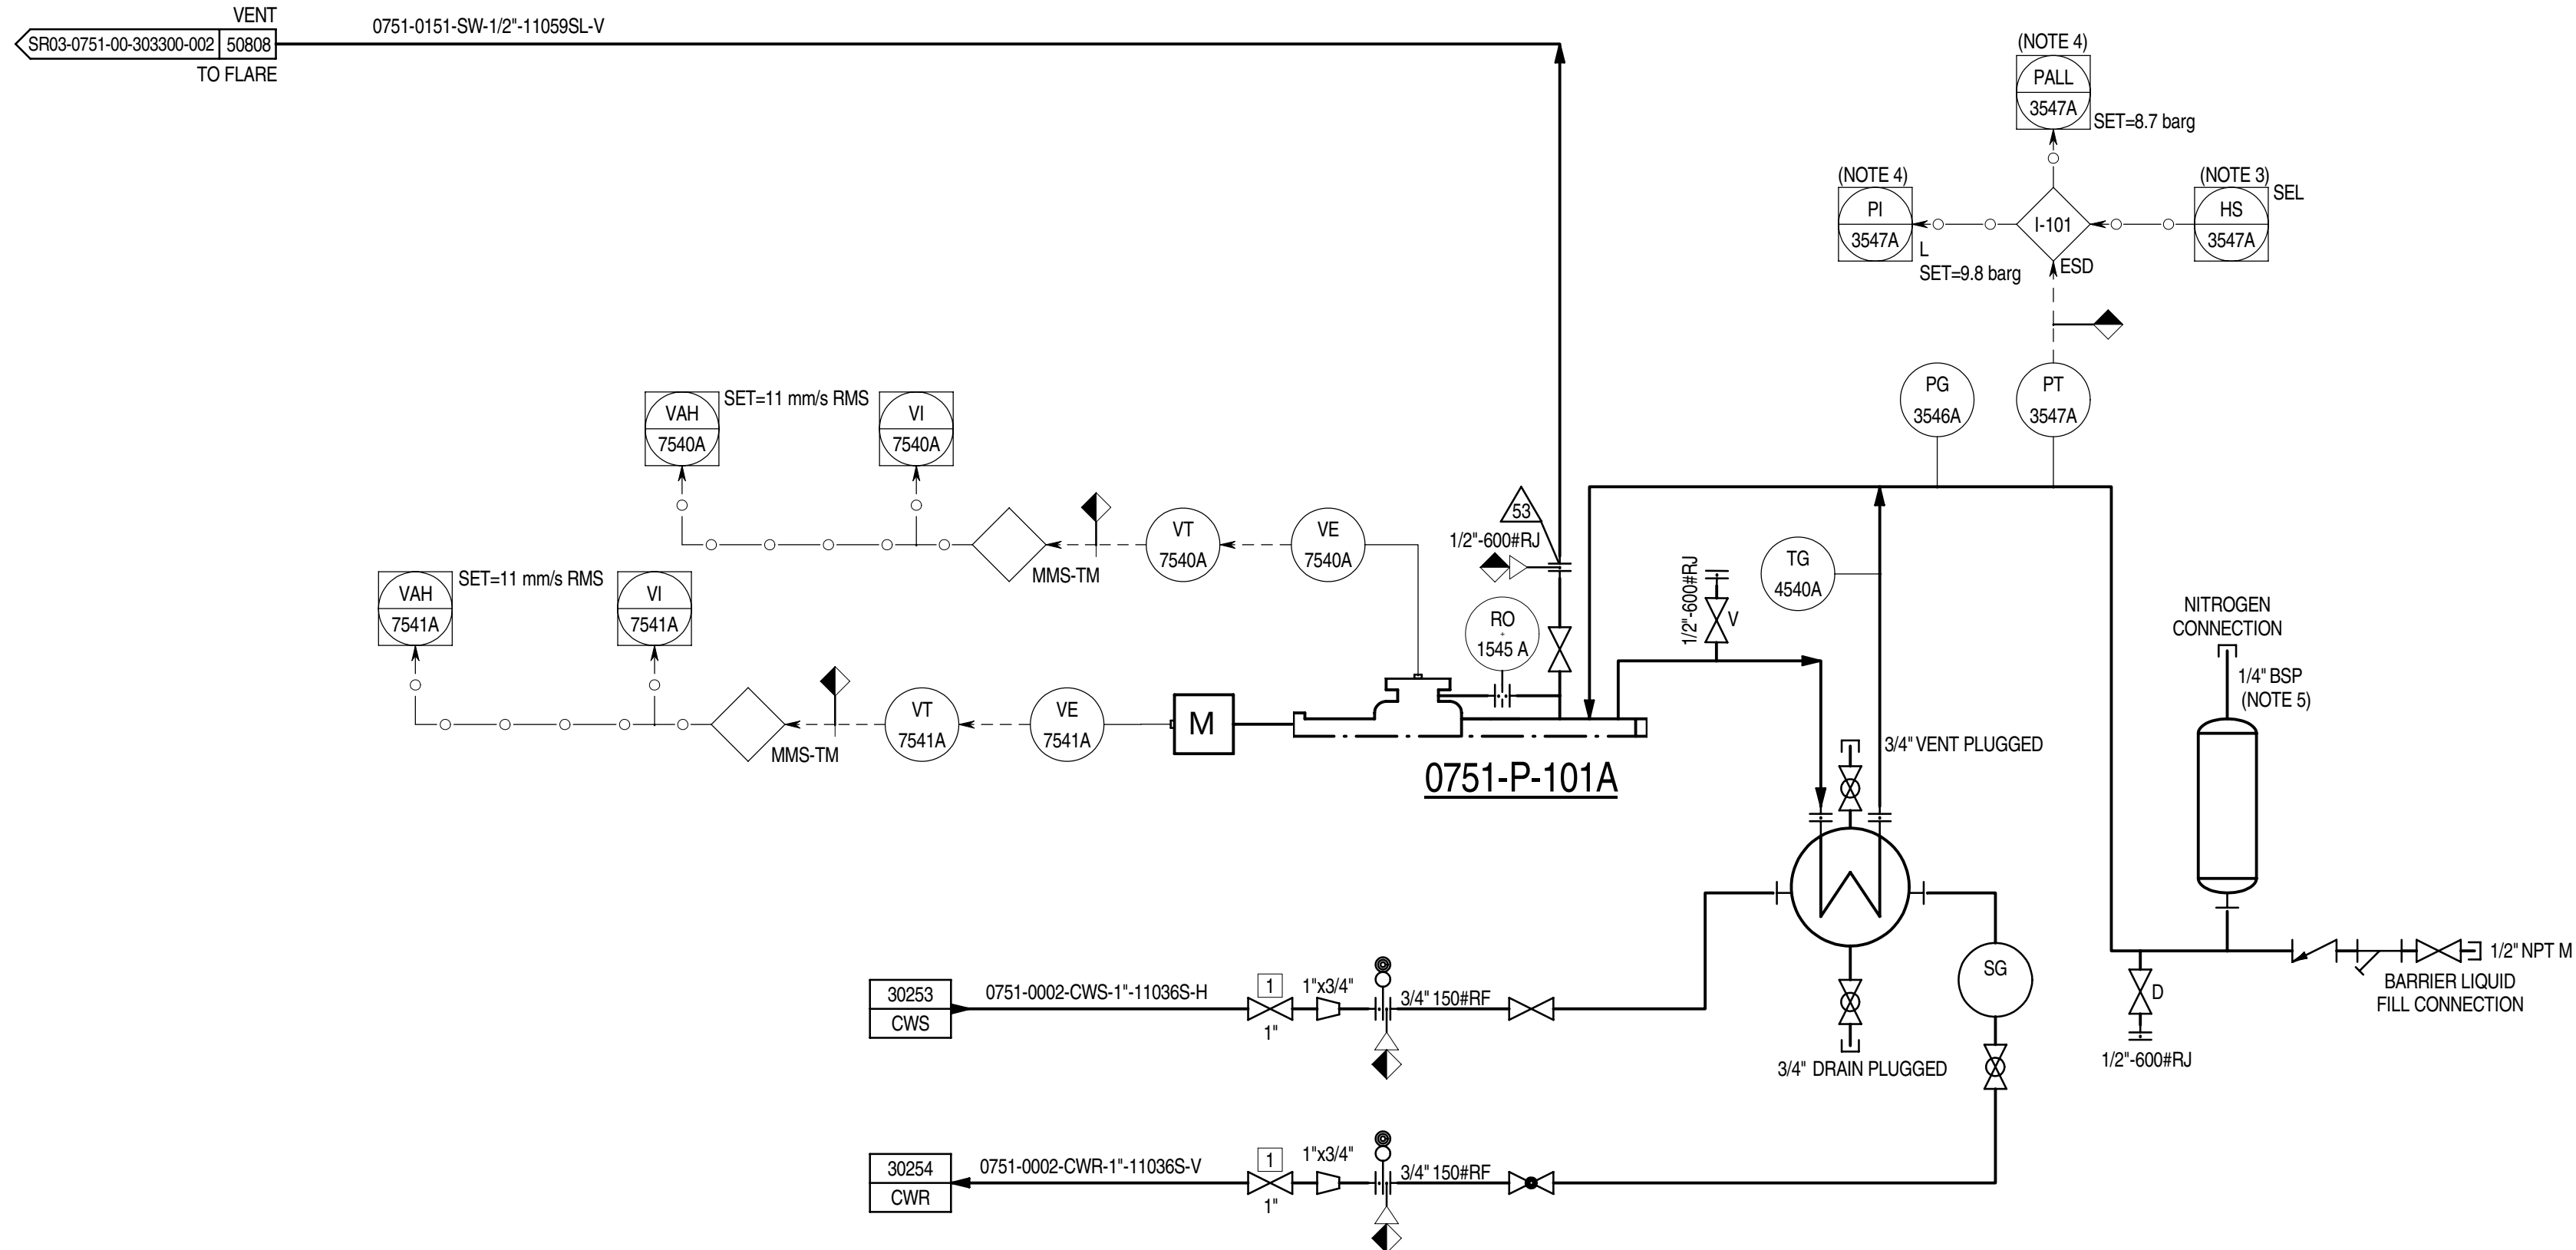

UTILITY REFERENCE TABLE	
CWS/CWR	DRW. N°. SR03-0751-00-PID-362308

PLAN 11/53B FOR OH PUMPS

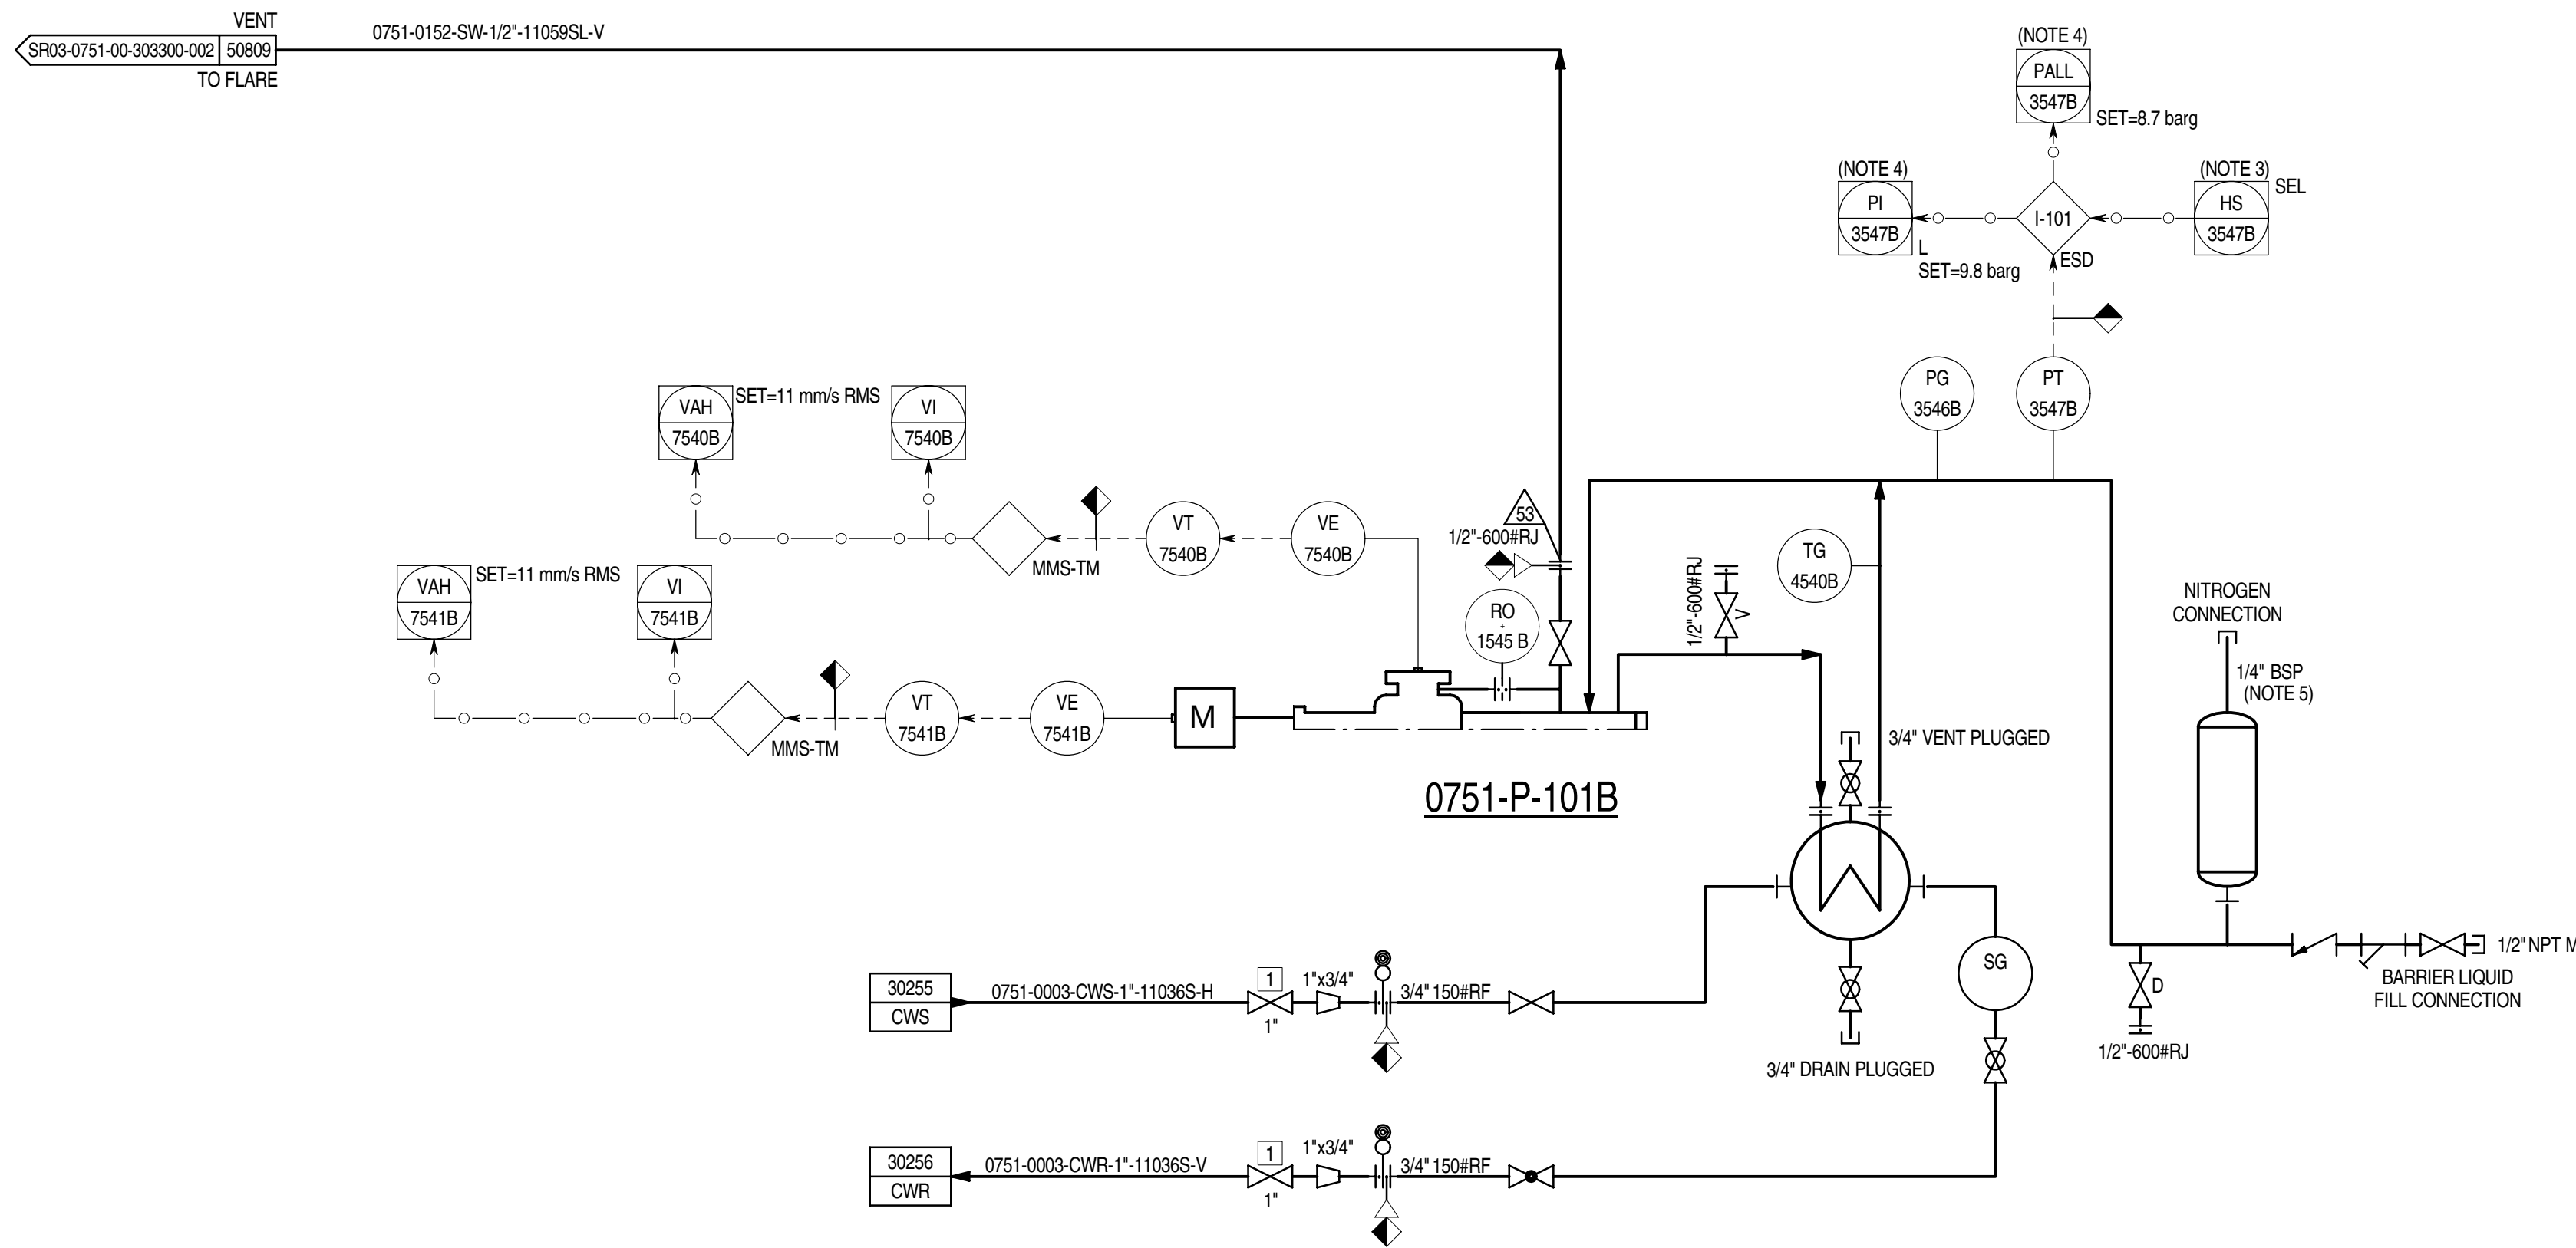

INTERLOCK TABLE (NOTE 1)		
INTERLOCK NUMBER	LOGIC DESCRIPTION (NOTE 2)	REFERENCE DOCUMENT N. (TDR)
I-101	ACID GAS KO DRUM	SR03-0751-00-303375

- GENERAL NOTES:**
- FOR STANDARD SYMBOLS, DETAILS, ABBREVIATIONS, SAMPLE CONNECTION TYPE, GENERAL NOTES & LEGEND SHEETS REFER TO DRAWING NO. MP02-0230-00-004000 TO 004015.
 - ALL INSTRUMENT TAG NUMBERS ON THIS P&ID INCLUDING PACKAGE UNITS ARE PREFIXED WITH UNIT NUMBER 0751 UNLESS OTHERWISE NOTED.
 - DELETED.
- NOTES:**
- INTERLOCK TABLE IS FOR REFERENCE ONLY. CAUSE AND EFFECT MATRIX SR03-0751-00-CC-30155 SHALL GOVERN.
 - REFER TO CAUSE AND EFFECT CHART FOR FULLY REPRESENTATION OF INTERLOCK INITIATORS AND ACTIONS.
 - SELECTOR TO ACTIVATE EITHER ALARM ONLY OR ALARM AND TRIP.
 - ALARM AND TRIP VALUES BY PUMP VENDOR.
 - BSP = BRITISH STANDARD PIPE.

Z1	04-11-14	IAB	ISSUED FOR AS BUILT	PCA	MAR	ASP
2.1D	18-04-14	IFC	ISSUED FOR CONSTRUCTION	PCA	MAR	ASP
2.1C	10-03-13	IFC	ISSUED FOR CONSTRUCTION	RL	CN	MZ
2.1B	06-08-12	IFC	ISSUED FOR CONSTRUCTION	DSC	CBR	SIN
2	02-12-11	IFC	ISSUED FOR CONSTRUCTION	DSC	CBR	SIN
1	28-07-11	IFCH	ISSUED FOR CONSTRUCTION WITH HOLDS	DSC	CBR	SIN
REV	DATE	STATUS	STATUS DESCRIPTION	BY	CKD	APP.

COMPANY:

Abu Dhabi Gas Development Co. Ltd.

CONTRACTOR:

JOB No. 032090

PROJECT:

SHAH GAS DEVELOPMENT (SGD) PROJECT
SHAH PROCESS PLANT

AGREEMENT No. 13525001

DRAWING TITLE: PIPING & INSTRUMENT DIAGRAM UNIT 0751 SULPHUR RECOVERY AND TAIL GAS TREATING UNIT	
EQUIPMENT DESCRIPTION	API PLAN 0751-P-101A/B AND VIBRATION MONITORING
TAGITEM No.	

CONTRACTOR DRG.No.	751-GD-B-303300	REV. Z1
COMPANY DRG.No.	SR03-0751-00-303300-003	
SCALE:	SIZE: A1 DOC. CLASS: 1	