



MANUALLY OPERATED VALVES

LINE AND PIPING SYMBOLS IDENTIFICATION

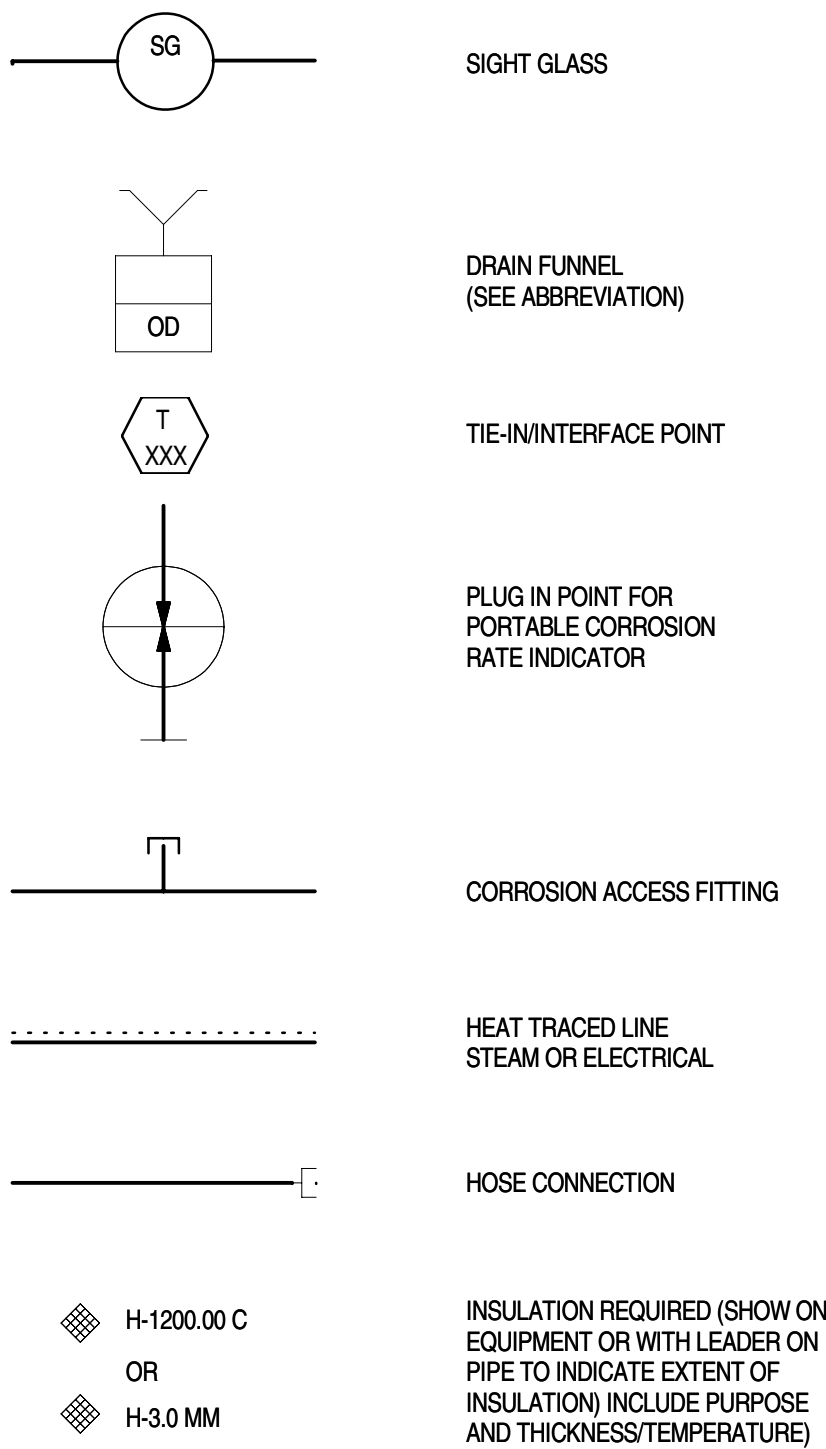

ABBREVIATIONS

- | | | | |
|-----|--|---------|--|
| AG | - INSULATION ACOUSTIC | AW | - MANWAY |
| AS | - ABOVE GROUND | MCR | - MAIN CONTROL CENTER |
| AS | - ANALYSER SHELTER | MIN | - MINIMUM |
| BD | - BLOW DOWN | MOV | - MOTOR OPERATED VALVE |
| BL | - BATTERY LIMIT | MVC | - MULTI VARIABLE CONTROLLER |
| BDL | - BOTTOM TAN LINE | N | - NONE |
| BV | - BALL VALVE | NC | - NORMALLY CLOSED |
| C | - INSULATION COLD | NLL | - NORMAL LIQUID LEVEL |
| CC | - CONTRACTOR/VENDOR | NNF | - NORMALLY NO FLOW |
| CC | - CORROSION COUPON AND CORROSION PROBE | NO | - NORMALLY OPEN |
| CD | - CLOSED DRAIN | O | - OILY WATER DRAIN |
| CI | - CAST IRON | OD | - OPEN DRAIN |
| CH | - CHECK VALVE | OV | - OPERATING VALVE |
| CO | - CHAIN OPERATED | PIV | - POST INDICATOR VALVE |
| CS | - CARBON STEEL | PL | - PLUG VALVE |
| DCB | - DOUBLE BLOCK AND BLEED | PLC | - PROGRAMMABLE LOGIC CONTROLLER |
| DBS | - DISTRIBUTED CONTROL SYSTEM | PP OR P | - INSULATION SAFETY (PERSONNEL PROTECTION) |
| DP | - DESIGN PRESSURE | R | - REJECT WATER DRAIN |
| DE | - DESIGN TEMPERATURE | RCR | - REFINERY CONTROL ROOM (RUW/IAS) |
| EL | - ELEVATION | R | - REDUCED PORT |
| ESD | - EMERGENCY SHUT DOWN SYSTEM | RTU | - REMOTE TERMINAL UNIT |
| FF | - FAIL CLOSED | RS | - REMOVABLE SPOOL |
| FD | - FLEX DISC VALVE | SC | - SAMPLE CONNECTION |
| FF | - FLAT FACE | SCADA | - SUPERVISORY CONTROL AND DATA ACQUISITION |
| FI | - FAIL INTERMEDIATE | SDS | - SHUTDOWN SYSTEM |
| FL | - FAIL LOCKED | SGS | - SIGHT GLASS |
| FO | - FAIL OPEN | SL | - STEAM LANCE |
| FP | - FULL PORT | SMC | - SUPERVISORY MONITORING CONTROL SYSTEM |
| FSP | - FIRE AND SAFETY PANEL | SP | - SET POINT |
| GL | - GLOBE VALVE | SP GR | - SPECIFIC GRAVITY |
| HS | - INSULATION HOT | SS | - SOFT SEAT VALVE |
| HDR | - HEADER | T | - TIE-IN |
| HH | - HAND HOLE | TS | - GENERAL TWIN SEAL |
| HT | - HIGH TEMPERATURE | TST | - TIGHT SHUT OFF |
| IAS | - INSTRUMENT AIR SUPPLY | TSO | - TANGENT TO TANGENT |
| ID | - INTERNAL DIAMETER | UC | - UTILITY CONNECTION |
| IES | - INSTRUMENT EQUIPMENT SHELTER | UG | - UNDERGROUND |
| IP | - INTERFACE POINT | (V) | - FURNISHED BY VENDOR |
| LC | - LOCK CLOSED | VT | - VESSEL TRIM |
| LO | - LOCK OPEN | | |
| LP | - LOW PRESSURE | | |
| LPT | - LOW POINT | | |

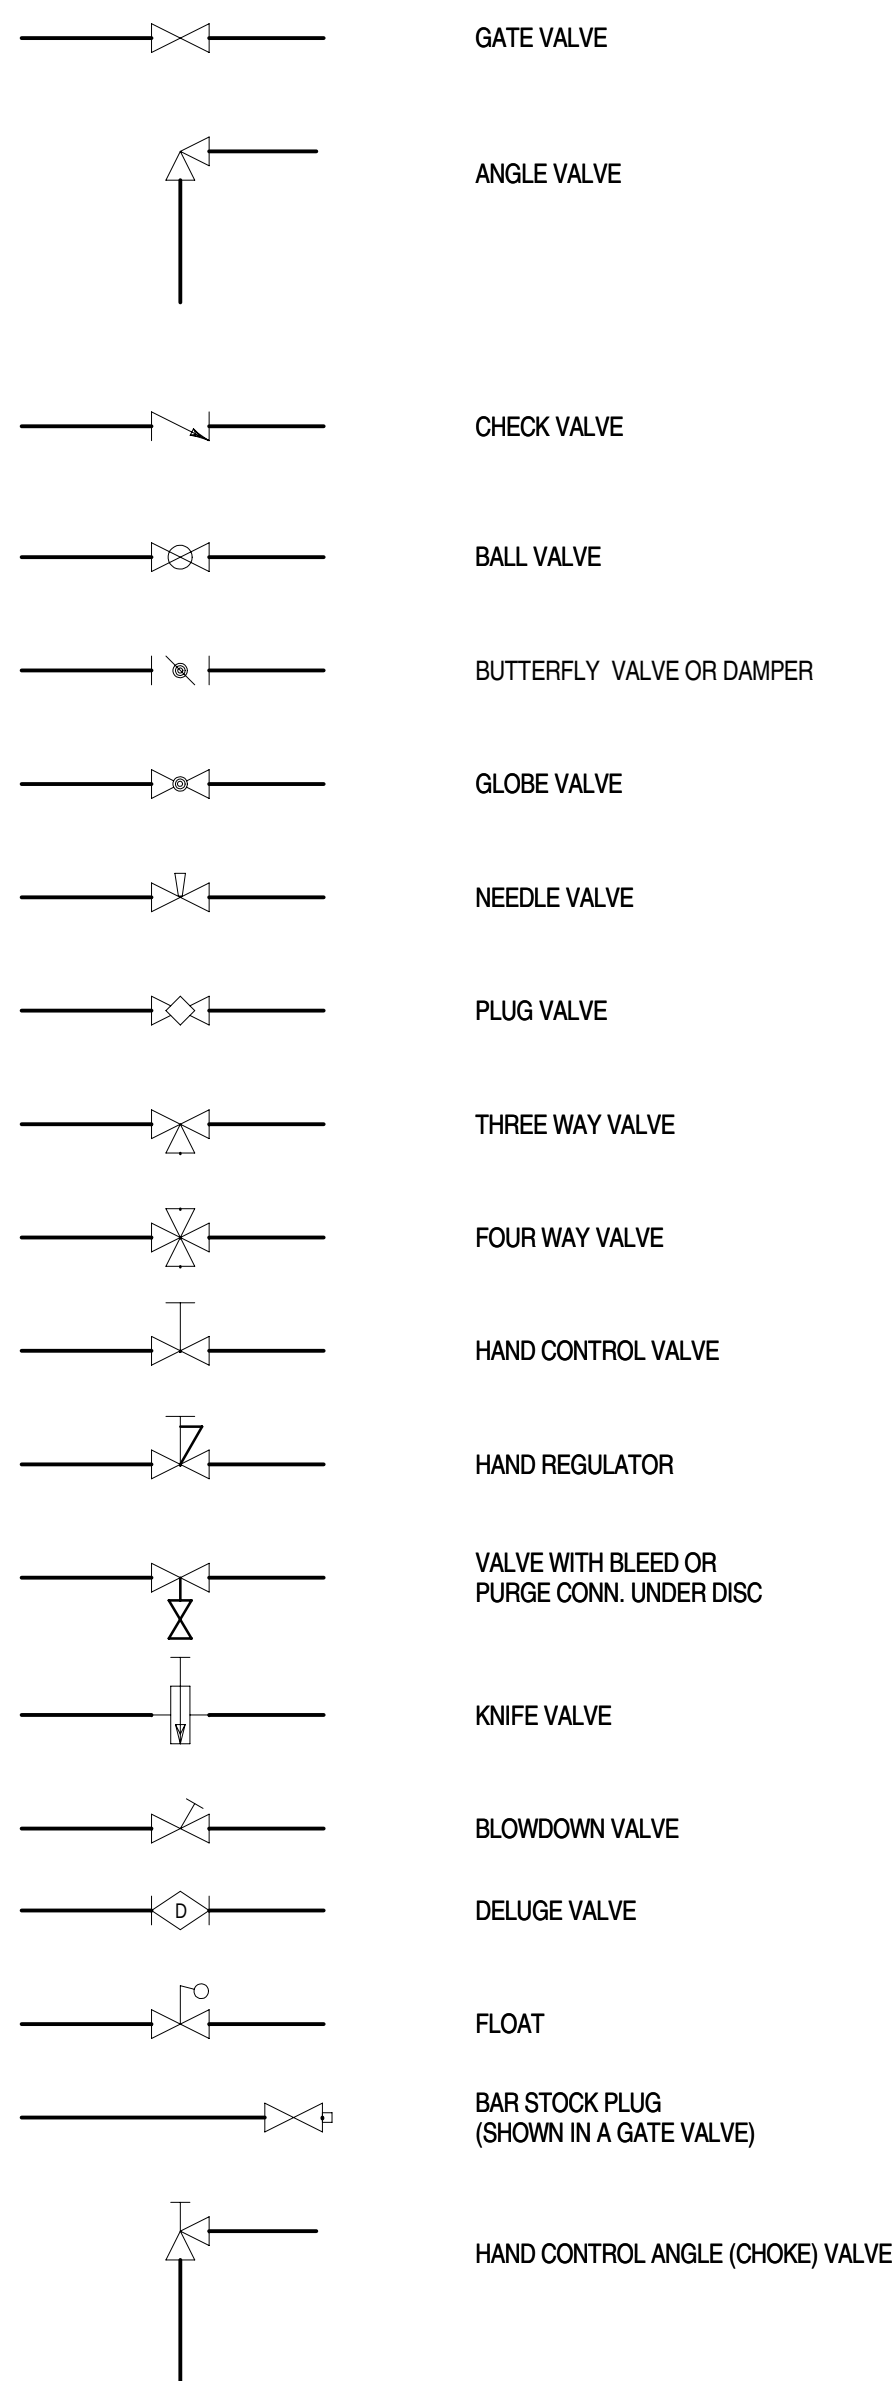

 VENDOR
CONTRACTOR

GENERAL NOTES:

Z1	14/08/2014	IAB	ISSUE FOR AS BUILT	F.T.	N.F.	A.N.
03	30/05/2012	RFC	REISSUE FOR CONSTRUCTION	F.T.	D.L.	A.N.
02	30/06/2011	IFC	FINAL ISSUE FOR CONSTRUCTION	F.T.	D.L.	A.N.
01	02/03/2011	IFC	FIRST ISSUE FOR CONSTRUCTION	F.T.	D.L.	A.N.
00	29/11/2010	IFD	ISSUE FOR DESIGN	F.T.	N.F.	A.N.
REV	DATE	STATUS	STATUS DESCRIPTION	BY	CKD	APP

COMPANY

Abu Dhabi Gas Development Co. Ltd.



CONTRACTOR



saipem

JOB No. 032088

PROJECT:

SHAH GAS DEVELOPMENT (SGD) PROJECT

AGREEMENT No. 13525201

DRAWING TITLE: PIPING & INSTRUMENT DIAGRAM UNIT 0500

CONTRACTOR DRG.No.		500-GD-B-08030		REV. Z1
COMPANY DRG.No.		PP05-0500-00-PID-8030		
SCALE:	NONE	SIZE:	A1	