


THIS DOCUMENT IS THE PROPERTY OF ABU DHABI GAS DEVELOPMENT COMPANY LIMITED AND CONTAINS INFORMATION WHICH IS PROPRIETARY. THIS INFORMATION IS TO BE HELD IN CONFIDENCE. NO DISCLOSURE OR OTHER USE OF THIS DOCUMENT IS TO BE MADE WITHOUT THE PRIOR WRITTEN CONSENT OF ABU DHABI GAS DEVELOPMENT COMPANY LIMITED.

INSTRUMENT IDENTIFICATION																																																																																																																					
* FIRST LETTER PROCESS VARIABLE OR ACTUATION <table><tr><td>A ANALYSIS</td><td>O UNCLASSIFIED</td></tr><tr><td>B BURNER FLAME</td><td>P PRESSURE/VACUUM</td></tr><tr><td>C CONDUCTIVITY (ELECT.)</td><td>PD PRESSURE DIFFERENTIAL</td></tr><tr><td>D DENSITY SP GR</td><td>Q QUANTITY/NUMBER</td></tr><tr><td>E VOLTAGE (EMF)/ELECT.</td><td>R RADIOACTIVITY/REMOTE/RESISTANCE</td></tr><tr><td>F FLOW RATE</td><td>S SPEED/FREQUENCY</td></tr><tr><td>FQ FLOW QUANTITY</td><td>T TEMPERATURE</td></tr><tr><td>FF FLOW RATIO</td><td>TD TEMPERATURE DIFFERENTIAL</td></tr><tr><td>G GAGING (DIMENSIONAL)</td><td>U MULTIVARIABLE</td></tr><tr><td>H HAND (MANUALLY) (ON/OFF)</td><td>V VIBRATION</td></tr><tr><td>I CURRENT AMPS</td><td>W WEIGHT/FORCE</td></tr><tr><td>J POWER WATTS</td><td>X SAFETY</td></tr><tr><td>K TIME</td><td>Y (UNCLASSIFIED) SECOND LETTER RELAY</td></tr><tr><td>L LEVEL</td><td>Z POSITION</td></tr><tr><td>M MOISTURE HUMIDITY</td><td></td></tr><tr><td>N PROCESS TRAP</td><td></td></tr></table> * SELECT LETTER FROM TABLE ABOVE <table><tr><td>*A</td><td>* ALARM</td></tr><tr><td>*AH</td><td>* ALARM HIGH</td></tr><tr><td>*AL</td><td>* ALARM LOW</td></tr><tr><td>*C</td><td>* CONTROLLER OR CONTROL</td></tr><tr><td>*CV</td><td>* CONTROLLER VALVE (SELF ACTUATED)</td></tr><tr><td>*DW</td><td>* DEPRESSURIZATION VALVE</td></tr><tr><td>*E</td><td>* ELEMENT</td></tr><tr><td>*G</td><td>* GLASS OR GAUGE</td></tr><tr><td>*I</td><td>* INDICATOR</td></tr><tr><td>*IC</td><td>* INDICATING CONTROLLER-HARDWARE LOCATED IN INSTRUMENT EQUIPMENT SHELTER (IES)</td></tr><tr><td>*J</td><td>* SCAN</td></tr><tr><td>*O</td><td>* ORIFICE RESTRICTION</td></tr><tr><td>*P</td><td>* POINT (TEST CONNECTION)</td></tr><tr><td>*Q</td><td>* TOTALIZE INTEGRATE</td></tr><tr><td>*R</td><td>* RECORDER</td></tr><tr><td>*RC</td><td>* RECORDER CONTROLLER</td></tr><tr><td>*S</td><td>* SWITCH</td></tr><tr><td>*SH</td><td>* SWITCH HIGH</td></tr><tr><td>*SL</td><td>* SWITCH LOW</td></tr><tr><td>*SV</td><td>* SAFETY VALVE</td></tr><tr><td>*T</td><td>* TRANSMITTER</td></tr><tr><td>*V</td><td>* VALVE</td></tr><tr><td>*W</td><td>* WELL OR PROBE</td></tr><tr><td>*M</td><td>* MONITOR</td></tr><tr><td>*SO</td><td>* SWITCH OPEN</td></tr><tr><td>*SC</td><td>* SWITCH CLOSED</td></tr><tr><td>*HSO</td><td>* HAND SWITCH OPEN</td></tr><tr><td>*HSC</td><td>* HAND SWITCH CLOSED</td></tr><tr><td>*ZSO</td><td>* POSITION SWITCH OPEN</td></tr><tr><td>*ZSC</td><td>* POSITION SWITCH CLOSED</td></tr><tr><td>*ZLO</td><td>* POSITION LIGHT OPEN</td></tr><tr><td>*ZLC</td><td>* POSITION LIGHT CLOSED</td></tr><tr><td></td><td>LOCAL HMI</td></tr><tr><td>*Y</td><td>SOLENOID OPERATED VALVE</td></tr><tr><td>DVC</td><td>DIGITAL VALVE CONTROLLER</td></tr><tr><td>TT</td><td>MOTOR RESISTANCE THERMAL DETECTORS</td></tr><tr><td>RTD</td><td></td></tr><tr><td></td><td>EMERGENCY P/B HARDWIRED DIRECT TO MAIN FIRE & SAFETY PANEL (PROTECTED RED MUSHROOM)</td></tr><tr><td>P</td><td>PURGE</td></tr><tr><td></td><td>CONTROL STATION -----</td></tr><tr><td></td><td>CONTROL STATION SIGNAL FUNCTION ----- BY ELECT.</td></tr><tr><td></td><td>SELECTOR SWITCH (MULTI-CIRCUITS) -----</td></tr></table>		A ANALYSIS	O UNCLASSIFIED	B BURNER FLAME	P PRESSURE/VACUUM	C CONDUCTIVITY (ELECT.)	PD PRESSURE DIFFERENTIAL	D DENSITY SP GR	Q QUANTITY/NUMBER	E VOLTAGE (EMF)/ELECT.	R RADIOACTIVITY/REMOTE/RESISTANCE	F FLOW RATE	S SPEED/FREQUENCY	FQ FLOW QUANTITY	T TEMPERATURE	FF FLOW RATIO	TD TEMPERATURE DIFFERENTIAL	G GAGING (DIMENSIONAL)	U MULTIVARIABLE	H HAND (MANUALLY) (ON/OFF)	V VIBRATION	I CURRENT AMPS	W WEIGHT/FORCE	J POWER WATTS	X SAFETY	K TIME	Y (UNCLASSIFIED) SECOND LETTER RELAY	L LEVEL	Z POSITION	M MOISTURE HUMIDITY		N PROCESS TRAP		*A	* ALARM	*AH	* ALARM HIGH	*AL	* ALARM LOW	*C	* CONTROLLER OR CONTROL	*CV	* CONTROLLER VALVE (SELF ACTUATED)	*DW	* DEPRESSURIZATION VALVE	*E	* ELEMENT	*G	* GLASS OR GAUGE	*I	* INDICATOR	*IC	* INDICATING CONTROLLER-HARDWARE LOCATED IN INSTRUMENT EQUIPMENT SHELTER (IES)	*J	* SCAN	*O	* ORIFICE RESTRICTION	*P	* POINT (TEST CONNECTION)	*Q	* TOTALIZE INTEGRATE	*R	* RECORDER	*RC	* RECORDER CONTROLLER	*S	* SWITCH	*SH	* SWITCH HIGH	*SL	* SWITCH LOW	*SV	* SAFETY VALVE	*T	* TRANSMITTER	*V	* VALVE	*W	* WELL OR PROBE	*M	* MONITOR	*SO	* SWITCH OPEN	*SC	* SWITCH CLOSED	*HSO	* HAND SWITCH OPEN	*HSC	* HAND SWITCH CLOSED	*ZSO	* POSITION SWITCH OPEN	*ZSC	* POSITION SWITCH CLOSED	*ZLO	* POSITION LIGHT OPEN	*ZLC	* POSITION LIGHT CLOSED		LOCAL HMI	*Y	SOLENOID OPERATED VALVE	DVC	DIGITAL VALVE CONTROLLER	TT	MOTOR RESISTANCE THERMAL DETECTORS	RTD			EMERGENCY P/B HARDWIRED DIRECT TO MAIN FIRE & SAFETY PANEL (PROTECTED RED MUSHROOM)	P	PURGE		CONTROL STATION -----		CONTROL STATION SIGNAL FUNCTION ----- BY ELECT.		SELECTOR SWITCH (MULTI-CIRCUITS) -----
A ANALYSIS	O UNCLASSIFIED																																																																																																																				
B BURNER FLAME	P PRESSURE/VACUUM																																																																																																																				
C CONDUCTIVITY (ELECT.)	PD PRESSURE DIFFERENTIAL																																																																																																																				
D DENSITY SP GR	Q QUANTITY/NUMBER																																																																																																																				
E VOLTAGE (EMF)/ELECT.	R RADIOACTIVITY/REMOTE/RESISTANCE																																																																																																																				
F FLOW RATE	S SPEED/FREQUENCY																																																																																																																				
FQ FLOW QUANTITY	T TEMPERATURE																																																																																																																				
FF FLOW RATIO	TD TEMPERATURE DIFFERENTIAL																																																																																																																				
G GAGING (DIMENSIONAL)	U MULTIVARIABLE																																																																																																																				
H HAND (MANUALLY) (ON/OFF)	V VIBRATION																																																																																																																				
I CURRENT AMPS	W WEIGHT/FORCE																																																																																																																				
J POWER WATTS	X SAFETY																																																																																																																				
K TIME	Y (UNCLASSIFIED) SECOND LETTER RELAY																																																																																																																				
L LEVEL	Z POSITION																																																																																																																				
M MOISTURE HUMIDITY																																																																																																																					
N PROCESS TRAP																																																																																																																					
*A	* ALARM																																																																																																																				
*AH	* ALARM HIGH																																																																																																																				
*AL	* ALARM LOW																																																																																																																				
*C	* CONTROLLER OR CONTROL																																																																																																																				
*CV	* CONTROLLER VALVE (SELF ACTUATED)																																																																																																																				
*DW	* DEPRESSURIZATION VALVE																																																																																																																				
*E	* ELEMENT																																																																																																																				
*G	* GLASS OR GAUGE																																																																																																																				
*I	* INDICATOR																																																																																																																				
*IC	* INDICATING CONTROLLER-HARDWARE LOCATED IN INSTRUMENT EQUIPMENT SHELTER (IES)																																																																																																																				
*J	* SCAN																																																																																																																				
*O	* ORIFICE RESTRICTION																																																																																																																				
*P	* POINT (TEST CONNECTION)																																																																																																																				
*Q	* TOTALIZE INTEGRATE																																																																																																																				
*R	* RECORDER																																																																																																																				
*RC	* RECORDER CONTROLLER																																																																																																																				
*S	* SWITCH																																																																																																																				
*SH	* SWITCH HIGH																																																																																																																				
*SL	* SWITCH LOW																																																																																																																				
*SV	* SAFETY VALVE																																																																																																																				
*T	* TRANSMITTER																																																																																																																				
*V	* VALVE																																																																																																																				
*W	* WELL OR PROBE																																																																																																																				
*M	* MONITOR																																																																																																																				
*SO	* SWITCH OPEN																																																																																																																				
*SC	* SWITCH CLOSED																																																																																																																				
*HSO	* HAND SWITCH OPEN																																																																																																																				
*HSC	* HAND SWITCH CLOSED																																																																																																																				
*ZSO	* POSITION SWITCH OPEN																																																																																																																				
*ZSC	* POSITION SWITCH CLOSED																																																																																																																				
*ZLO	* POSITION LIGHT OPEN																																																																																																																				
*ZLC	* POSITION LIGHT CLOSED																																																																																																																				
	LOCAL HMI																																																																																																																				
*Y	SOLENOID OPERATED VALVE																																																																																																																				
DVC	DIGITAL VALVE CONTROLLER																																																																																																																				
TT	MOTOR RESISTANCE THERMAL DETECTORS																																																																																																																				
RTD																																																																																																																					
	EMERGENCY P/B HARDWIRED DIRECT TO MAIN FIRE & SAFETY PANEL (PROTECTED RED MUSHROOM)																																																																																																																				
P	PURGE																																																																																																																				
	CONTROL STATION -----																																																																																																																				
	CONTROL STATION SIGNAL FUNCTION ----- BY ELECT.																																																																																																																				
	SELECTOR SWITCH (MULTI-CIRCUITS) -----																																																																																																																				
LOCAL MOUNTED INSTRUMENT LOCAL BOARD MOUNTED INSTRUMENT (*) DENOTES PANEL NO. INSTRUMENT MOUNTED BEHIND LOCAL CONTROL BOARD VISUAL DISPLAY (VDU) IN CENTRAL CONTROL ROOM DCS POINT NOT DISPLAYED INSTRUMENT MOUNTED IN LOCAL INSTRUMENT EQUIPMENT SHELTER (IES) INSTRUMENT WITH TWO SERVICES OR FUNCTIONS KEY SWITCH/PASSWORD PROTECTED NORMALLY ACCESSIBLE TO OPERATOR INDICATOR/ CONTROLLER/RECORDER OR ALARM POINT. USED TO INDICATE VIDEO DISPLAY DIGITAL CONTROLS IN DISTRIBUTED CONTROL SYSTEM SMC SYMBOL (WITH TELEMETRY) INSTRUMENT MOUNTED IN MAIN CONTROL ROOM ADVANCED PROCESS CONTROL (NOTE: WHERE FUNCTION IS NOT SELF EVIDENT, EXPLANATORY NOTE TO BE ADDED TO P&ID) LOCAL LAMP. LOCAL HORN																																																																																																																					

RELAY FUNCTION IDENTIFICATION																	
SEE LIST BELOW. MIN. **SIZE BOX LOCATED IN UPPER RIGHT HAND CORNER ONLY *RELAY = ANALOG/DIGITAL = INVERSE DERIVATIVE = DERIVATIVE OR RATES = HIGH SELECTOR = LOW SELECTOR = ADD = BIAS = DIVIDE = CHARACTERIZE = RAISE TO THE POWER = EXTRACT SQUARE ROOT = BOOST = ON-OFF = SOLENOID = DIFFERENCE = GAIN = REVERSE = MULTIPLY = INTEGRATE = (FOR INPUT OUTPUT OF THE FOLLOWING) = AVERAGE = MID SELECTOR <table><tr><th>DESIGNATION</th><th>SIGNAL</th></tr><tr><td>E</td><td>VOLTAGE</td></tr><tr><td>I</td><td>CURRENT</td></tr><tr><td>H</td><td>HYDRAULIC</td></tr><tr><td>O</td><td>ELECTROMAGNETIC</td></tr><tr><td></td><td>SONIC SIGNAL OR LIGHT BEAM</td></tr><tr><td>P</td><td>PNEUMATIC</td></tr><tr><td>R</td><td>RESISTANCE</td></tr></table> - DCS REDUNDANT INPUT AND OUTPUT CHANNEL LOGIC SYMBOLS INDICATES DWG. NUMBER LOGIC DIAGRAM ESD LOGIC SYMBOLS PROGRAMMABLE LOGIC CONTROLLER FIRE ALARM SYSTEM GAS DETECTION SYSTEM		DESIGNATION	SIGNAL	E	VOLTAGE	I	CURRENT	H	HYDRAULIC	O	ELECTROMAGNETIC		SONIC SIGNAL OR LIGHT BEAM	P	PNEUMATIC	R	RESISTANCE
DESIGNATION	SIGNAL																
E	VOLTAGE																
I	CURRENT																
H	HYDRAULIC																
O	ELECTROMAGNETIC																
	SONIC SIGNAL OR LIGHT BEAM																
P	PNEUMATIC																
R	RESISTANCE																

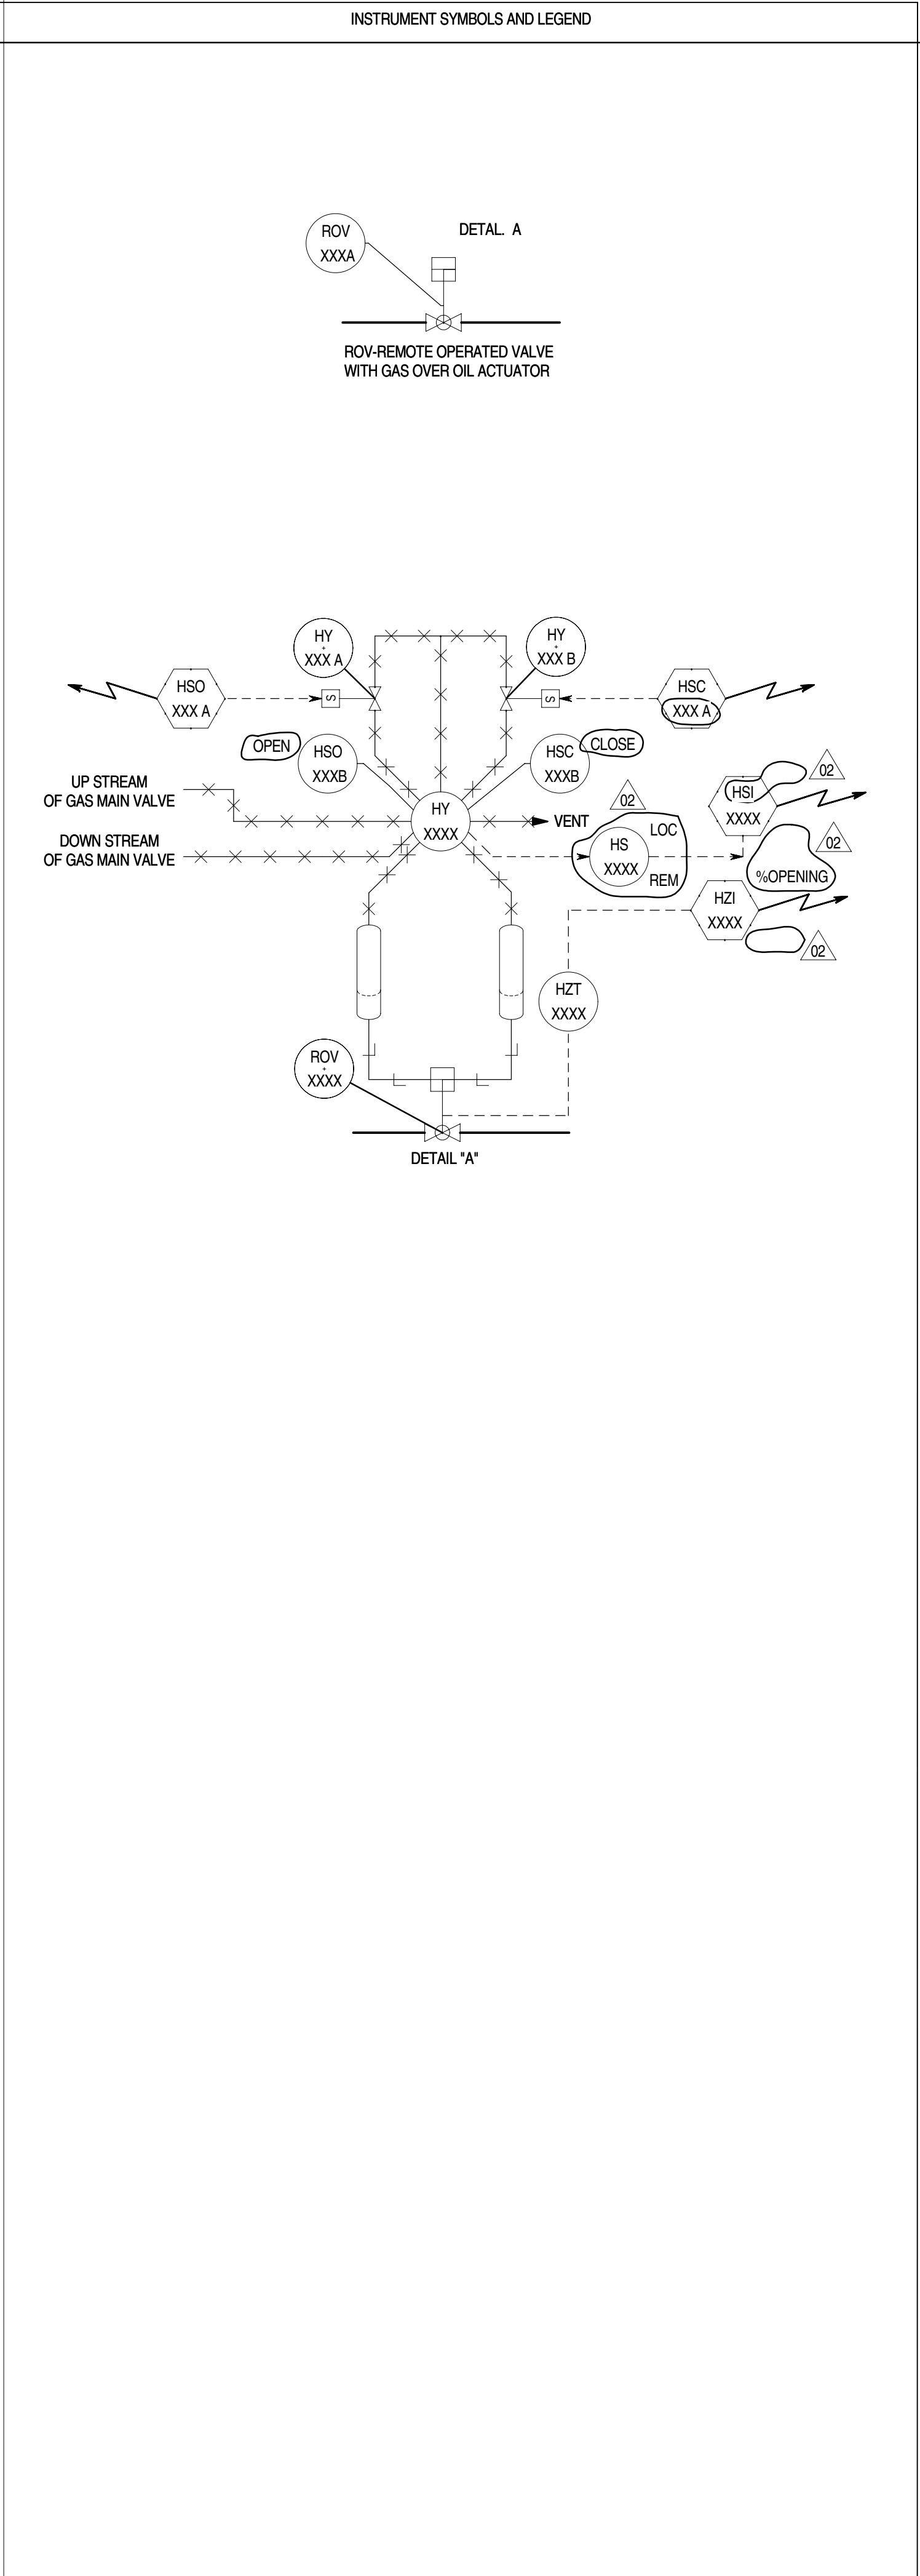

Z1	14/08/2014	IAB	ISSUE FOR AS BUILT	F.T.	N.F.	A.N.
02	30/06/2011	IFC	FINAL ISSUE FOR CONSTRUCTION	N.F.	D.L.	A.N.
01	02/03/2011	IFC	FIRST ISSUE FOR CONSTRUCTION	N.F.	D.L.	A.N.
00	29/11/2010	IFD	ISSUE FOR DESIGN	N.F.	N.F.	A.N.
B2	21/10/2010	IFH	ISSUE FOR HAZOP	N.F.	N.F.	A.N.
REV	DATE	STATUS	STATUS DESCRIPTION	BY	CKD	APP.

COMPANY:

Abu Dhabi Gas Development Co. Ltd.

الحصن للغاز
Al Hosn Gas

شركة أبو دهب للغاز
Abu Dhabi Gas Development Company Ltd.

CONTRACTOR:

eni saipem

JOB No. 022008

PROJECT: SHAH GAS DEVELOPMENT (SGD) PROJECT

AS BUILT

AGREEMENT No. 13525201

DRAWING TITLE: PIPING & INSTRUMENT DIAGRAM UNIT 0500

EQUIPMENT DESCRIPTION	INSTRUMENT SYMBOLS AND LEGEND - SHEET 2
TAGITEM No.	

CONTRACTOR DRG.No.	500-GD-B-08033	REV. Z1
COMPANY DRG.No.	PP05-0500-00-PID-8033	
SCALE: NONE	SIZE: A1	DOC. CLASS: 1